


GRW Record Drawings

BID SET

FALL CREEK REGIONAL WASTE DISTRICT SANITARY SEWER REHABILITATION PROJECT PHASE I

PENDLETON, INDIANA

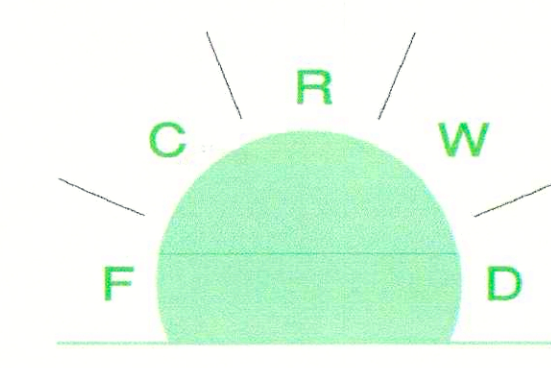

Jack Hutton


FCRWD MEMBERS

MARK A. JABLONSKI	- PRESIDENT
MICHELLE W. PATISHALL	- VICE PRESIDENT
GREGORY L. VALENTINE	- TREASURER
DAVID K. PADGETT	- SECRETARY
STEPHEN J. BILL	- DEPUTY SECRETARY/TREASURER
TIMOTHY E. GREEN	- BOARD MEMBER
KURT L. KAHL	- BOARD MEMBER
JACK C. WEIST	- BOARD MEMBER
ALBERT B. STEWART	- BOARD MEMBER
TERESA HUTTON	- GENERAL MANAGER
STEVE UNGER	- ATTORNEY



engineering | architecture | geospatial


www.grwinc.com

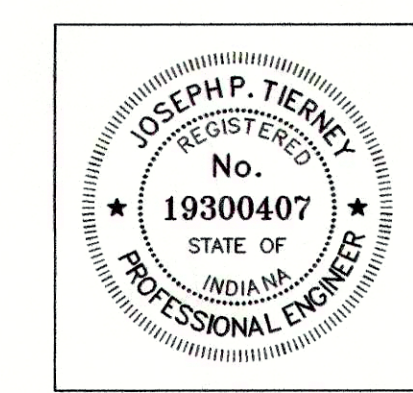

JOSEPH P. TIERNEY, P.E.
INDIANA REG. NO. 19300407

DATE: 4-22-2016

APRIL 2016

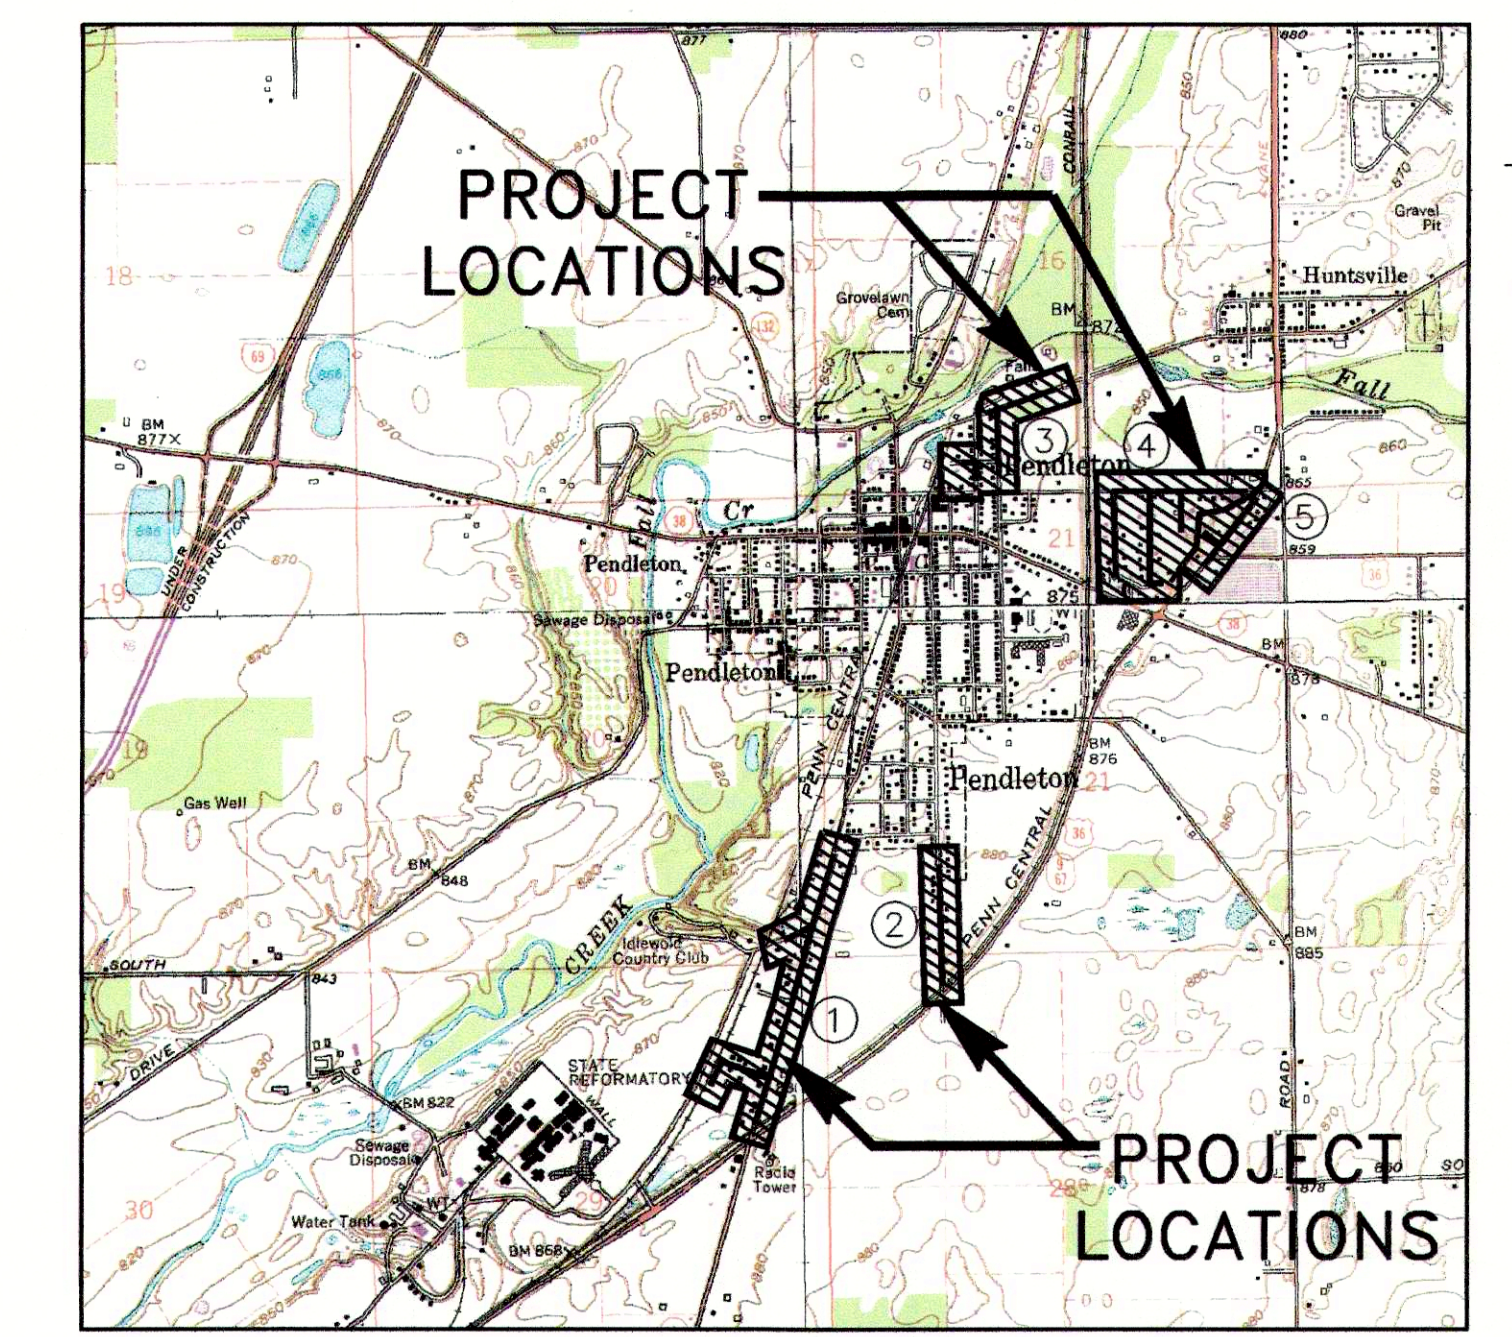

SCALE: 1" = 2000'

PROJECT AREAS:

- ① SOUTH PENDLETON
- ② SOUTH BROADWAY
- ③ FALLS PARK
- ④ EAST WATER STREET
- ⑤ STATE ROAD 67

PLAN SET IS FULL SCALE ON 24"x36"
AND HALF SCALE ON 12"x18"

*Pendleton
Phase I
As-built*

SRF NO. WW16074803
GRW PROJECT NO. 4447-14

PRINTED: 8/24/2016 @ 11:54AM
FILE NAME: G:\4447-FCRWD-2015\Working Drawings\AutoCAD\REHABILITATION PHASE I\4447-14-G-00.dwg