



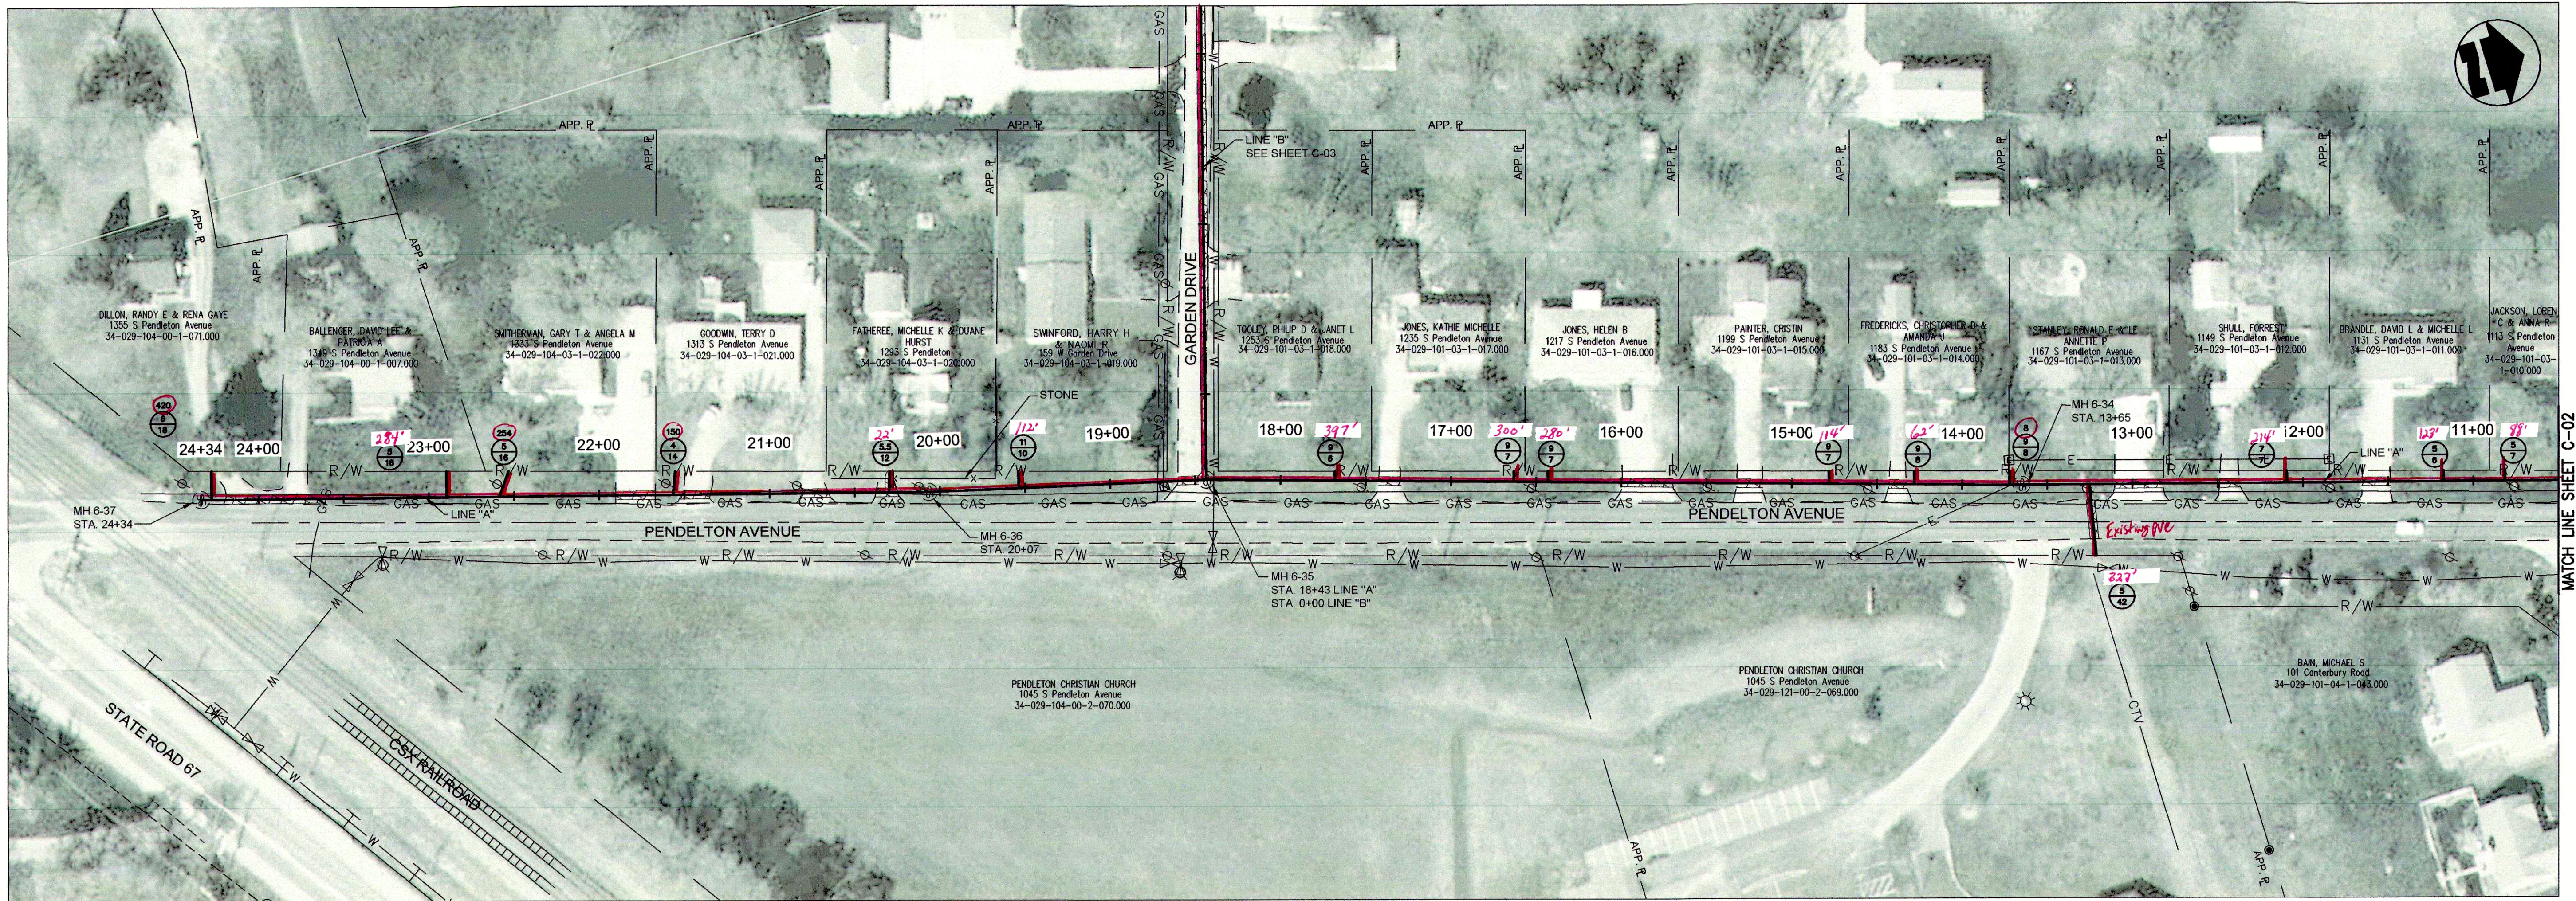

PLAN VIEW - STA. 24+34 TO STA. 10+50 LINE "A"

From MH# 6-37 to MH# 6-30 - CIPP

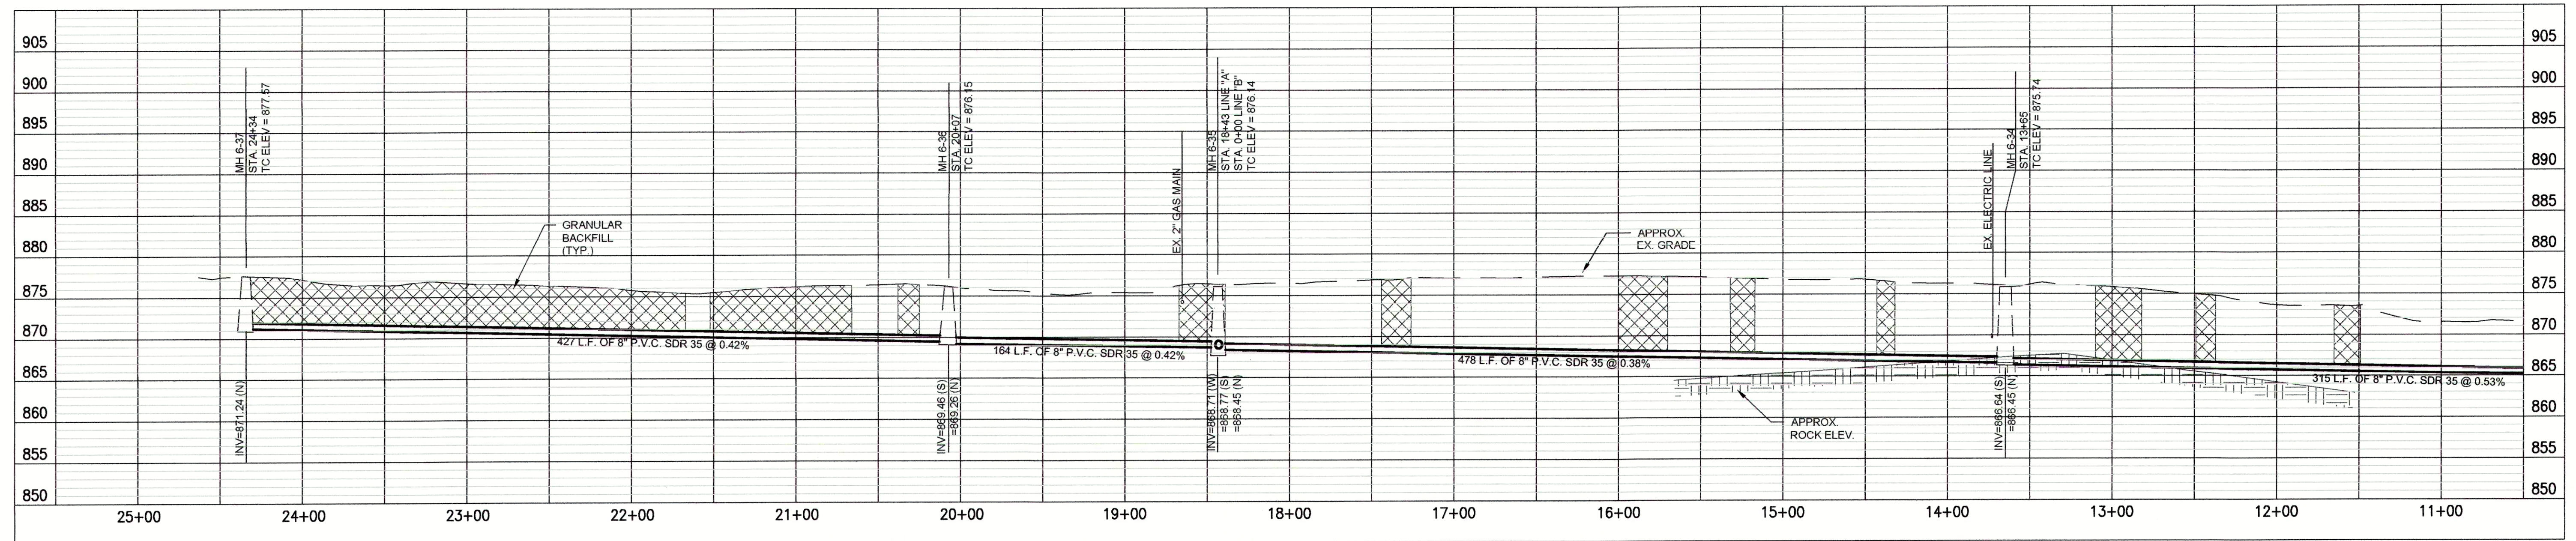


PROFILE - STA. 24+46 TO STA. 10+50 LINE "A"

"BID SCHEDULE A" (OPEN CUT) NOTES:

- LATERAL LOCATIONS SHOWN ARE BASED ON BEST AVAILABLE INFORMATION. CONTRACTOR TO FIELD VERIFY ALL EXISTING SANITARY LATERAL LOCATIONS AND DEPTHS. INSTALL 6" SDR 35 SEWER PIPE TO R/W LINE AND CONNECT TO EXISTING LATERAL.
- THE EXISTING MANHOLES ARE TO REMAIN IN PLACE WITH NEW SEWERS RECONNECTED. THE MANHOLES SHALL BE REHABILITATED PER THE MANHOLE REHABILITATION SCHEDULE.

BID SCHEDULES A & B NOTES:

- SANITARY LATERAL LEGEND:

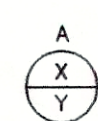

A = DISTANCE FROM DOWN STREAM MANHOLE
X = APPROX. DEPTH AT R/W
Y = LENGTH FROM MAIN TO R/W

"BID SCHEDULE B" (CIPP) NOTES:

- LATERAL LOCATIONS SHOWN ARE BASED ON BEST AVAILABLE INFORMATION. CONTRACTOR TO FIELD VERIFY EXISTING SANITARY LATERAL LOCATIONS AND DEPTHS. FOR LATERAL REPLACEMENTS, MAKE CONNECTION DIRECTLY TO CIPP LINER AS SHOWN IN THE DETAILS AND ON SHEET C-16. INSTALL 6" SDR 35 SEWER PIPE FROM MAIN TO R/W LINE AND CONNECT TO EXISTING LATERAL.
- IF THE PLANS SHOW C.I.P.P. LATERAL REHABILITATION, COMPLETE PER THE DETAIL ON SHEET C-16.
- MANHOLE SHALL BE REHABILITATION PER THE MANHOLE REHABILITATION SCHEDULE.



GRW PROJECT NO. 4447-14

SRF NO. WY16074803

ALL RIGHTS RESERVED
GRW ENGINEERS, INC. AND SHALL NOT
BE USED FOR CONSTRUCTION OF
ANY OTHER PROJECT WITHOUT WRITTEN PERMISSION



engineering | architecture | geospatial
www.grwinc.com

PLAN & PROFILE
SANITARY SEWER REHABILITATION
FALL CREEK REGIONAL WASTE DISTRICT
PENDELTON, INDIANA

DESIGNED	BY	DATE	DESCRIPTION	NO.
GWL	BK	---	---	---
DRAWN	BY	DATE	DESCRIPTION	NO.
GCR	BK	---	---	---
REVIEWED	BY	DATE	DESCRIPTION	NO.
JPT	BK	---	---	---
APPROVED	BY	DATE	DESCRIPTION	NO.
JPT	BK	---	---	---

DATE: APRIL 2016

SCALE: H: 1"=50' V: 1"=10'

SHEET NO.

C-01