
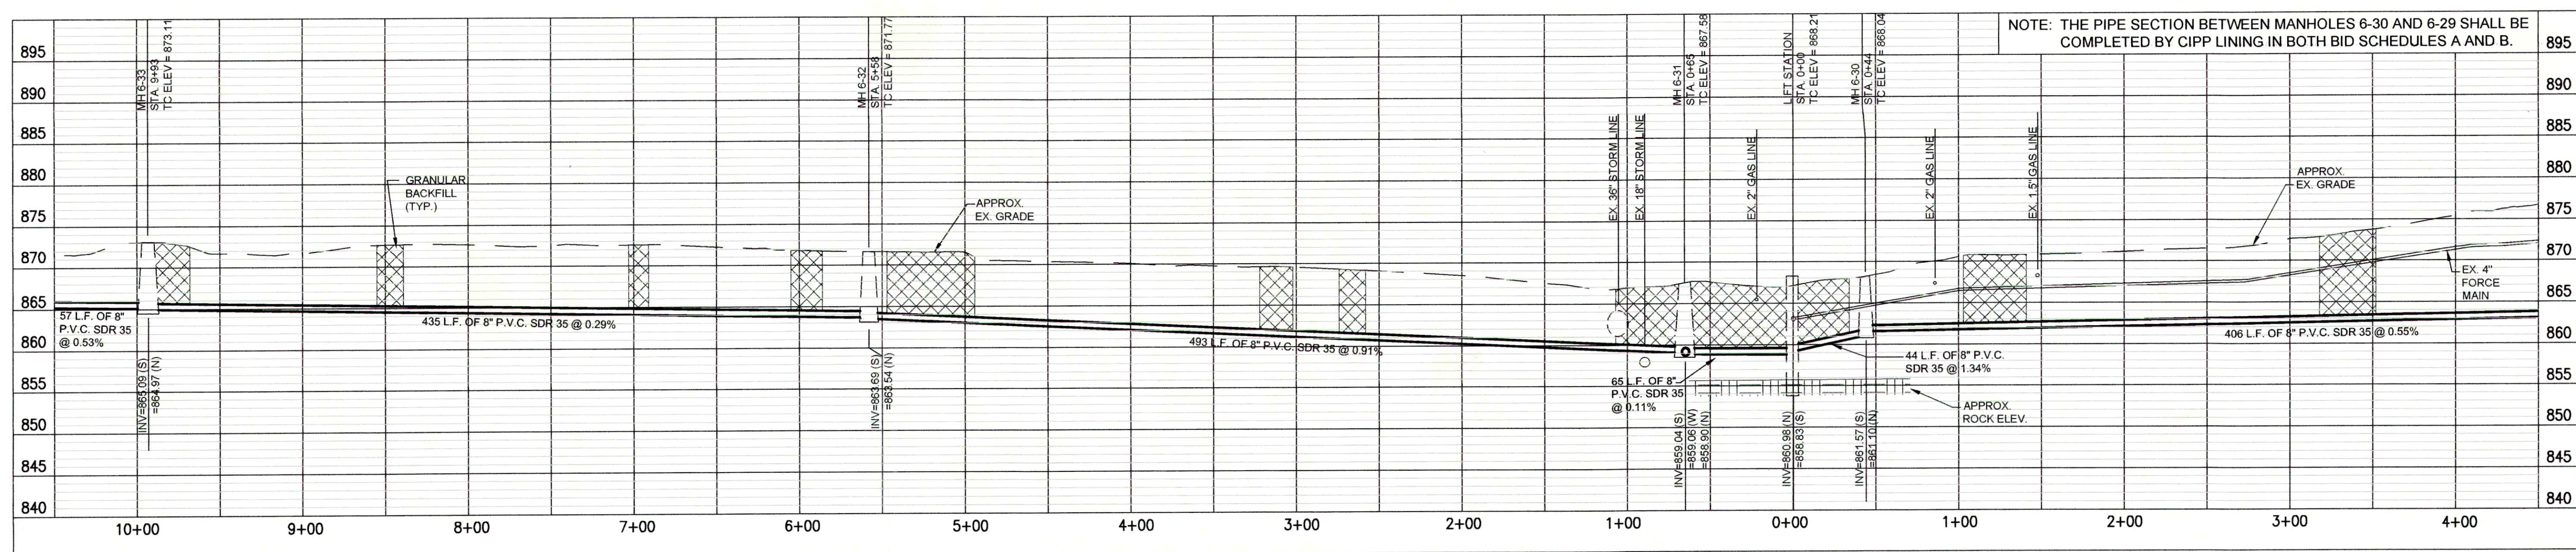


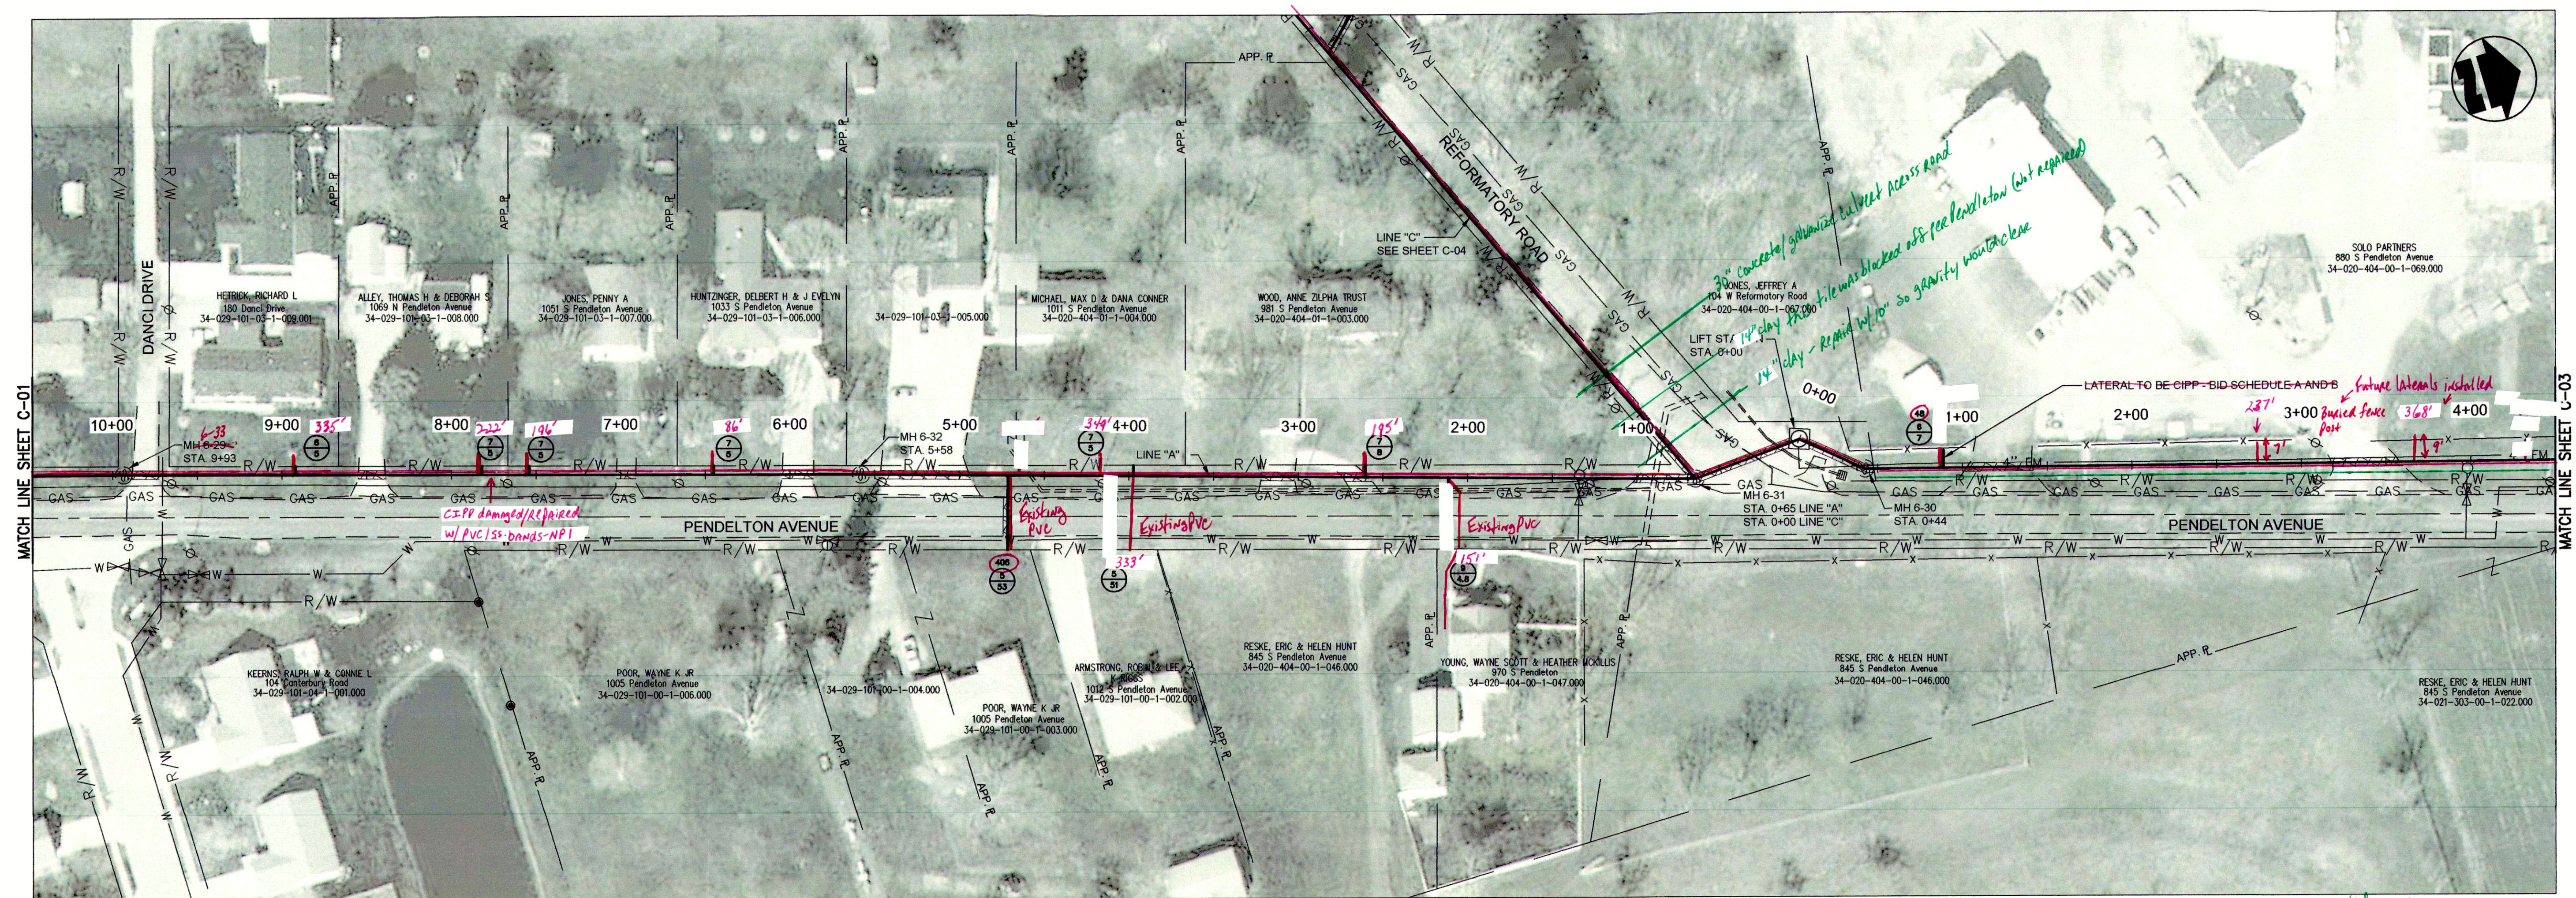

- "BID SCHEDULE A" (OPEN CUT) NOTES:**
1. LATERAL LOCATIONS SHOWN ARE BASED ON BEST AVAILABLE INFORMATION. CONTRACTOR TO FIELD VERIFY ALL EXISTING SANITARY LATERAL LOCATIONS AND DEPTHS, INSTALL 6" SDR 35 SEWER PIPE TO R/W LINE AND CONNECT TO EXISTING LATERAL.
 2. THE EXISTING MANHOLES ARE TO REMAIN IN PLACE WITH NEW SEWERS RECONNECTED. THE MANHOLES SHALL BE REHABILITATED PER THE MANHOLE REHABILITATION SCHEDULE.

- BID SCHEDULES A & B NOTES:**
1. SANITARY LATERAL LEGEND:
-  A
X
Y
- A= DISTANCE FROM DOWN STREAM MANHOLE
X= APPROX. DEPTH AT R/W
Y= LENGTH FROM MAIN TO R/W

- "BID SCHEDULE B" (CIPP) NOTES:**
1. LATERAL LOCATIONS SHOWN ARE BASED ON BEST AVAILABLE INFORMATION. CONTRACTOR TO FIELD VERIFY EXISTING SANITARY LATERAL LOCATIONS AND DEPTHS, FOR LATERAL REPLACEMENTS, MAKE CONNECTION DIRECTLY TO CIPP LINER AS SHOWN IN THE DETAILS AND ON SHEETC-16. INSTALL 6" SDR 35 SEWER PIPE FROM MAIN TO RAW LINE AND CONNECT TO EXISTING LATERAL.
 2. IF THE PLANS SHOW C.I.P. LATERAL REHABILITATION, COMPLETE PER THE DETAIL ON SHEET C-16.
 3. MANHOLE SHALL BE REHABILITATION PER THE MANHOLE REHABILITATION SCHEDULE.

JOSEPH P. TIERNY REGISTERED No. 19300407 STATE OF INDIANA PROFESSIONAL ENGINEER		GRW PROJECT NO. 4447-14	
SRF NO. WW16074803 ----		ALL RIGHTS RESERVED THIS DOCUMENT IS THE PROPERTY OF GRW INC. IT IS TO BE USED ONLY FOR THE PROJECT FOR WHICH IT WAS PREPARED AND NOT BE REPRODUCED IN WHOLE OR IN PART FOR ANY OTHER PROJECT WITHOUT THE WRITTEN PERMISSION OF GRW INC.	
		engineering architecture geospatial www.grwinc.com	
PLAN & PROFILE SANITARY SEWER REHABILITATION FALL CREEK REGIONAL WASTE DISTRICT PENDLETON, INDIANA			
DESIGNED		GWL -	
DRAWN		GCR	
REVIEWED		JPT	
APPROVED		JPT	
REVISIONS		SCALE CHECK: _____ THE MARK SHOULD MEASURE EXACTLY 1" WHEN PLOTTED.	
NO.	DESCRIPTION	DATE	BY
1		APRIL 2016	
SCALE:		H: 1"=50' V: 1"=10'	
SHEET NO.		C-02	