




**PLAN & PROFILE ADDITIONAL AREA
SANITARY SEWER REHABILITATION
FALL CREEK REGIONAL WASTE DISTRICT
PENDLETON, INDIANA**

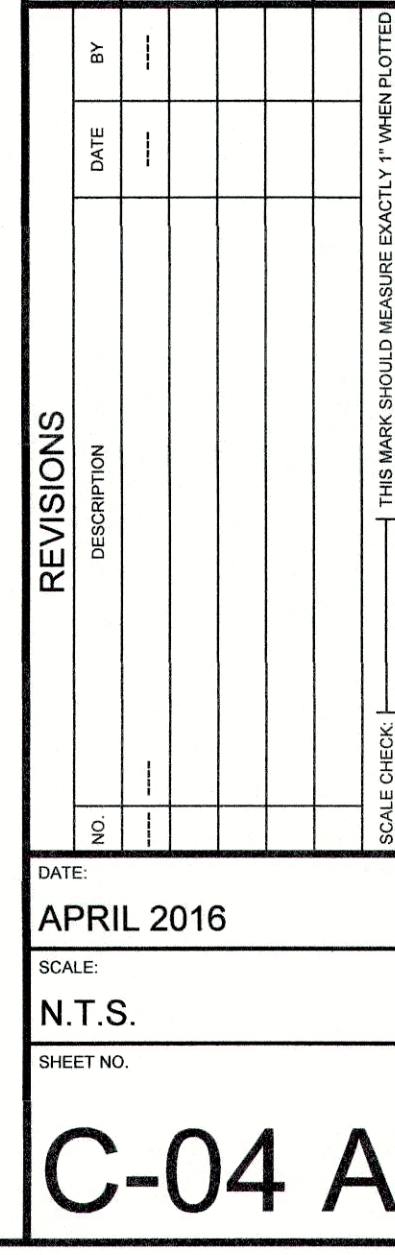

GRW PROJECT NO. 4447-14

SRF NO. WWM16074803 ----

ALL RIGHTS RESERVED.
THIS DOCUMENT IS THE PROPERTY OF
GRW ENGINEERS, INC. AND SHALL NOT
BE REPRODUCED IN WHOLE OR IN PART
OR USED FOR CONSTRUCTION OF
OTHER THAN THIS SPECIFIC PROJECT
WITHOUT WRITTEN PERMISSION

