



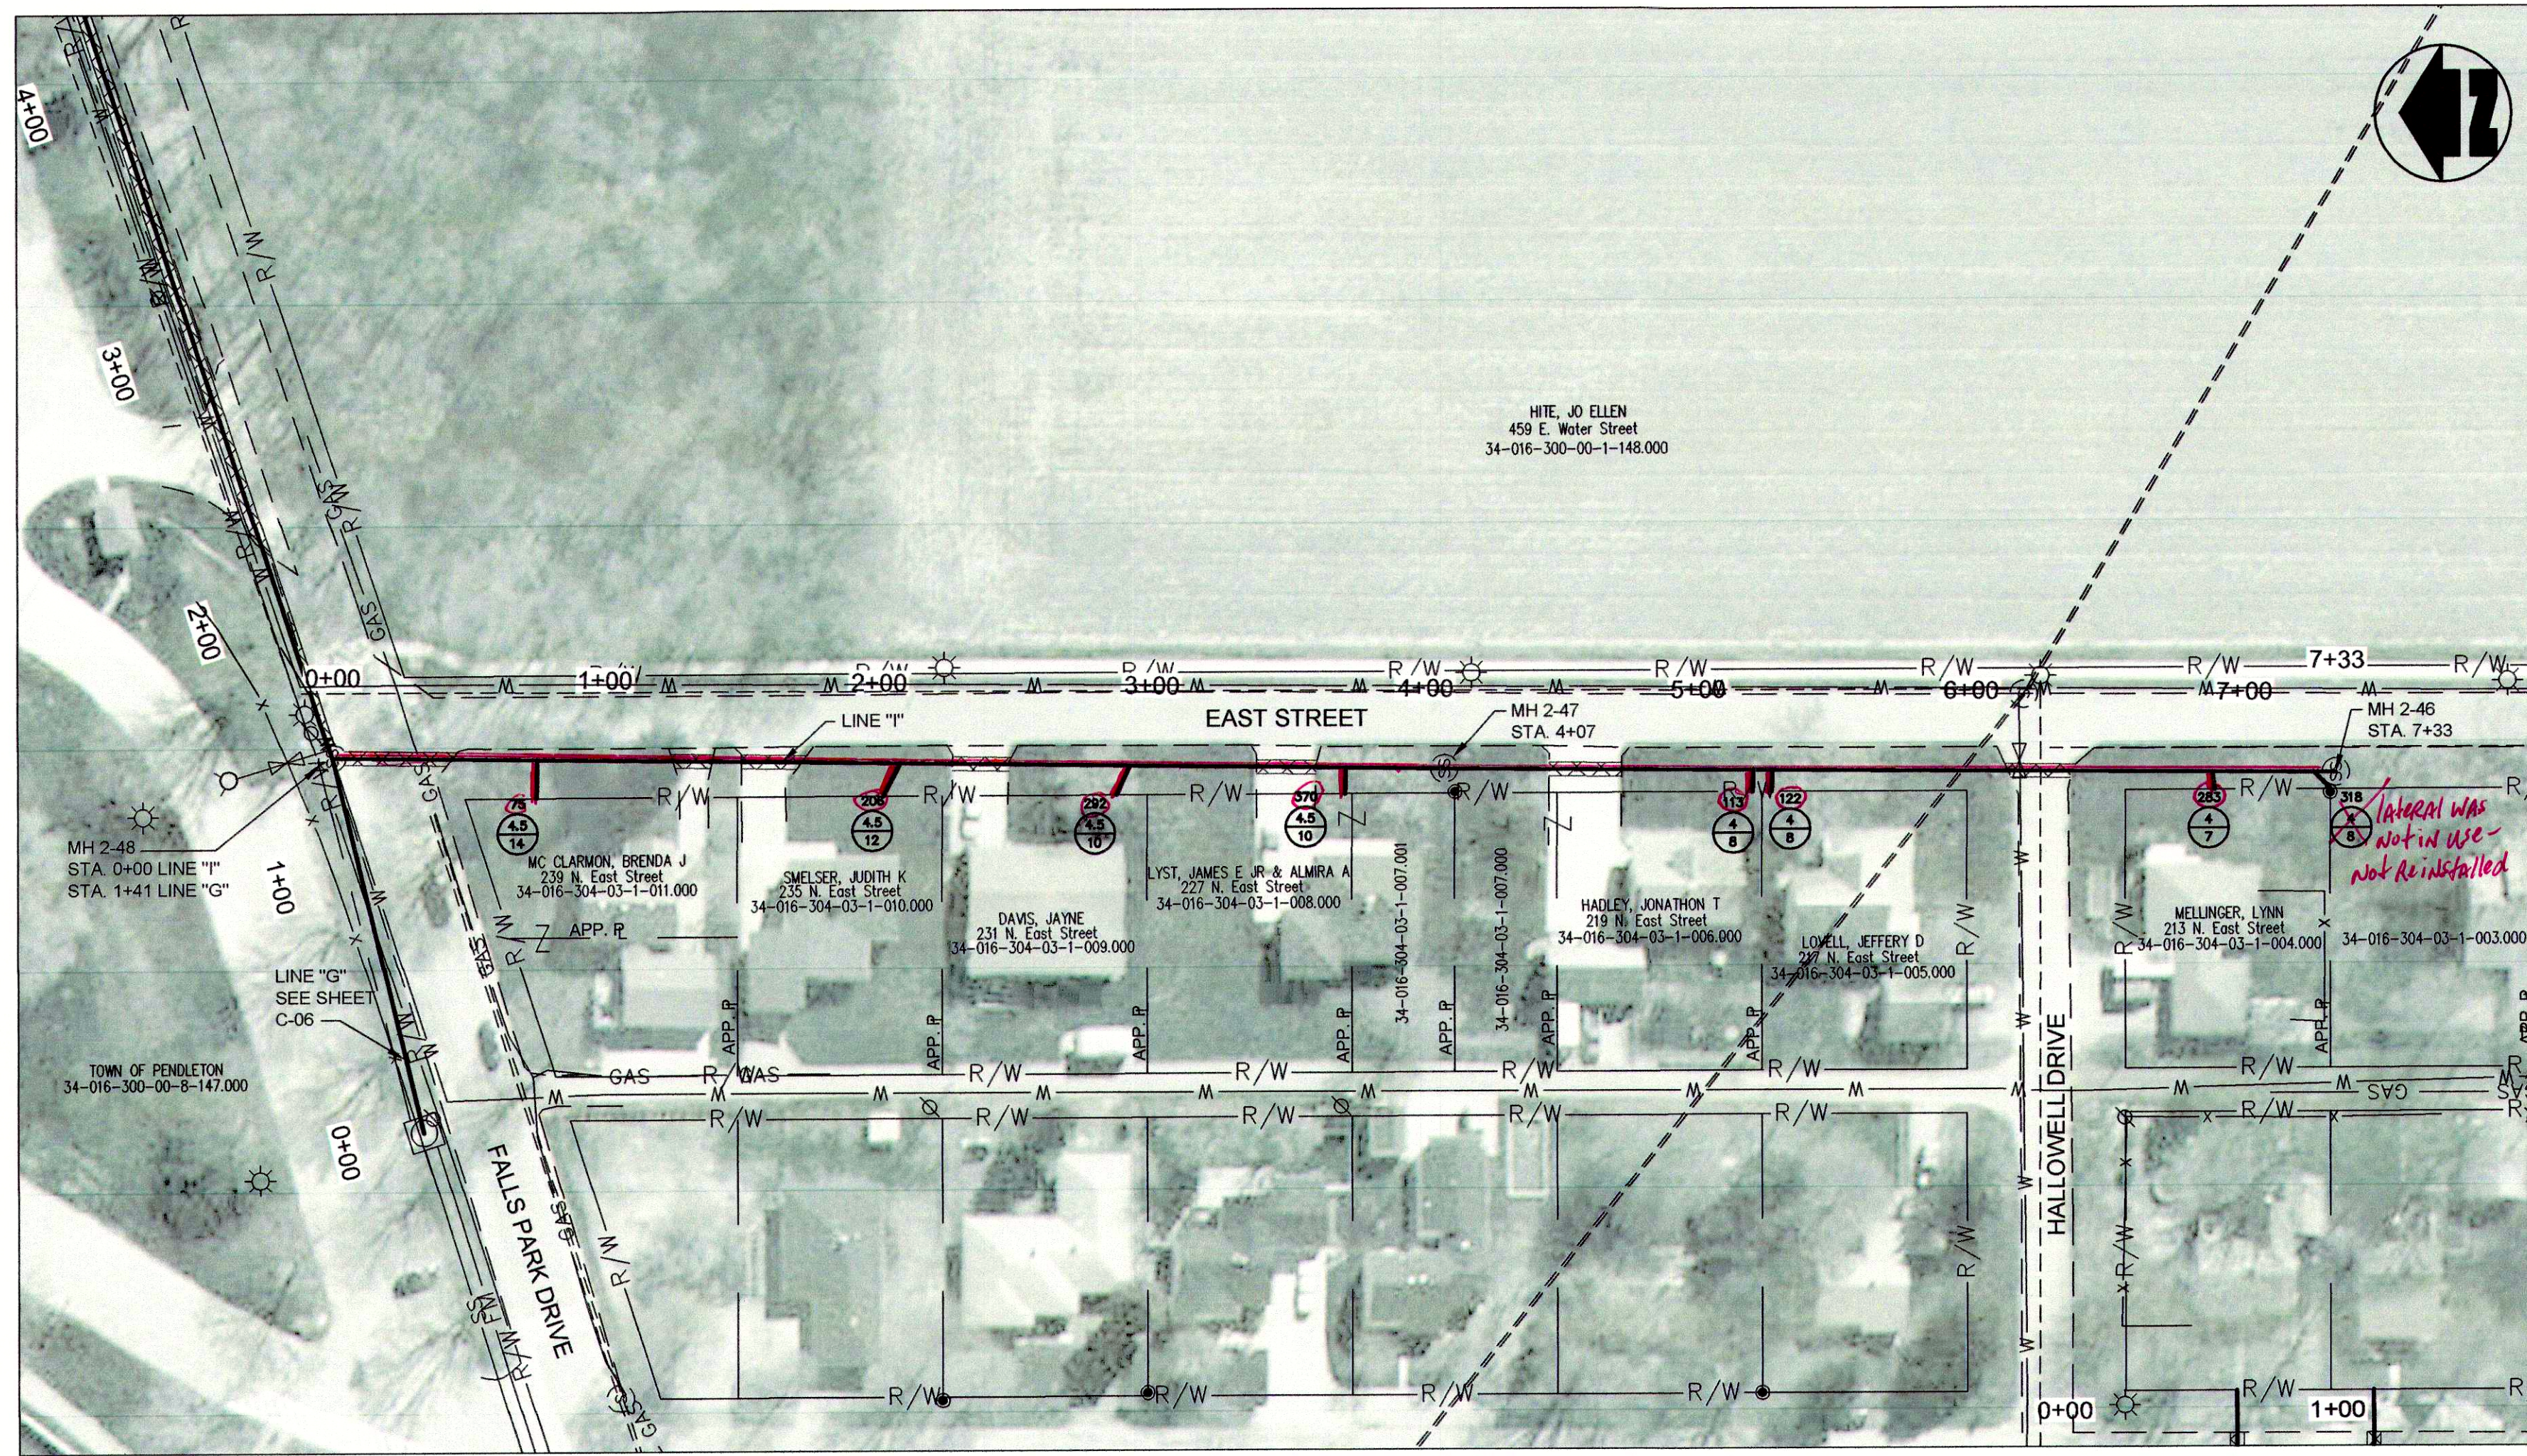

PLAN VIEW - STA. 0+00 TO STA. 7+33 LINE "I"

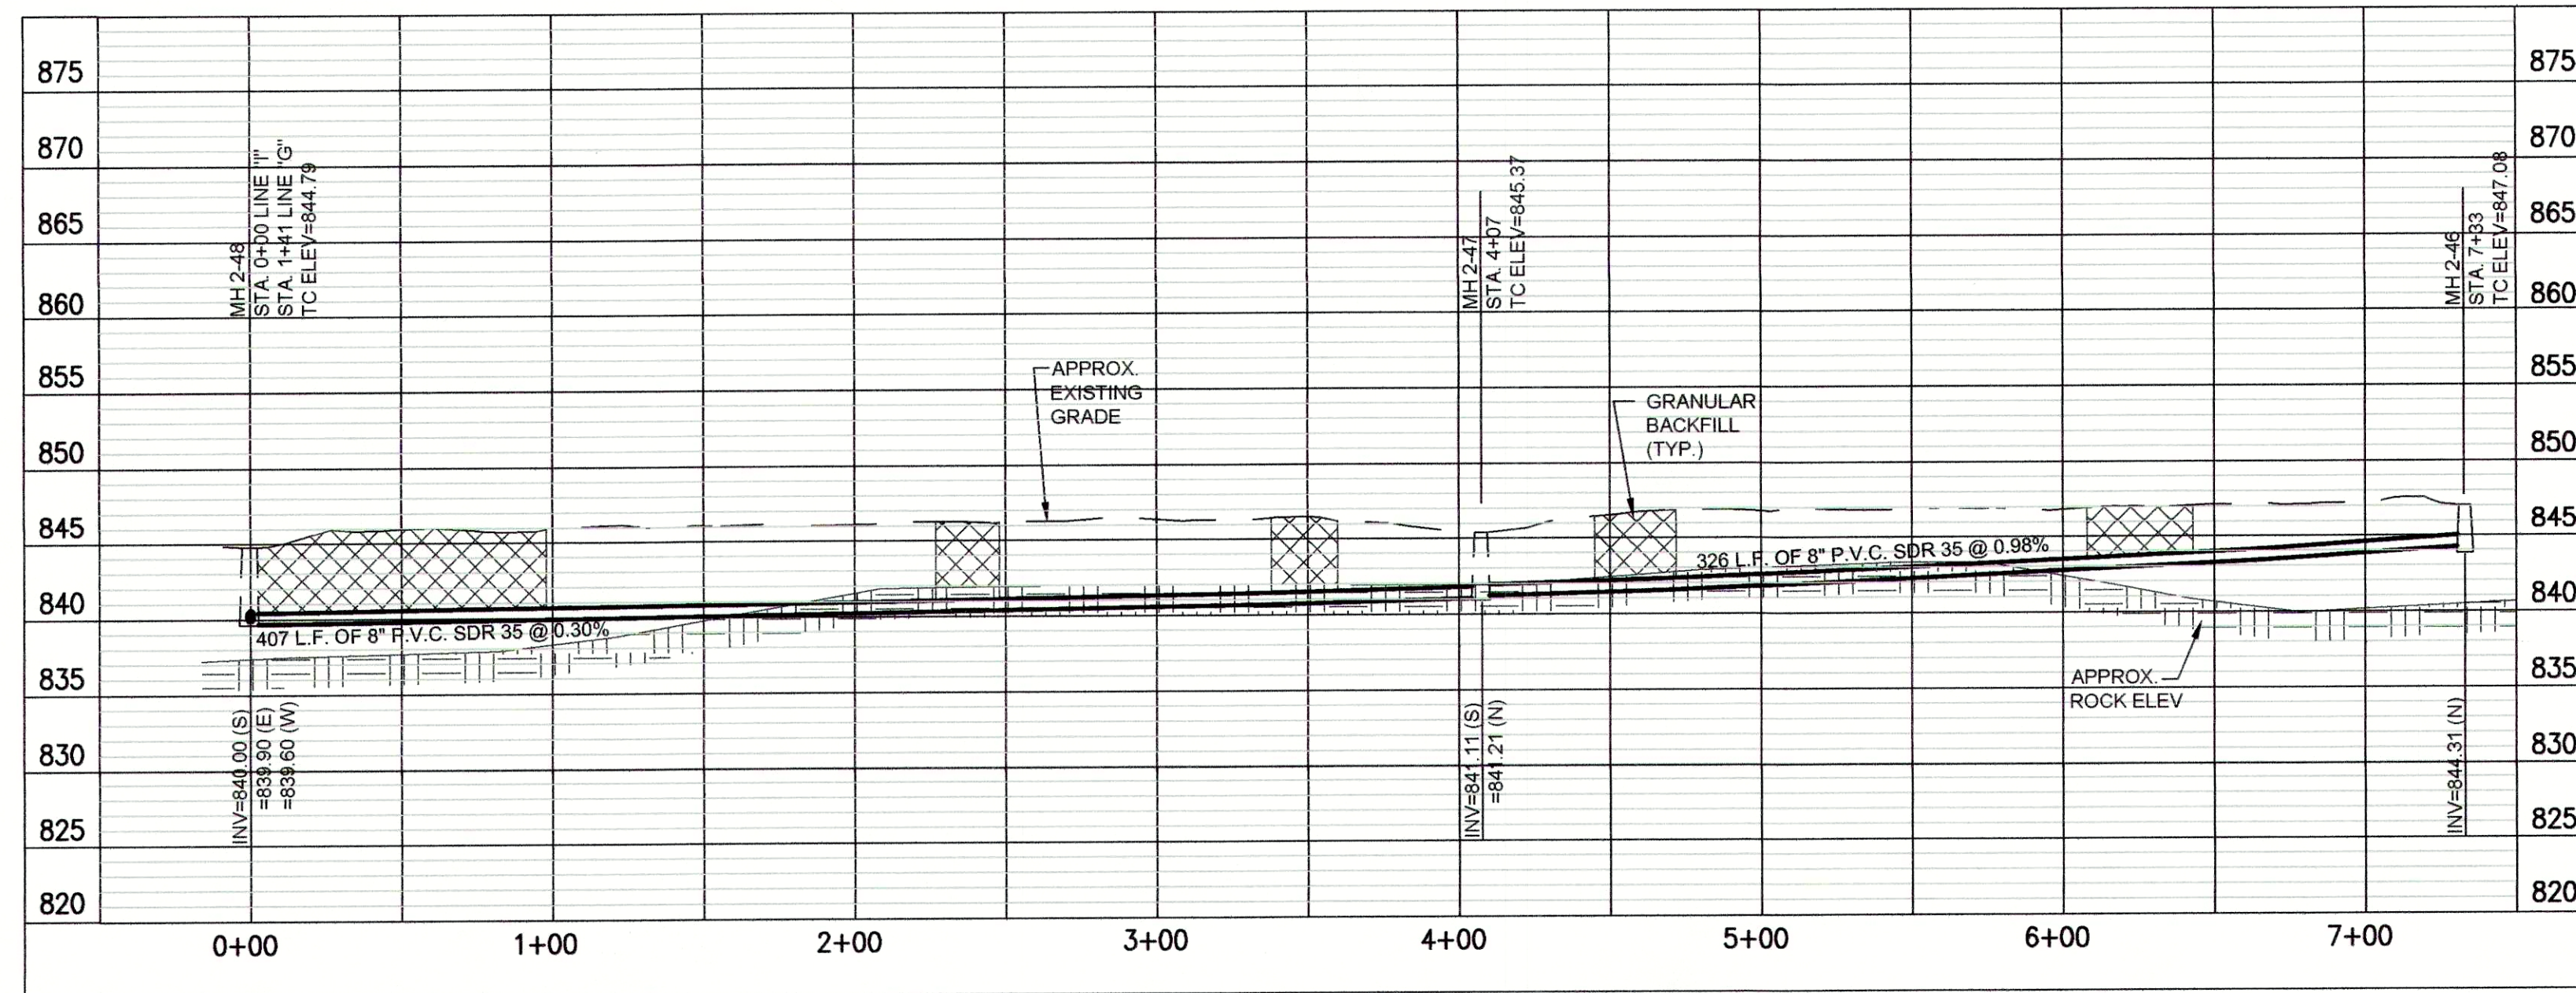


PROFILE - STA. 0+00 TO STA. 7+33 LINE "I"

"BID SCHEDULE A" (OPEN CUT) NOTES:


1. LATERAL LOCATIONS SHOWN ARE BASED ON BEST AVAILABLE INFORMATION. CONTRACTOR TO FIELD VERIFY ALL EXISTING SANITARY LATERAL LOCATIONS AND DEPTHS, INSTALL 6" SDR 35 SEWER PIPE TO R/W LINE AND CONNECT TO EXISTING LATERAL.
2. THE EXISTING MANHOLES ARE TO REMAIN IN PLACE WITH NEW SEWERS RECONNECTED. THE MANHOLES SHALL BE REHABILITATED PER THE MANHOLE REHABILITATION SCHEDULE.

BID SCHEDULES A & B NOTES:


1. SANITARY LATERAL LEGEND:

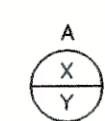

A = DISTANCE FROM DOWN STREAM MANHOLE
X = APPROX. DEPTH AT R/W
Y = LENGTH FROM MAIN TO R/W

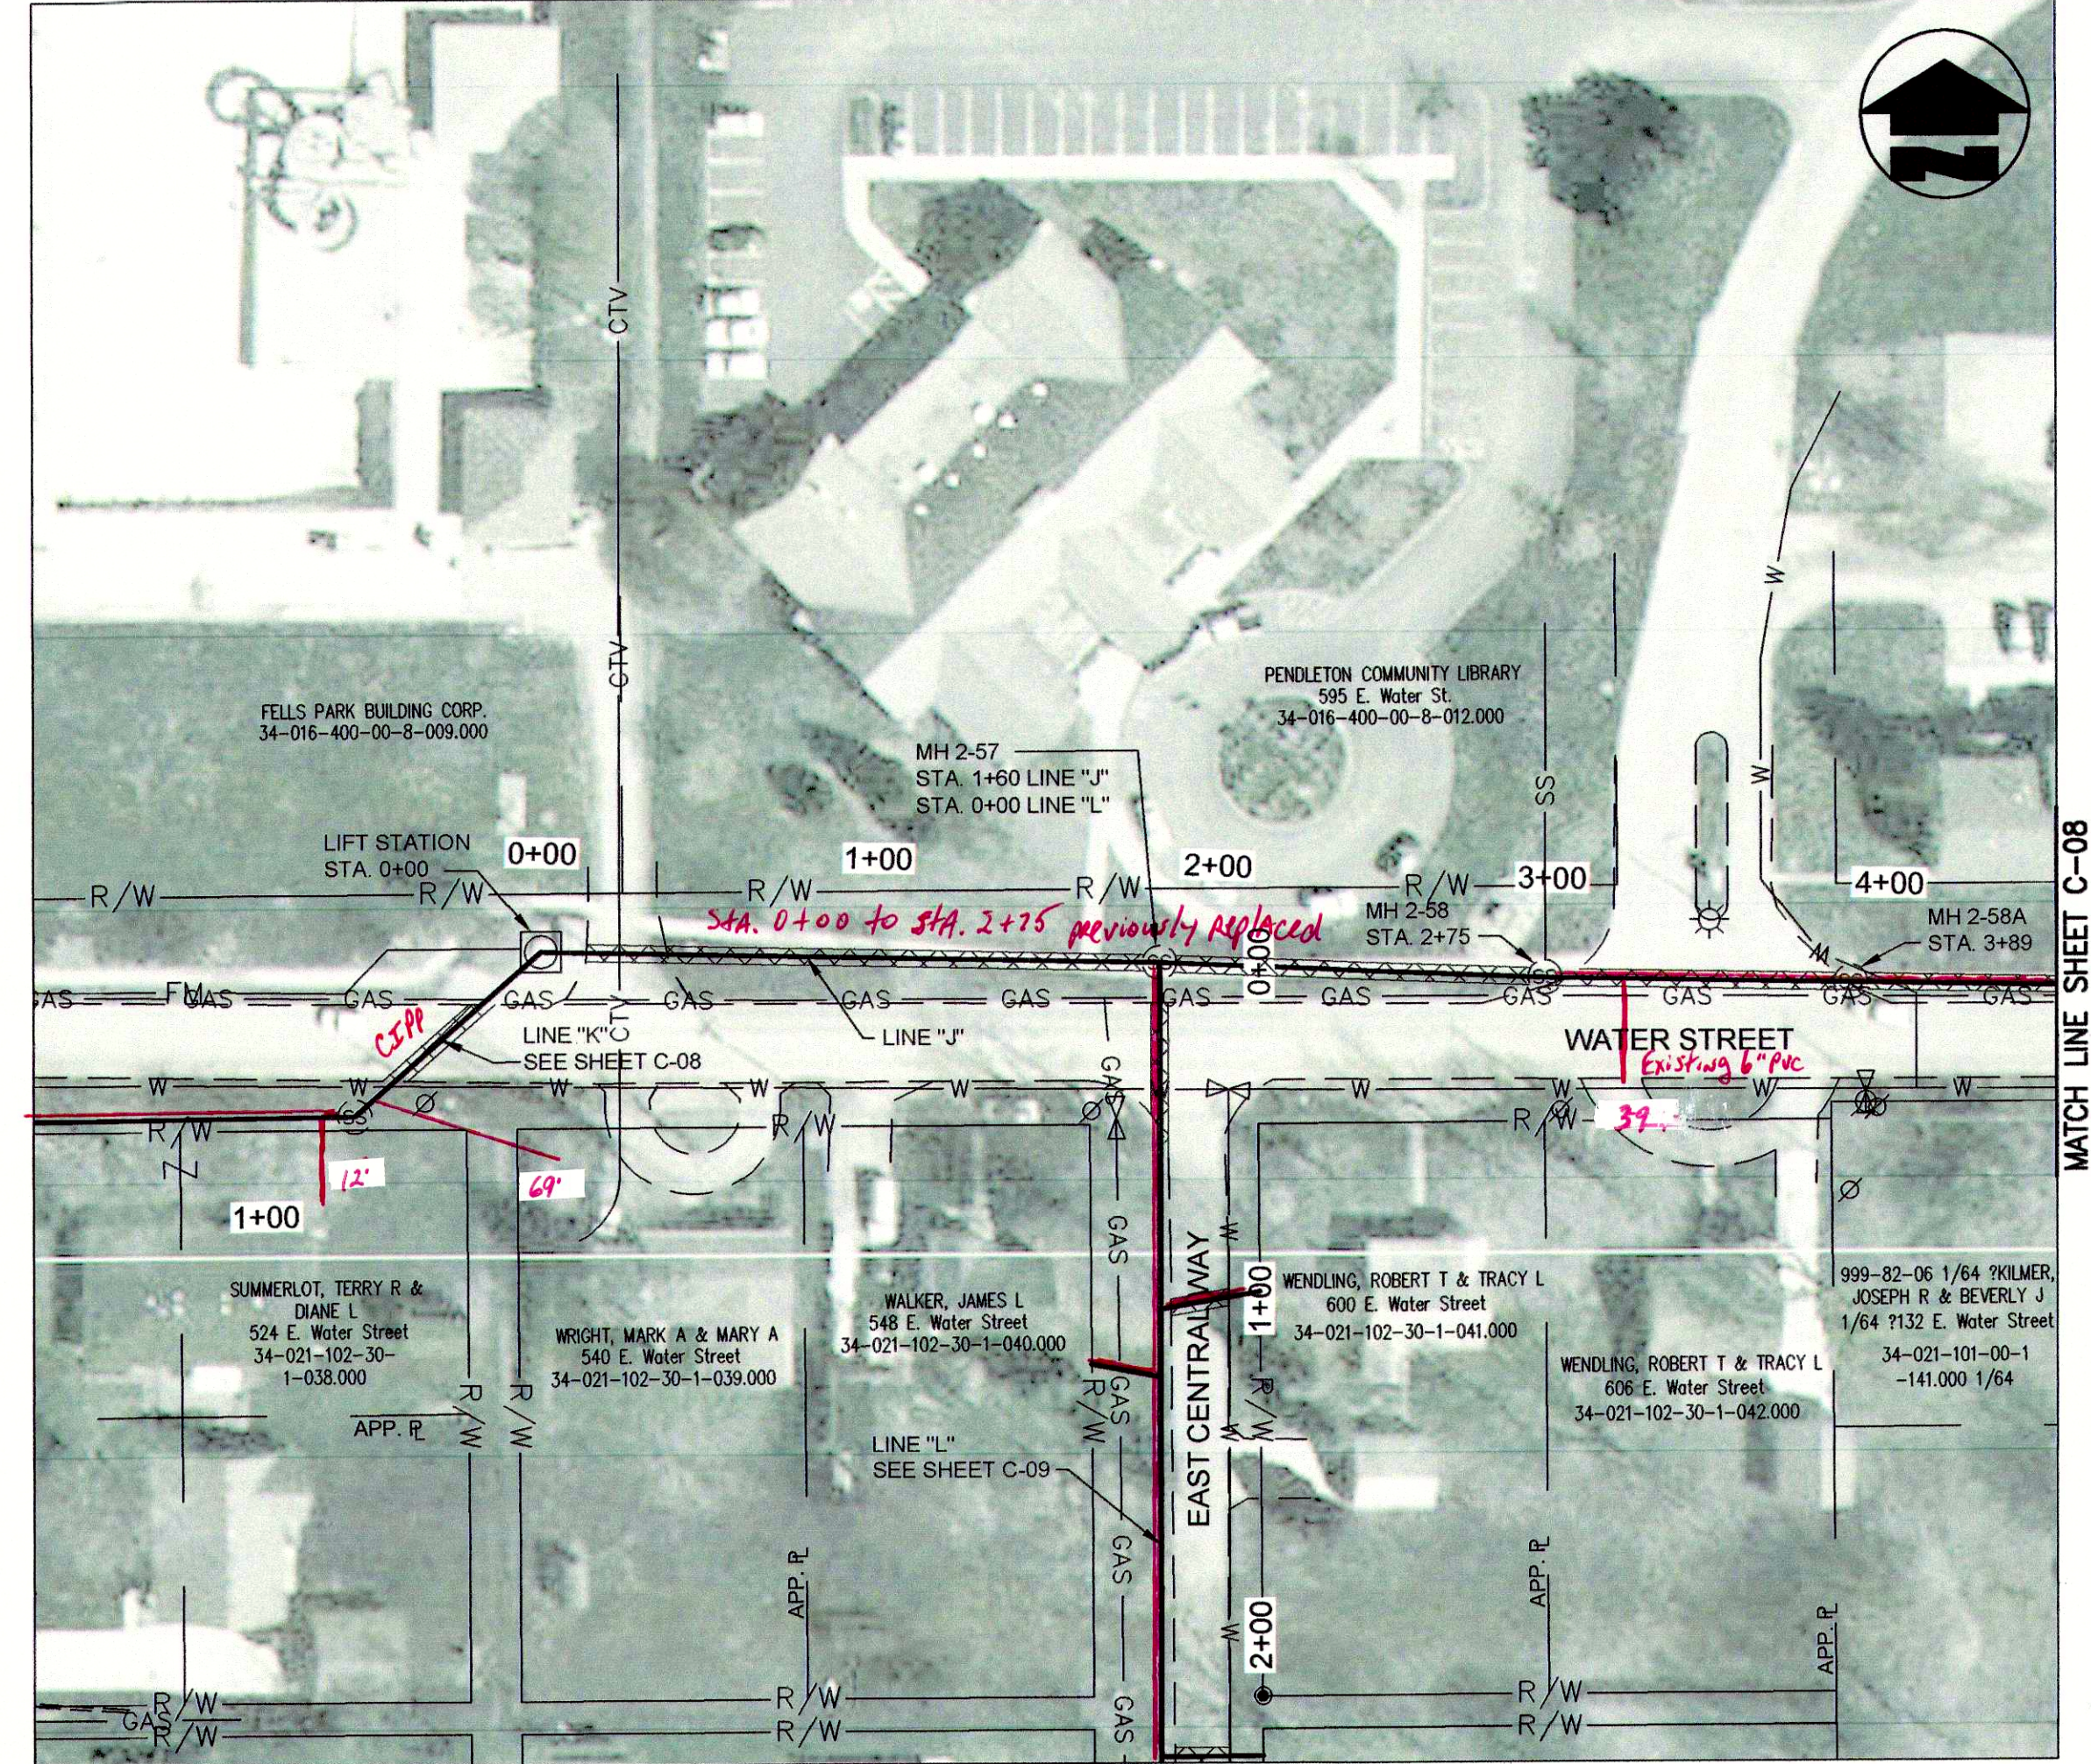

PLAN VIEW - B.O.P. STA. 0+00 TO STA. 4+50 LINE "J"

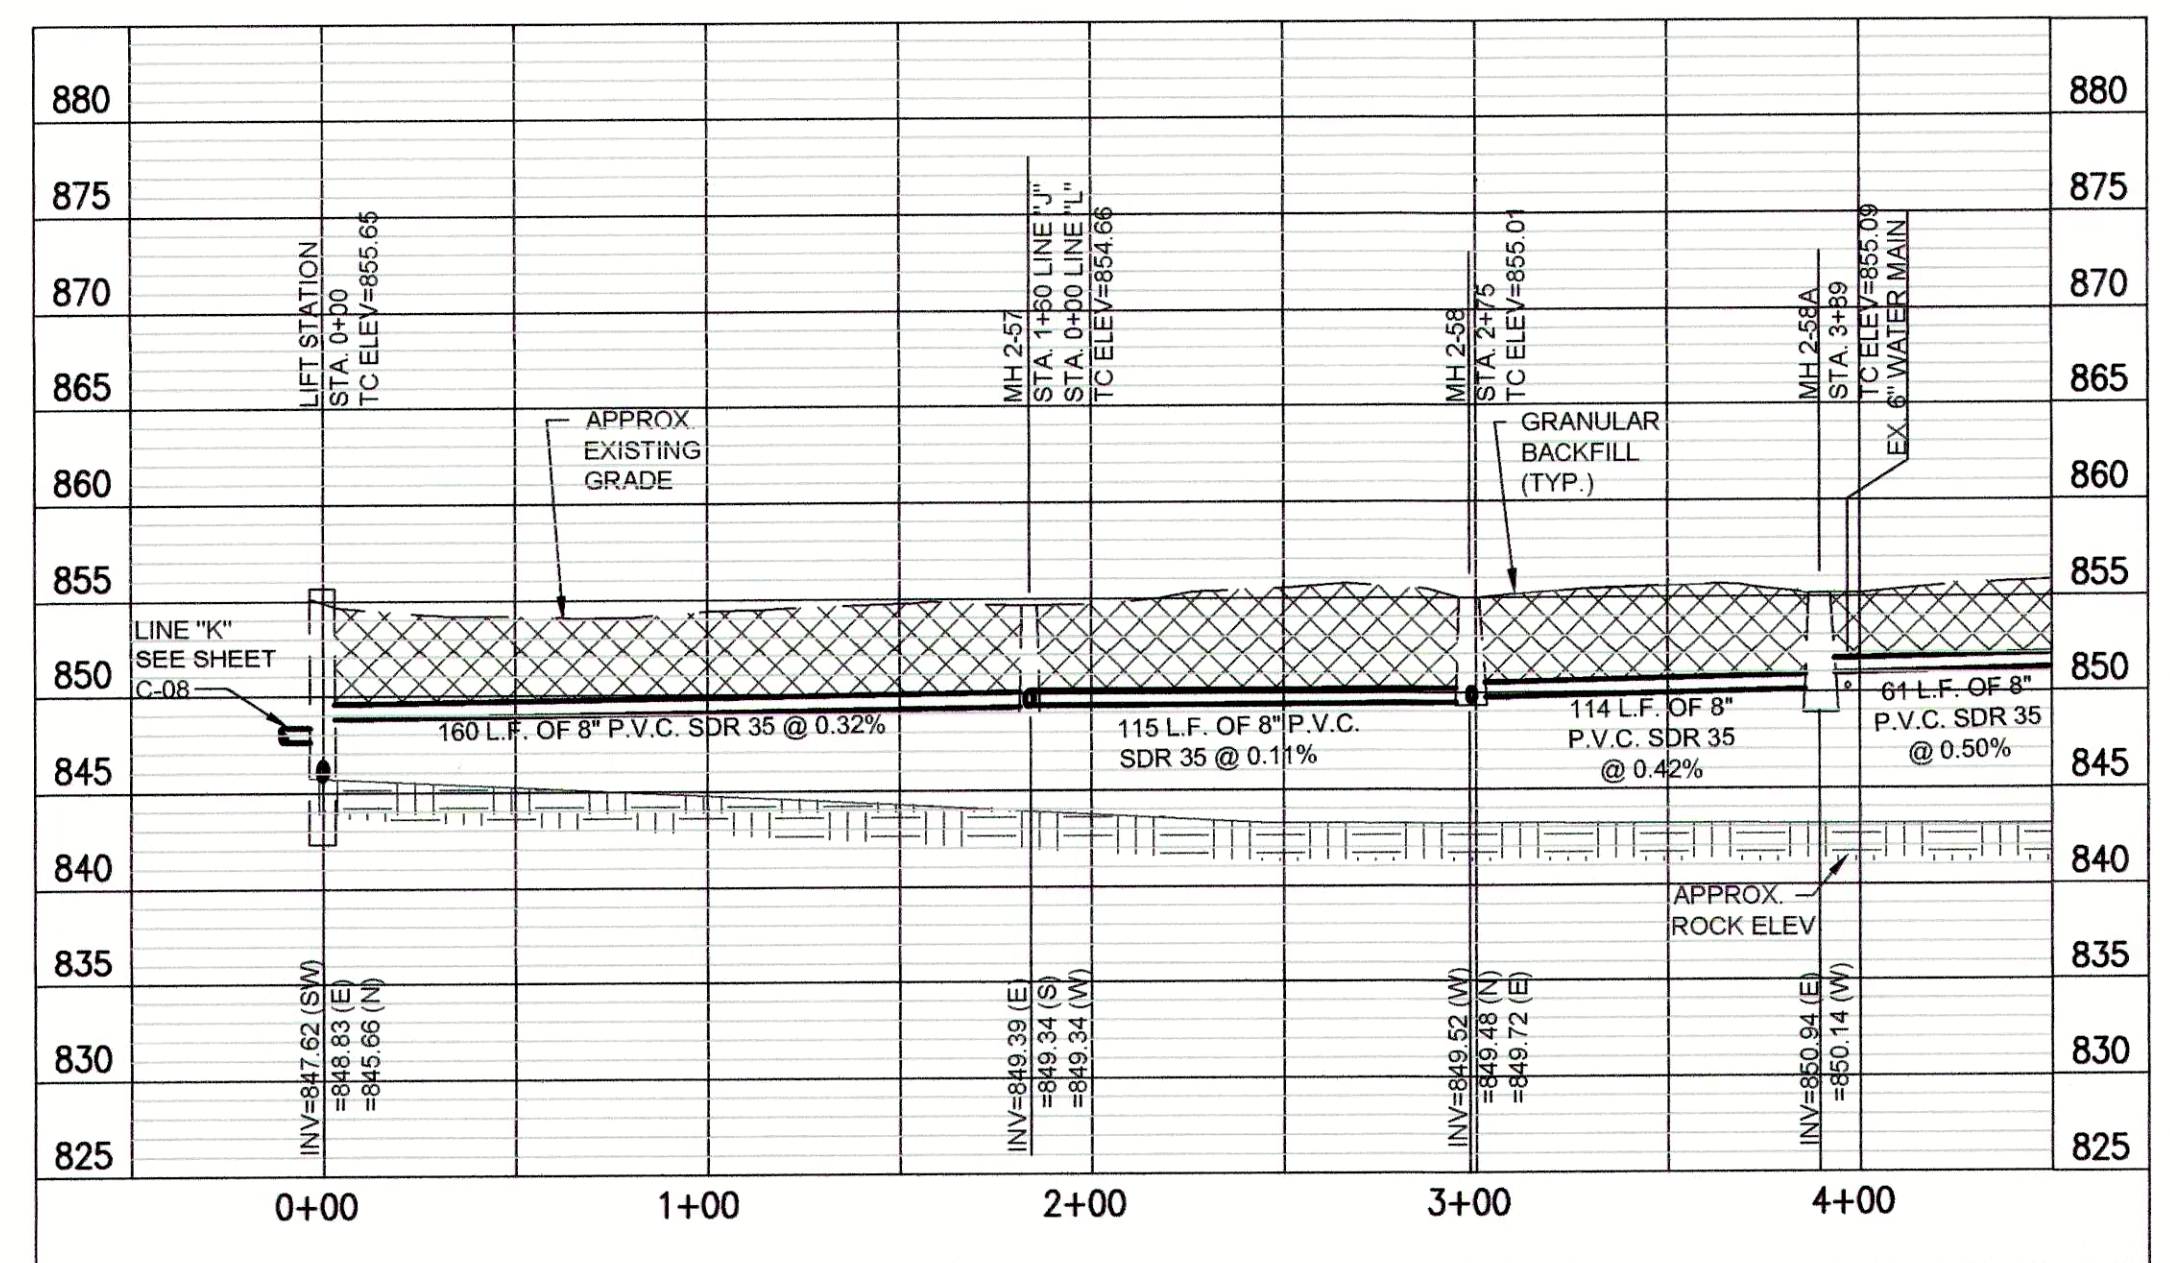

PROFILE - B.O.P. STA. 0+00 TO STA. 4+50 LINE "J"

"BID SCHEDULE B" (CIPP) NOTES:

1. LATERAL LOCATIONS SHOWN ARE BASED ON BEST AVAILABLE INFORMATION. CONTRACTOR TO FIELD VERIFY EXISTING SANITARY LATERAL LOCATIONS AND DEPTHS, FOR LATERAL REPLACEMENTS, MAKE CONNECTION DIRECTLY TO CIPP LINER AS SHOWN IN THE DETAILS AND ON SHEET C-16. INSTALL 6" SDR 35 SEWER PIPE FROM MAIN TO R/W LINE AND CONNECT TO EXISTING LATERAL.
2. IF THE PLANS SHOW C.I.P.P. LATERAL REHABILITATION, COMPLETE PER THE DETAIL ON SHEET C-16.
3. MANHOLE SHALL BE REHABILITATION PER THE MANHOLE REHABILITATION SCHEDULE.