



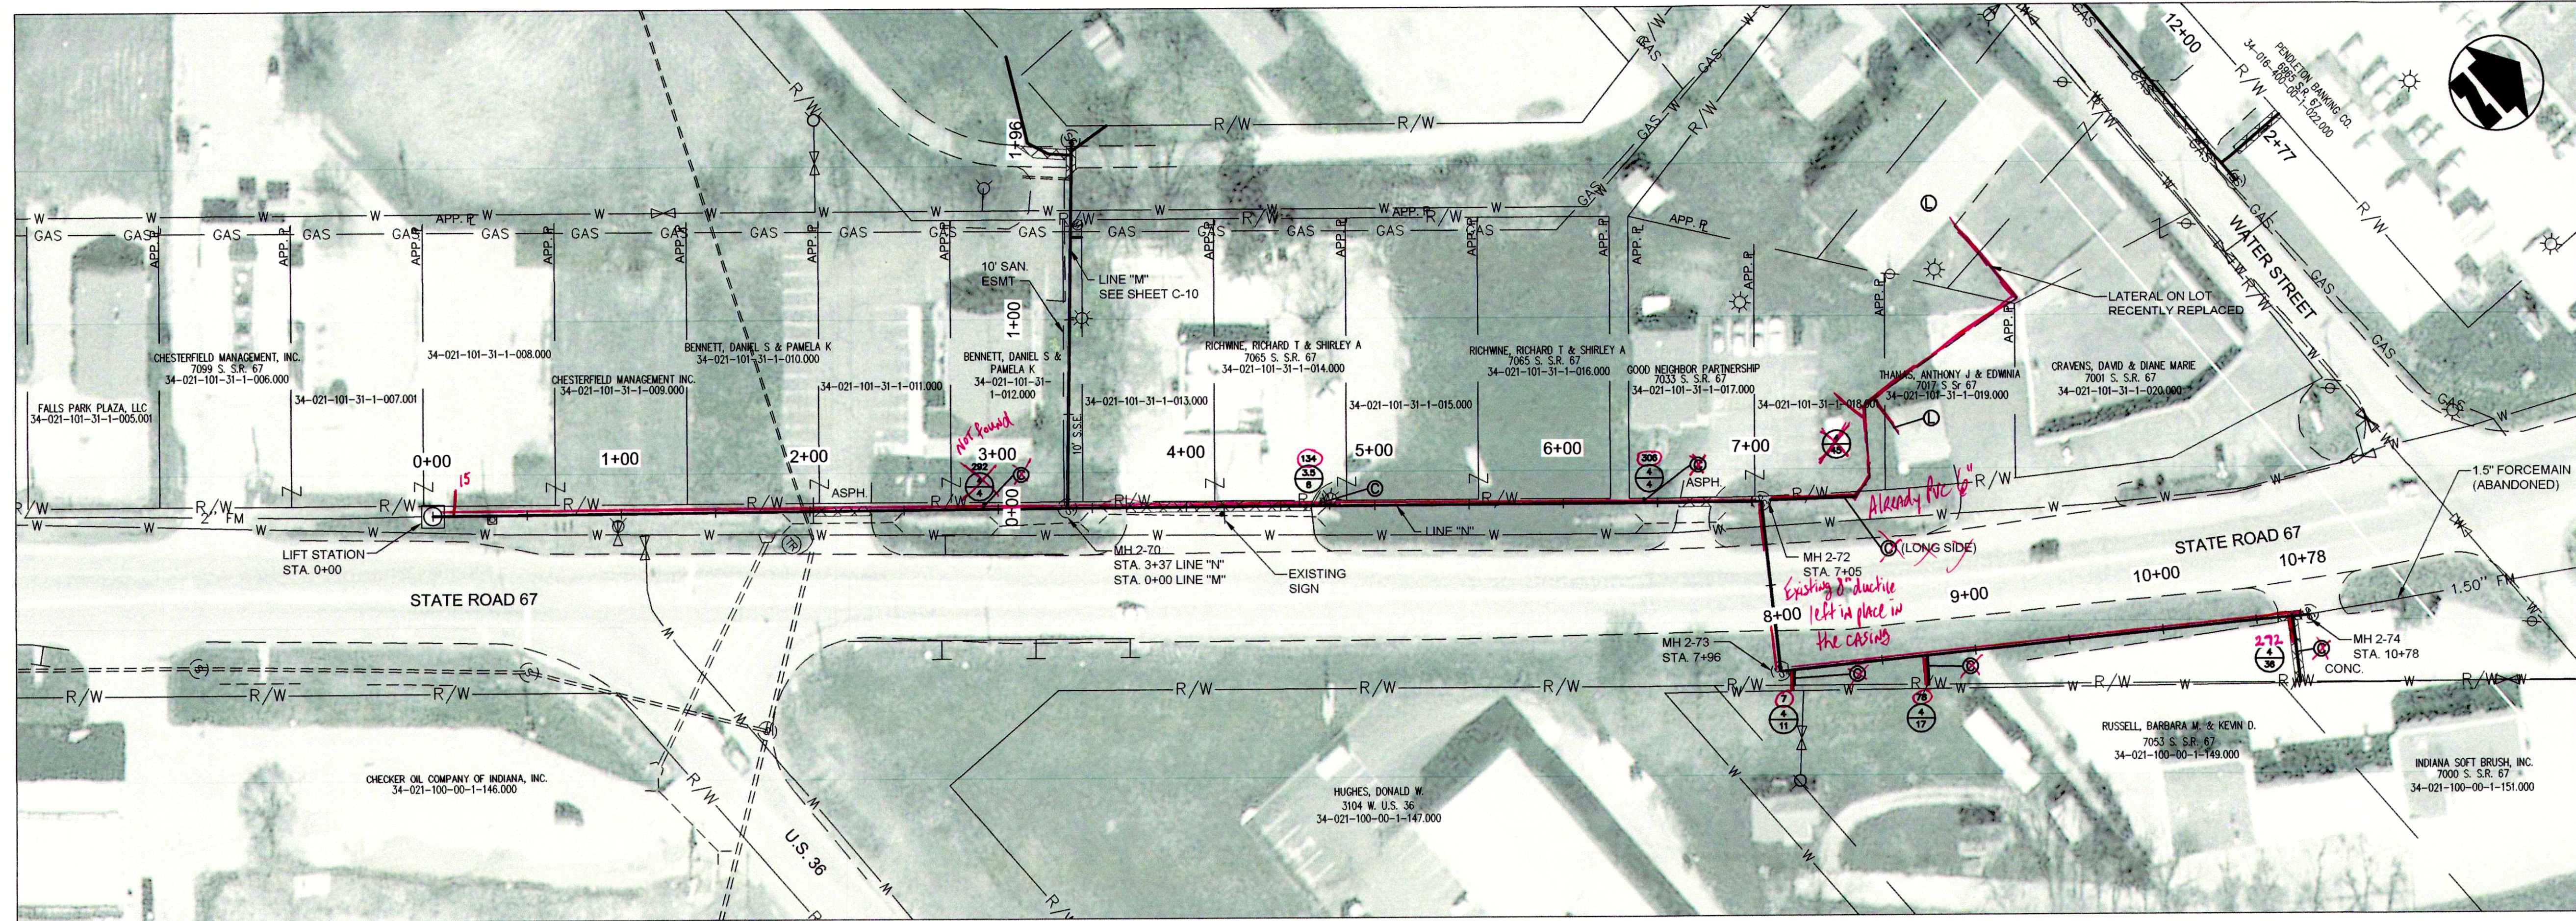

PLAN VIEW - STA. 0+00 TO STA. 10+78 LINE "N"

- ① PRIVATE LATERALS TO BE REPLACED.
SEE WORK DESCRIPTION IN MEASUREMENTS AND PAYMENT.
- ② LATERAL TO BE CIPP LINED -
BID SCHEDULE B ONLY

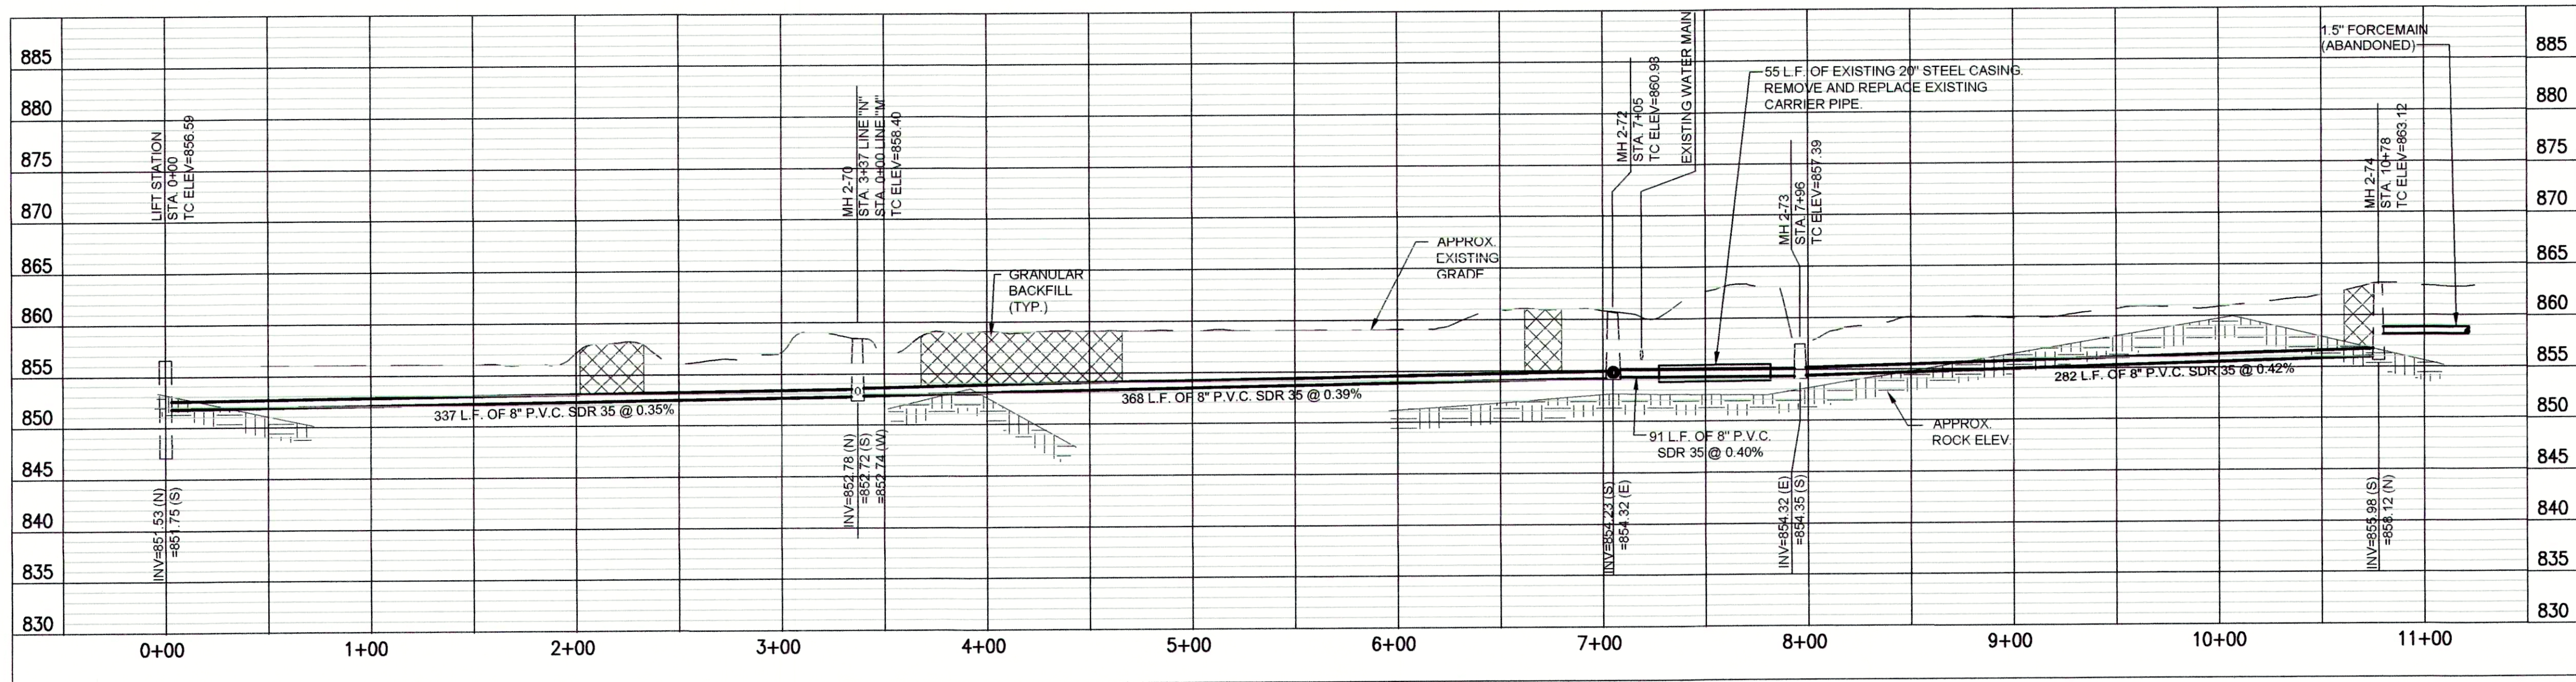

PROFILE - STA. 0+00 TO STA. 10+78 LINE "N"

NOTE:
THE PRIVATE LATERAL REPLACEMENT WORK ON THIS SHEET
SHALL BE INCLUDED IN ADDITIVE ALTERNATE NO.2.

"BID SCHEDULE A" (OPEN CUT) NOTES:

- LATERAL LOCATIONS SHOWN ARE BASED ON BEST AVAILABLE INFORMATION. CONTRACTOR TO FIELD VERIFY ALL EXISTING SANITARY LATERAL LOCATIONS AND DEPTHS, INSTALL 6" SDR 35 SEWER PIPE TO R/W LINE AND CONNECT TO EXISTING LATERAL.
- THE EXISTING MANHOLES ARE TO REMAIN IN PLACE WITH NEW SEWERS RECONNECTED. THE MANHOLES SHALL BE REHABILITATED PER THE MANHOLE REHABILITATION SCHEDULE.


BID SCHEDULES A & B NOTES:

- SANITARY LATERAL LEGEND:

A= DISTANCE FROM DOWN STREAM MANHOLE
X= APPROX. DEPTH AT R/W
Y= LENGTH FROM MAIN TO R/W

"BID SCHEDULE B" (CIPP) NOTES:

- LATERAL LOCATIONS SHOWN ARE BASED ON BEST AVAILABLE INFORMATION. CONTRACTOR TO FIELD VERIFY EXISTING SANITARY LATERAL LOCATIONS AND DEPTHS, FOR LATERAL REPLACEMENTS, MAKE CONNECTION DIRECTLY TO CIPP LINER AS SHOWN IN THE DETAILS AND ON SHEET C-16. INSTALL 6" SDR 35 SEWER PIPE FROM MAIN TO R/W LINE AND CONNECT TO EXISTING LATERAL.
- IF THE PLANS SHOW C.I.P.P. LATERAL REHABILITATION, COMPLETE PER THE DETAIL ON SHEET C-16.
- MANHOLE SHALL BE REHABILITATION PER THE MANHOLE REHABILITATION SCHEDULE.

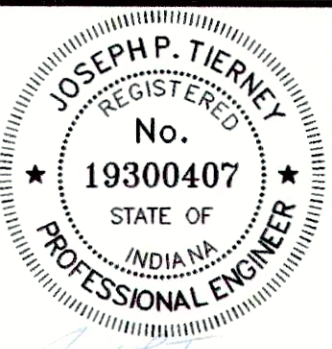

GRW PROJECT NO. 4447-14
SRF NO. WW16074803 ----
ALL RIGHTS RESERVED. NO PART OF THIS DOCUMENT SHALL BE REPRODUCED OR TRANSMITTED IN ANY FORM OR BY ANY MEANS, ELECTRONIC OR MECHANICAL, WITHOUT PERMISSION IN WRITING FROM GRW INC.



PLAN & PROFILE
SANITARY SEWER REHABILITATION
FALL CREEK REGIONAL WASTE DISTRICT
PENDLETON, INDIANA

DESIGNED	GWL	GCR	JPT	JPT
NO.	BY	DATE	DATE	DATE
1	---	---	---	---
2	---	---	---	---
DATE: APRIL 2016

SCALE: H: 1"=50' V: 1"=10'

SHEET NO.

C-11