


PLAN VIEW - B.O.P. STA. 0+00 TO E.O.P. STA. 3+88 LINE "B"

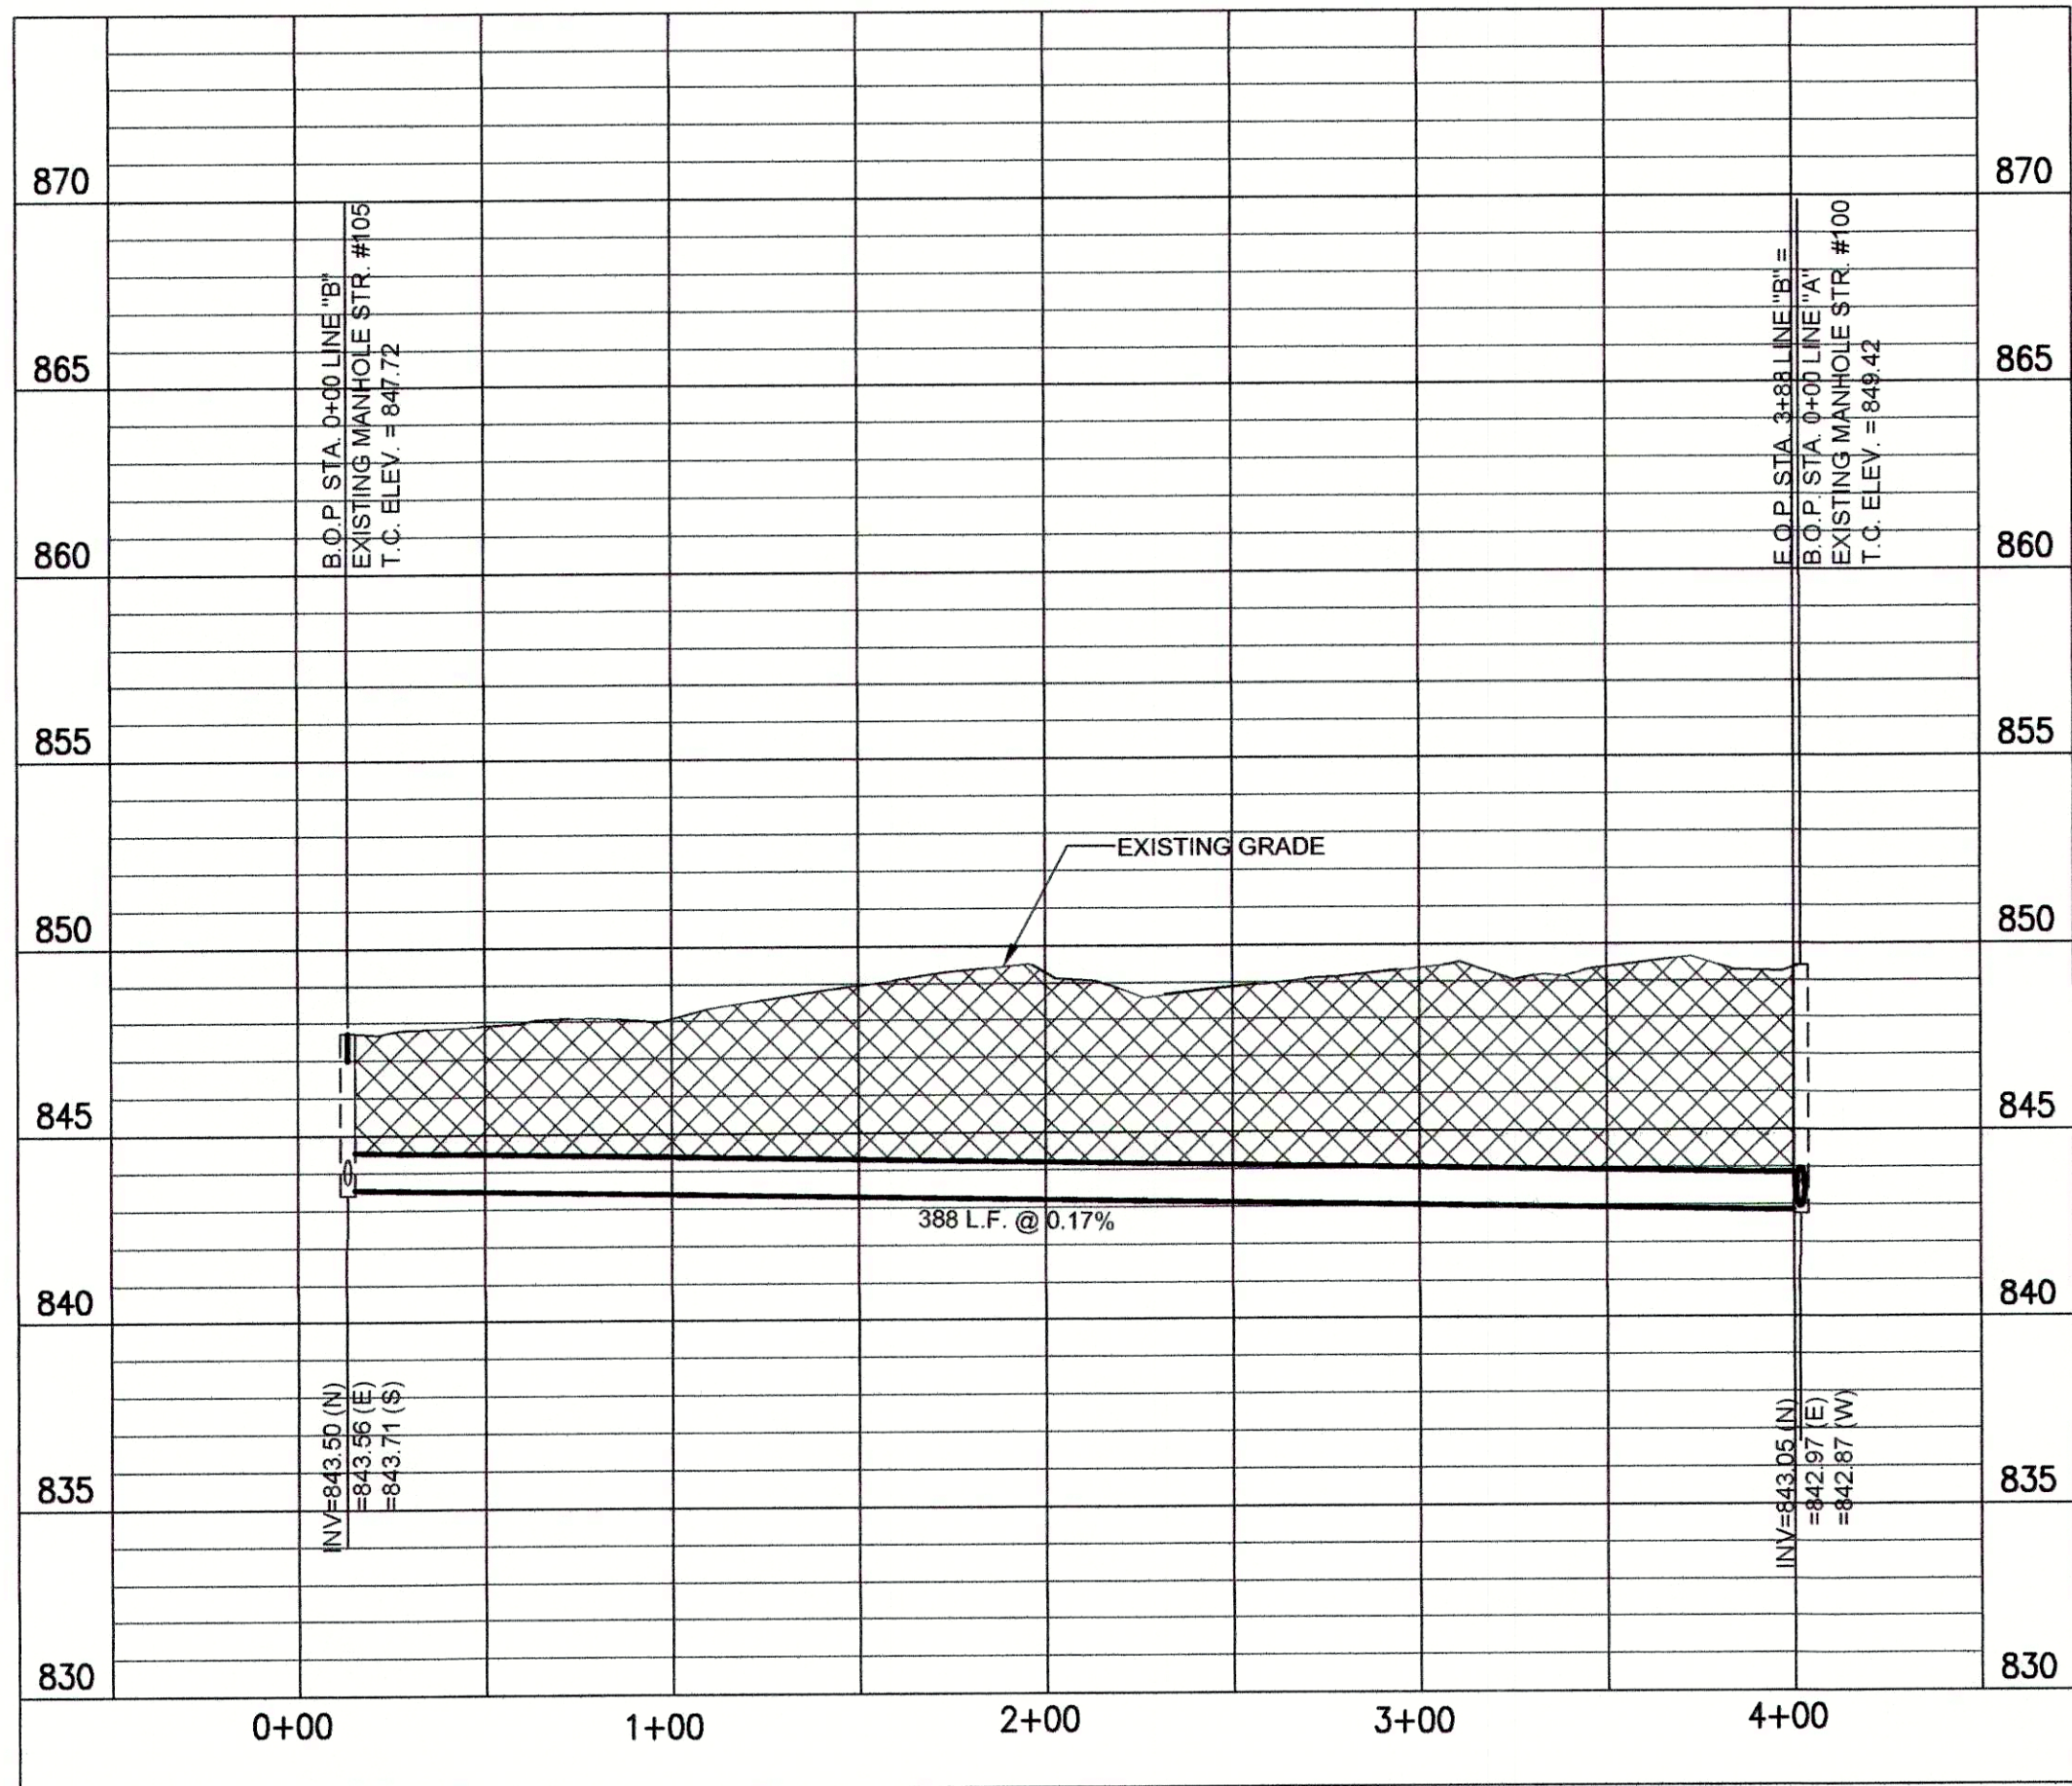

PROFILE - B.O.P. STA. 0+00 TO E.O.P. STA. 3+88 LINE "B"

① PRIVATE LATERALS TO BE REPLACED.  
SEE WORK DESCRIPTION IN MEASUREMENTS AND PAYMENT.

- NOTE:
1. THE WORK TO REPLACE THE MAINS AND RECONNECT TO THE LATERALS WITHIN RIGHT-OF-WAY SHALL BE INCLUDED IN THE BAS BID.
  2. THE WORK TO REPLACE THE PRIVATE LATERALS SHALL BE INCLUDED IN ALTERNATE NO. 2
  3. LATERAL LOCATIONS SHOWN ARE BASED ON BEST AVAILABLE INFORMATION. CONTRACTOR SHALL FIELD VERIFY EXISTING LATERAL LOCATIONS AND DEPTHS.
  4. THE 6" LATERAL SERVING TWO HOUSES OFF MCLOY DRIVE SHALL BE INCLUDED IN THE BASE BID, INSTALLED WITHIN THE RIGHT-OF-WAY AND PAID FOR AS 1 LONG SIDE LATERAL AND 1 SHORT SIDE LATERAL. THE PORTIONS ON PRIVATE PROPERTY SHALL BE PART OF ALTERNATE NO. 2

"BID SCHEDULE A" (OPEN CUT) NOTES:

1. LATERAL LOCATIONS SHOWN ARE BASED ON BEST AVAILABLE INFORMATION. CONTRACTOR TO FIELD VERIFY ALL EXISTING SANITARY LATERAL LOCATIONS AND DEPTHS, INSTALL 6" SDR 35 SEWER PIPE TO R/W LINE AND CONNECT TO EXISTING LATERAL.
2. THE EXISTING MANHOLES ARE TO REMAIN IN PLACE WITH NEW SEWERS RECONNECTED. THE MANHOLES SHALL BE REHABILITATED PER THE MANHOLE REHABILITATION SCHEDULE.

"BID SCHEDULE B" (CIPP) NOTES:

1. LATERAL LOCATIONS SHOWN ARE BASED ON BEST AVAILABLE INFORMATION. CONTRACTOR TO FIELD VERIFY EXISTING SANITARY LATERAL LOCATIONS AND DEPTHS, FOR LATERAL REPLACEMENTS, MAKE CONNECTION DIRECTLY TO CIPP LINER AS SHOWN IN THE DETAILS AND ON SHEET C-16. INSTALL 6" SDR 35 SEWER PIPE FROM MAIN TO R/W LINE AND CONNECT TO EXISTING LATERAL.
2. IF THE PLANS SHOW C.I.P.P. LATERAL REHABILITATION, COMPLETE PER THE DETAIL ON SHEET C-16.
3. MANHOLE SHALL BE REHABILITATION PER THE MANHOLE REHABILITATION SCHEDULE.

JOSEPH P. TIERNEY  
REGISTERED  
No  
19300407  
STATE OF  
INDIANA  
PROFESSIONAL ENGINEER

GRW PROJECT NO. 4447-14

SRF NO. WW16074803

ALL RIGHTS RESERVED. PROPERTY OF  
GRW ENGINEERS, INC. AND SHALL NOT  
BE REPRODUCED OR TRANSMITTED IN  
ANY FORM OR BY ANY MEANS, ELECTRONIC  
OR MECHANICAL, INCLUDING PHOTOCOPYING,  
RECORDING, OR BY ANY INFORMATION  
SYSTEMS, WITHOUT WRITTEN PERMISSION.

engineering | architecture | geospatial  
www.grwinc.com

PLAN & PROFILE  
SANITARY SEWER REHABILITATION  
FALL CREEK REGIONAL WASTE DISTRICT  
PENDLETON, INDIANA

DESIGNED	GWL
DRAWN	GCR
REVIEWED	JPT
APPROVED	JPT

DATE: APRIL 2016  
SCALE: H: 1"=50' V: 1"=10'  
SHEET NO.

C-13

BID SET