
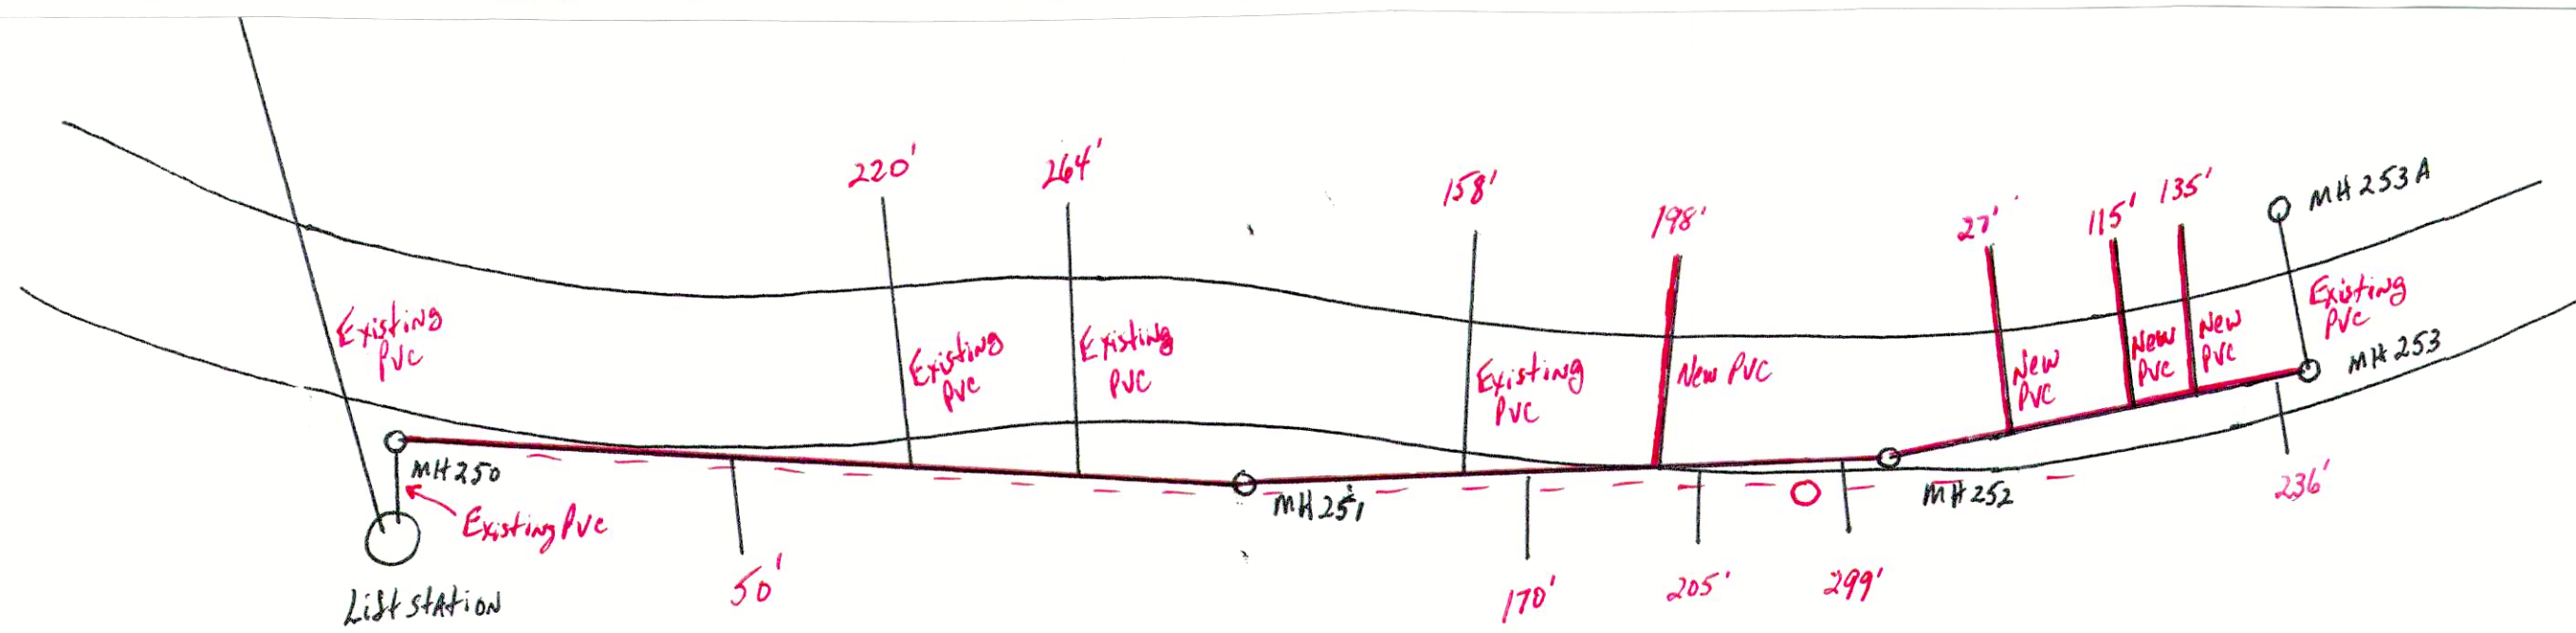


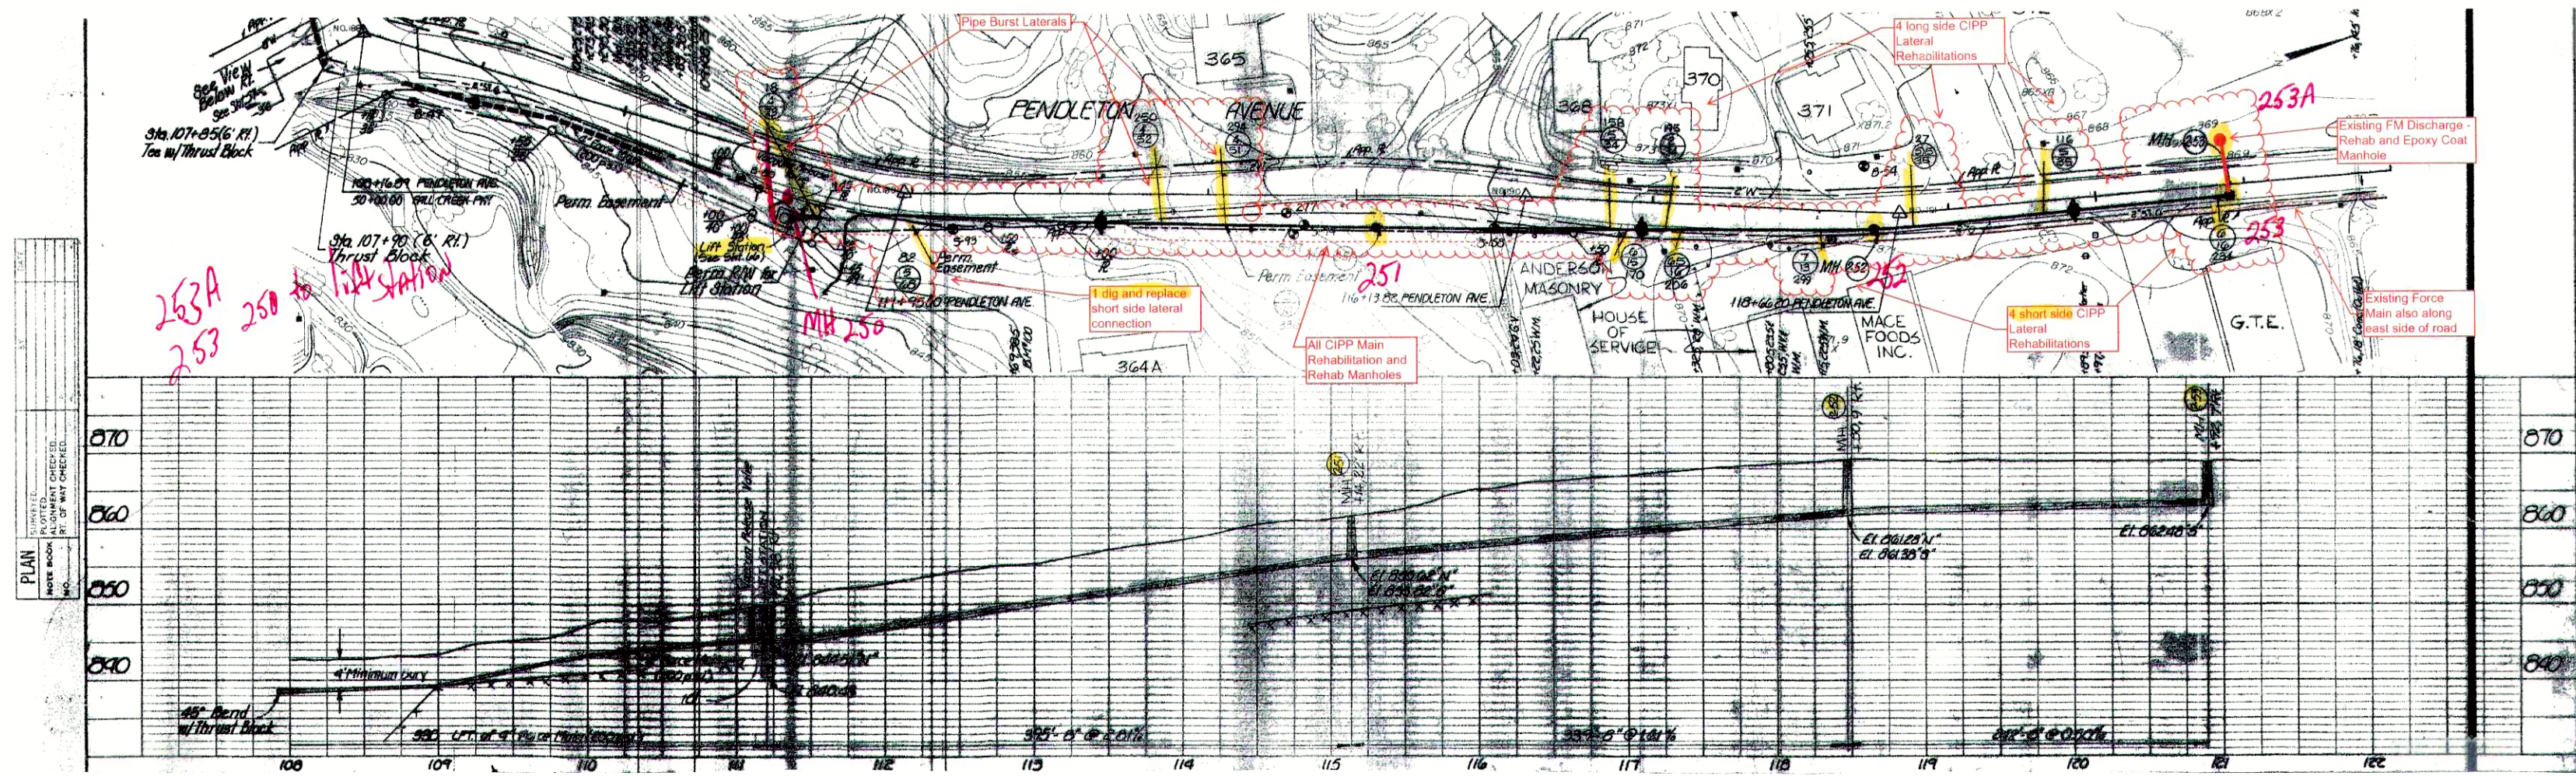

N. Pendleton

MH#250 to MH#253 CIPP

Existing force main on east side of the road

Rehab all manholes/epoxy coat

North



South

JOSEPH P. TIERNEY
REGISTERED
No.
19300407
STATE OF
INDIANA
PROFESSIONAL ENGINEER

GRW PROJECT NO. 4447-14

SRF NO. WW16074003

ALL RIGHTS RESERVED. THE PROPERTY OF
GRW ENGINEERS, INC. AND SHALL NOT
BE REPRODUCED OR TRANSMITTED IN ANY
FORM OR BY ANY MEANS, ELECTRONIC OR
MECHANICAL, WITHOUT WRITTEN PERMISSION



engineering | architecture | geospatial

www.grwinc.com

PLAN & PROFILE ADDITIONAL AREA
SANITARY SEWER REHABILITATION
FALL CREEK REGIONAL WASTE DISTRICT
PENDLETON, INDIANA

DESIGNED		GWL		GCR		JPT		JPT	
NO.	DATE	BY	DATE	BY	DATE	BY	DATE	BY	DATE

DATE: APRIL 2016
SCALE: N.T.S.
SHEET NO. C-13 A

BID SET