


NOTE: FIELD DRAIN REPLACEMENT SHALL BE INCLUDED IN UNIT PRICE FOR GRAVITY SEWER INSTALLATION.


FIELD DRAIN REPLACEMENT DETAIL

SCALE: N.T.S.

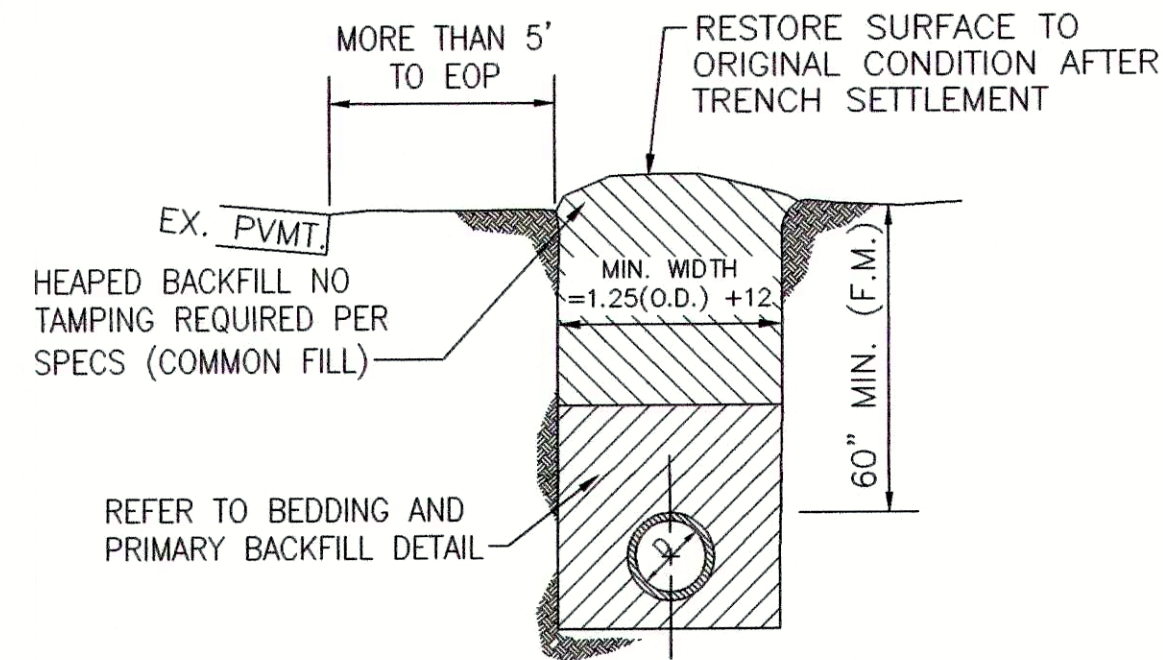


OPEN TERRAIN - METHOD "A"

SCALE: N.T.S.

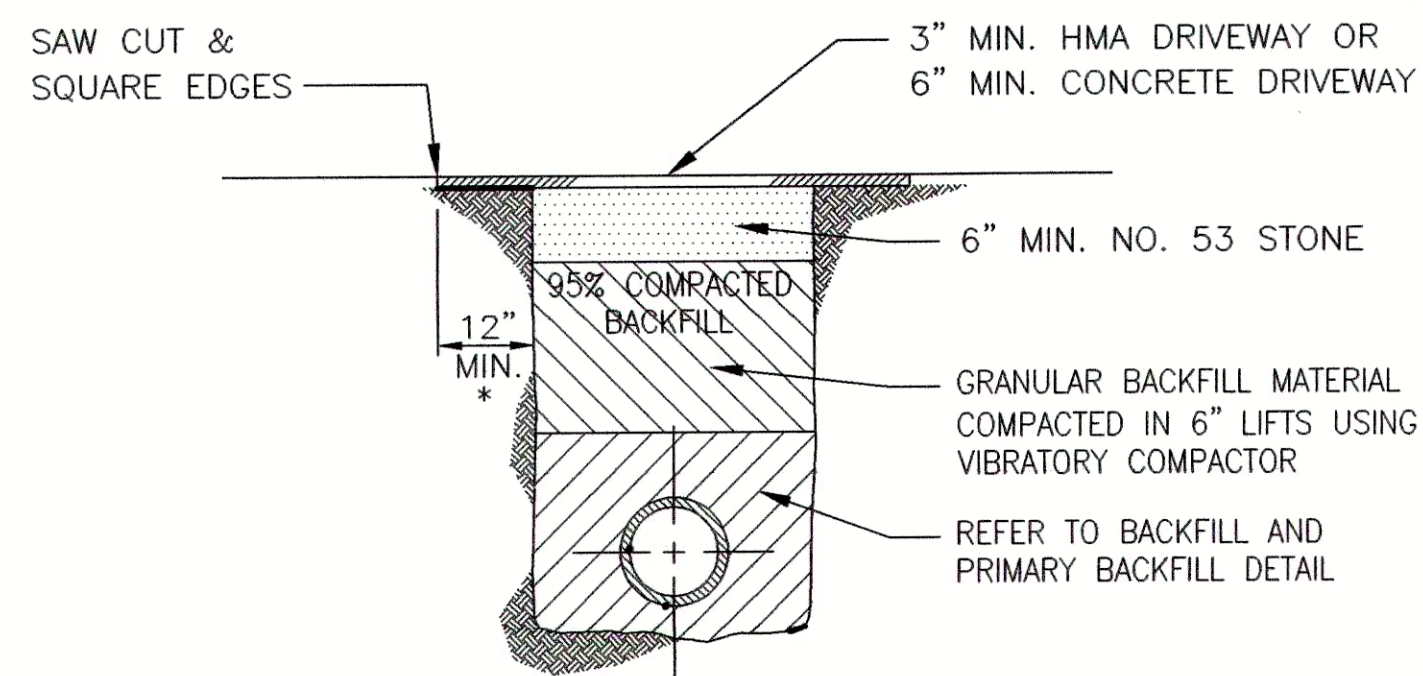

PAVED DRIVEWAYS - METHOD "D1"


SCALE: N.T.S.

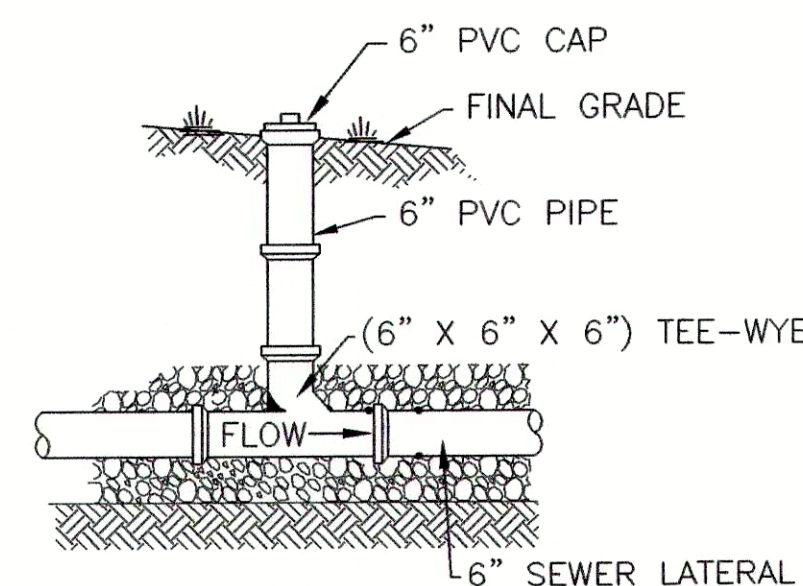

TYPE I - LANDSCAPE CLEANOUT DETAIL

SCALE: N.T.S.


NOTE: FOR PRIVATE LATERAL REPLACEMENTS, CLEANOUT SHALL BE WITHIN 5 FT. OF THE HOME AND EVERY 100 FT.

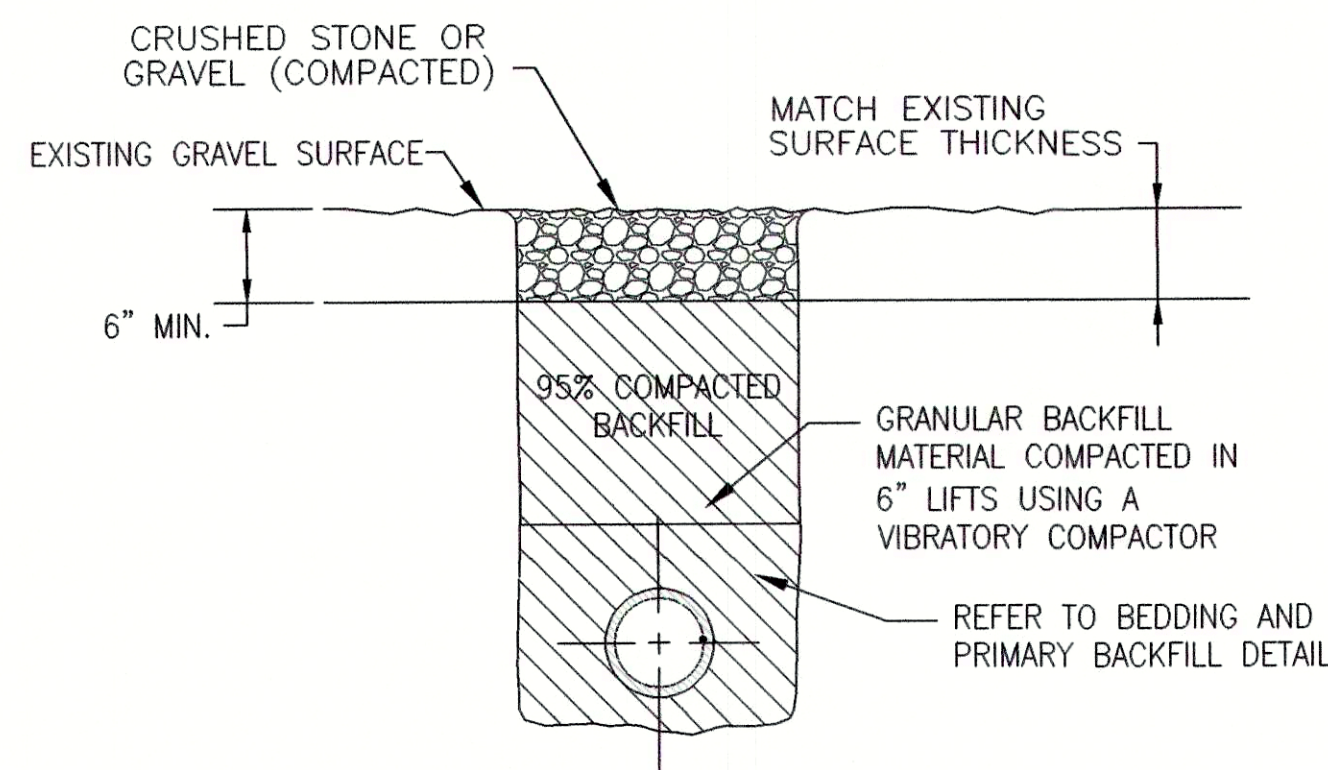

GRAVEL DRIVEWAYS - METHOD "B"


SCALE: N.T.S.

NOTES:
1.) GRANULAR BACKFILL MECHANICAL COMPACTION TO 95% PROCTOR DENSITY UNDER OR WITHIN 5 FEET OF PAVEMENT.

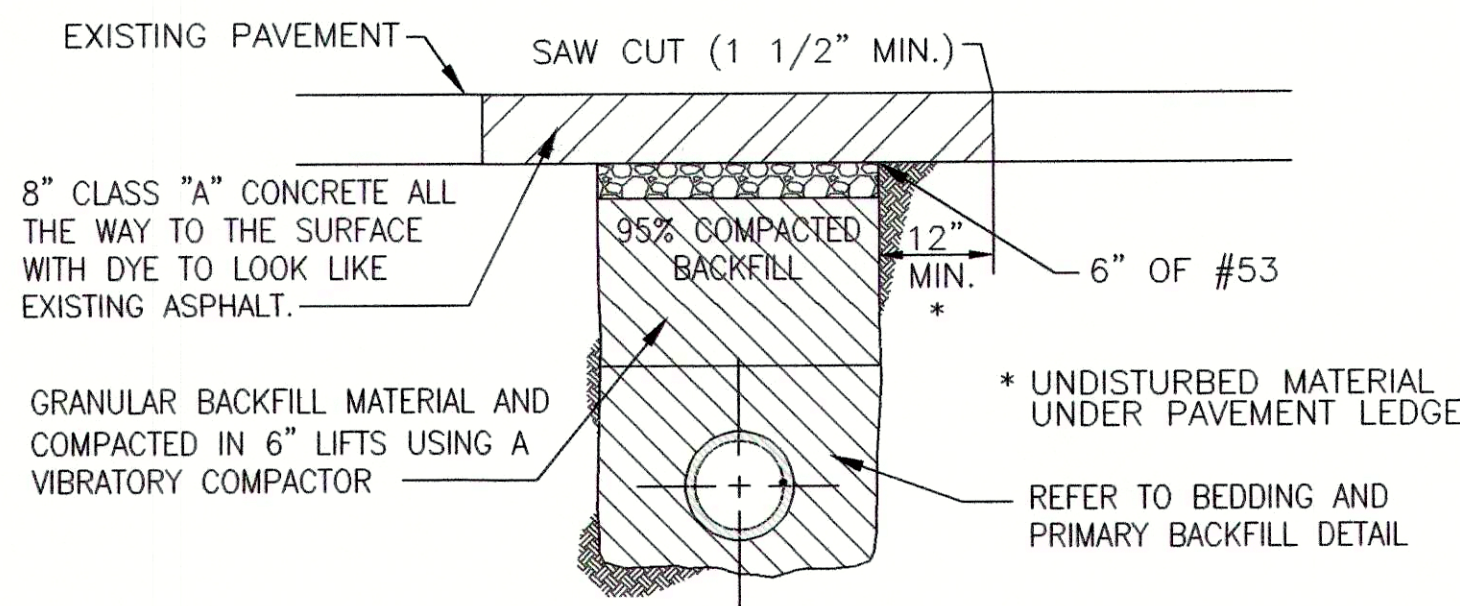


PAVED ALLEY DETAIL - METHOD "C1"

SCALE: N.T.S.

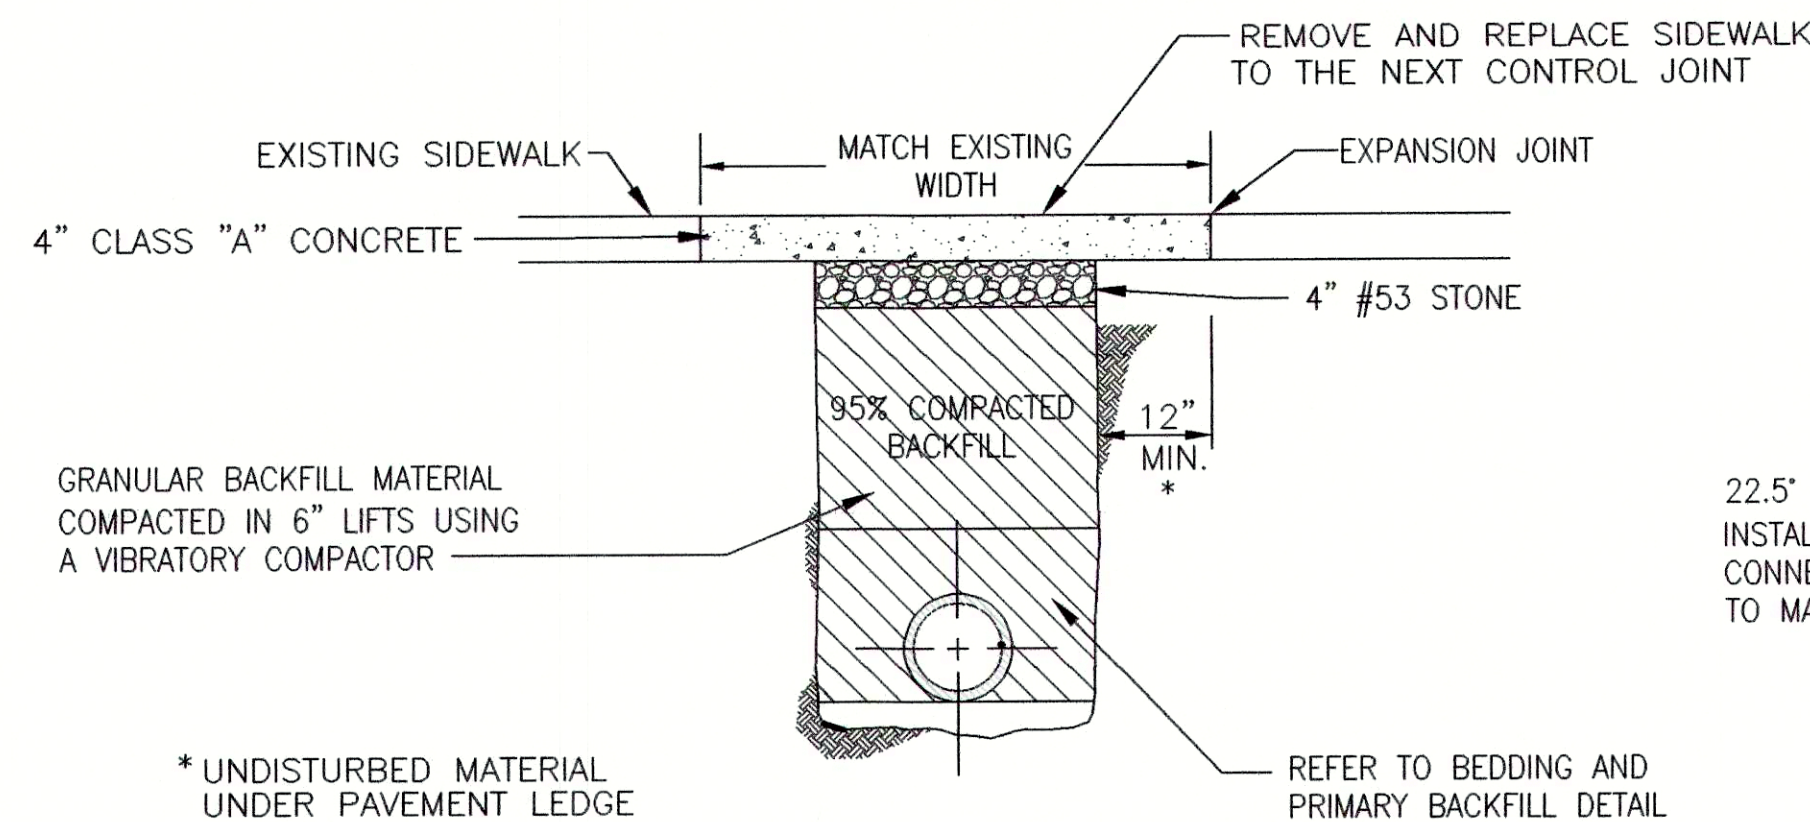


CONCRETE SIDEWALKS - METHOD "D2"

SCALE: N.T.S.

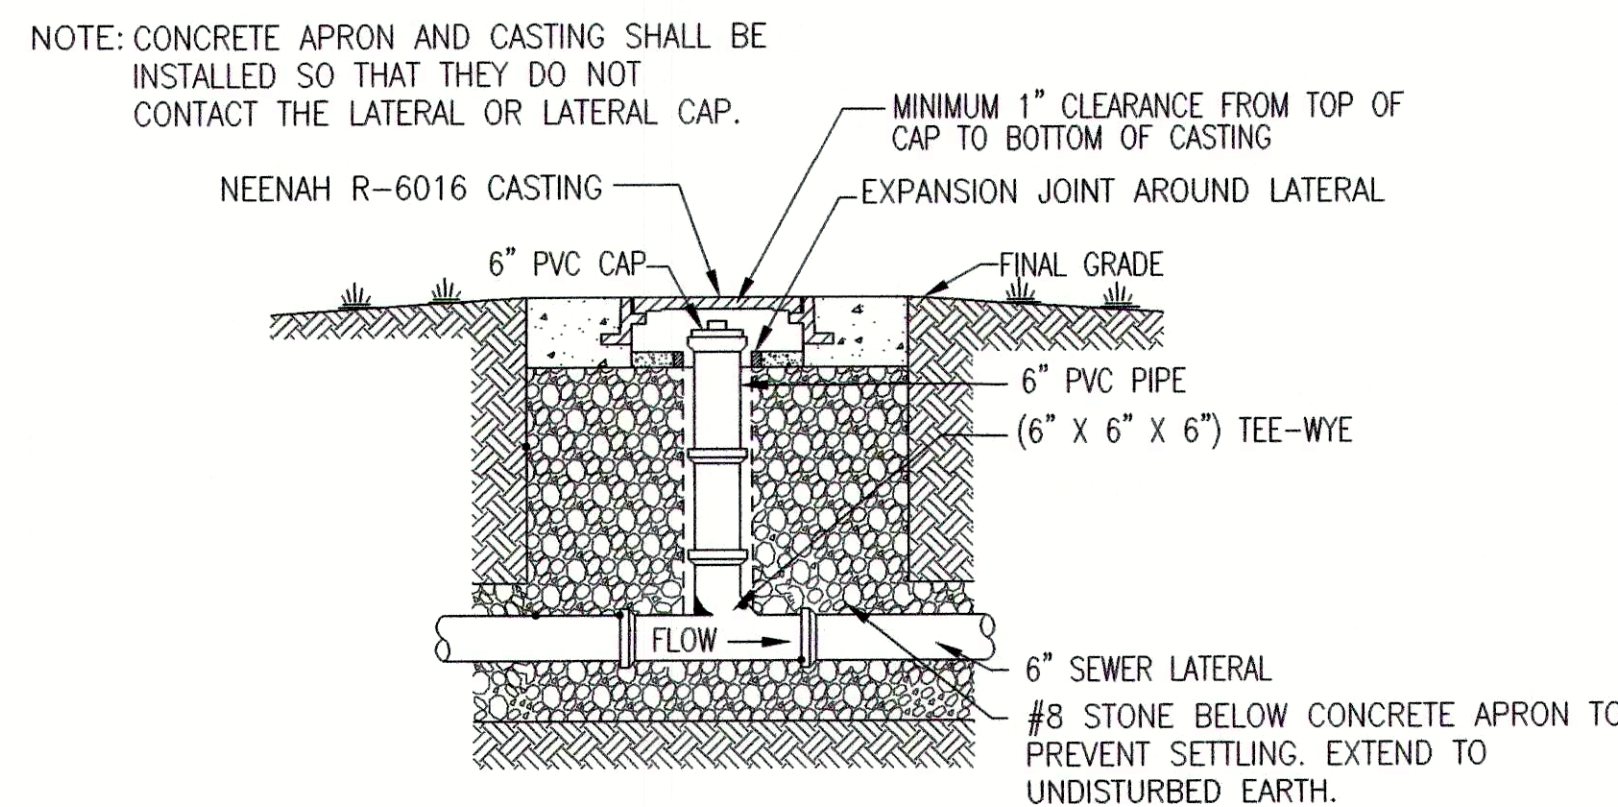


TYPE II - HARDSCAPE CLEANOUT DETAIL

SCALE: N.T.S.

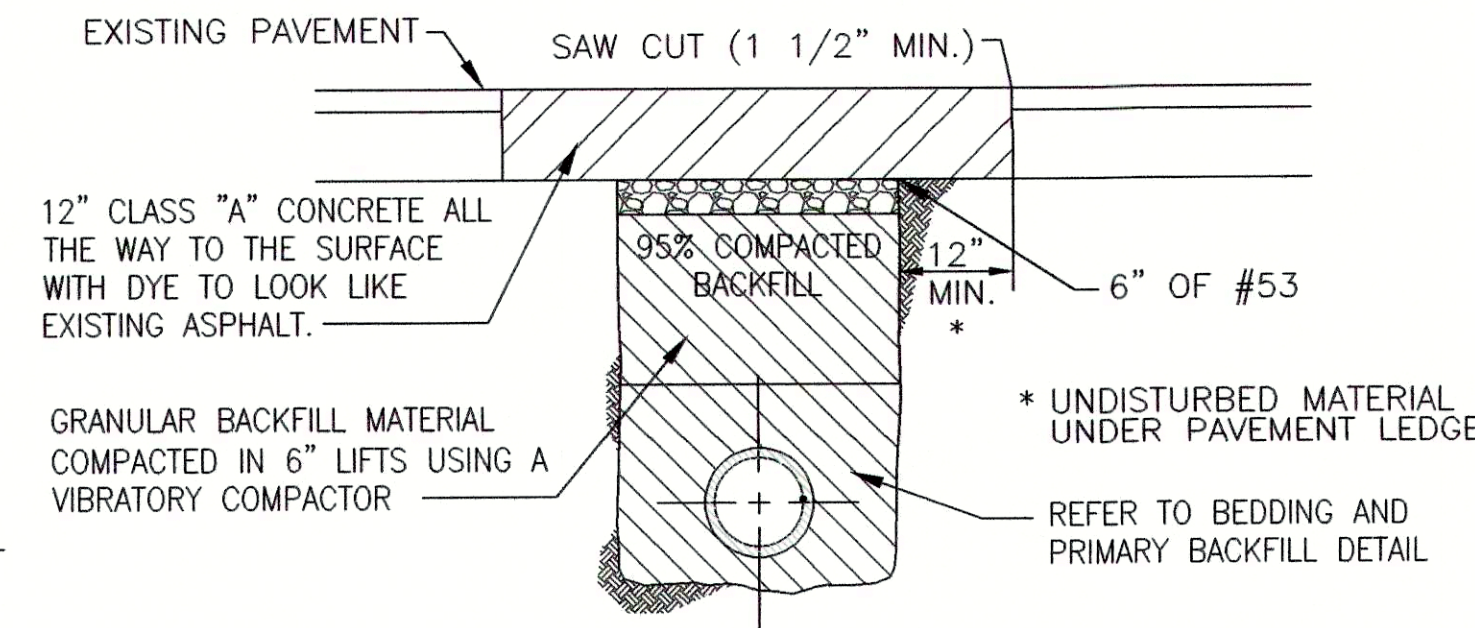


ROADWAYS DETAIL - METHOD "C"

SCALE: N.T.S.

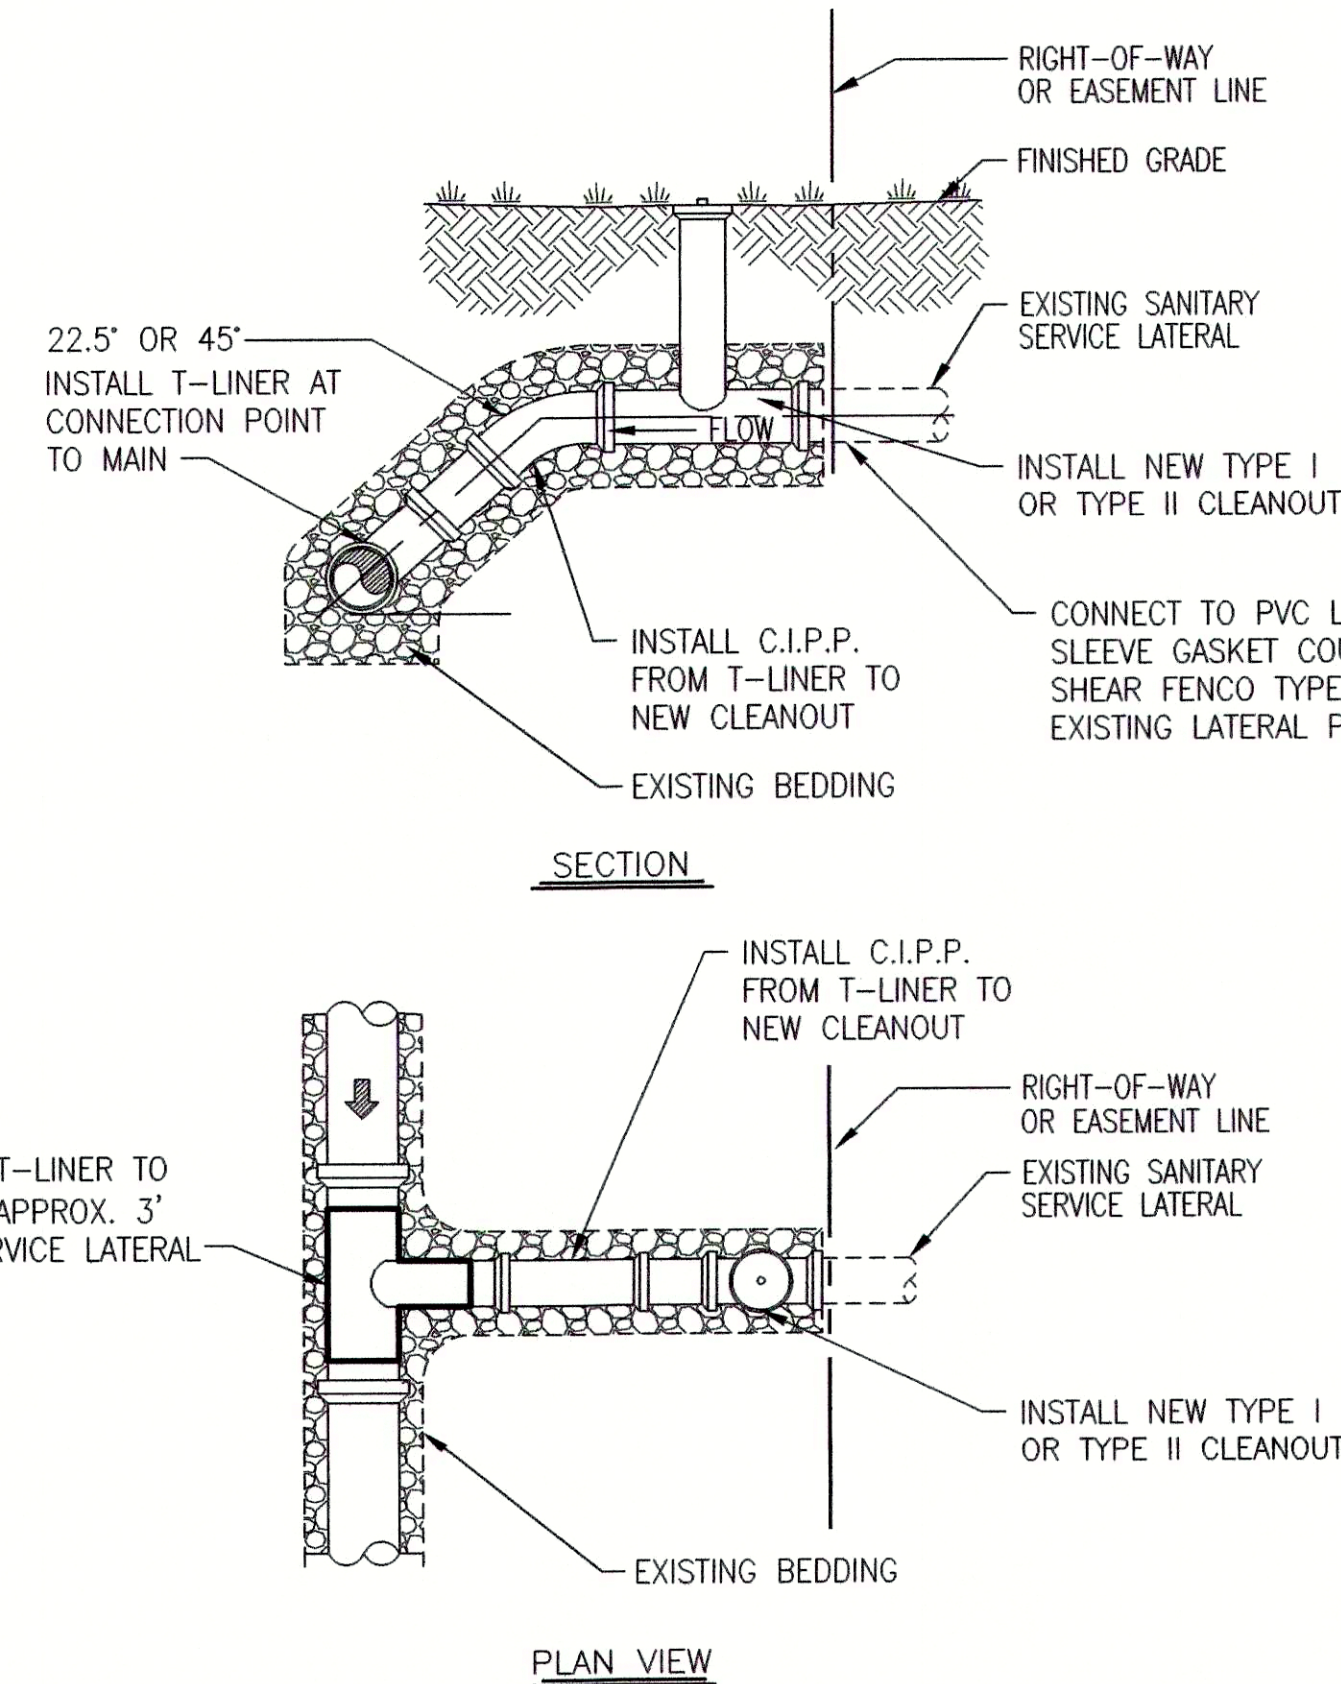

CIPP SERVICE LATERAL LINING DETAILS



SCALE: N.T.S.

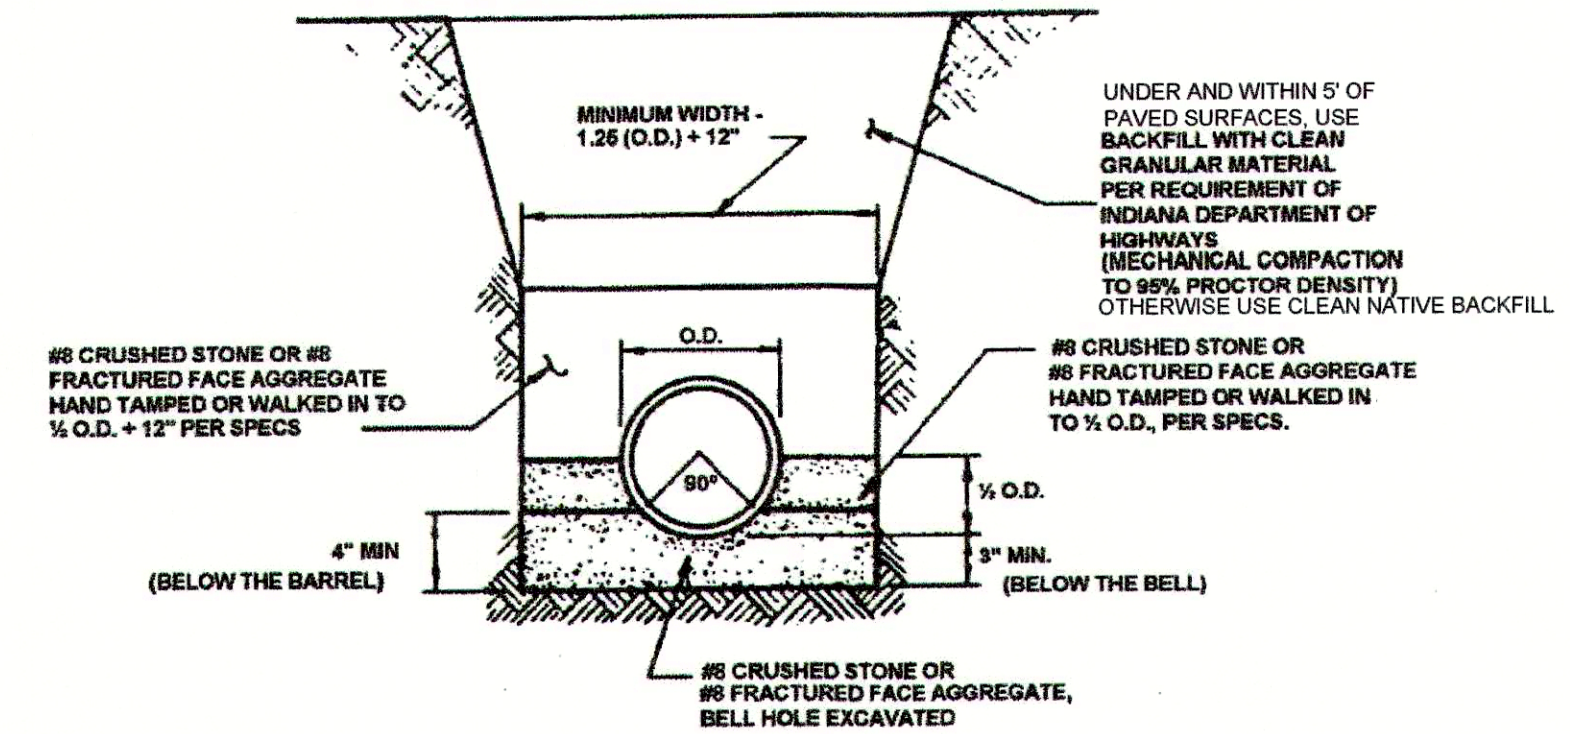

FLEXIBLE PIPE BEDDING DETAIL - PVC AND HDPE PIPE

SCALE: N.T.S.

PIPE SIZE	8" TO 15"	16" & OVER
BEDDING BELOW THE PIPE BARREL	O.D. / 4 MIN. = 4"	O.D. / 4 MAX. = 6"

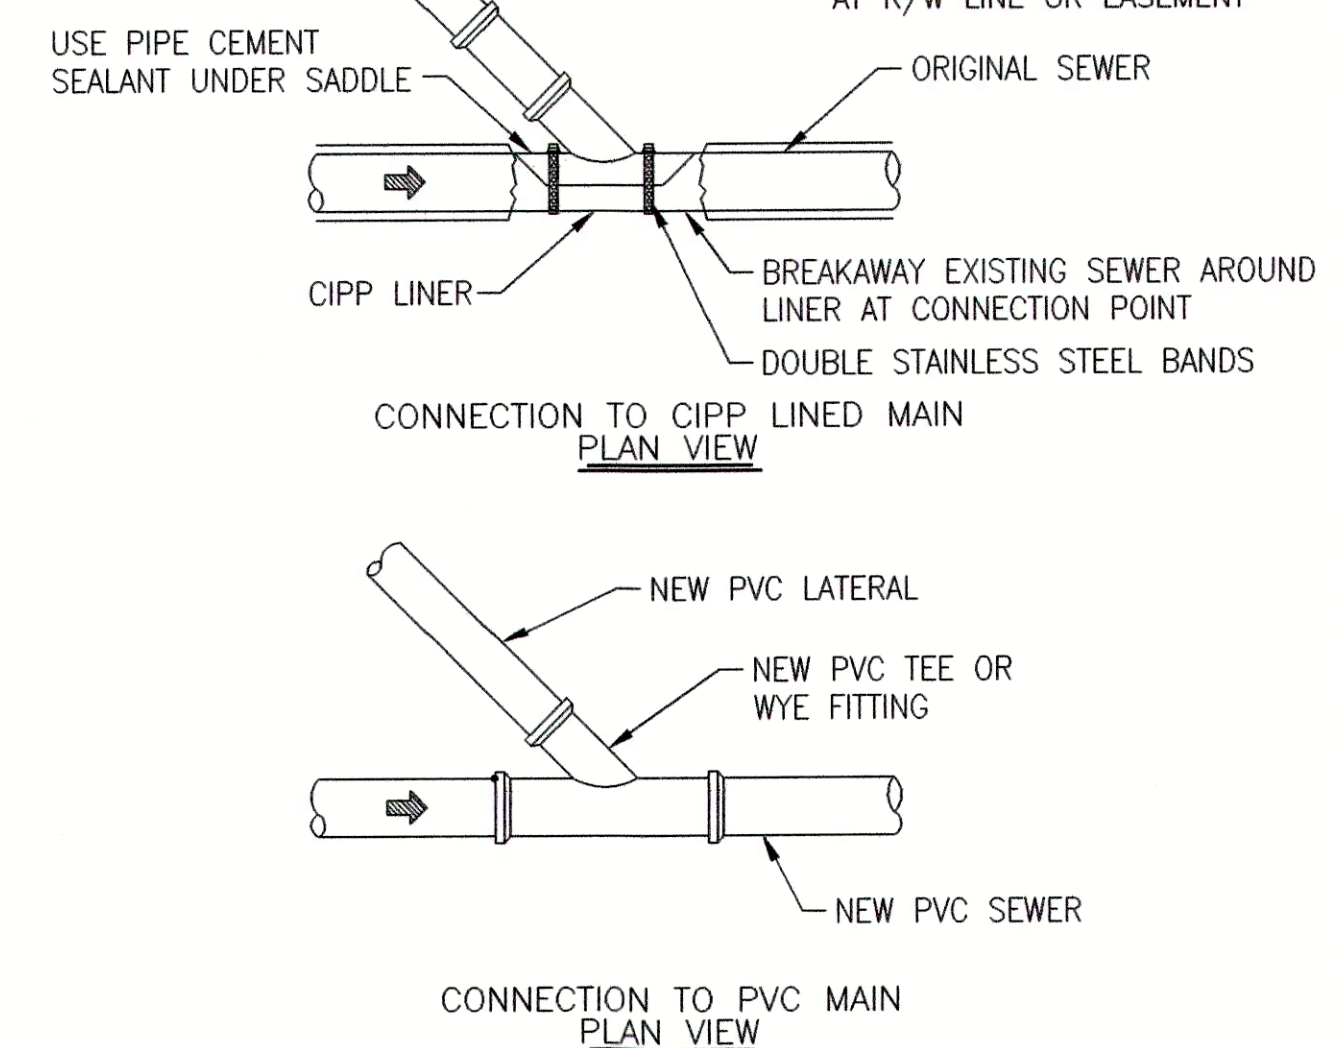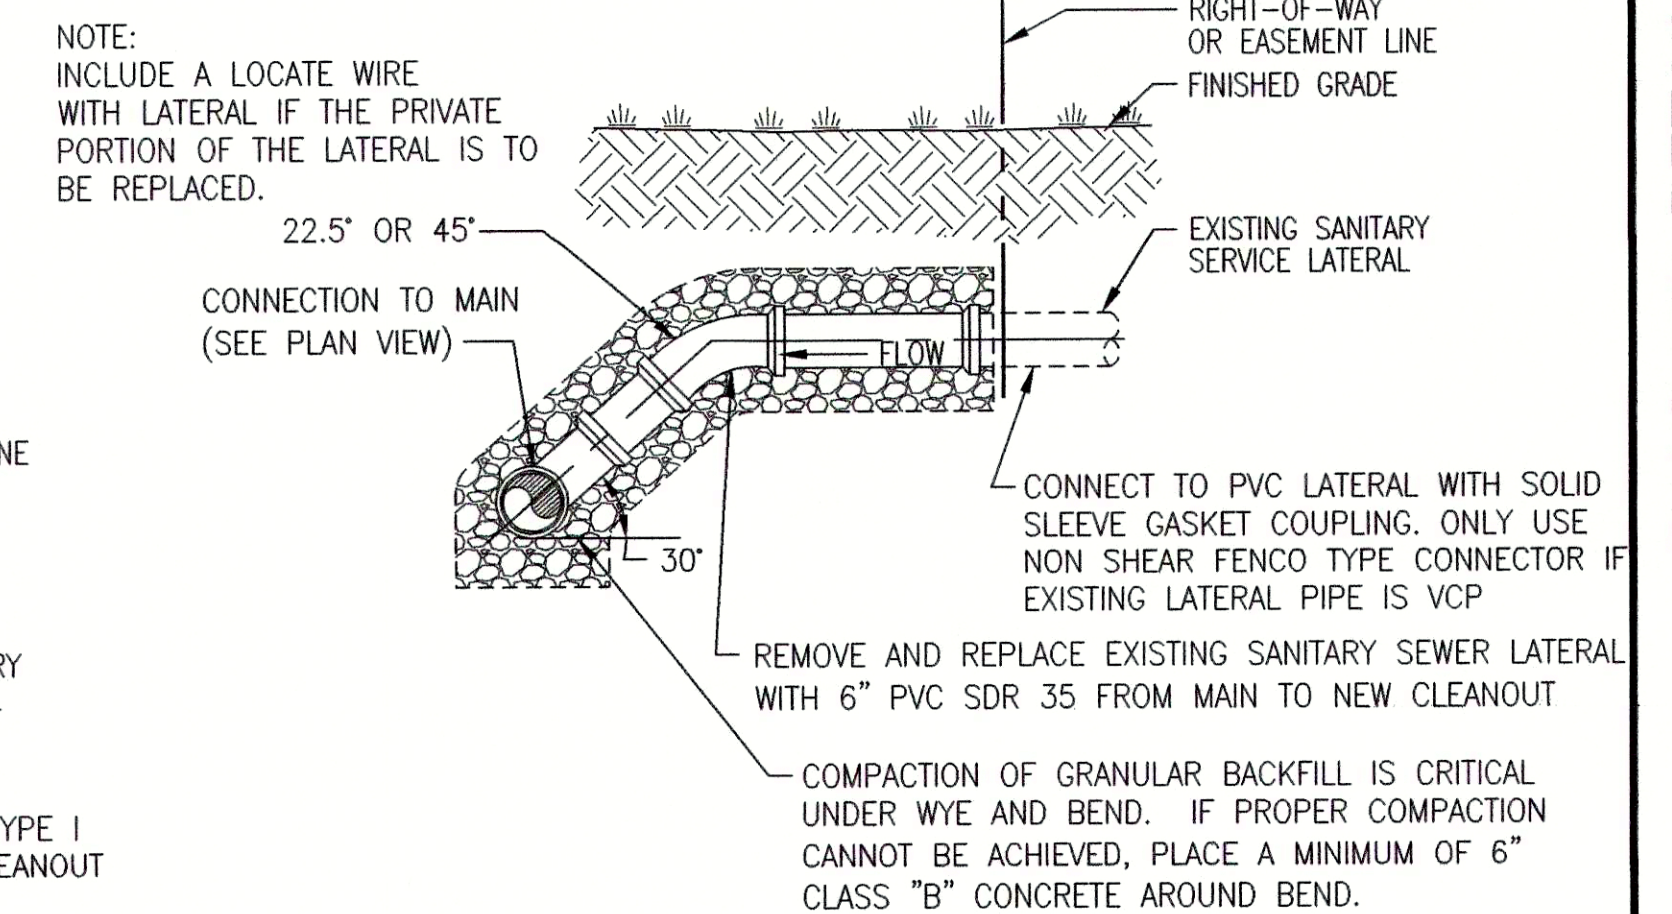

DIG AND REPLACE SERVICE LATERAL DETAILS

SCALE: N.T.S.

JOSEPH P. TIERNY
REGISTERED
No. 19300407
STATE OF INDIANA
PROFESSIONAL ENGINEER

engineering | architecture | geospatial
www.gwinc.com

STANDARD DETAILS
SANITARY SEWER REHABILITATION
FALL CREEK REGIONAL WASTE DISTRICT
PENDLETON, INDIANA

DESIGNED	GWL	GCR	JPT	JPT
DATE	DATE	DATE	DATE	DATE
BY	BY	BY	BY	BY
NO.	NO.	NO.	NO.	NO.

APRIL 2016
N.T.S.
C-16