
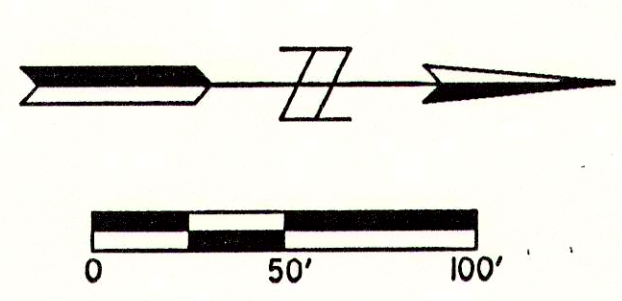


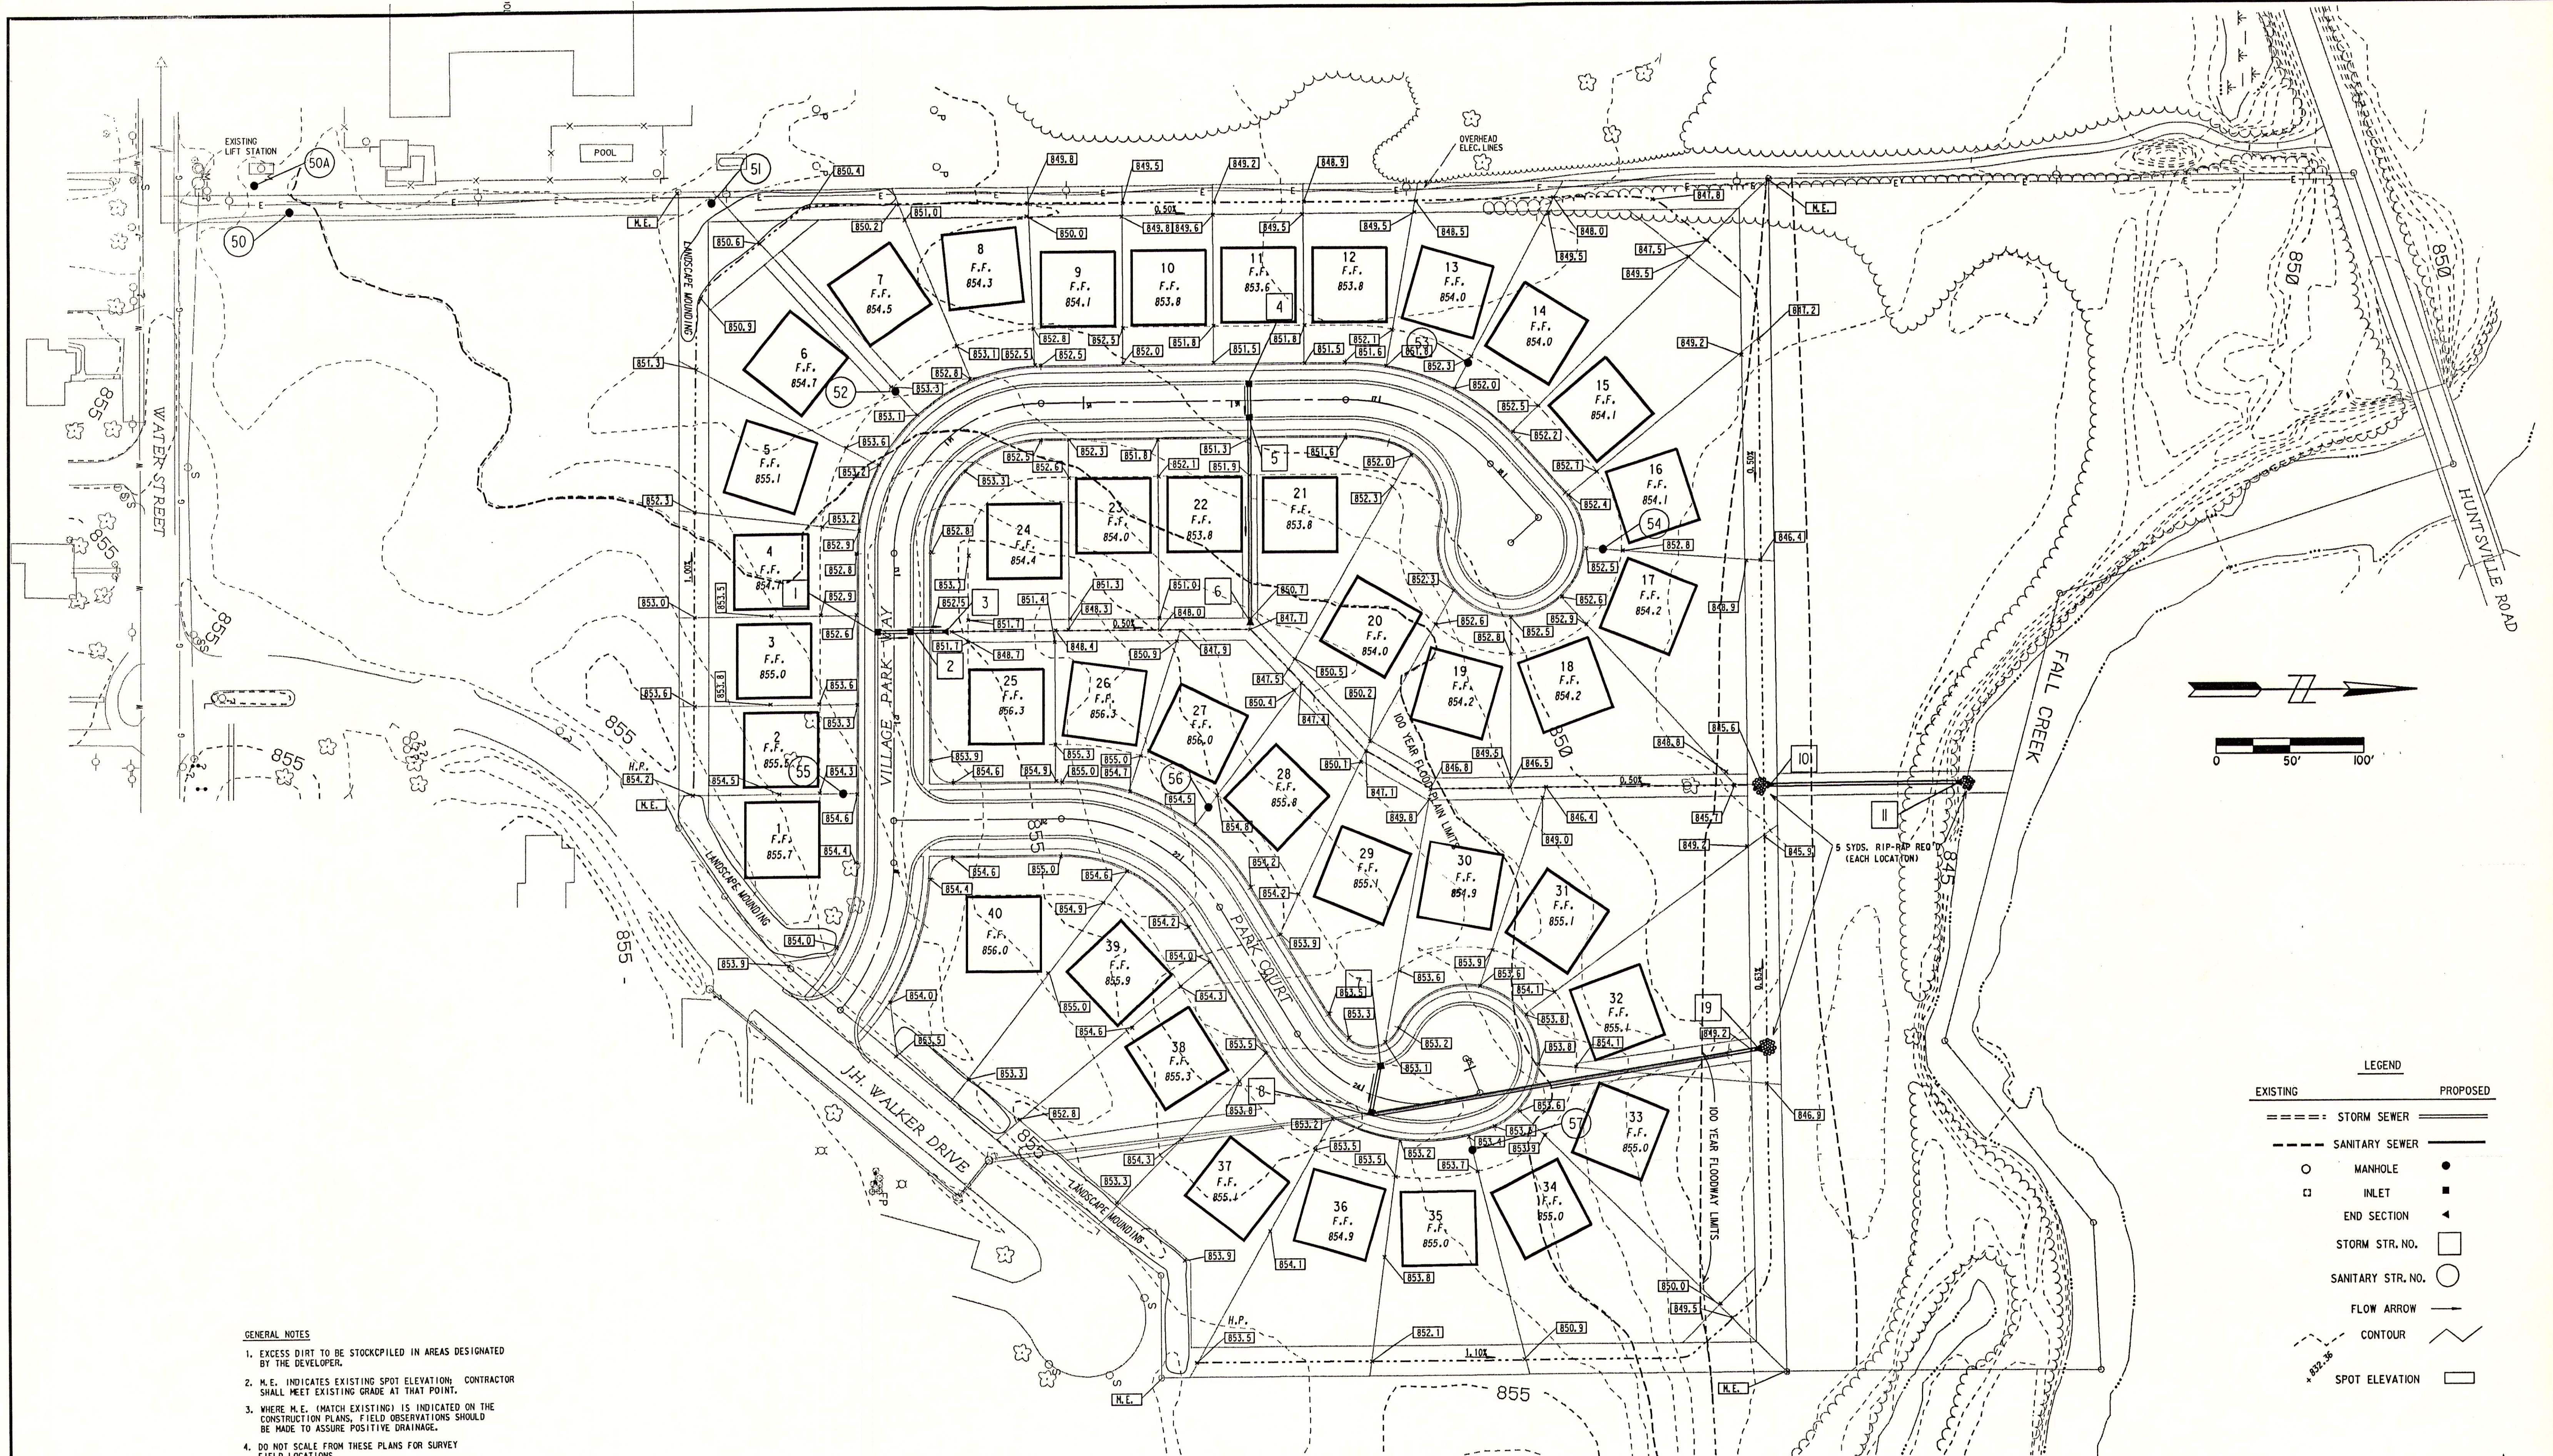


- GENERAL NOTES**
1. EXCESS DIRT TO BE STOCKPILED IN AREAS DESIGNATED BY THE DEVELOPER.
 2. M.E. INDICATES EXISTING SPOT ELEVATION; CONTRACTOR SHALL MEET EXISTING GRADE AT THAT POINT.
 3. WHERE M.E. (MATCH EXISTING) IS INDICATED ON THE CONSTRUCTION PLANS, FIELD OBSERVATIONS SHOULD BE MADE TO ASSURE POSITIVE DRAINAGE.
 4. DO NOT SCALE FROM THESE PLANS FOR SURVEY FIELD LOCATIONS.
 5. CHECK BENCHMARK WITH EXISTING GRADES AND EXISTING TOPOGRAPHY BEFORE BEGINNING CONSTRUCTION. ANY DISCREPANCIES MUST BE REPORTED TO THE ENGINEER IMMEDIATELY.
 6. BEFORE ANY EARTHWORK IS PERFORMED, THE CONTRACTOR IS RESPONSIBLE FOR LOCATING ALL EXISTING UTILITIES WITHIN, OR BORDERING, THE SITE.
 7. FOR STREET PROFILES, SEE SHEETS 7 AND 8.
 8. SEE SHEET 9 FOR INTERSECTIONS AND CUL-DE-SAC DETAILS.
 9. FINISH FLOOR (F.F.) ELEVATIONS SET FOR CRAWL SPACE CONSTRUCTION.

- LEGEND**
- | EXISTING | PROPOSED | |
|----------|----------|-------------------|
| ===== | ===== | STORM SEWER |
| ----- | ----- | SANITARY SEWER |
| ○ | ● | MANHOLE |
| □ | ■ | INLET |
| | ◄ | END SECTION |
| | □ | STORM STR. NO. |
| | ○ | SANITARY STR. NO. |
| | → | FLOW ARROW |
| - - - - | ~ ~ ~ | CONTOUR |
| 852.26 | □ | SPOT ELEVATION |

BENCHMARK DESCRIPTION
T.B.M. PK SET EAST FACE PWP #C245
3RD POLE NORTH OF WATER ST.
NEAR WEST R. ELEV. 852.42

Revisions and Dates	Designed by
9-14-89 REVISED 100YR. FLOODWAY LOCATION	D.B.H.
11-1-89 REVISED GRADES ON PARK COURT	Drawn by
	Checked by
	Approved by
	Date: 7/6/89

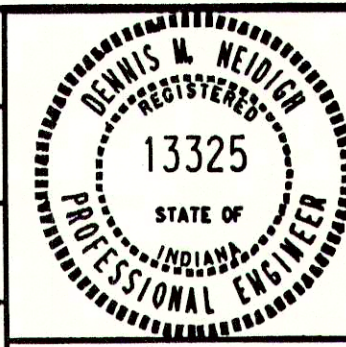

MSE Engineering
MSE Corporation
941 North Meridian Street
Indianapolis, IN 46204-1061
317 634-1000
317 634-3576 FAX