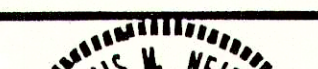


Revisions and Dates	Designed by D.B.H.		MSE Engineering MSE Corporation 941 North Meridian Street Indianapolis, IN 46204-1061 317 634-1000 317 634-3576 FAX	Title: UTILITY PLAN
7/31/89 REVISED STR. 11 TO AUTO. DRAINAGE TAGE	Drawn by:			
9/14/89 REVISED WATER LINE				
11/1/89 REVISED SAN. AND STORM SEWERS	Checked by:			
	Approved by:			
	Date: 7/6/89			
Scale: 1" = 50' Job No. 111-0295 Sheet No. 6 of 10				