
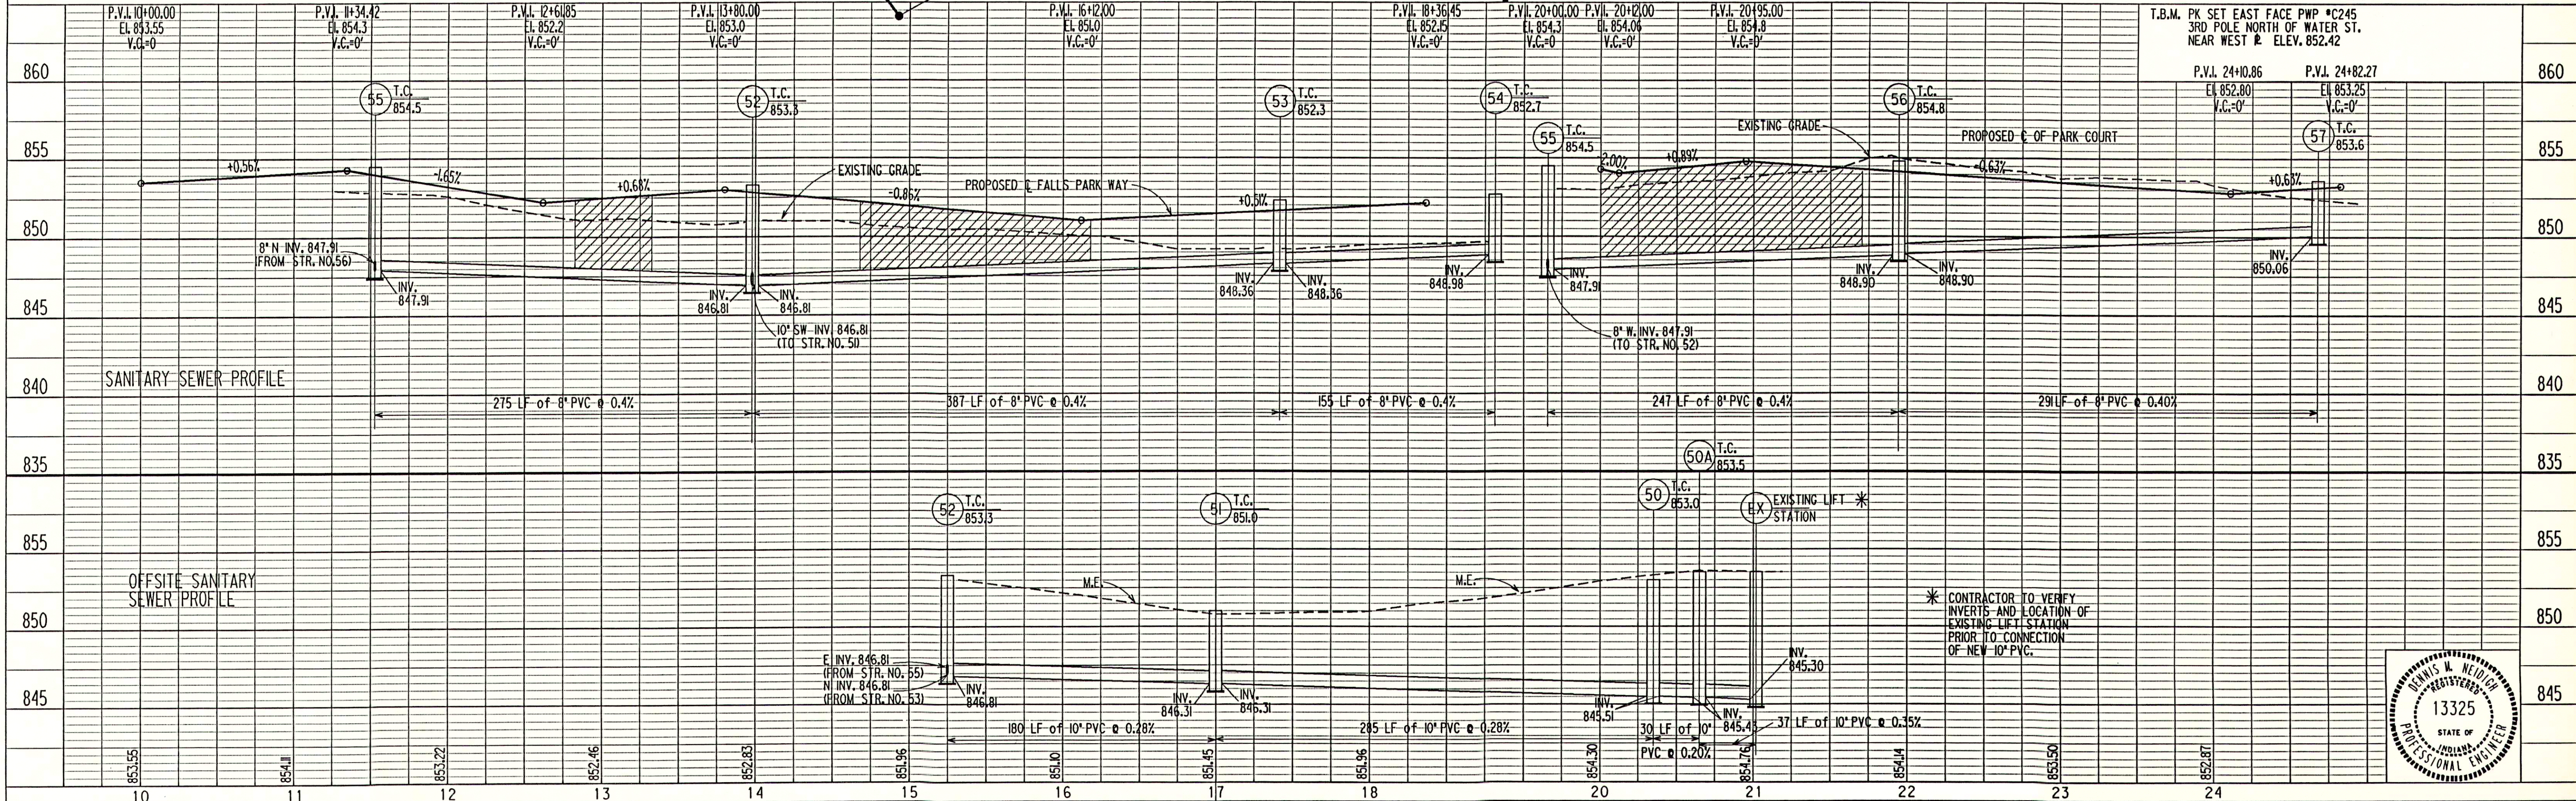
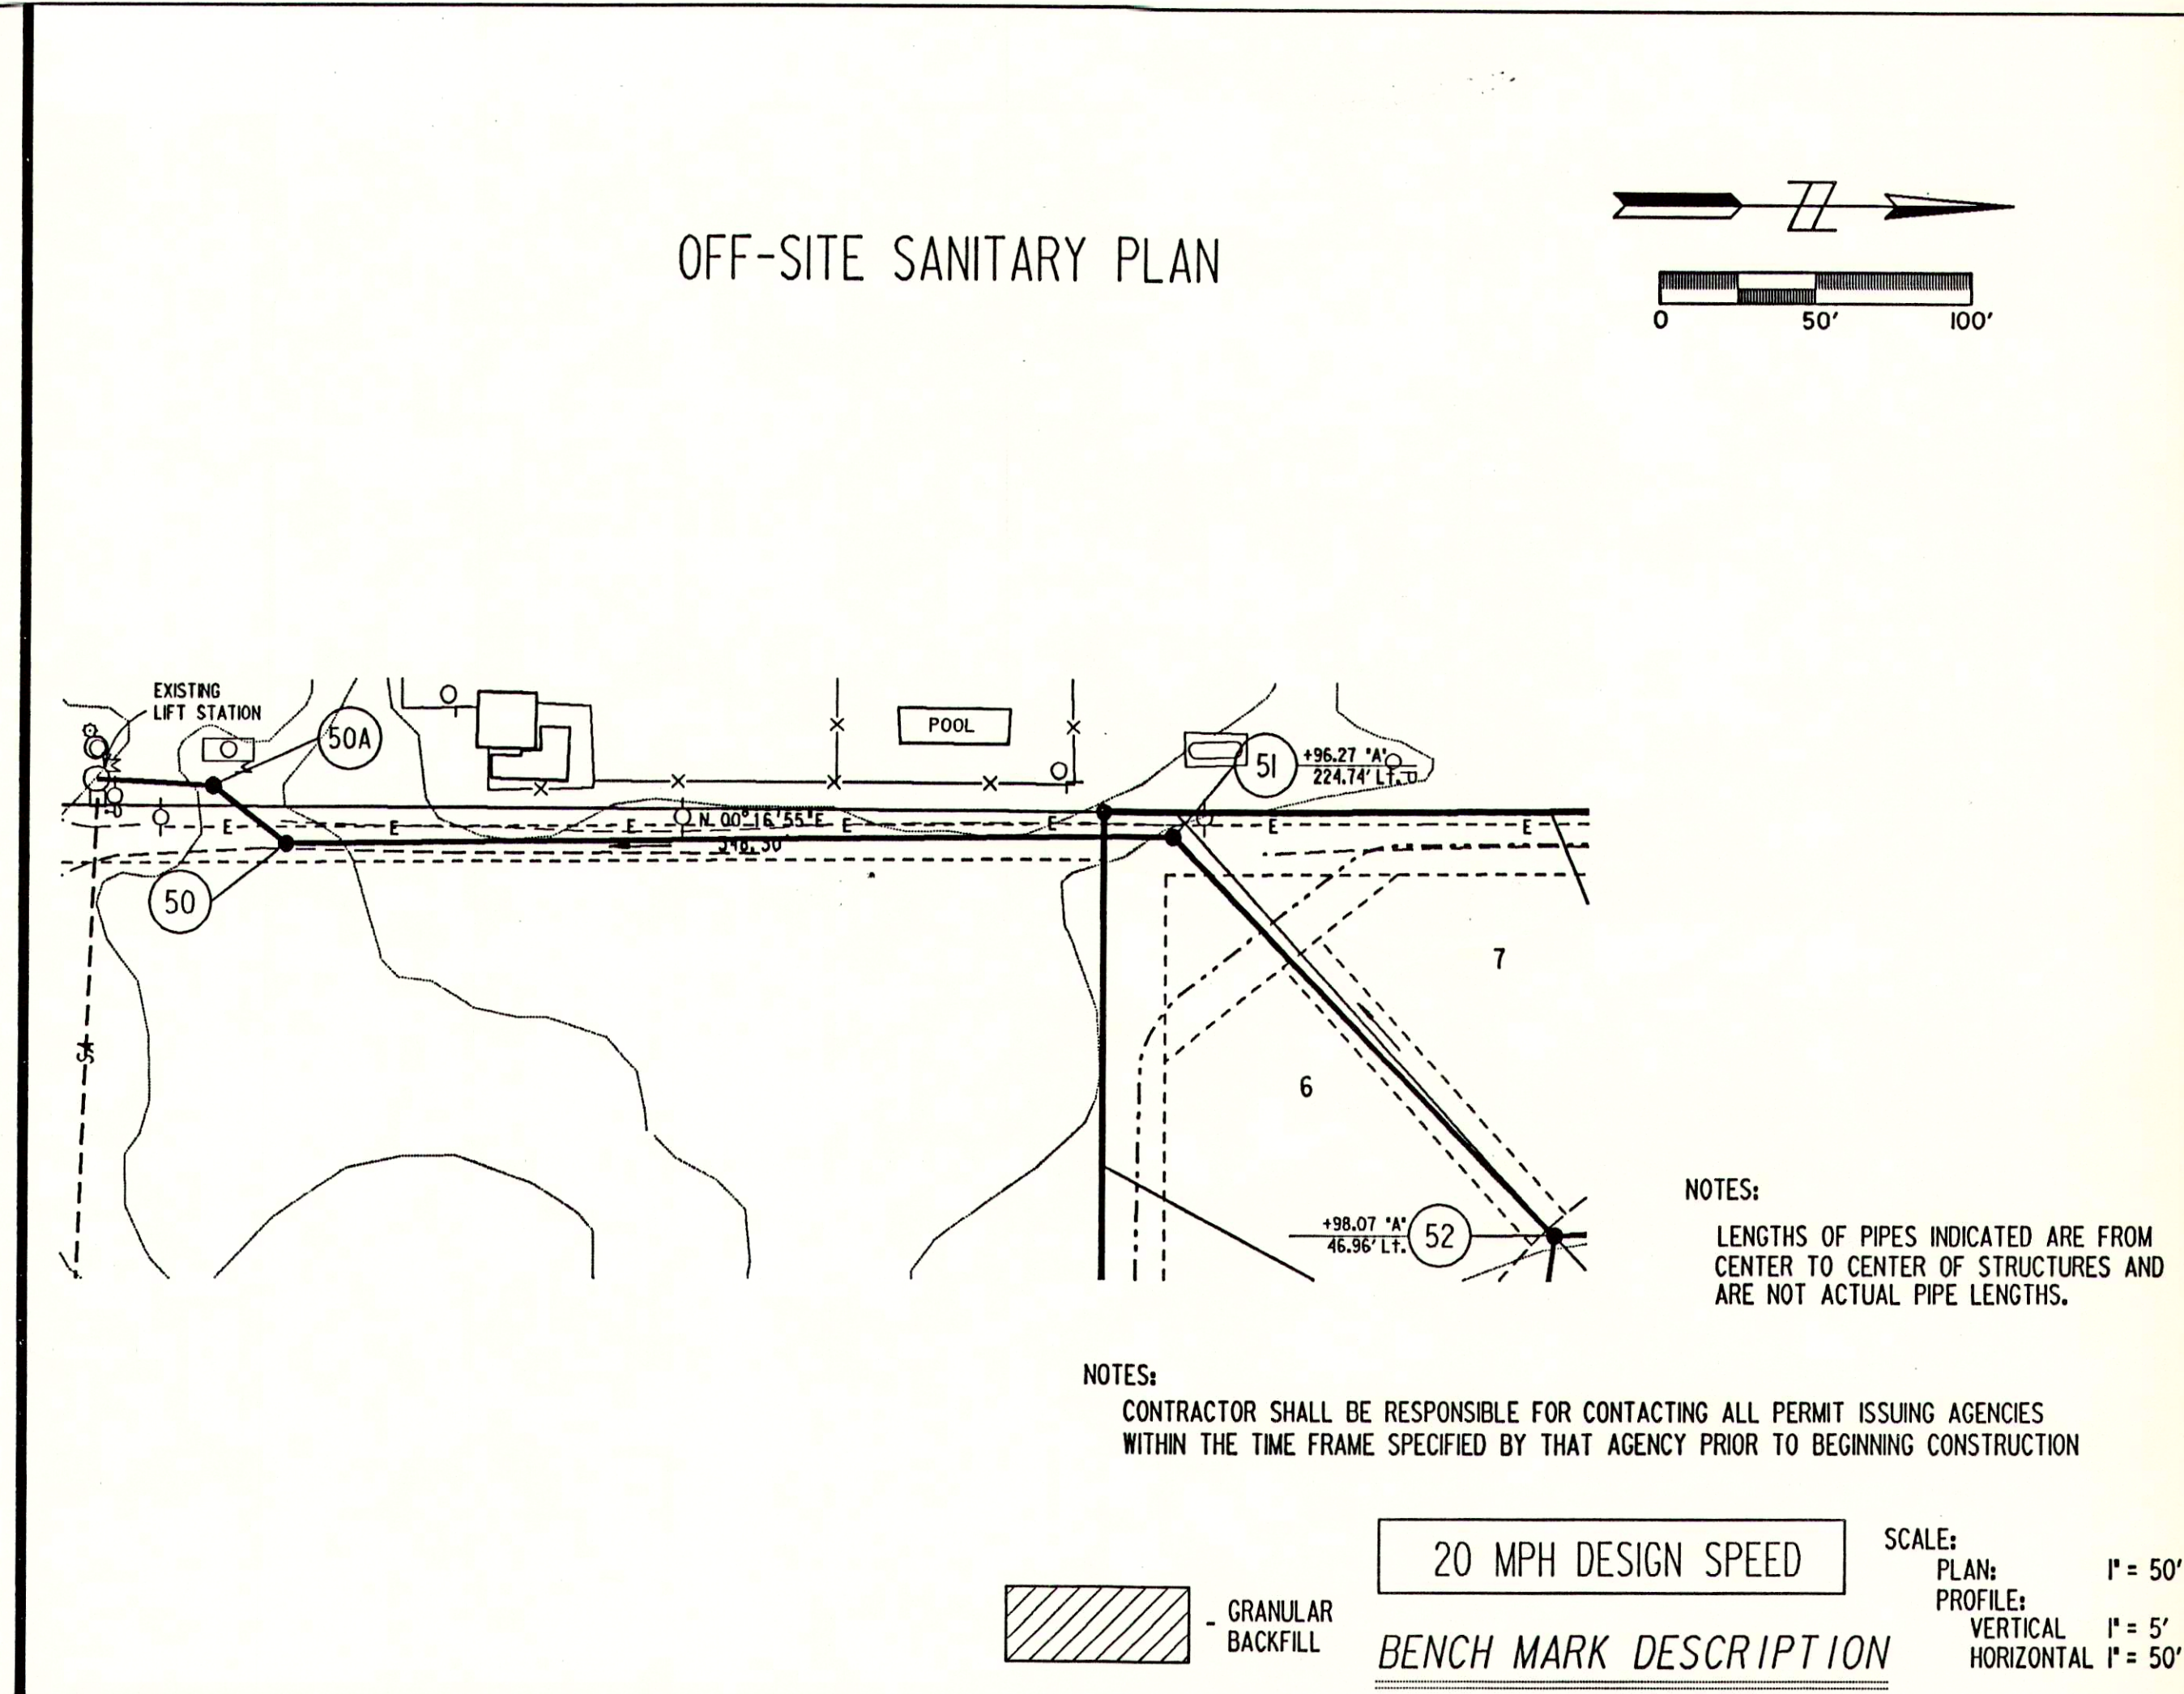


PLAN	DESIGNED	DATE
	CHECKED	BY
	NOTED	
	NO.	

PROFILE	DESIGNED	DATE
	CHECKED	BY
	NOTED	
	NO.	

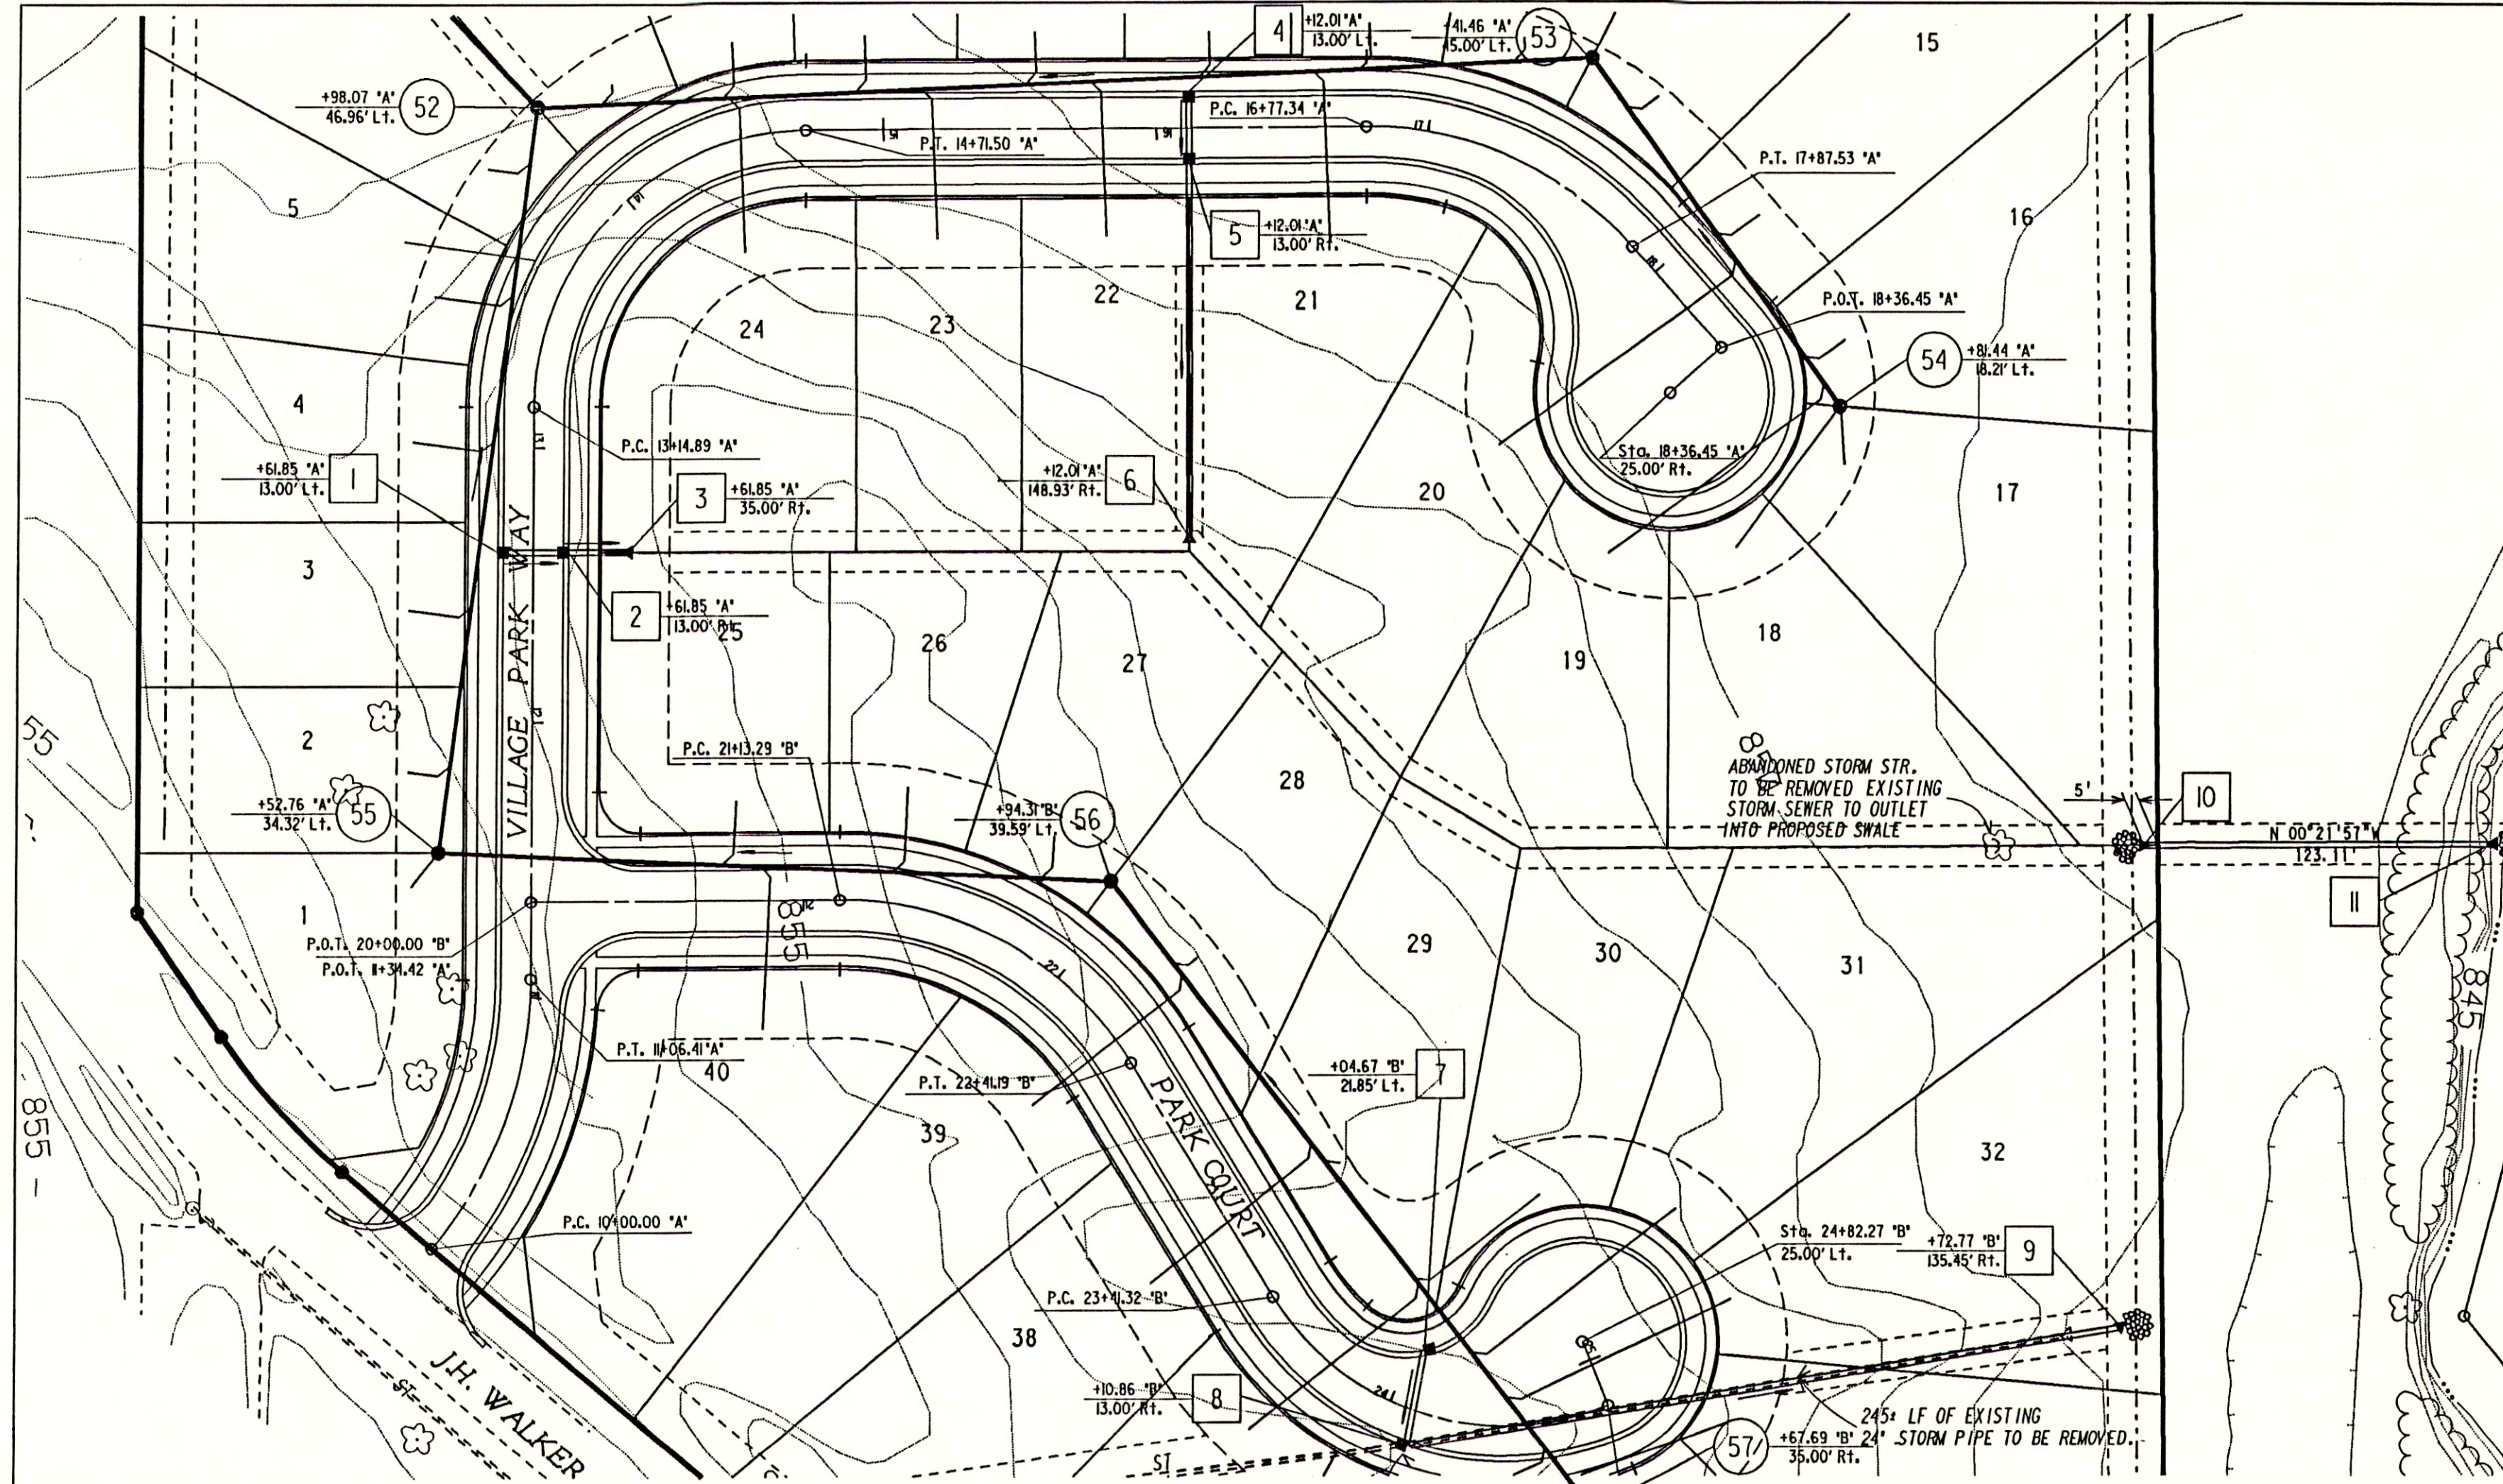

NSE Engineering

11/189 REVISED SAN. SEWER PROFILES

PROJECT NO.	LINE	SHEET NO.	TOTAL SHEETS	DGN	PRP
11-0295	"A" & "B"	7	10	0295SAB	0295SAB

