
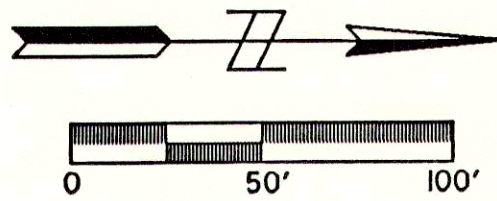


PLAN	SURVEYED	DATE
	NOTED	
	PLOTTED	
	BY	

PROFILE	SURVEYED	DATE
	NOTED	
	PLOTTED	
	BY	

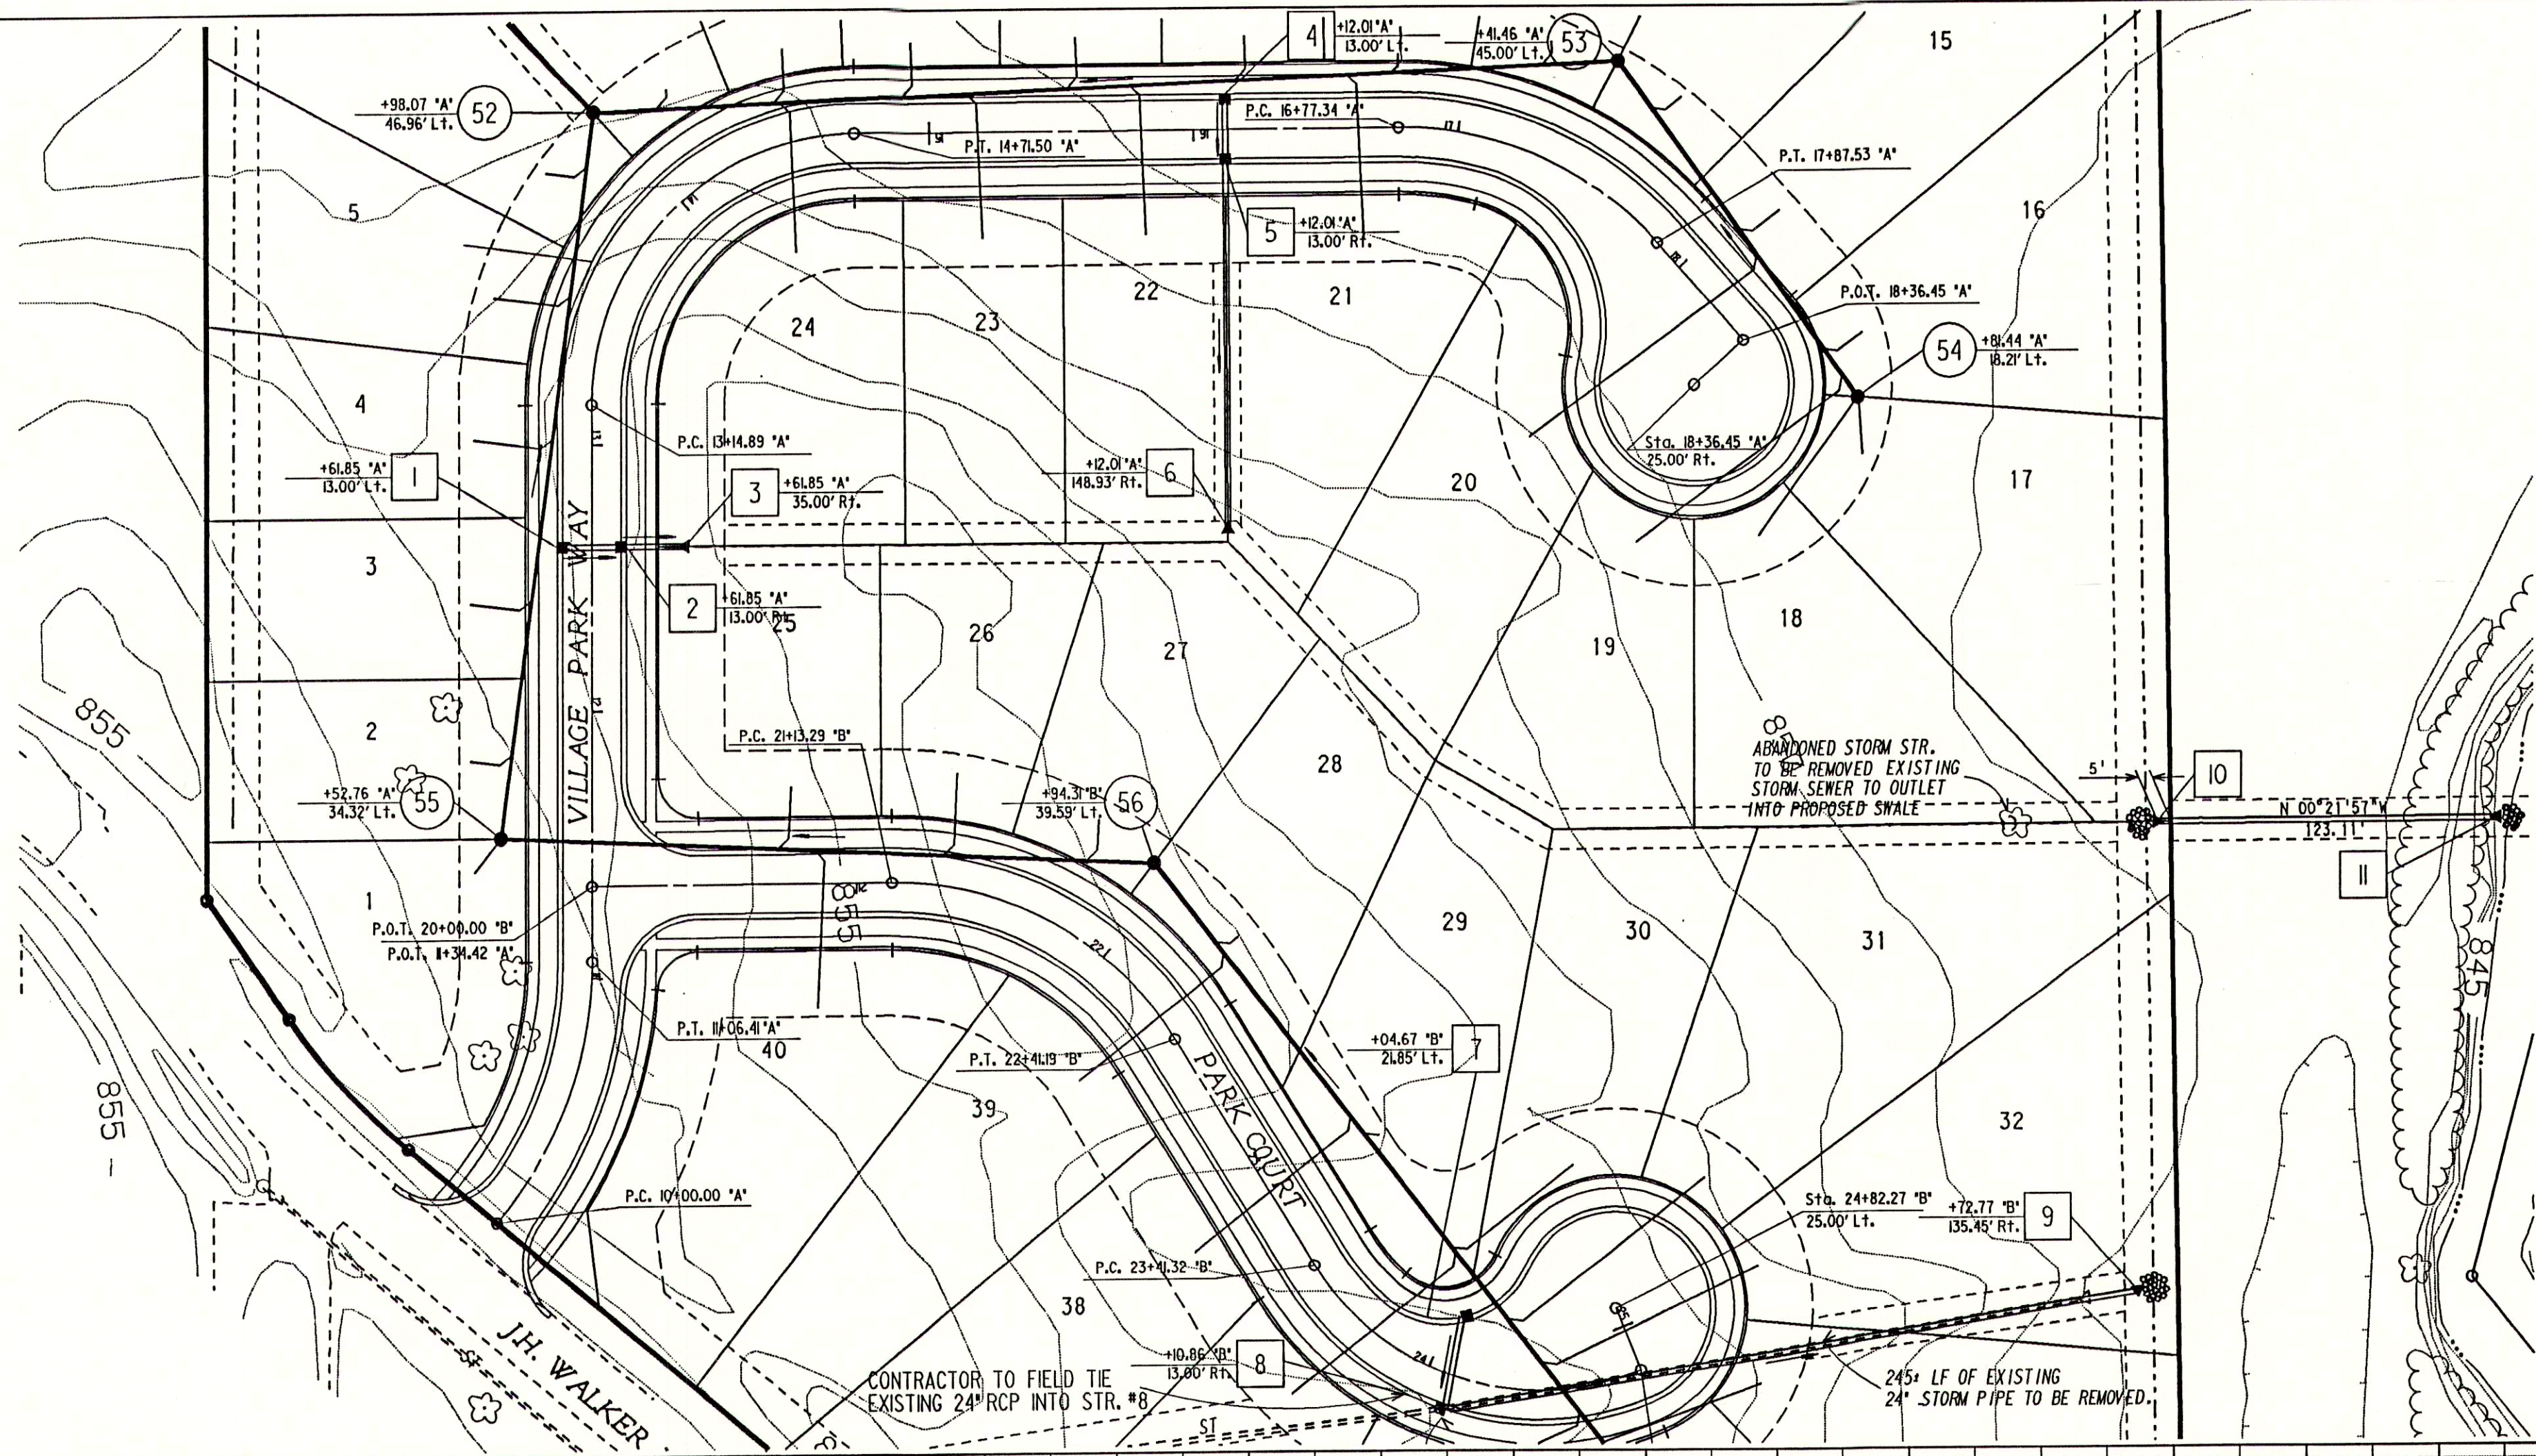

NOTES:
 LENGTHS OF PIPES INDICATED ARE FROM CENTER TO CENTER OF STRUCTURES AND ARE NOT ACTUAL PIPE LENGTHS.

NOTES:
 CONTRACTOR SHALL BE RESPONSIBLE FOR CONTACTING ALL PERMIT ISSUING AGENCIES WITHIN THE TIME FRAME SPECIFIED BY THAT AGENCY PRIOR TO BEGINNING CONSTRUCTION


20 MPH DESIGN SPEED

SCALE:
 PLAN: 1" = 50'
 PROFILE: 1" = 5'
 VERTICAL: 1" = 5'
 HORIZONTAL: 1" = 50'

GRANULAR BACKFILL


BENCH MARK DESCRIPTION

T.B.M. PK SET EAST FACE PWP *C245
 3RD POLE NORTH OF WATER ST.
 NEAR WEST R. ELEV. 852.42

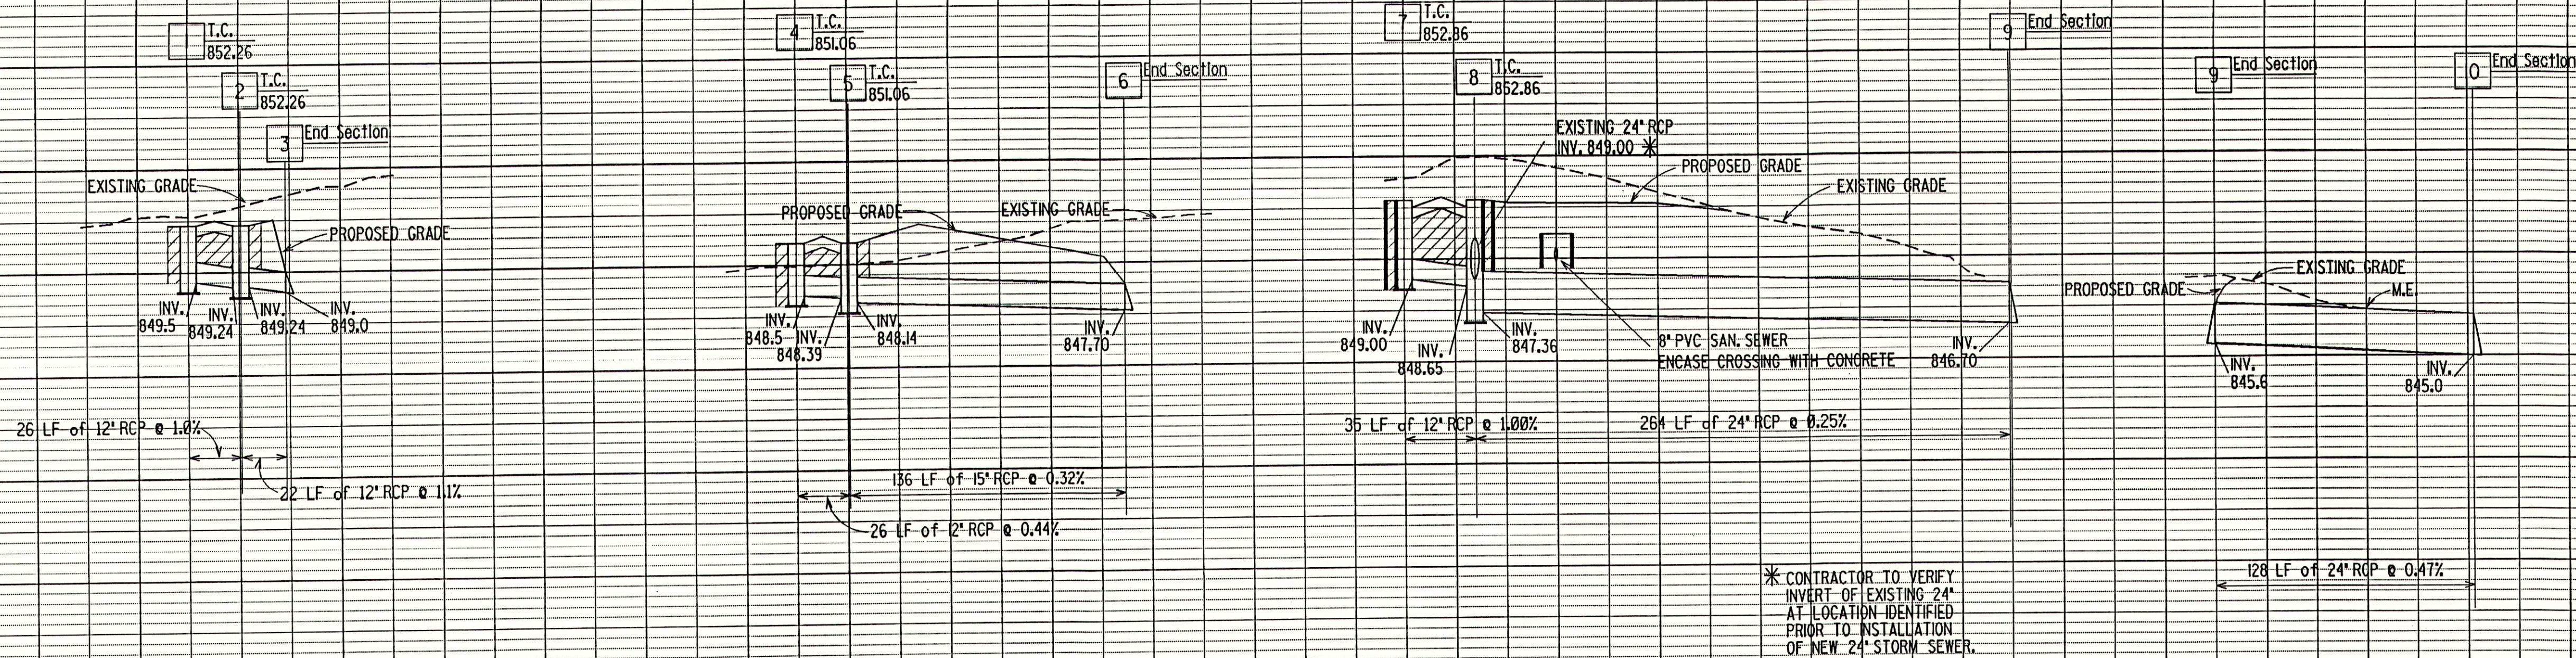

* CONTRACTOR TO VERIFY
 INVERT OF EXISTING 24"
 AT LOCATION IDENTIFIED
 PRIOR TO INSTALLATION
 OF NEW 24" STORM SEWER.

STORM SEWER PROFILES

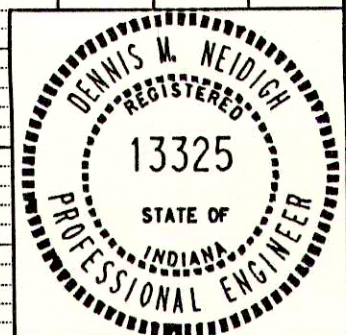

MSE Engineering

11/1/89 REVISED PROFILE

PROJECT NO.	LINE	SHEET NO.	TOTAL SHEETS	DGN	PRF
11-0295	A-A'	8	10	0295S1B	0295S1B