

# AS-BUILT NOTES:

X SANLAT denotes field location of sanitary lateral markers

X SANMHCSX.X denotes field location of a manhole in Cold Springs X.X denotes the manhole number

As-built locations of the sanitary lateral tees are denoted as distances from the downstream manhole, in line with the next upstream manhole.

X WV denotes field location of water valve.


X BOV denotes field location of blow-off valve

X FH denotes field location of Fire Hydrant

See As-built Plan notes from contractor for measured locations of tees, ells, valves, hydrants and other fittings from street centerline intersections.

X STCSXXX denotes field location of storm structure in Cold Springs xxx denotes the structure number.

(enc) denotes "could not confirm"

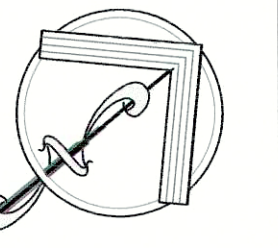

Scale: 1" = 50'

**Pendleton Consulting**  
P.O. Box 87 Pendleton, Indiana 46064  
Phone: 765-778-4540 Fax: 765-778-3871  
email: pendcsltdirect@aol.com

**Pendleton Land Company, LLC**  
9449 Priority Way West Drive  
Suite 120  
Indianapolis, Indiana 46240  
Tel: 317-762-2083 Fax: 317-762-2088

Date: 7/31/04

Revision  
8/10/04 Revised per comments of client, remove pond, modify storm system (Site Series 100-300).  
5/16/05 Revised per comments of client to remove pond, add storm system Series 700-720.  
9/23/05 Revised per client for lot numbers, lot line adjust.

Project: **FarmGate at Huntzinger Farms**  
Section 1  
Pendleton, Madison County, Indiana  
Sheet Title: **Waterline Plan**

Sheet No.

**11**

of 16 Sheets

**As-built Plans**