

SANITARY SEWER AS-BUILTS FOR
FOSTER BRANCH WOODS SUBDIVISION
29 LOT SUBDIVISION LOCATED IN GREEN TOWNSHIP, MADISON COUNTY, INDIANNA
PART OF THE SOUTHEAST QUARTER OF SECTION 13 TOWNSHIP 17 NORTH, RANGE 8 EAST.

INDEX

SHEET NO.	DESCRIPTION
1	TITLE SHEET
2	SITE PLAN—
3	GRADING PLAN
4	UTILITY PLAN
5	EROSION CONTROL PLAN & DETAILS
6	STREET PROFILES—
7	STREET PROFILES—
8	STREET PROFILES—
9	STORM SEWER PROFILES—
10	STORM SEWER PROFILES—
11	STORM SEWER PROFILES—
12	SANITARY SEWER PROFILES
13	SANITARY SEWER PROFILES
14	INTERSECTION DETAILS—
15	SPECIFICATIONS & DETAILS—
16	SPECIFICATIONS & DETAILS—


REVISIONS

SHEET NO.	DESCRIPTION

DEVELOPED BY:

BARRINGTON ENTERPRISES, INC.
403 WEST 8TH STREET
ANDERSON, INDIANA 46016

PROJECT # 9861

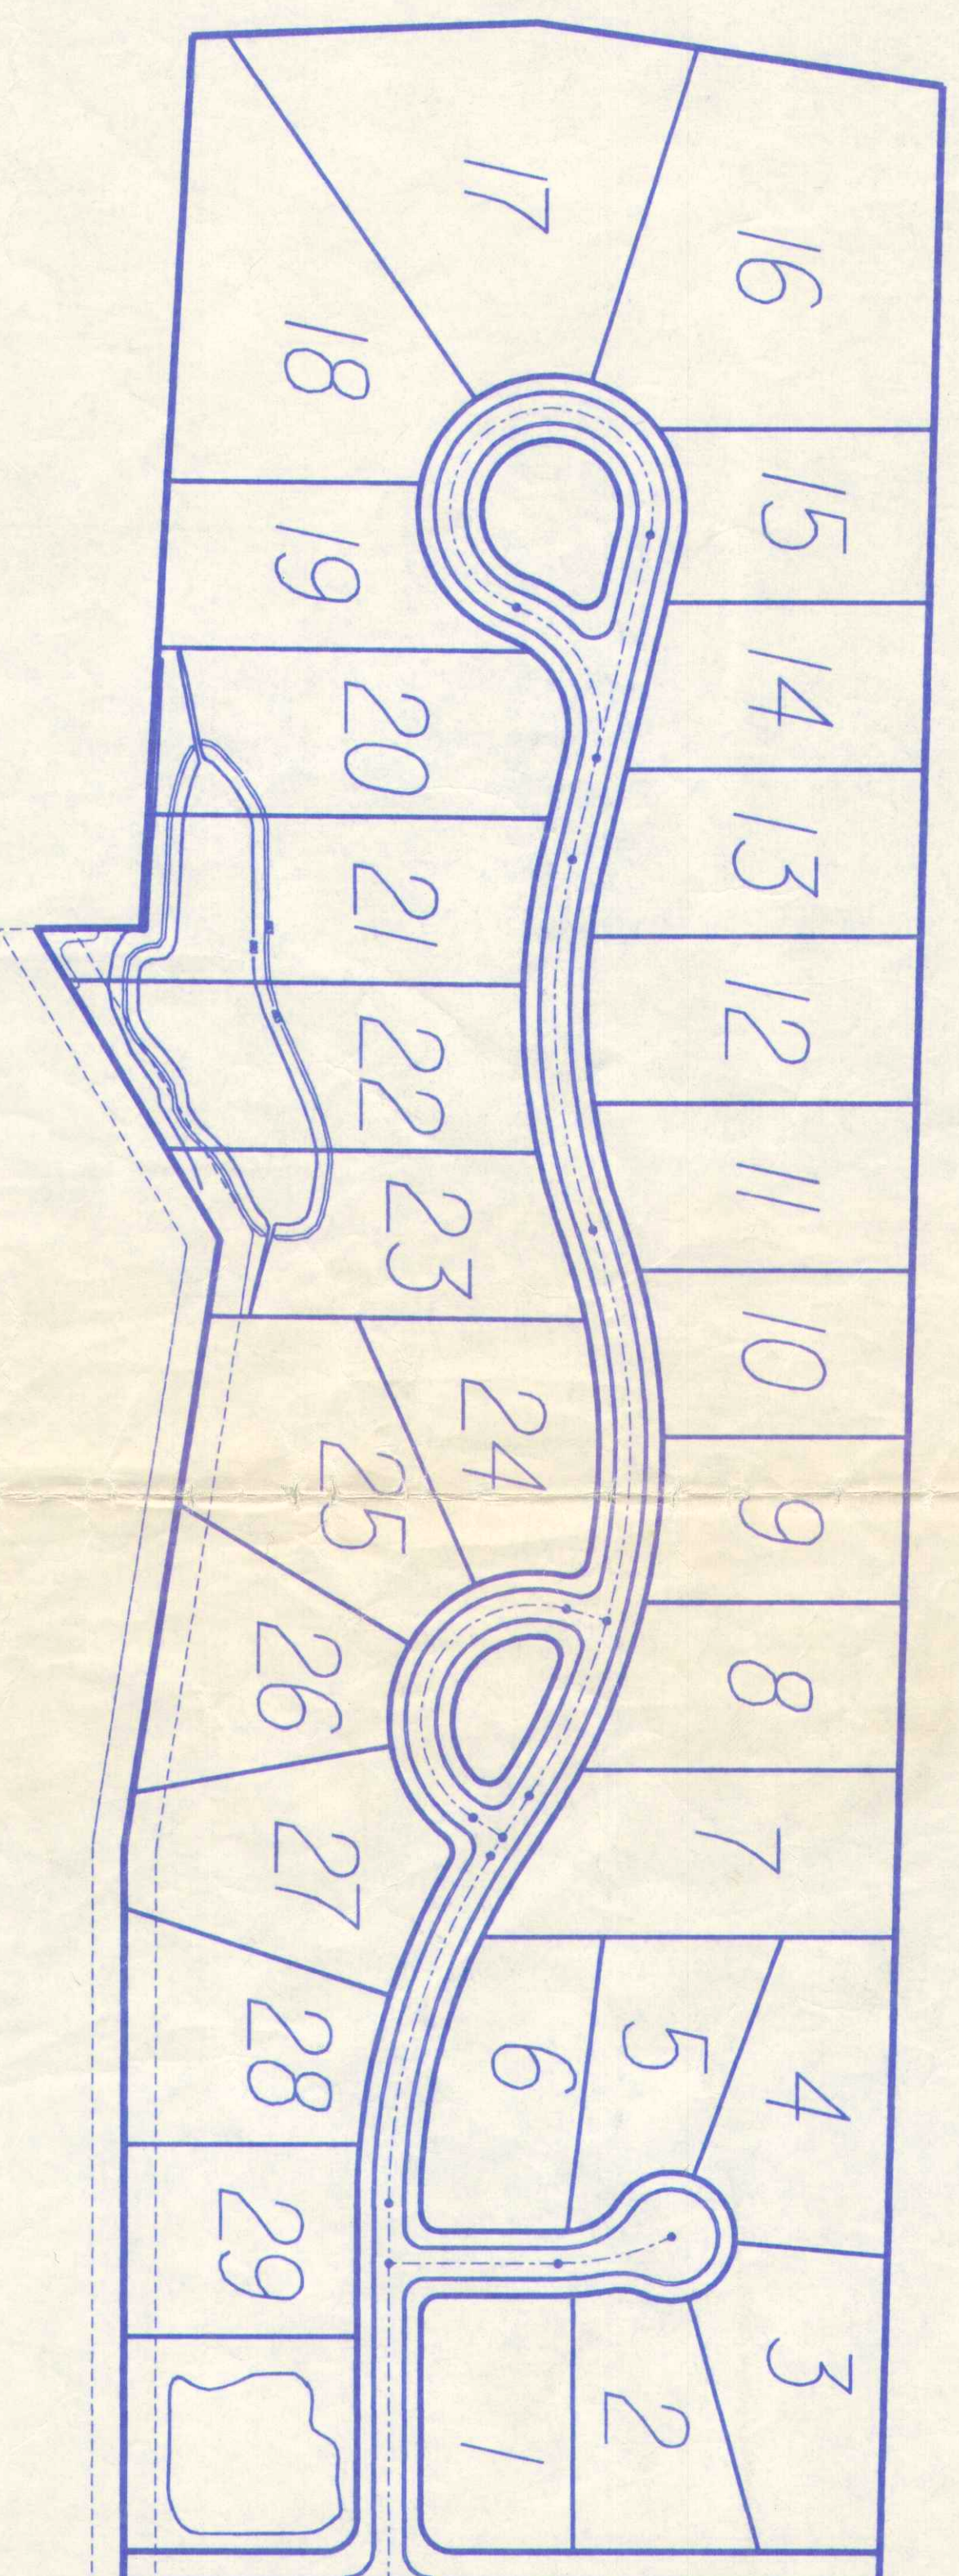

SITE MAP


PREPARED BY:

CDG


CONSULTING L.L.C.

RESIDENTIAL - COMMERCIAL
COMPLETE SITE DEVELOPMENT SERVICES
1500 W.OLAK STREET, SUITE 300
ZIONSVILLE, INDIANA 46077
TELEPHONE (317) 873-9360
FAX/MAIL (317) 873-9362

ZIONSVILLE, INDIANA 46077
FACSIMILE (317) 873-9362

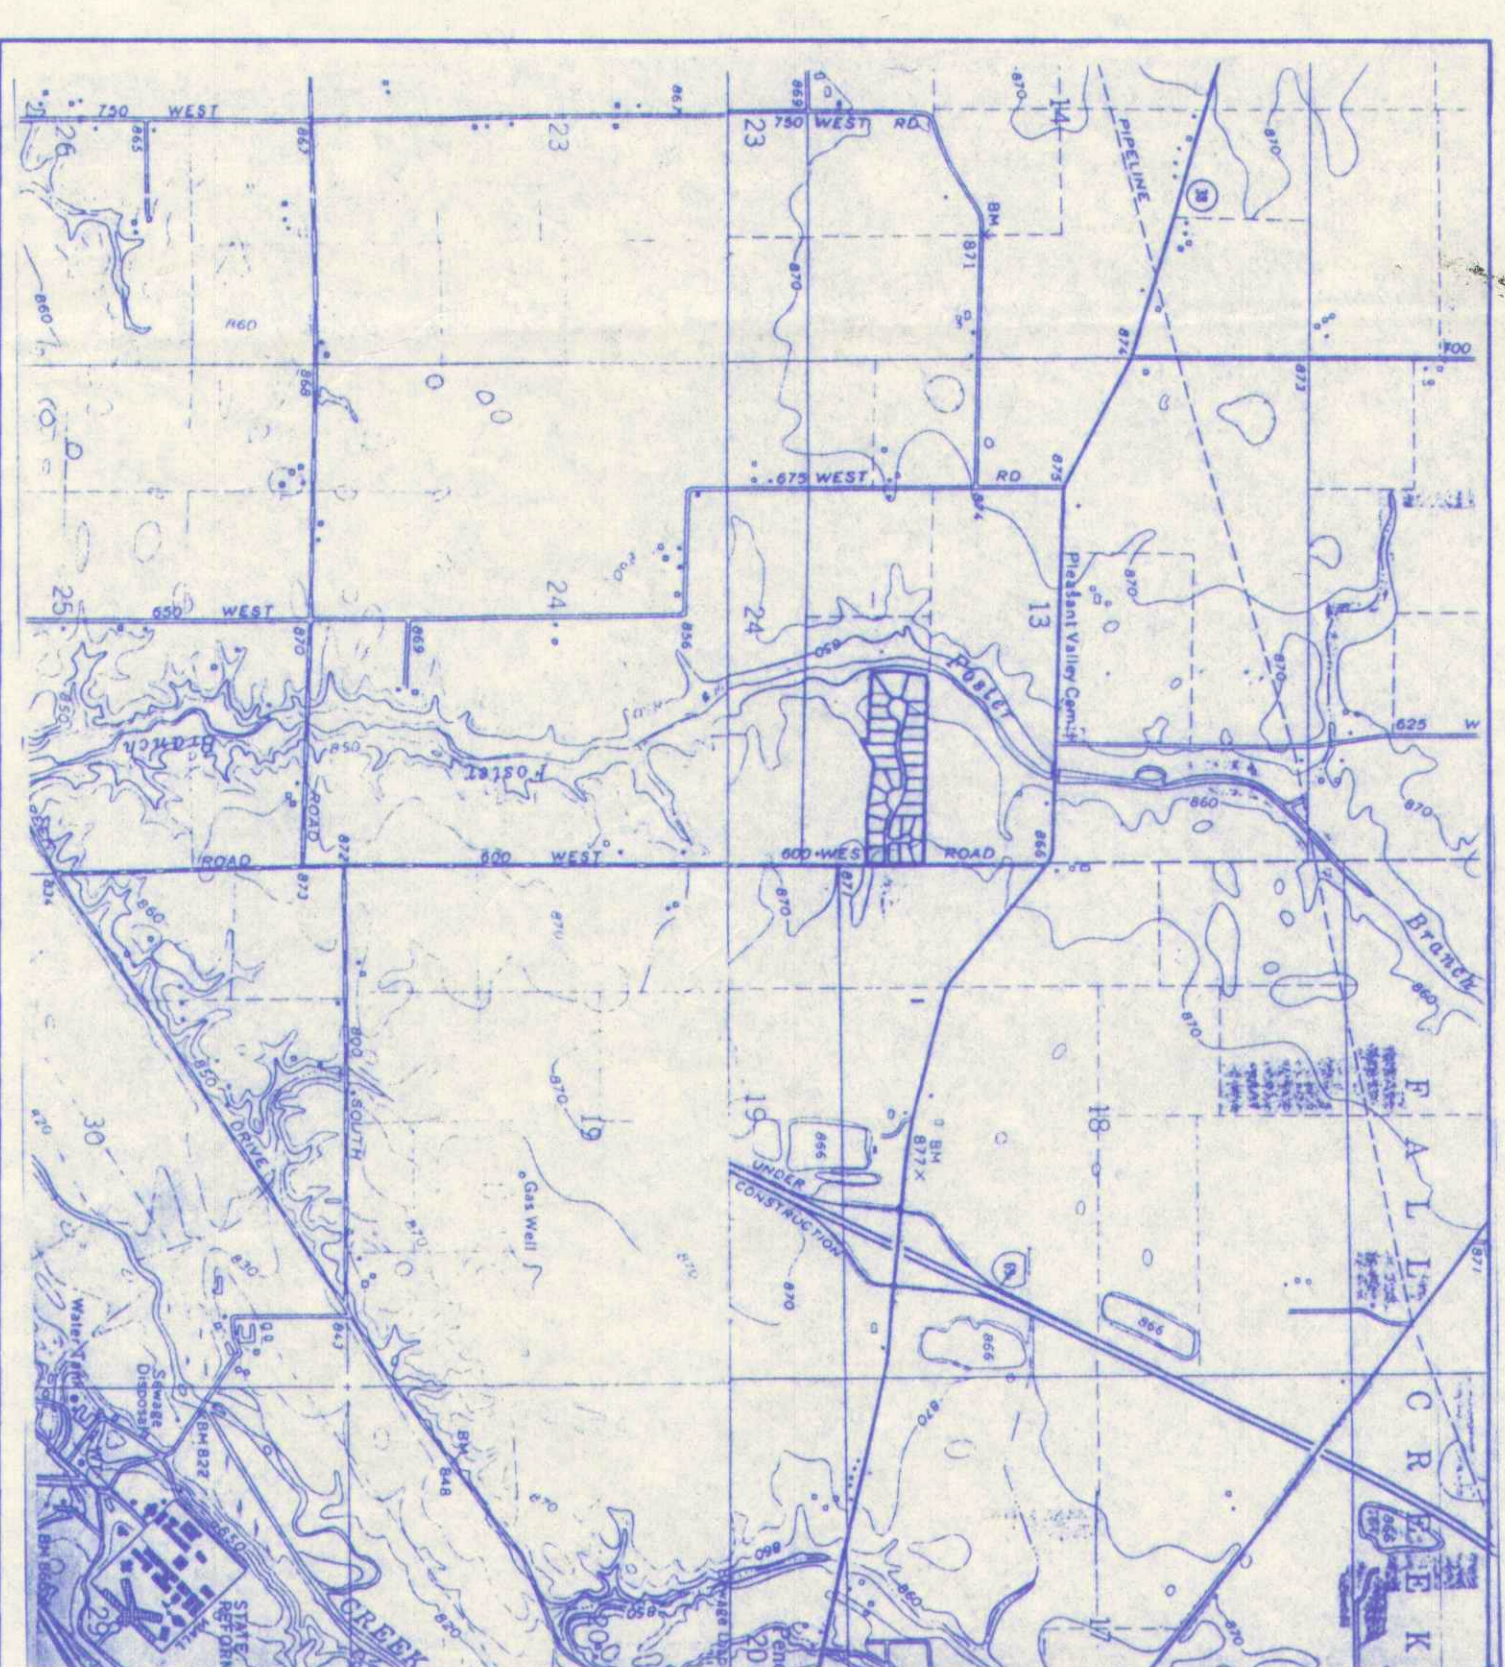

VACINITY MAP

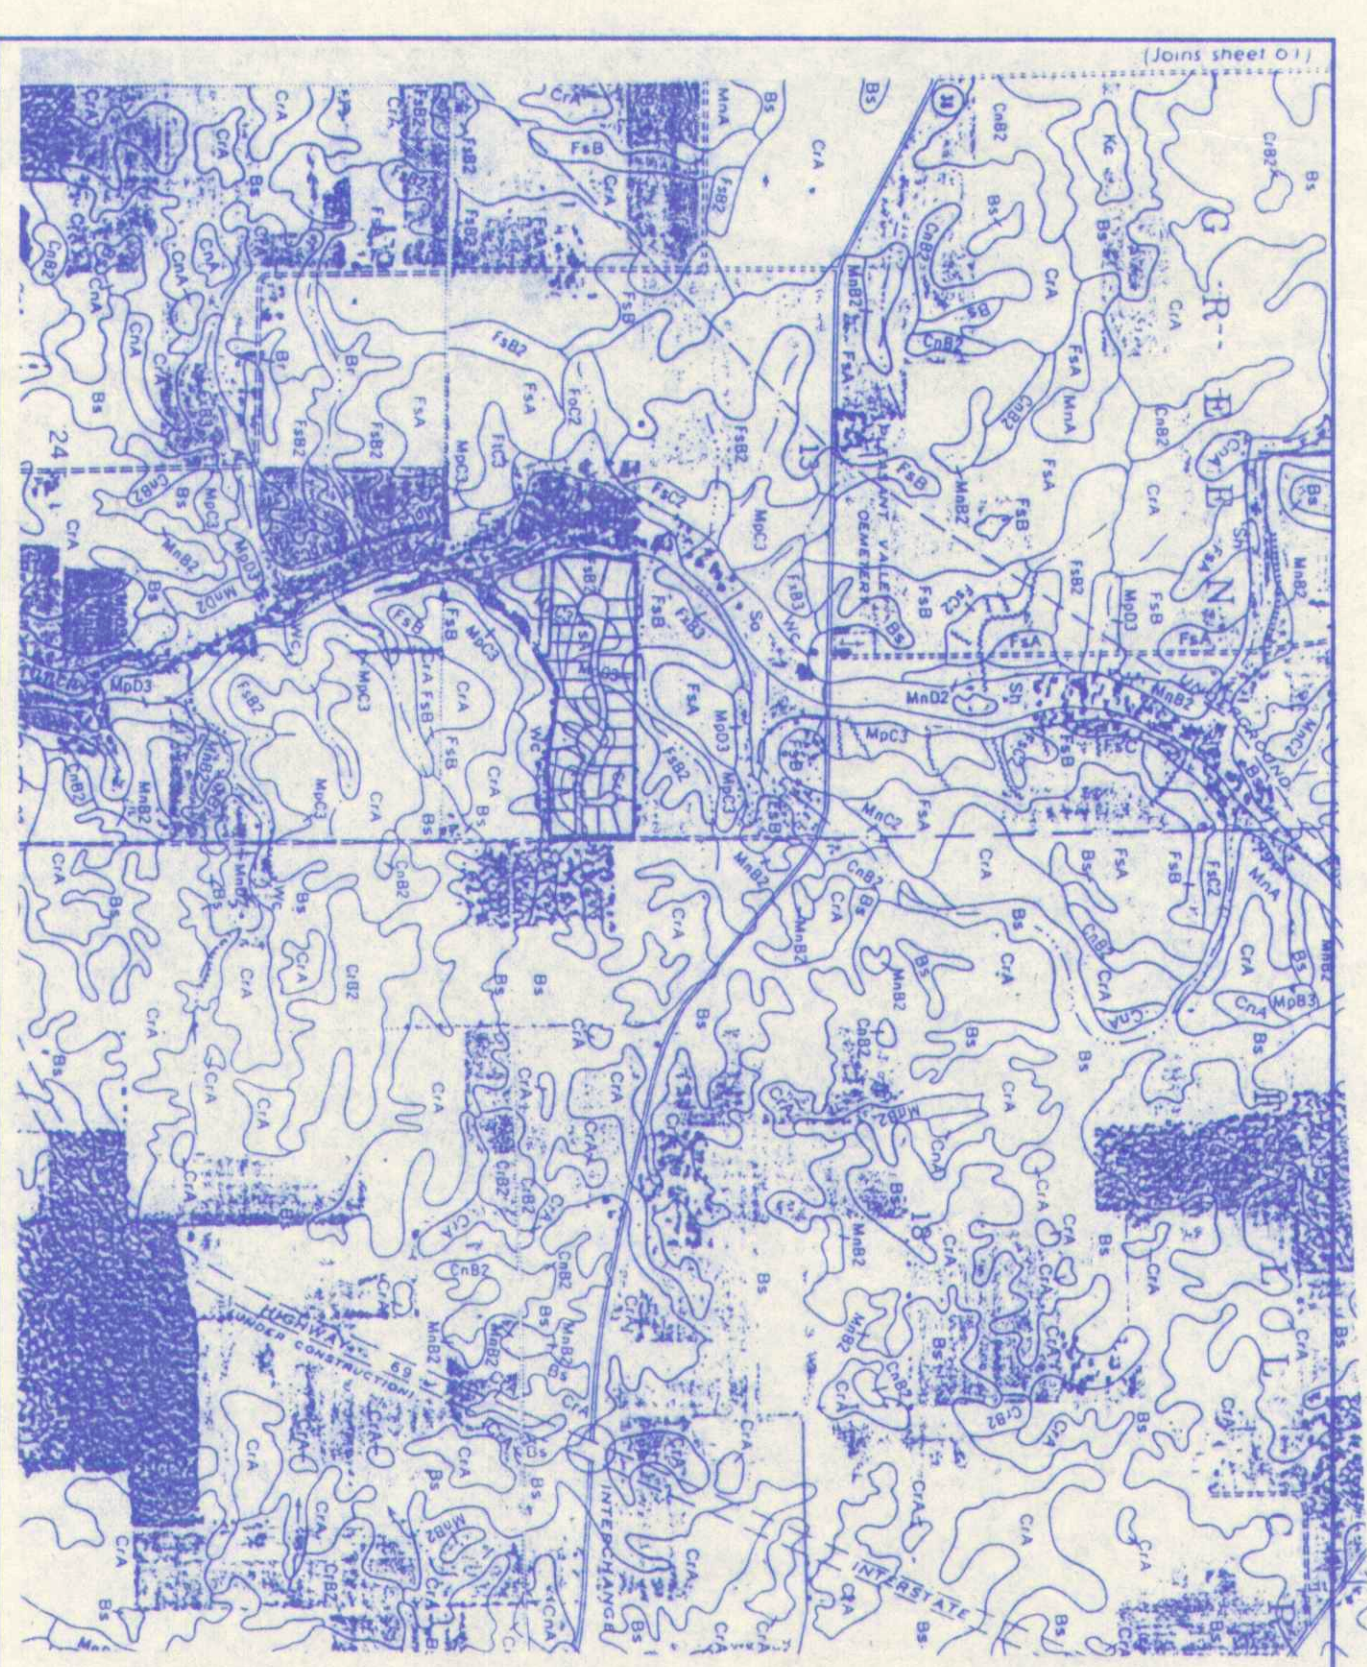

SOILS MAP

AS-BUILTS

CERTIFIED THIS 4th DAY OF FEBRUARY 2000

Jay B. Gibson
Registered Professional Engineer No. 920005-Indiana

