


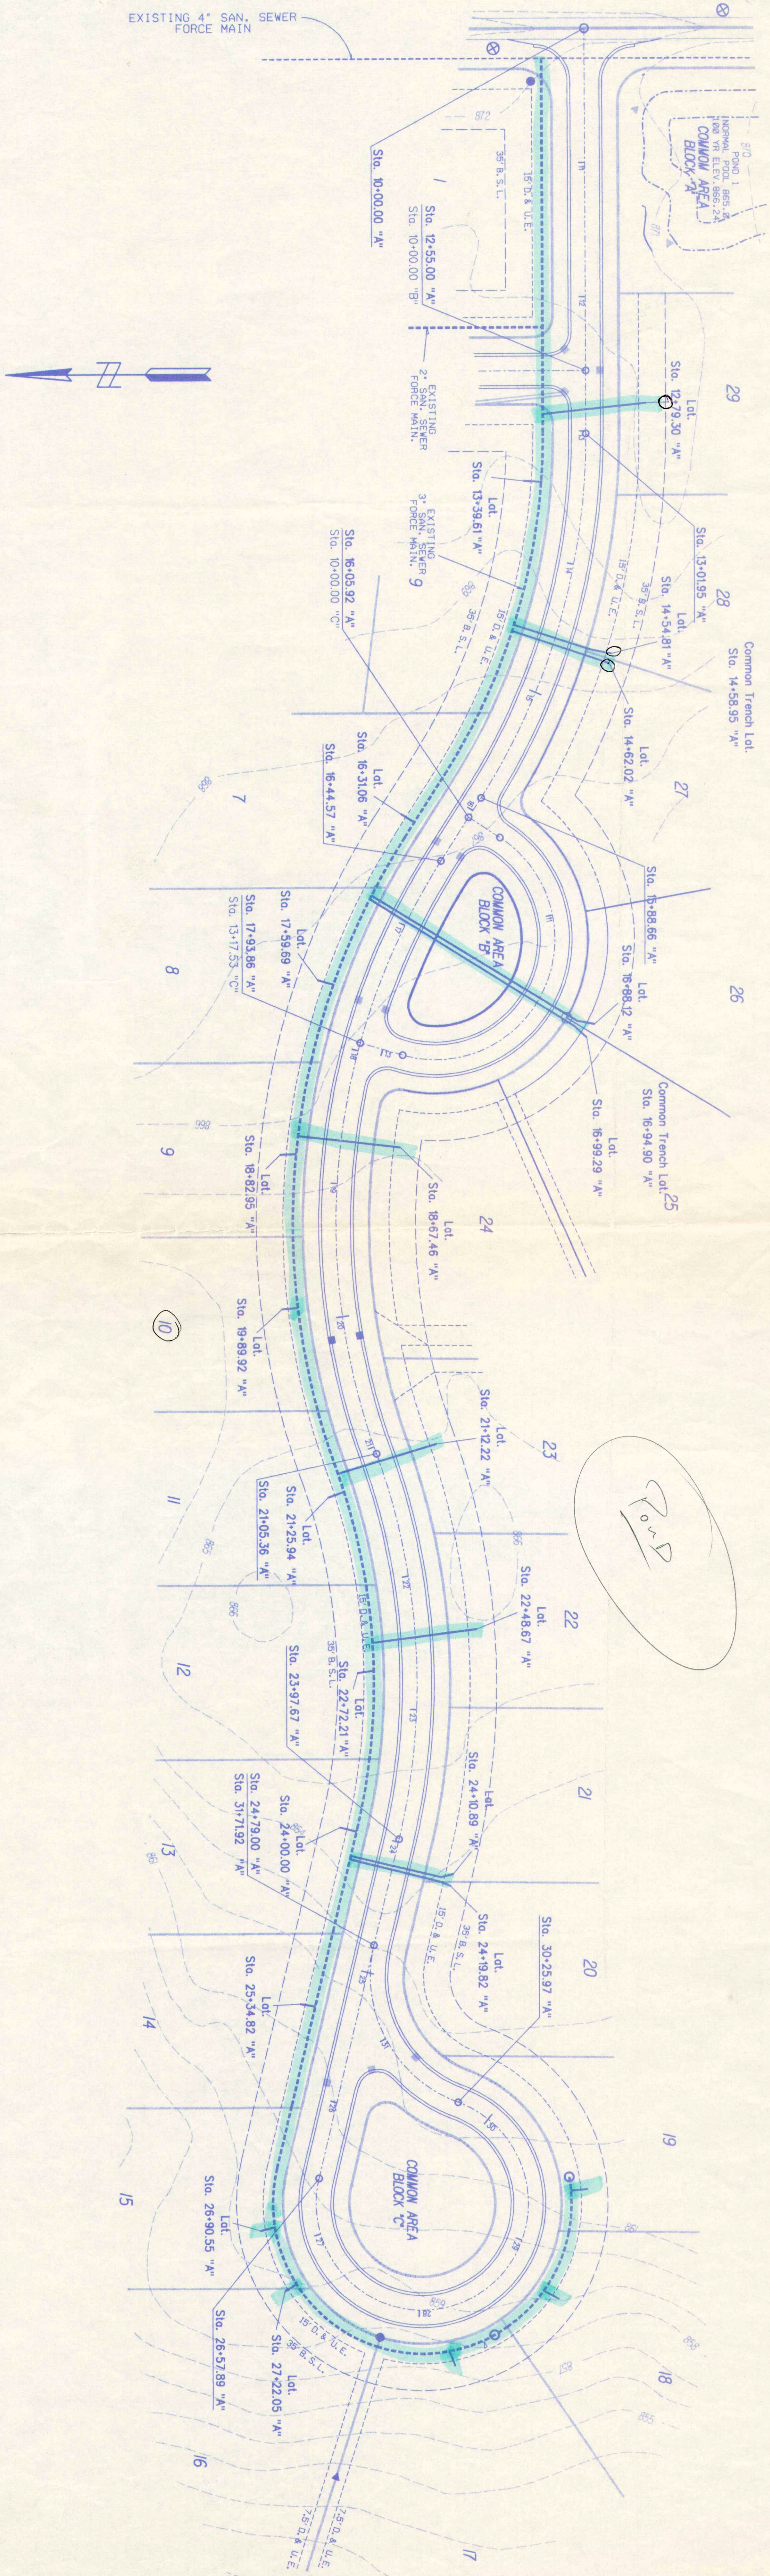


PLAN	SURVEYED	BY	DATE
NOTE BOOK	PLOTTED		
NO.	ALIGNED CHECKED		
	RT. OF WAY CHECKED		

"DON'T O.D. BLIND"
1-800-382-5544
CALL BEFORE YOU DIG

GRANULAR
BICKELL

SCALE:
PLAN: 1" = 50'
PROFILE: 1" = 5'
HORIZONTAL: 1" = 50'

BENCHMARK DESCRIPTION
CHISEL SQUARE IN THE NORTHEAST CORNER OF BRIDGE
HEADWALL ON STATE ROAD - 38 OVER FOSTER'S BRANCH.
ELEVATION 827.67.

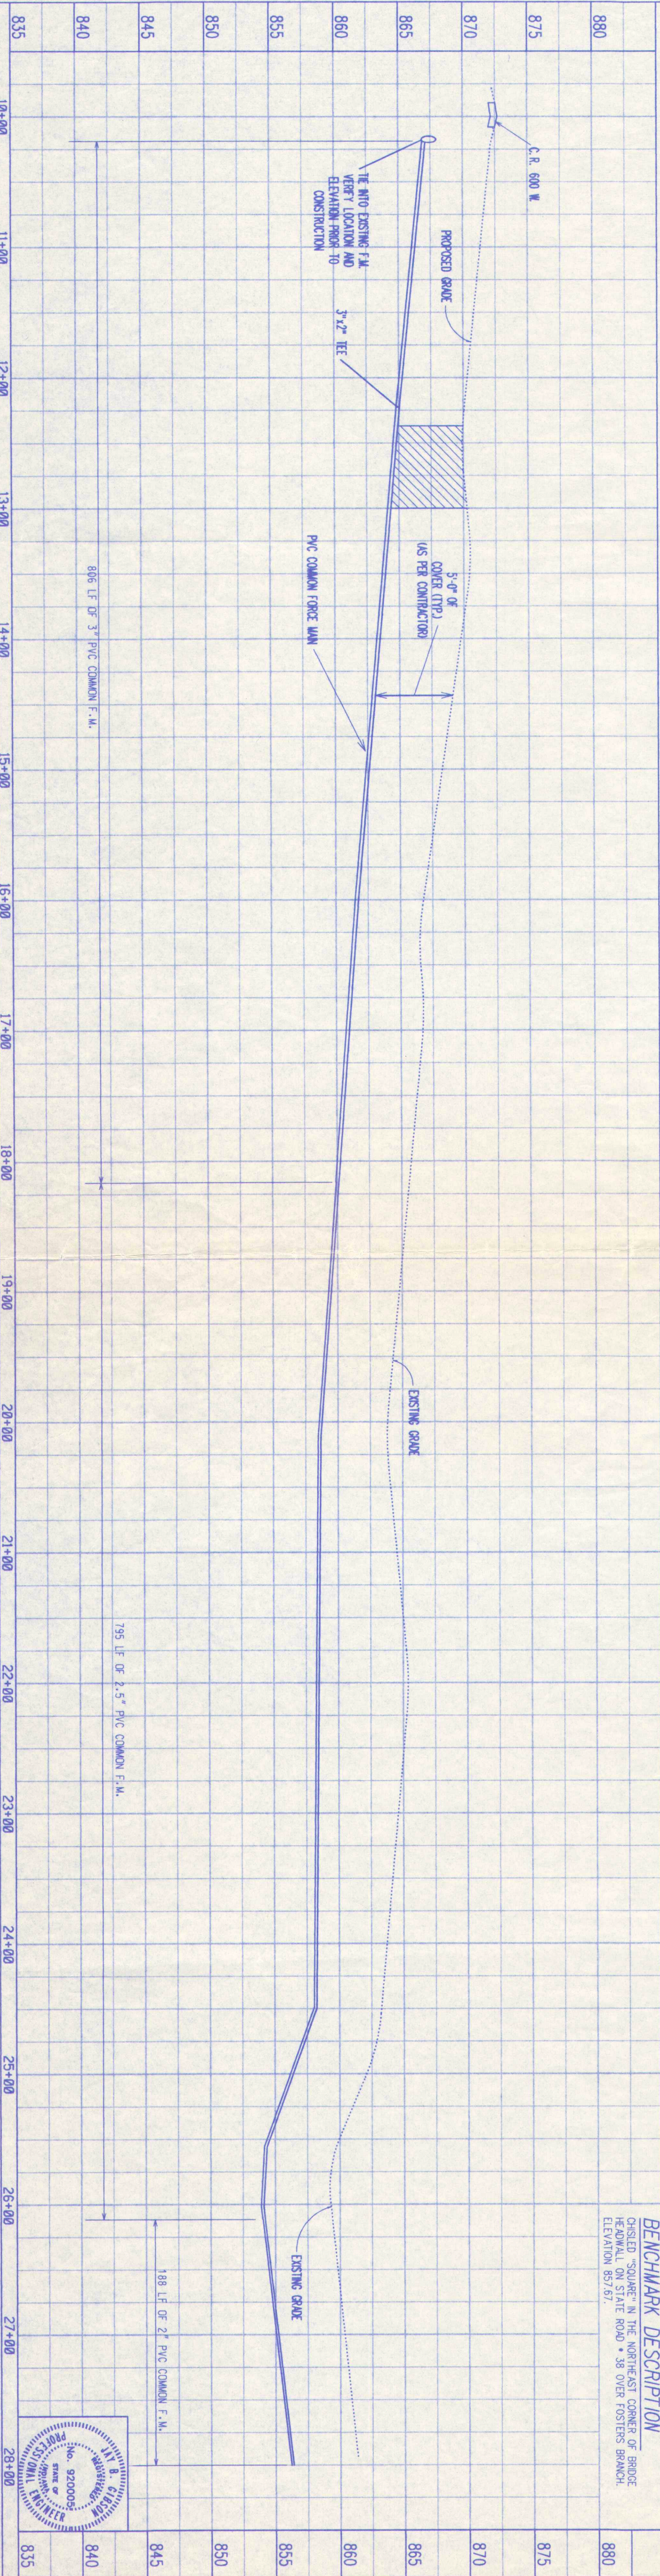

PROFILE	SURVEYED	BY	DATE
NOTE BOOK	PLOTTED		
NO.	GRADES CHECKED		
	S.M.V. NOTED		
	STRUCTURE NOTATIONS CHECKED		

FOSTER BRANCH WOODS SUBDIVISION SANITARY SEWER AS-BUILT.

PROJECT NO.	DATE	SHEET NO.	TOTAL SHEETS	DATE	REV.
C79861	A	12	16	C79851PP	