



PROFILE	SURVEYED	BY	DATE
	PLOTTED		
NOTE BOOK NO.	GRADES CHECKED		
	B. M.'s NOTED		
	STRUCTURE NOTATIONS CHECKED		

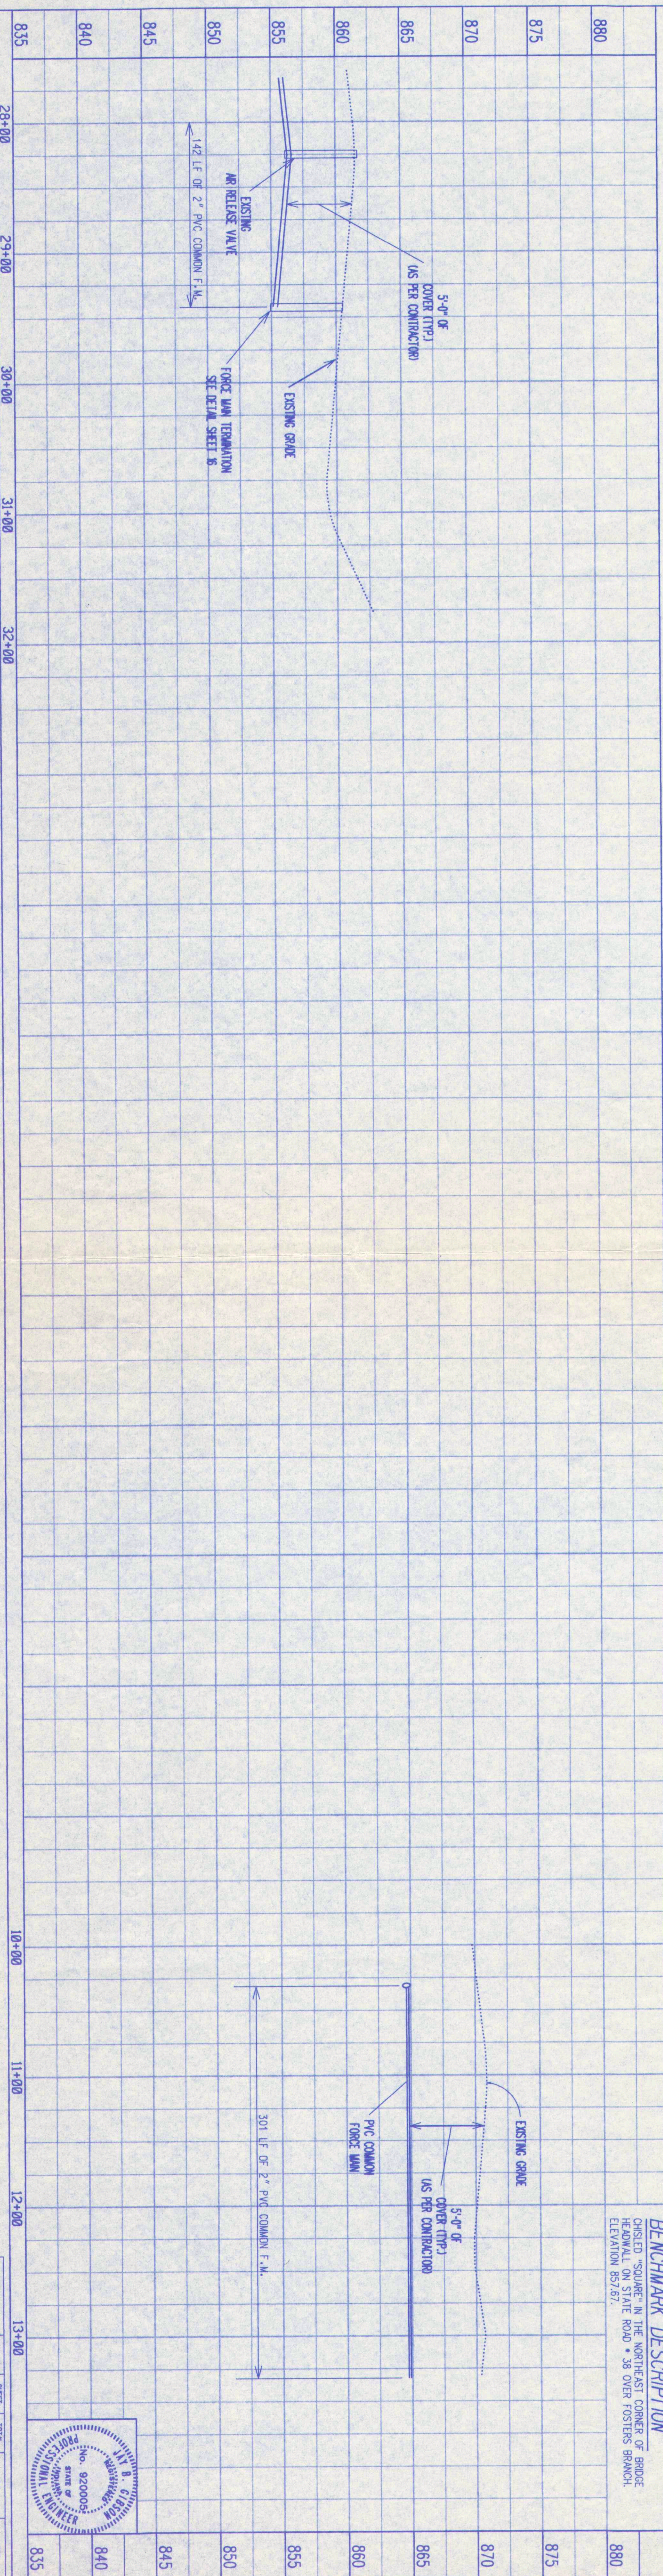

FOSTER BRANCH WOODS SUBDIVISION SANITARY SEWER AS-BUILT S.

13+00					
PROJECT NO.	LINE	SHEET NO.	TOTAL SHEETS	DO#	POST
C9861	A	13	16	C9861PP	

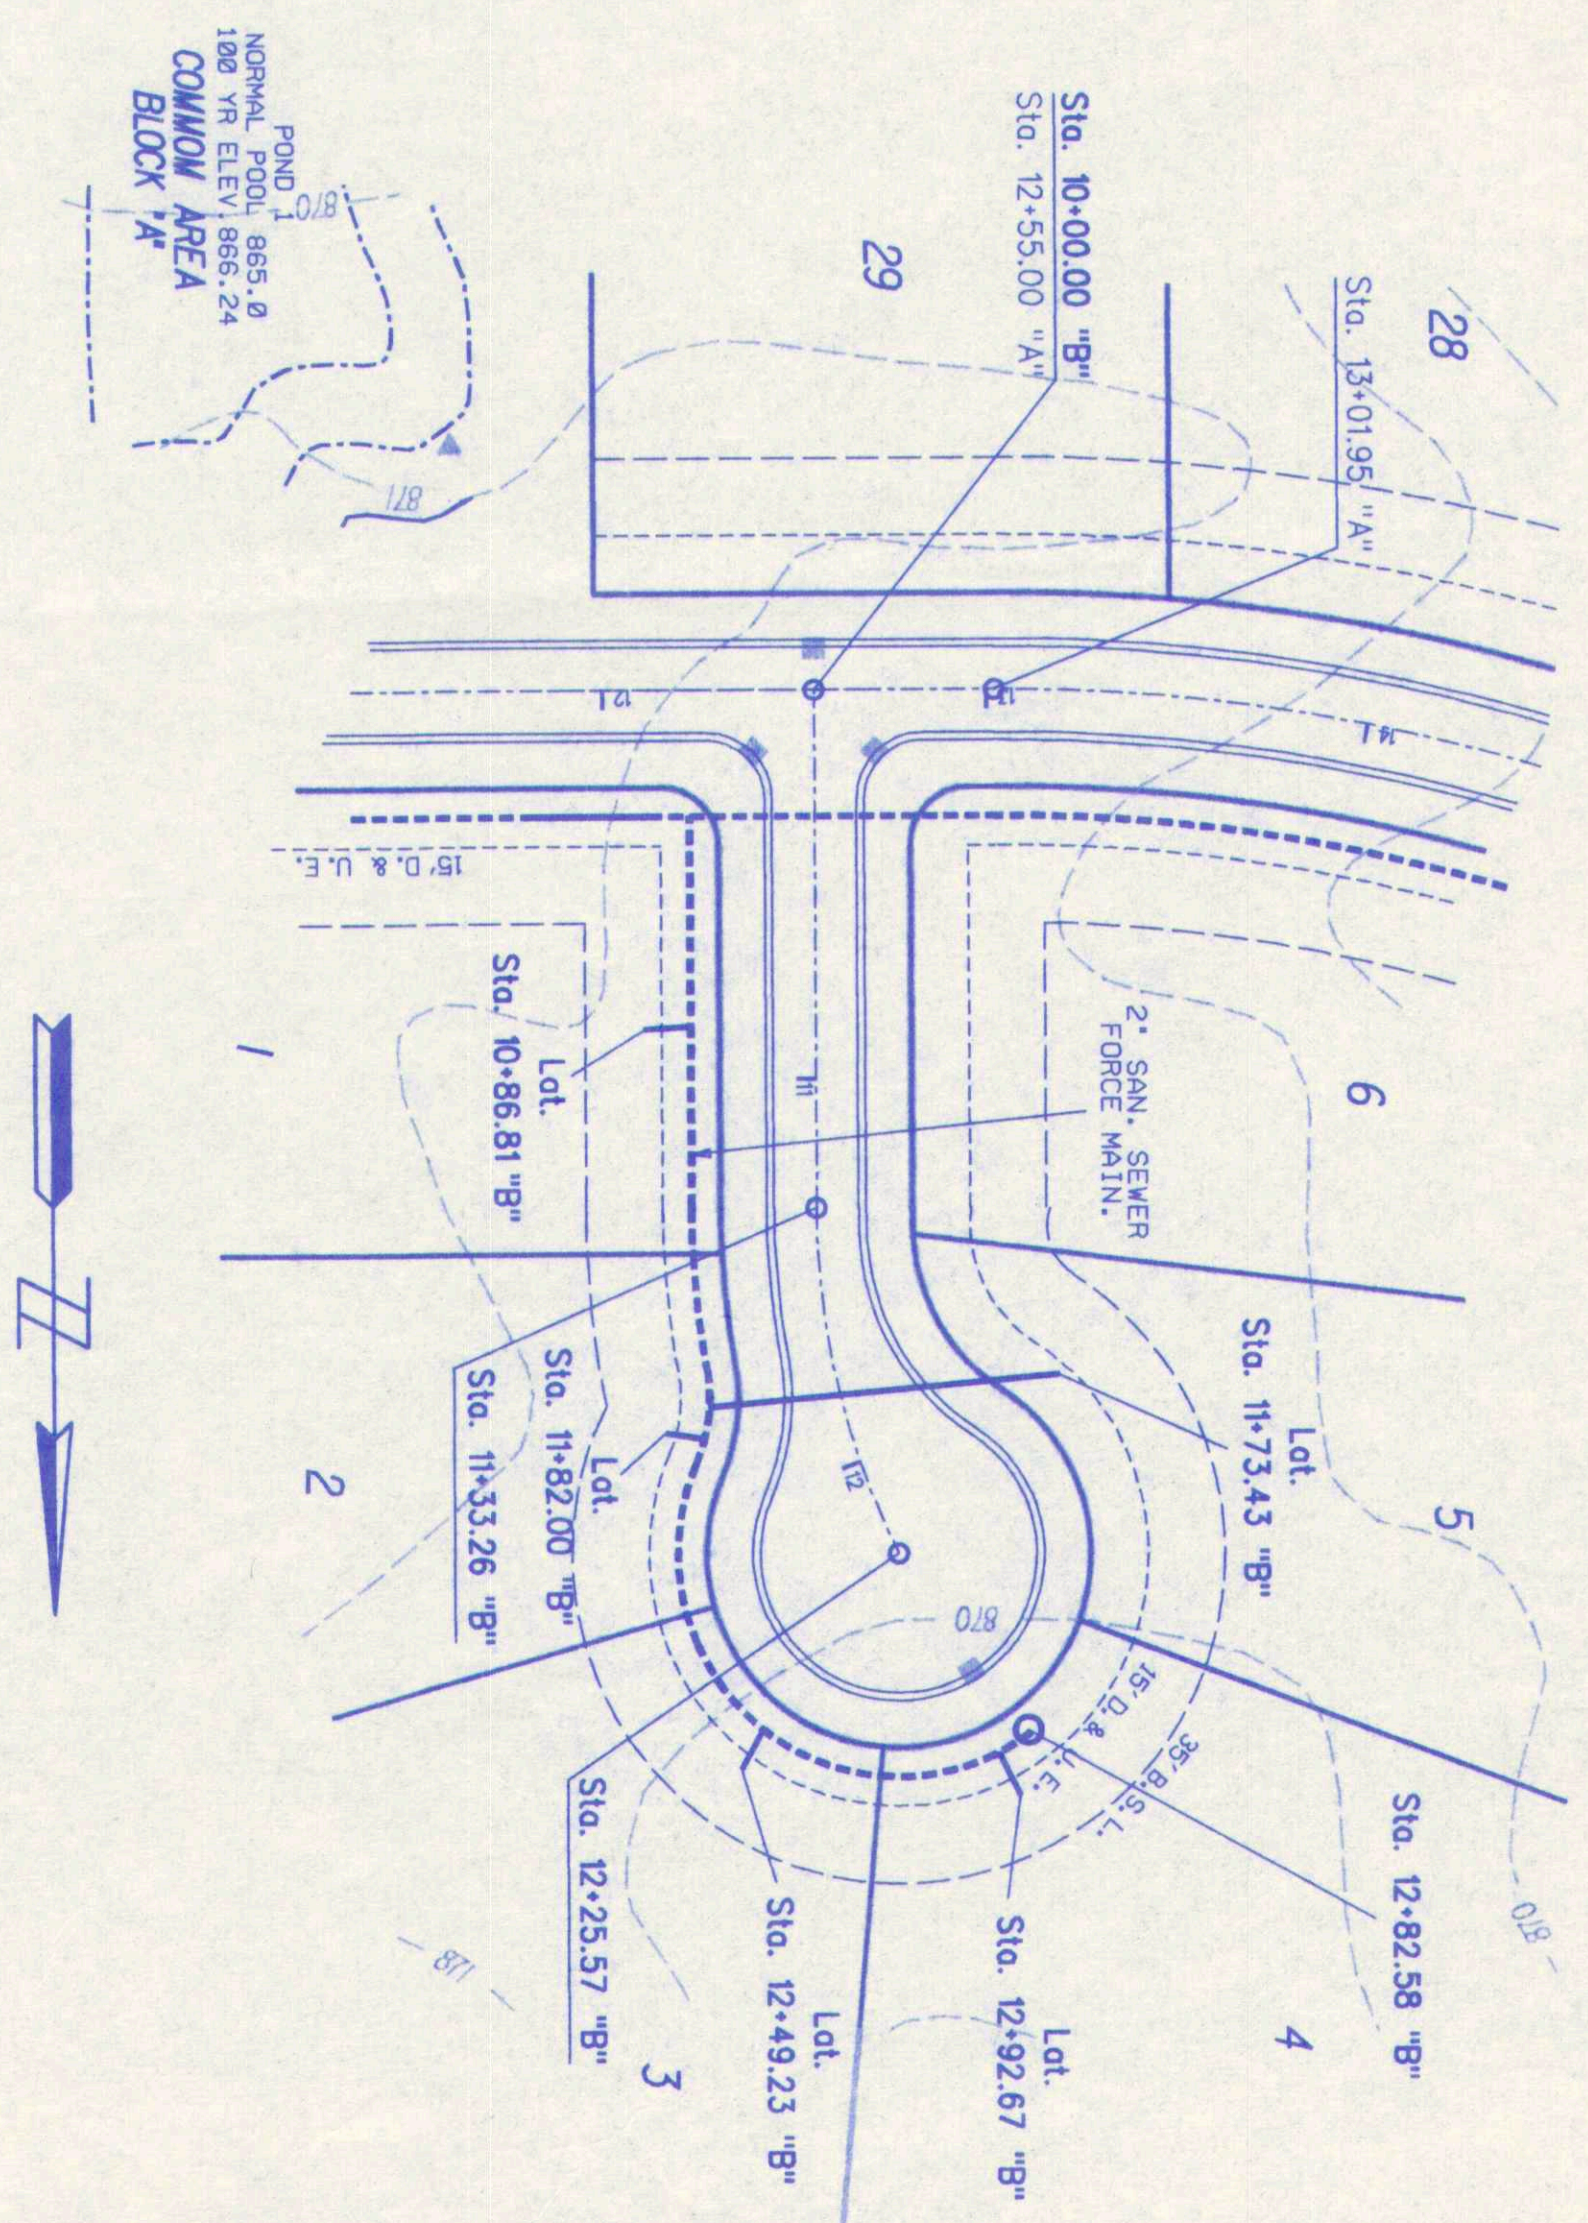

BENCHMARK DESCRIPTION
CHISED "SQUARE" IN THE NORTHEAST CORNER OF BRIDGE
HEADWALL ON STATE ROAD • 38 OVER FOSTERS BRANCH
ELEVATION 857.67.

SCALE:
PLAN: 1" = 50'
PROFILE:
VERTICAL 1" = 5'
HORIZONTAL 1" = 50'