

FREED'S VILLAGE ADDITION SANITARY SEWER PROJECT


PROJECT FOR THE FALL CREEK REGIONAL WASTE DISTRICT MADISON CO., IN.

1998
SRF PROJECT NO. CS 18207701
DIVISION II
CONTRACT 'B'
JOE ROWLETT - GENERAL MANAGER

SHEET INDEX


SHEET NO.	DESCRIPTION
1	TITLE SHEET AND INDEX
2	PROJECT BASE MAP
3-17	PLAN AND PROFILES
18	LIFT STATION DETAILS
19-21	STANDARD SANITARY DETAILS

AREA MAP

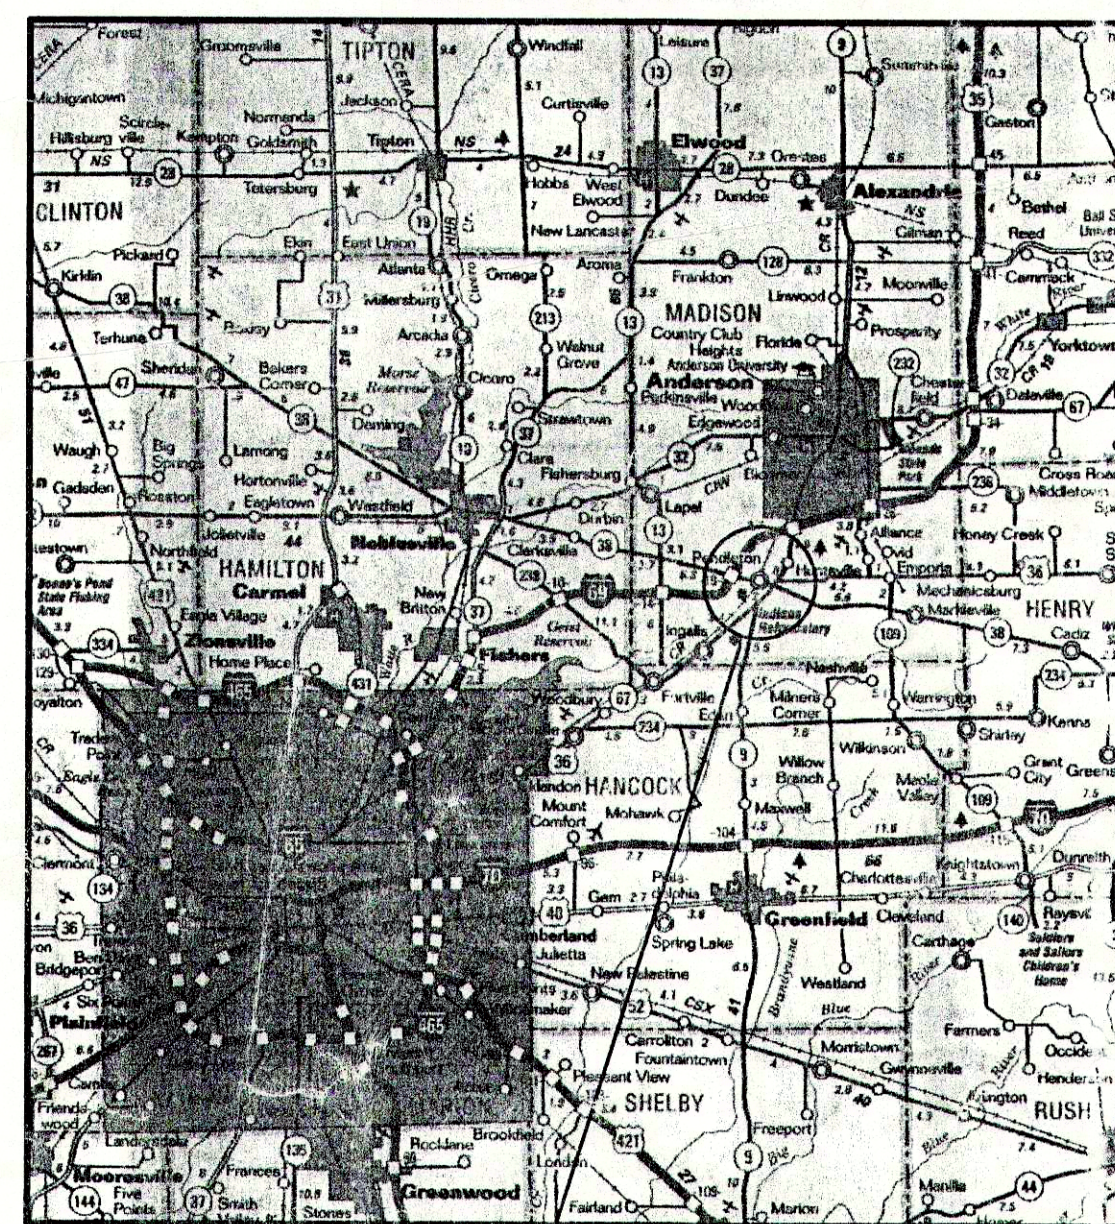


AREA
LOCATION

LOCATION MAP

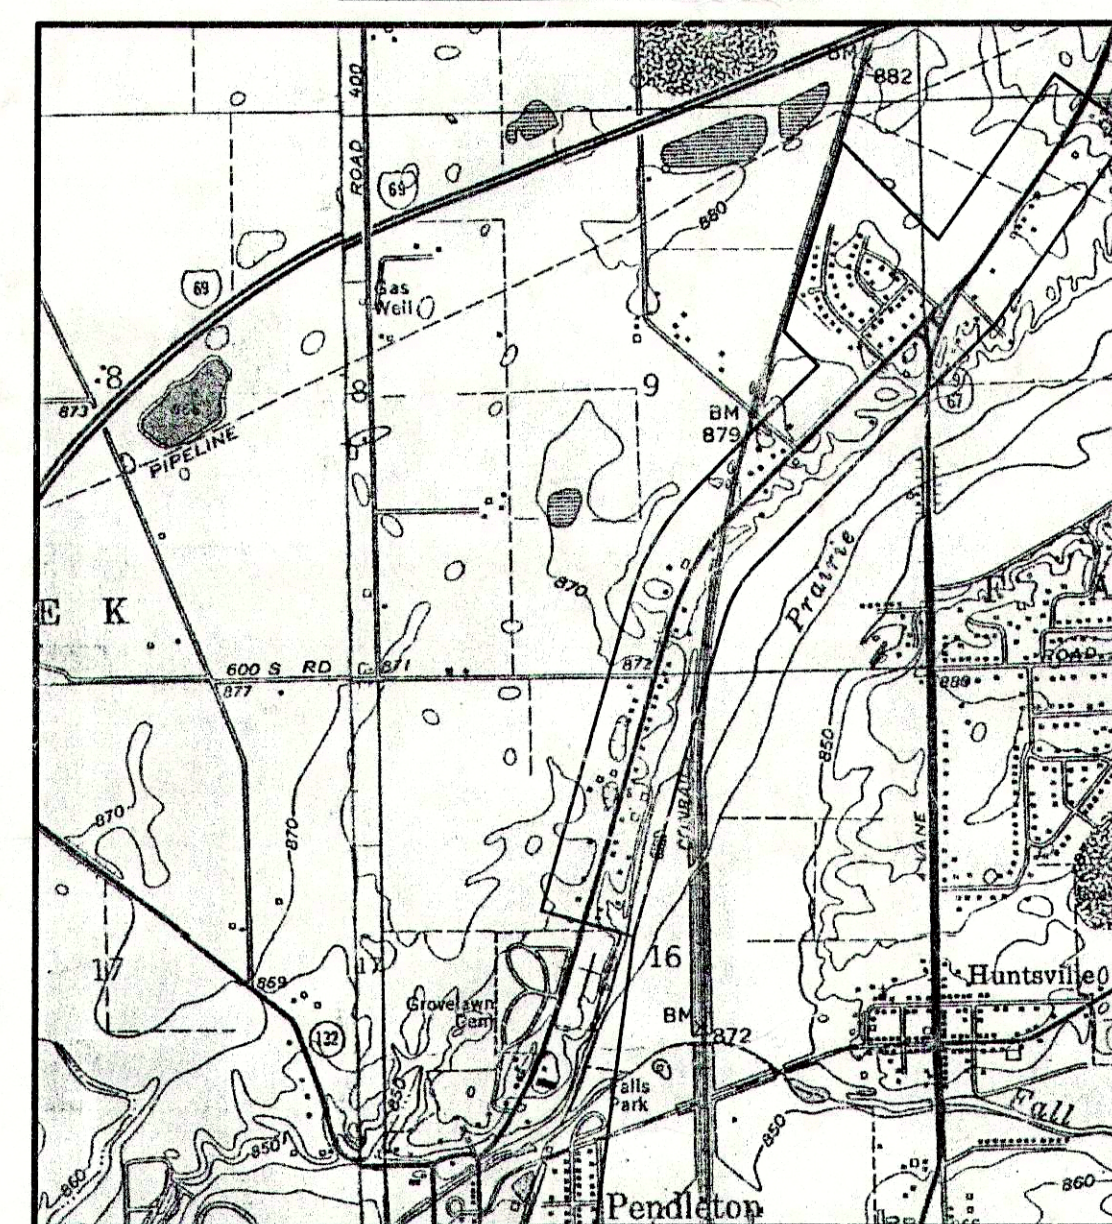

PROJECT
LOCATION

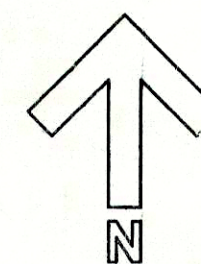

PLANS PREPARED BY:

**TRIAD
ASSOCIATES
INC.**
INDIANAPOLIS, INDIANA

NOTE:
ADDITIONAL RIGHT-OF-WAY OR EASEMENTS MAY
NEED TO BE ACQUIRED FOR INSTALLATION OF SEWER.



DON'T DIG BLIND
CALL BEFORE YOU DIG
1-800-382-5544
1-800-428-5200

PER INDIANA STATE LAW IS-68-1991, IT IS
AGAINST THE LAW TO EXCAVATE WITHOUT
NOTIFYING THE UNDERGROUND LOCATION SERVICE
TWO (2) WORKING DAYS BEFORE COMMENCING WORK.
NOTE: CONTRACTOR TO VERIFY ALL UTILITY LOCATIONS
PRIOR TO THE START OF CONSTRUCTION

THESE PLANS CERTIFIED BY:

James W. Frazell, Professional Engineer

Thomas M. Schubert, Professional Engineer

FALL CREEK REGIONAL WASTE DISTRICT BOARD

Mr. William Clark - President
Mr. Morris McCurdy - Member
Mr. Doug McGee - Member
Mr. Mark Jablonski - Member
Mr. Agon Tolbert - Member
Mr. Dallas Foster - Member
Mr. Jack Kasdorf - Member
Mr. Timothy Green - Member
Mr. John Ellingwood - Member
Mr. Joe Rowlett - General Manager

ATTORNEY

Mr. Randall Sorrell

**RECORD DRAWING
APRIL 2001**

