

# TBM INFORMATION

- FV-TBM #1 - NORTH FLANGE BOLT WITH "Y" NOTCH OF FIRE HYDRANT AT INTERSECTION OF PENDLETON AVENUE AND MARCY AVENUE ELEV. - 878.51
- FV-TBM #2 - FLANGE BOLT UNDER ARROW OF FIRE HYDRANT AT INTERSECTION OF PENDLETON AVENUE AND BESS BOULEVARD ELEV. - 875.94
- FV-TBM #3 - FLANGE BOLT UNDER ARROW OF FIRE HYDRANT AT 5962 PENDLETON AVENUE ELEV. - 878.09
- FV-TBM #4 - FLANGE BOLT WITH CUT LINES OF FIRE HYDRANT ACROSS FROM HOUSE 640(?) ELEV. - 875.62
- FV-TBM #5 - SOUTHEAST FLANGE BOLT WITH TAG LINES OF FIRE HYDRANT AT NORTHEAST CORNER OF CEMETARY ELEV. - 876.20

## UTILITIES

ANDERSON LIGHT AND POWER  
550 BAXTER ROAD  
ANDERSON, INDIANA 46016  
1 (765) 648-6187

GTE  
P.O. BOX 1406  
RICHMOND, INDIANA 47375  
1 (800) 483-5600

INDIANA GAS COMPANY, INC.  
2001 LOUISE STREET  
ANDERSON, INDIANA 46016  
1 (800) 777-2060

CYNERGY/PSI  
100 S. MILL CREEK ROAD  
NOBLESVILLE, INDIANA 46060  
1 (800) 521-2232

TCI OF CENTRAL INDIANA  
335 E. 10th STREET  
ANDERSON, INDIANA 46016  
1 (765) 649-0407

PENDLETON MUNICIPAL WATER UTILITY  
P.O. BOX 230  
PENDLETON, INDIANA 46064  
1 (765) 778-2173

## LEGEND

- 4 - SHEET DESIGNATION
- PROPOSED GRAVITY SEWER
- PROPOSED SANITARY MANHOLE
- PROPOSED SANITARY FORCEMAIN


NOTE:  
ADDITIONAL RIGHT-OF-WAY OR EASEMENTS MAY  
NEED TO BE ACQUIRED FOR INSTALLATION OF SEWER.



DON'T DIG BLIND  
CALL BEFORE YOU DIG  
TOLL FREE  
1-800-382-5544  
LOCAL SERVICE  
1-800-428-5200


PER INDIANA STATE LAW IS-69-1991, IT IS  
AGAINST THE LAW TO EXCAVATE WITHOUT  
NOTIFYING THE UNDERGROUND LOCATION SERVICE  
TWO (2) WORKING DAYS BEFORE COMMENCING WORK.

NOTE: CONTRACTOR TO VERIFY ALL UTILITY LOCATIONS  
PRIOR TO THE START OF CONSTRUCTION

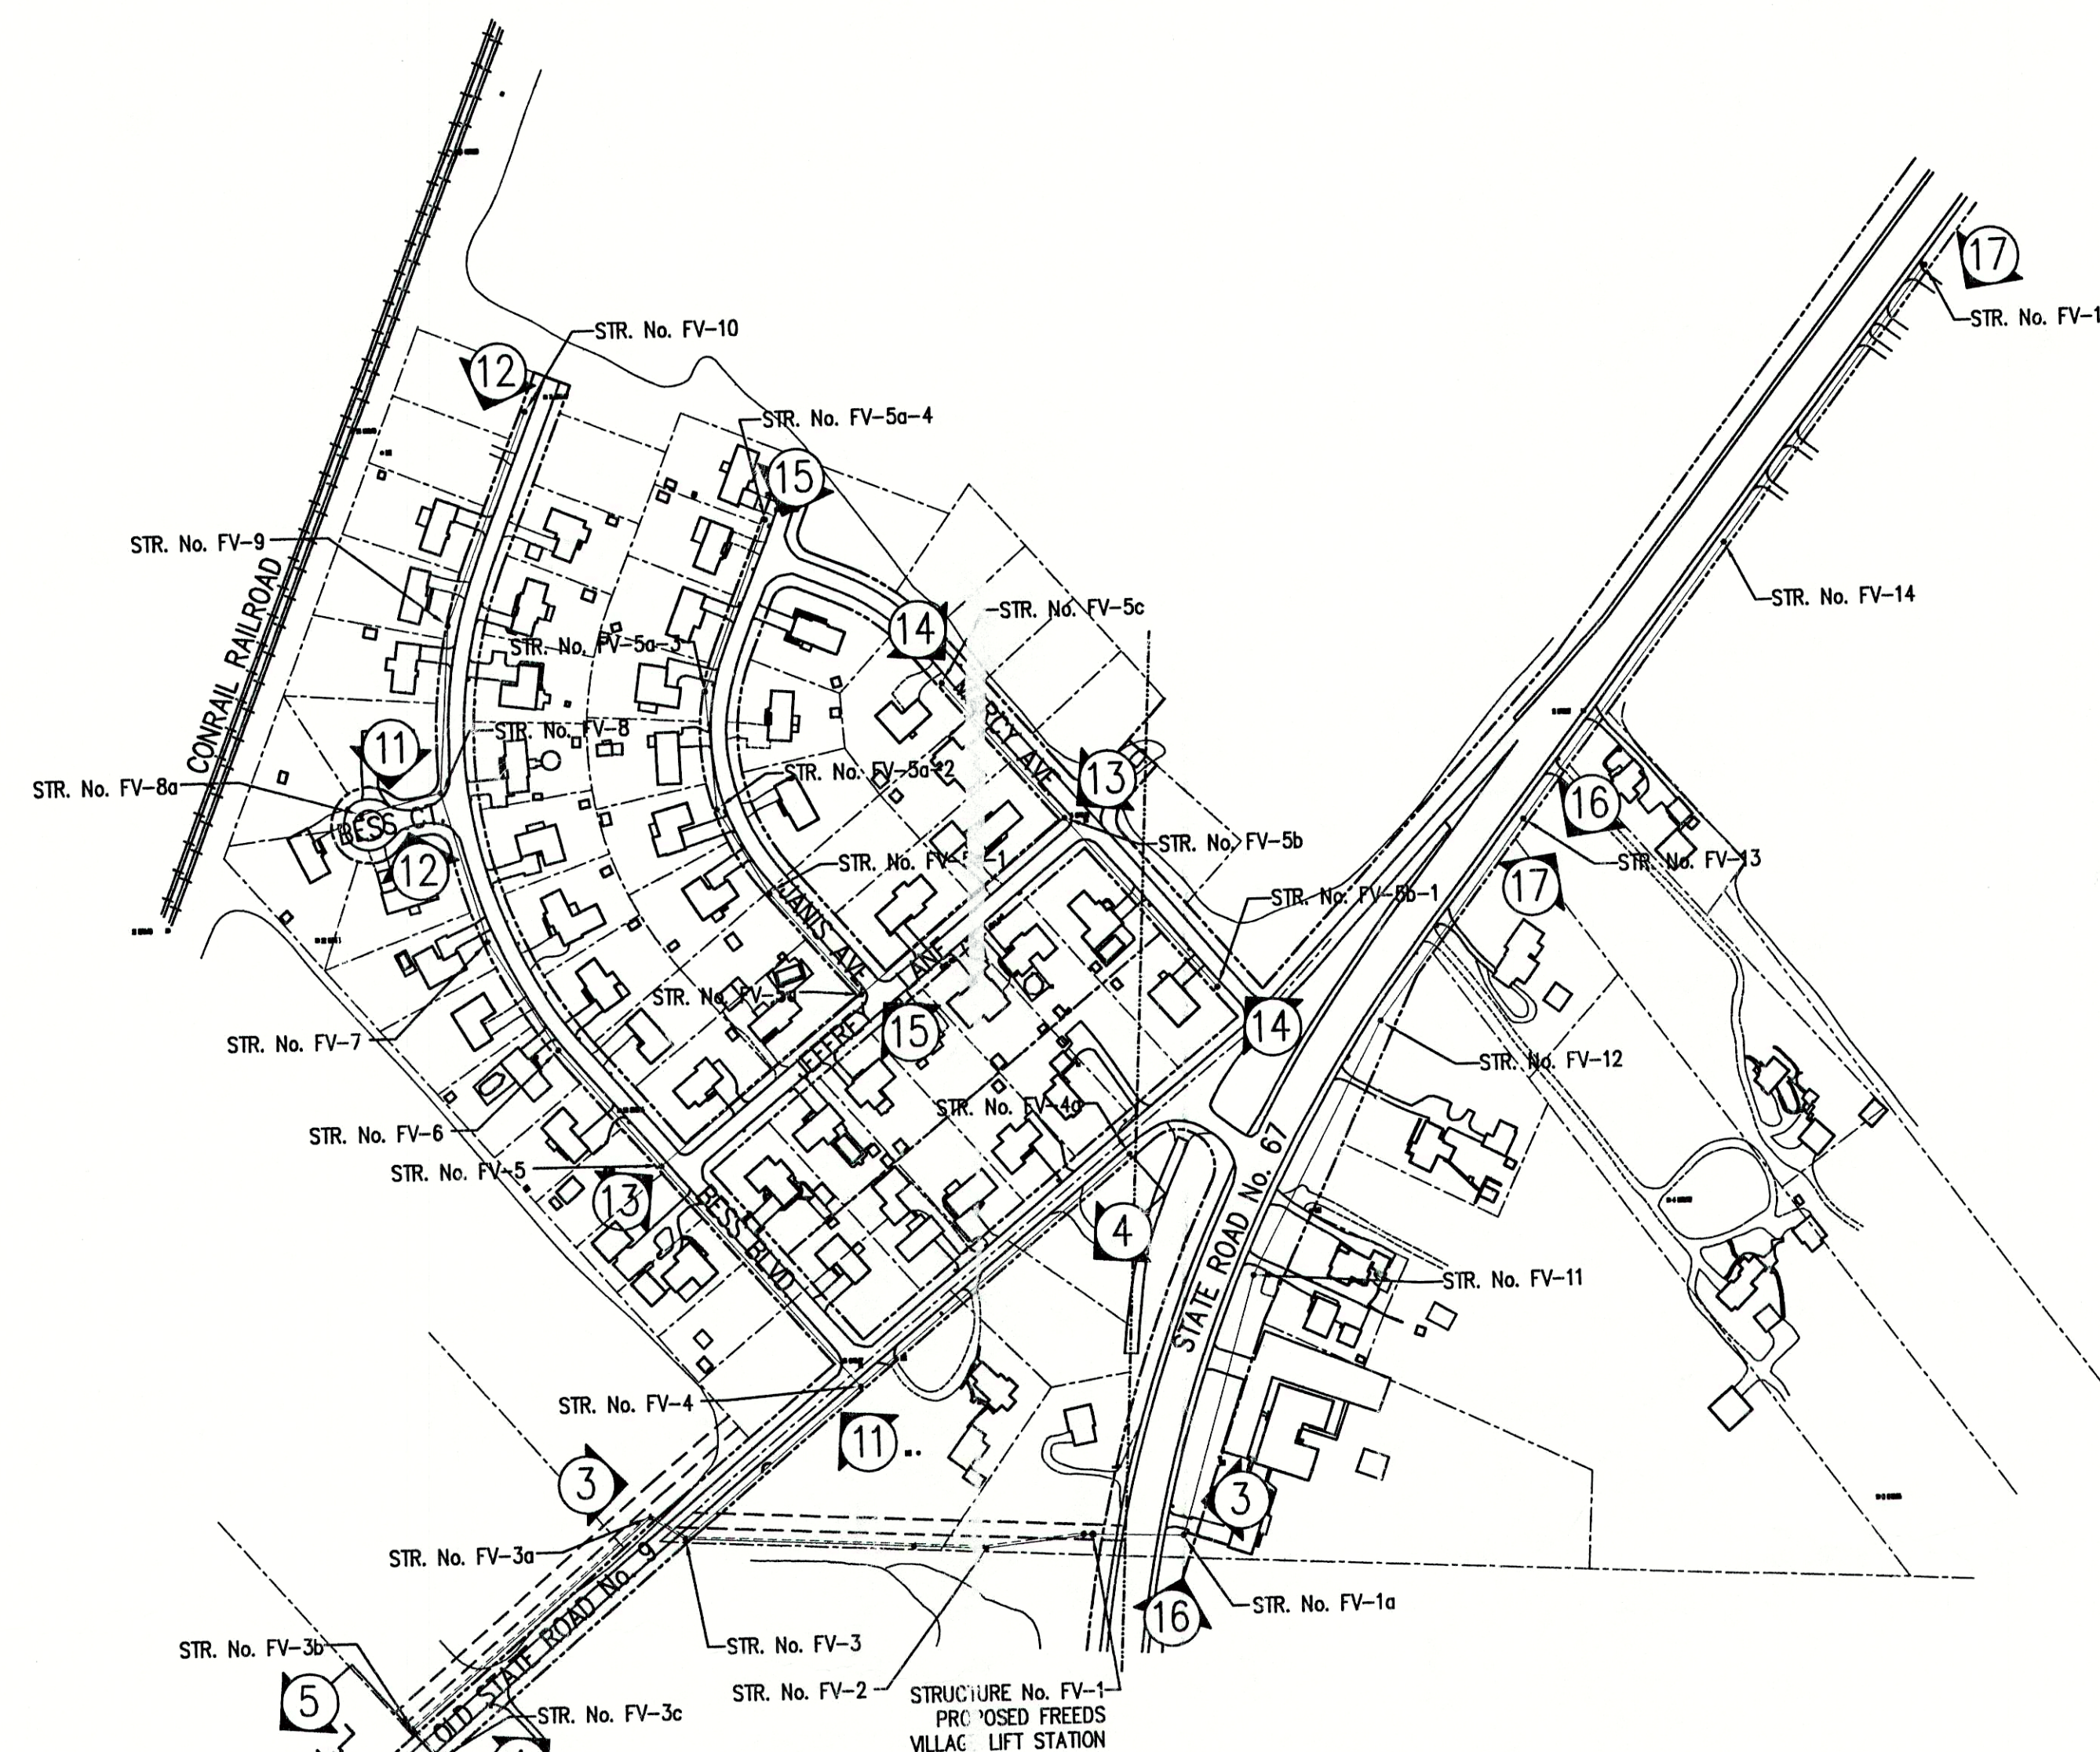

AREA BASE MAP

NOT TO SCALE

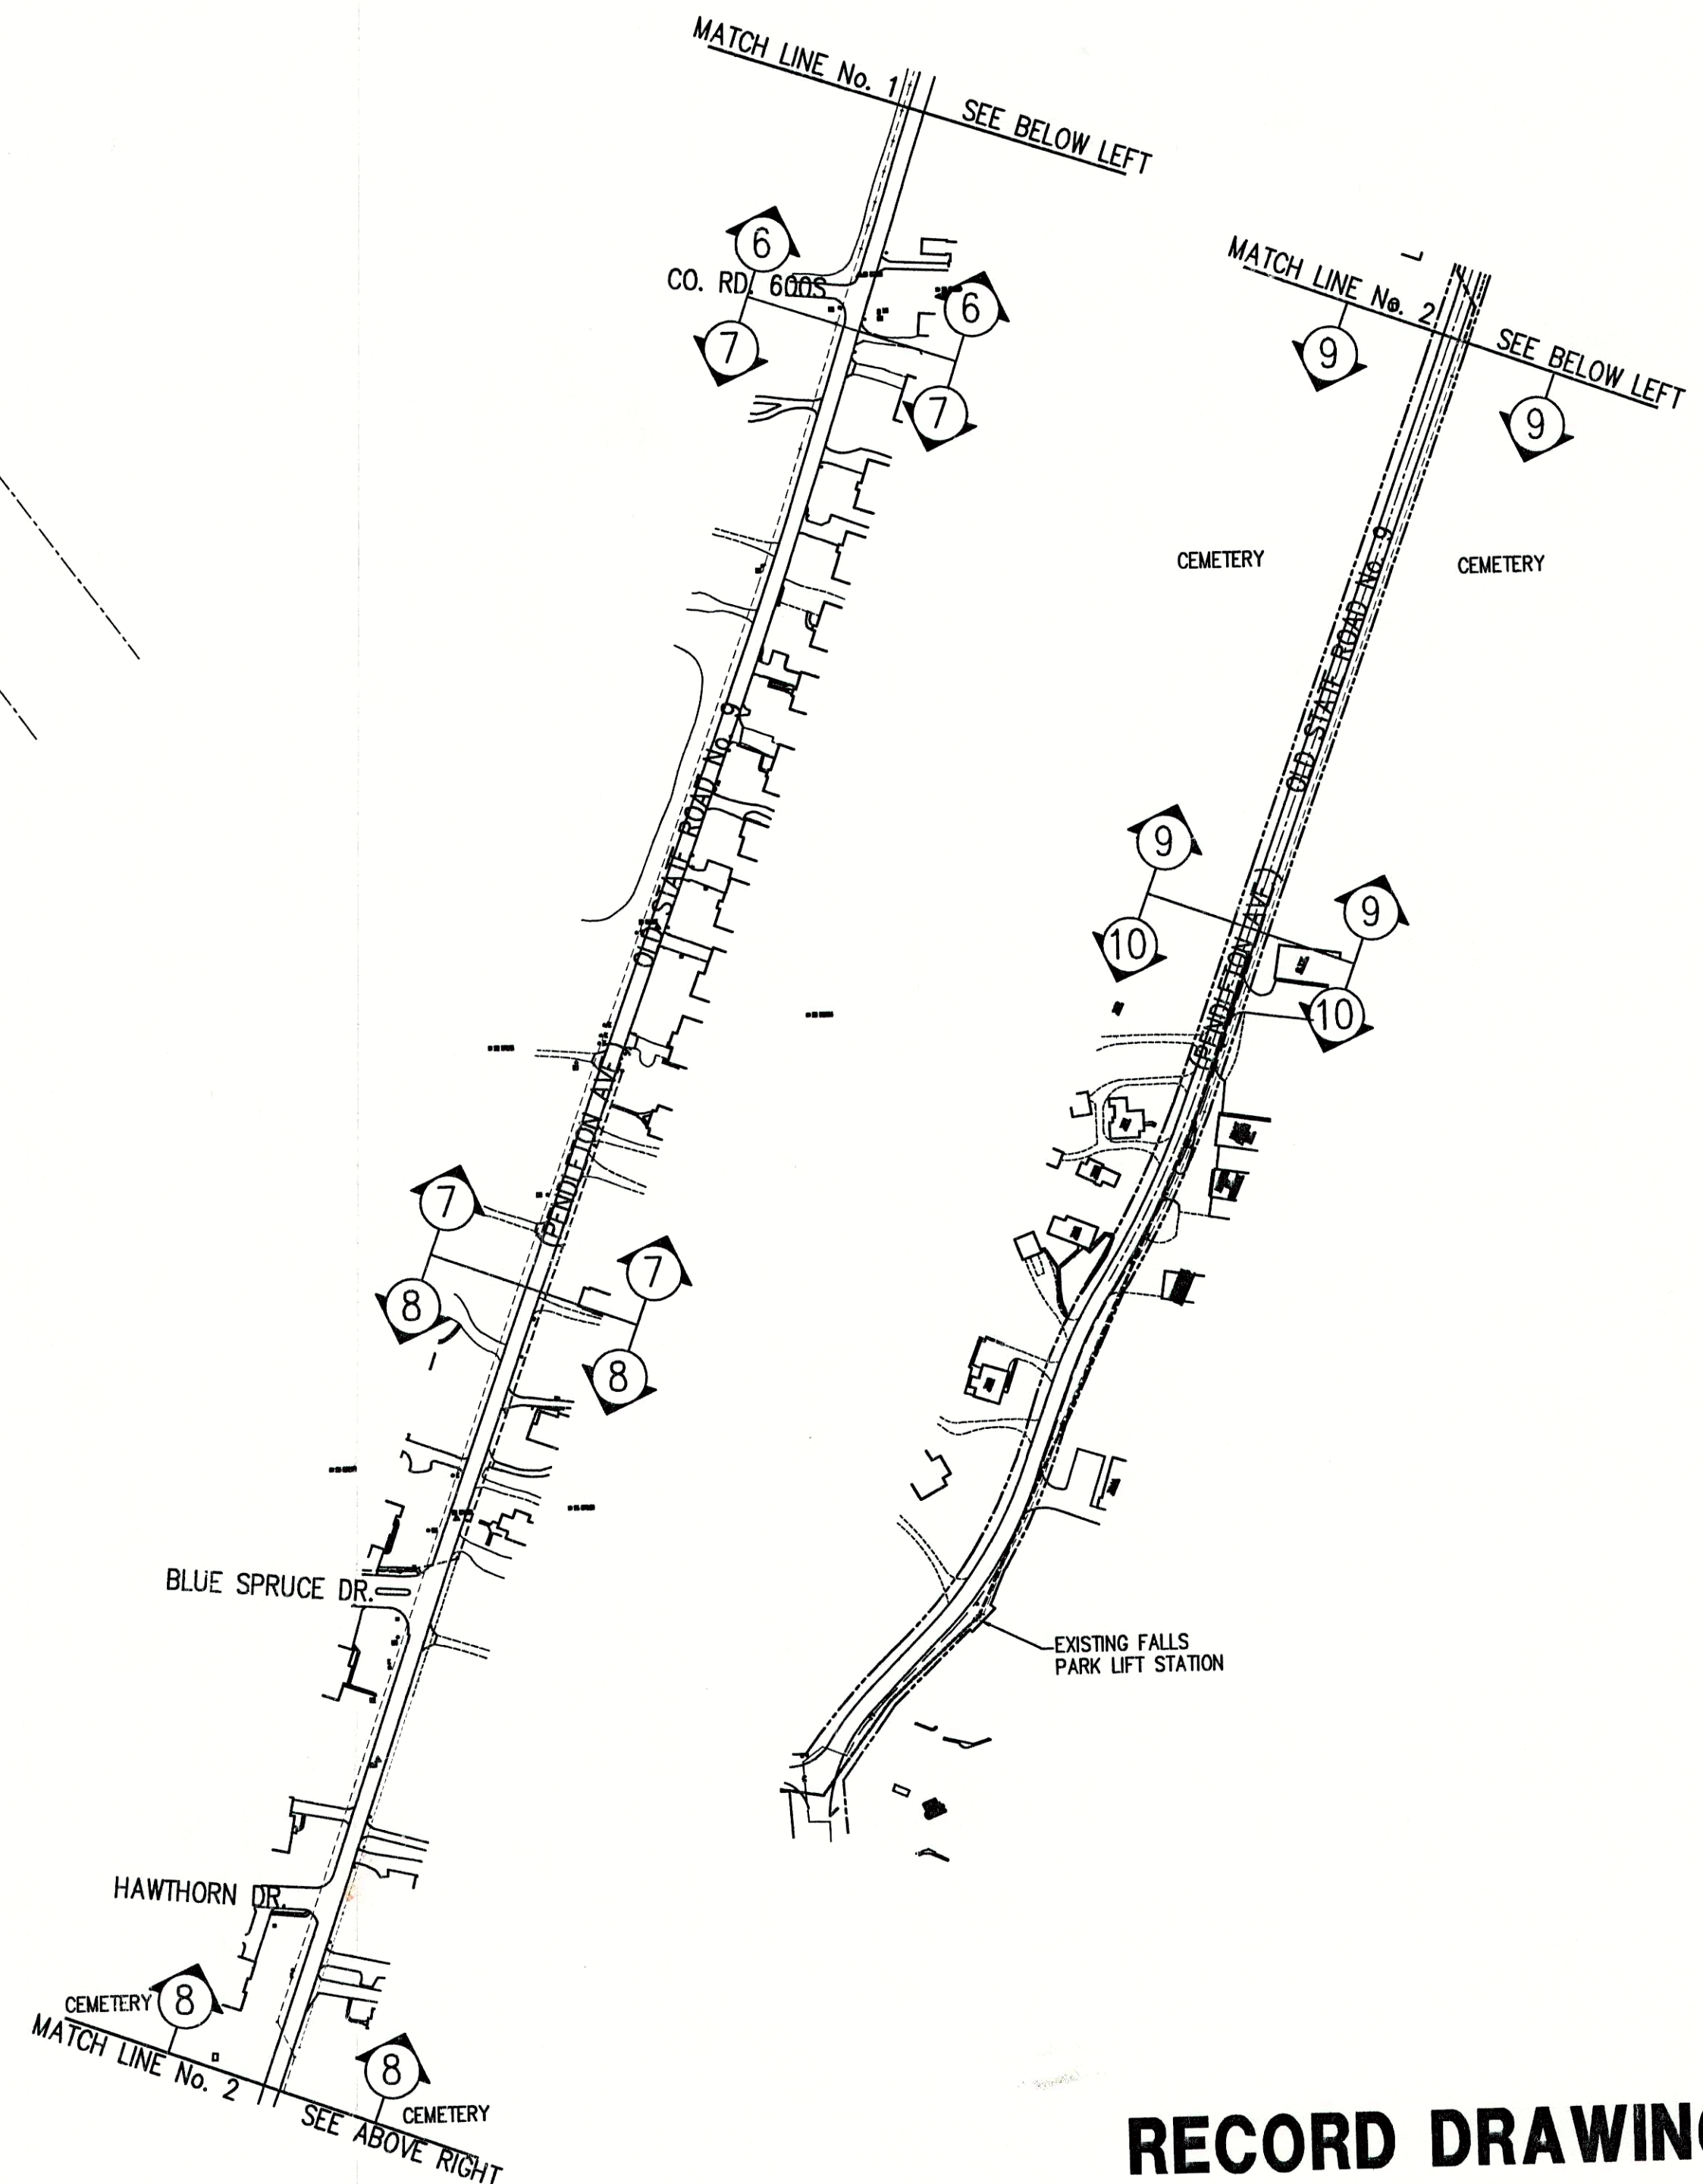

## RECORD DRAWING APRIL 2001

FREEDS VILLAGE SUBDIVISION  
FALL CREEK REGIONAL WASTE DISTRICT

PROJECT BASE MAP

DRAWN BY:	DATE	PROJECT No.	SHEET No.
DAP	04/12/98	98008A	2
DESIGNED BY:	SCALE	CHECKED BY:	OF
D.A. Pauling	AS NOTED	James W. Frazell, P.E.	20

NO.	DATE	DESCRIPTION	BY

**TRIAD ASSOCIATES INC.**  
INDIANAPOLIS, INDIANA

APPROVED BY:  
**THOMAS M. SCHUBERT**  
REGISTERED  
No. 15614  
STATE OF INDIANA  
PROFESSIONAL ENGINEER  
Thomas M. Schubert, P.E.