




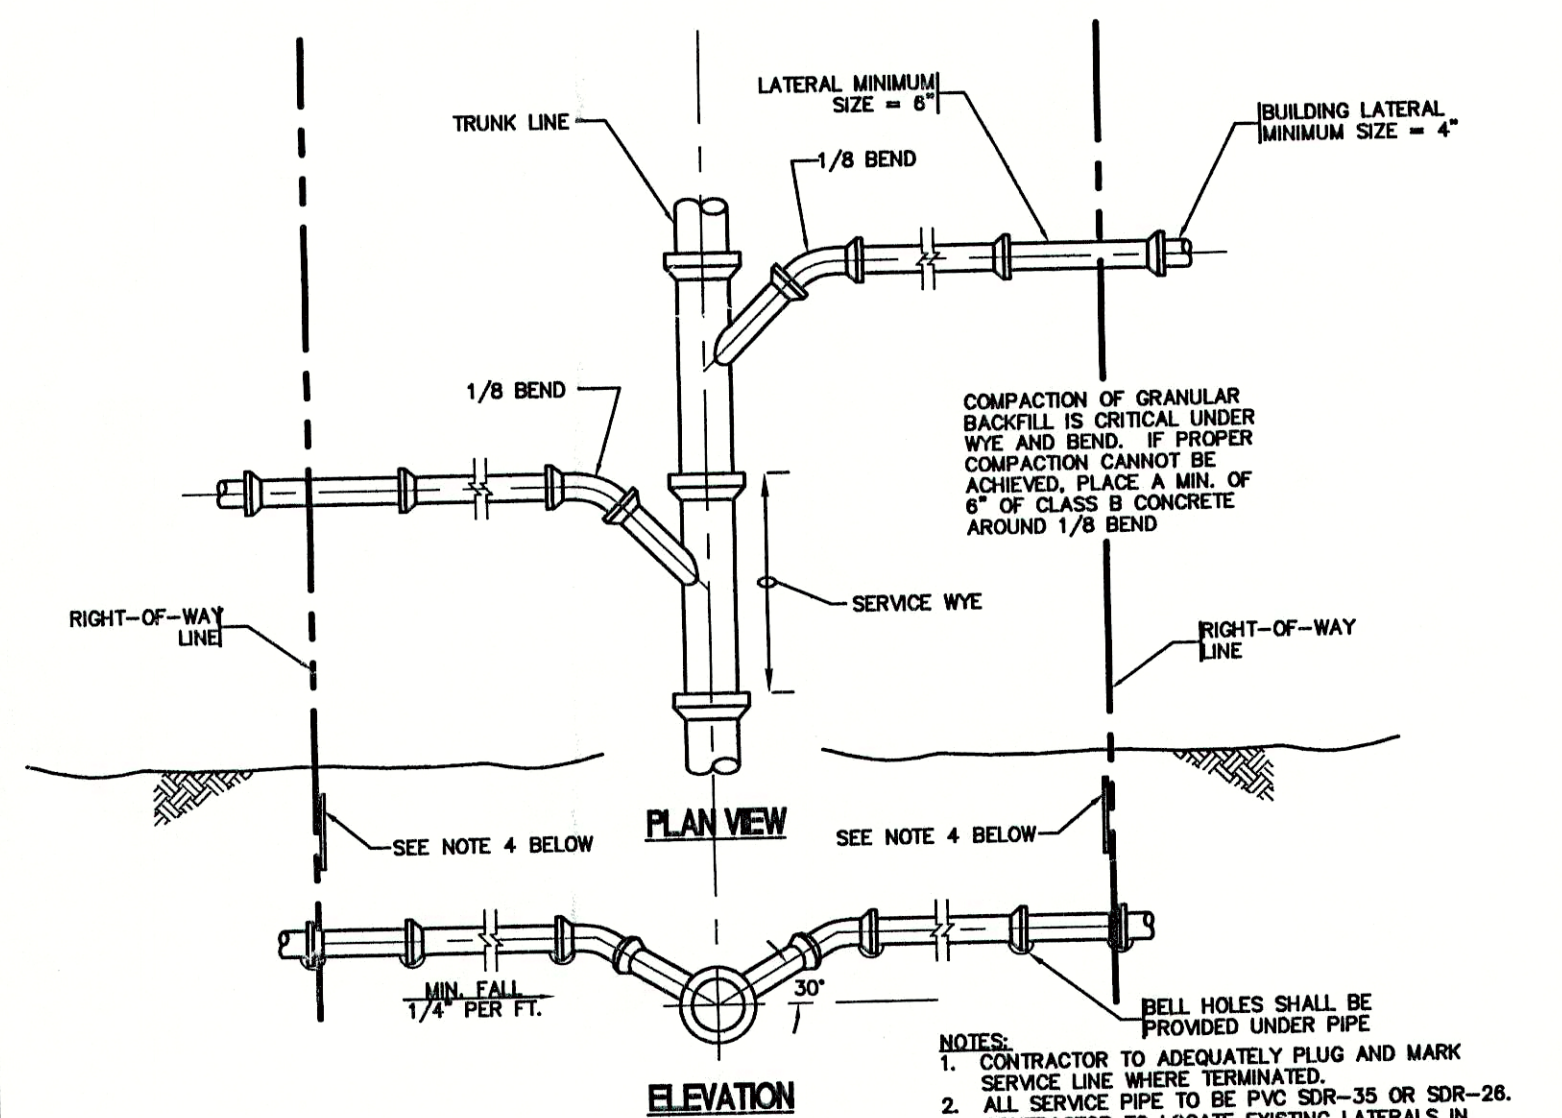


1 SERVICE CONNECTION DETAIL
SCALE: N.T.S.

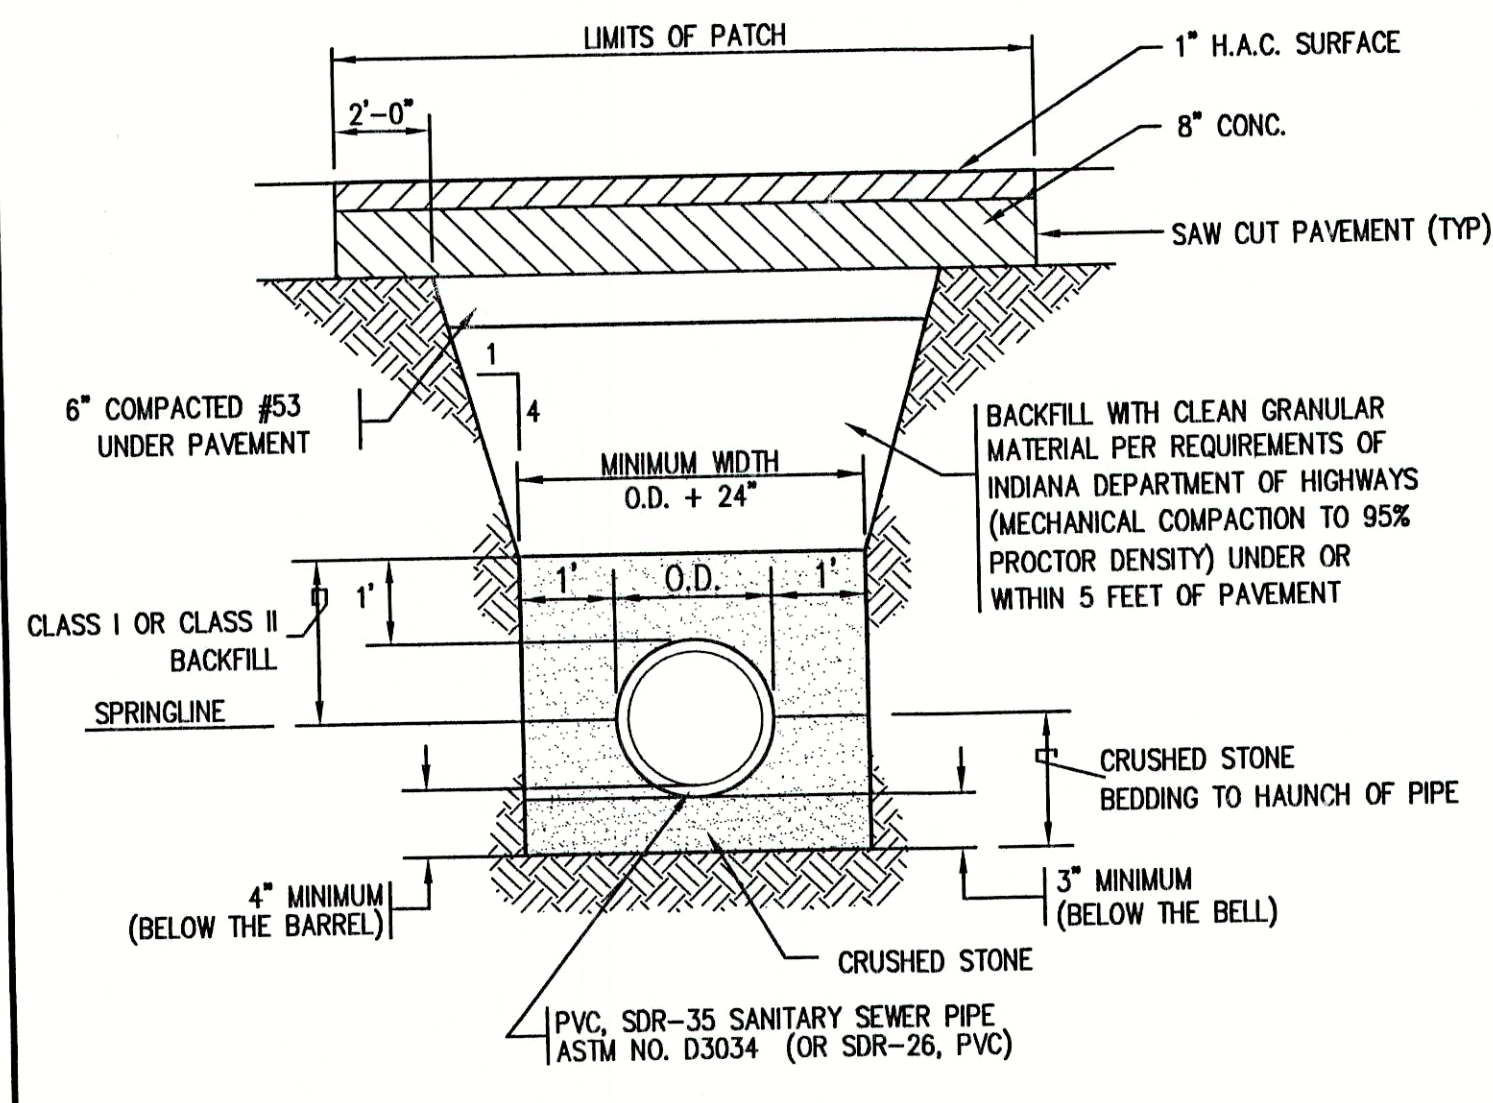


2 TYPICAL TRENCH AND PAVEMENT PATCH DETAIL
SCALE: N.T.S.

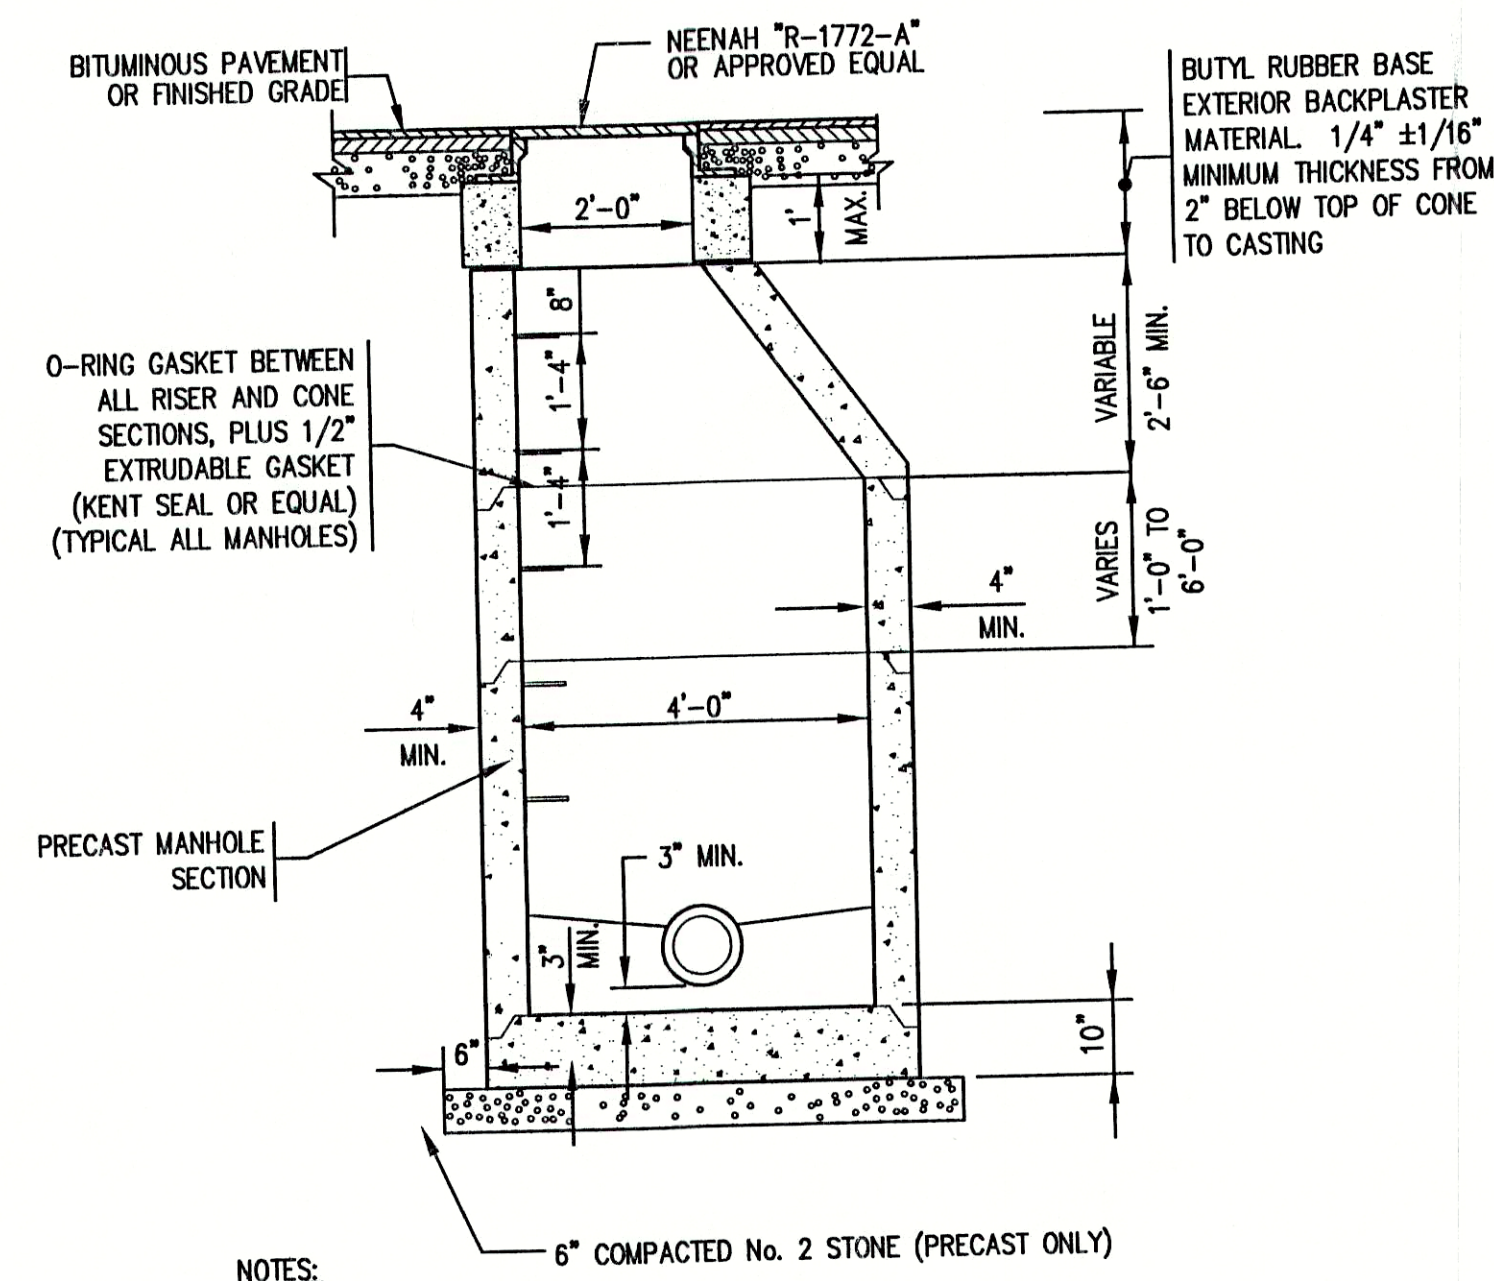


3 SANITARY MANHOLE
SCALE: N.T.S.

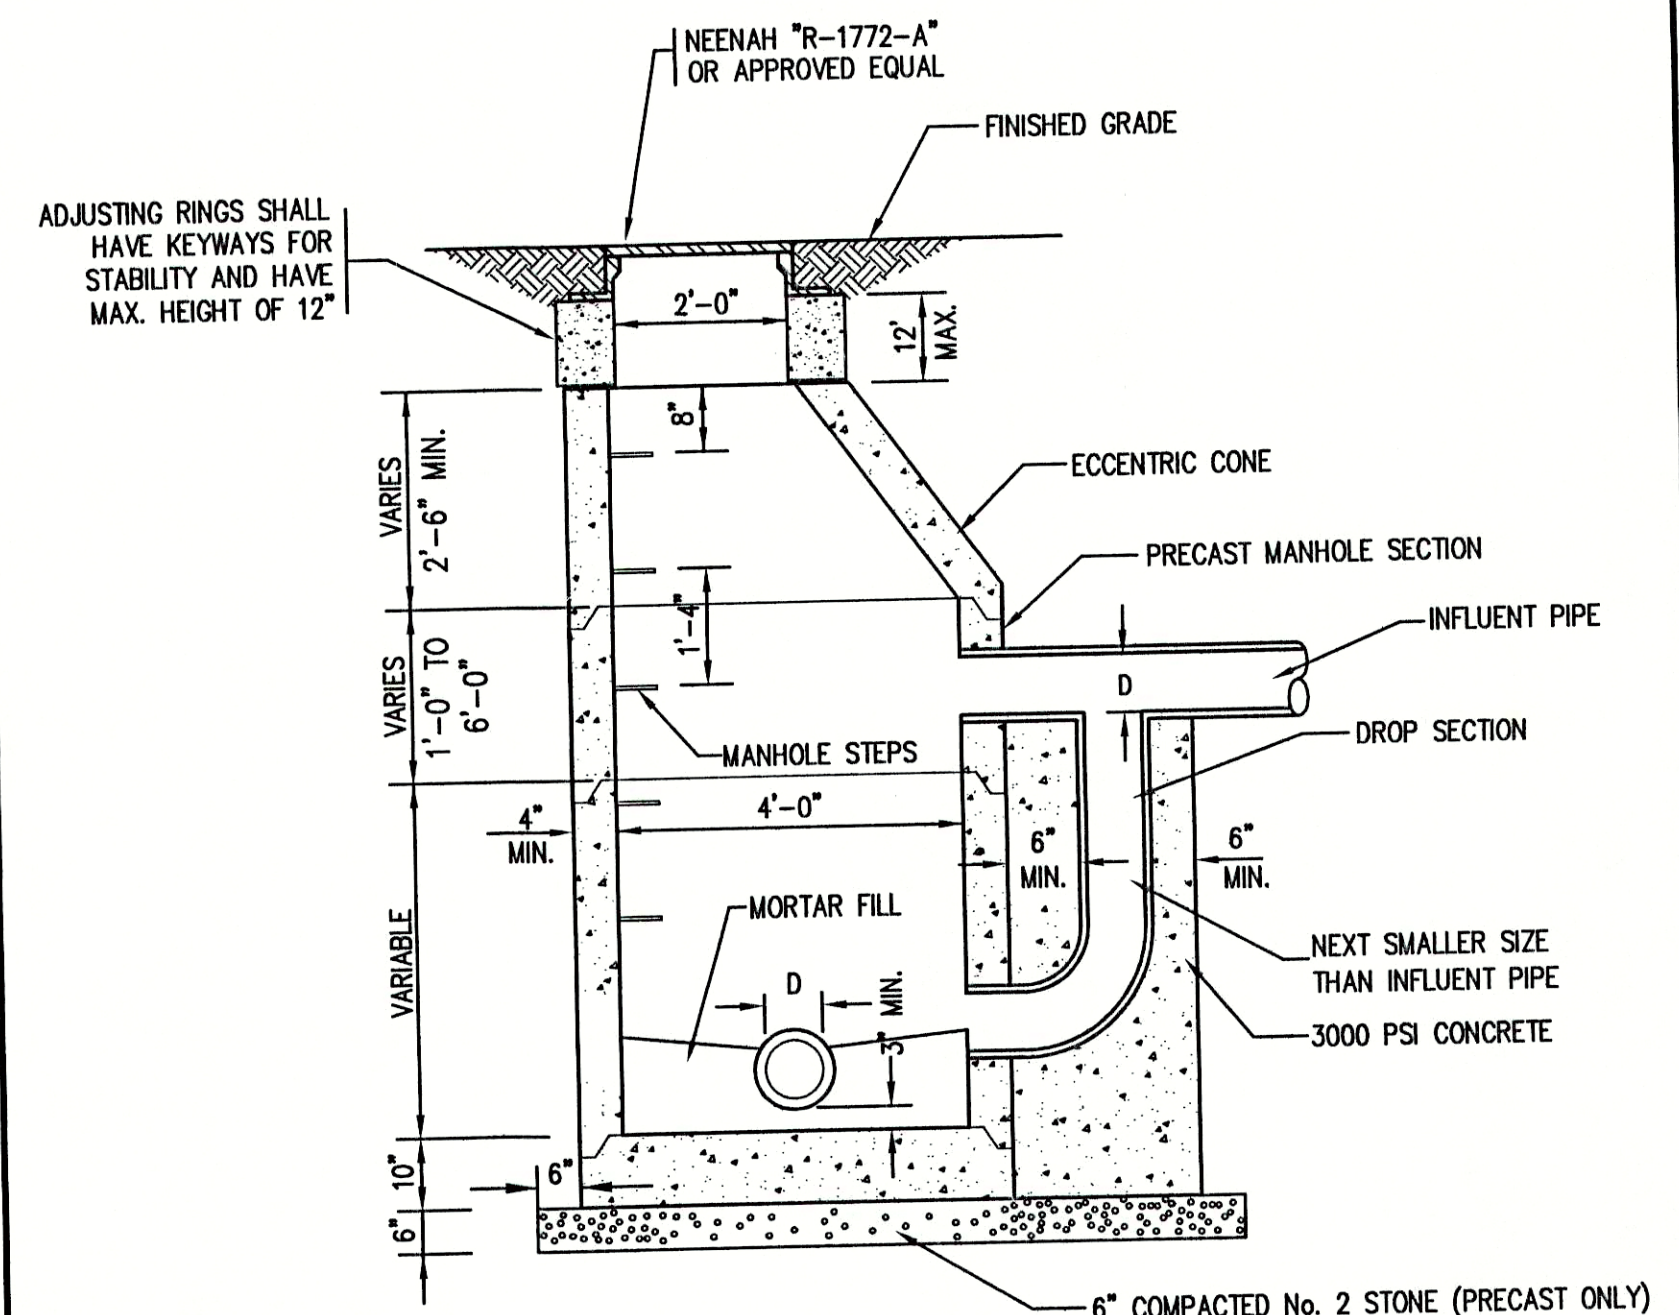


4 DROP MANHOLE
SCALE: N.T.S.

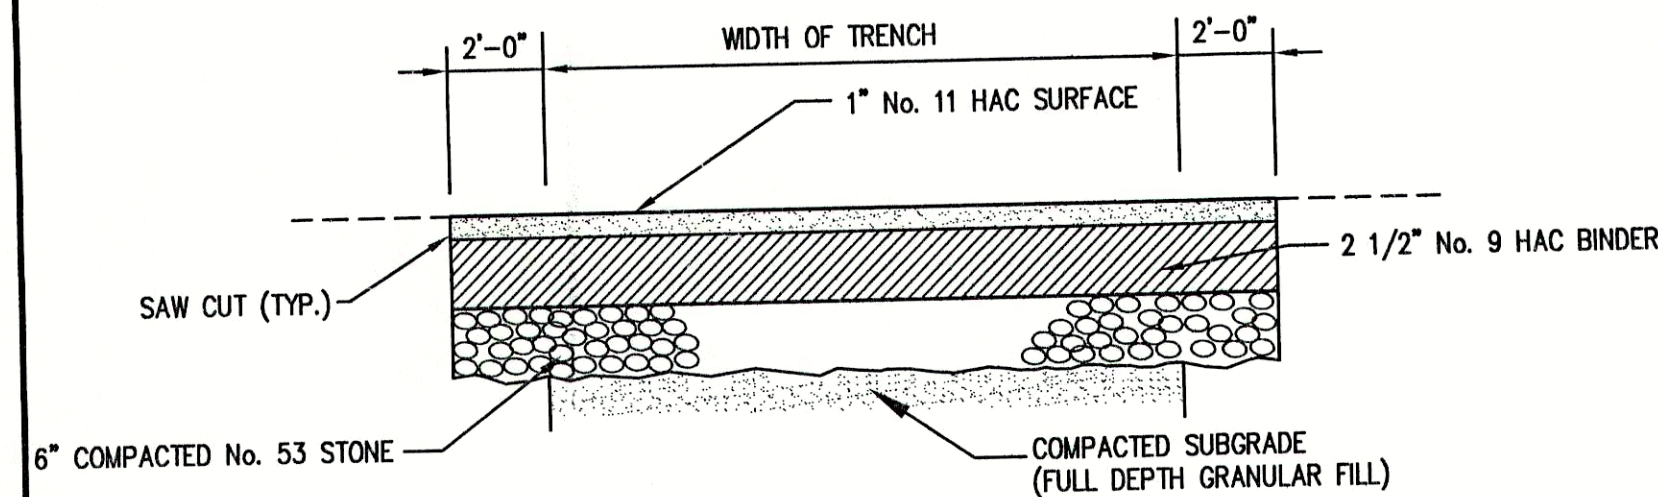


5 ASPHALT DRIVE REPAIR DETAIL
SCALE: N.T.S.

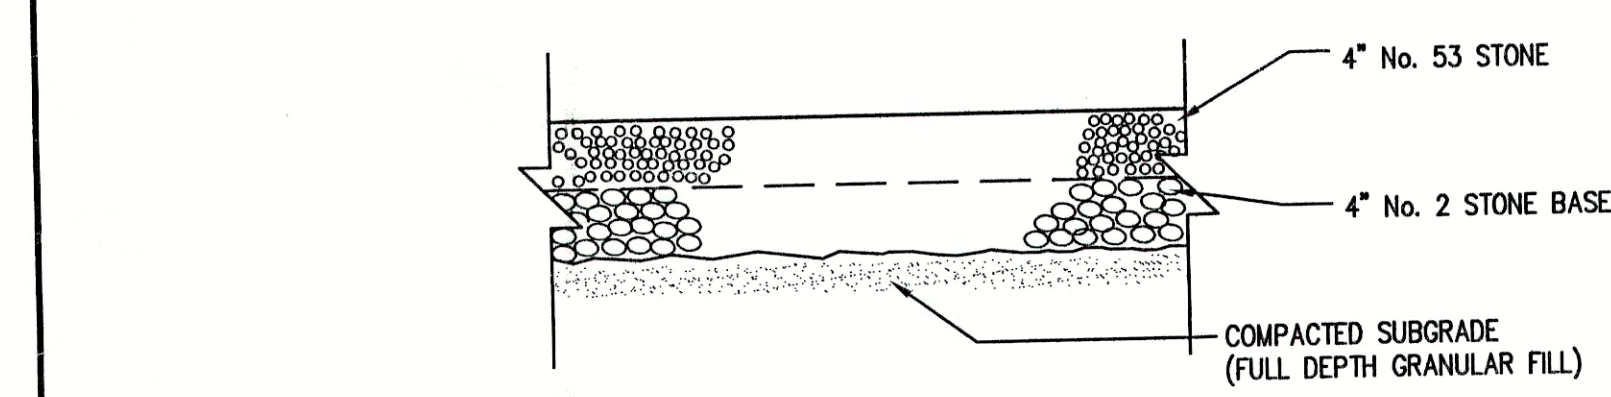


6 STONE DRIVE REPAIR DETAIL
SCALE: N.T.S.

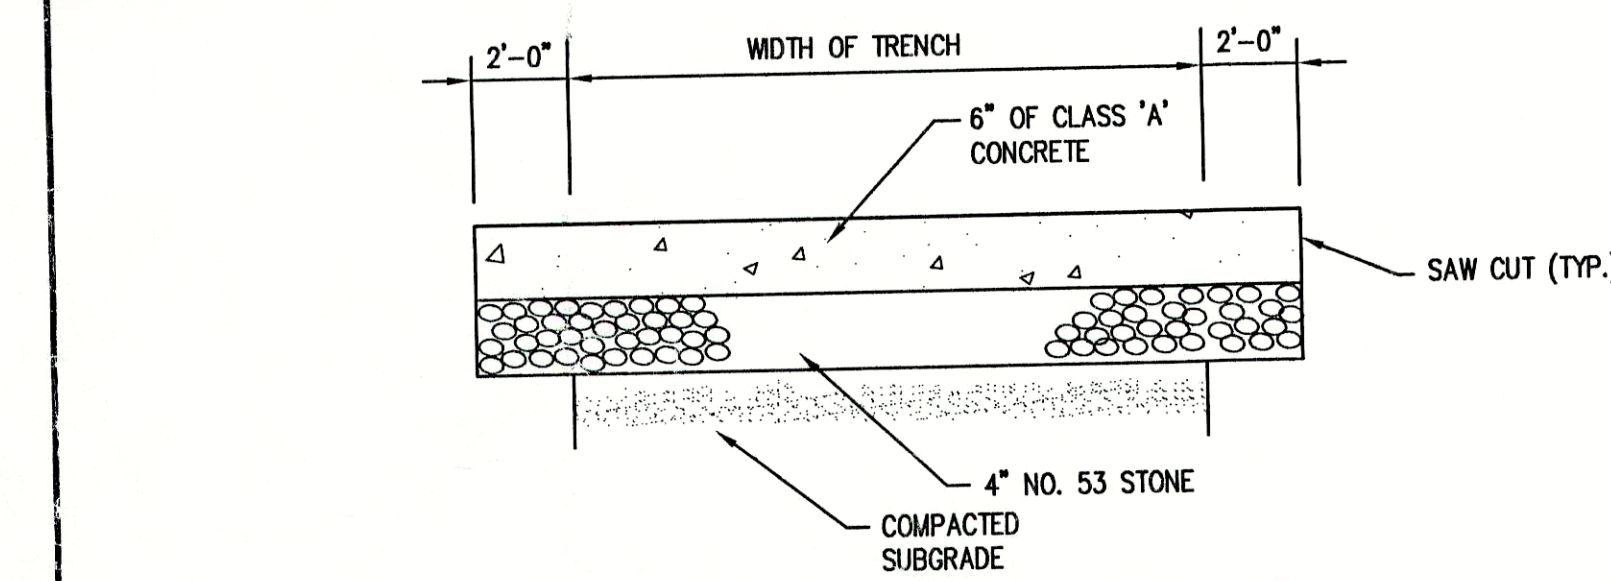


7 CONCRETE DRIVE REPAIR DETAIL
SCALE: N.T.S.

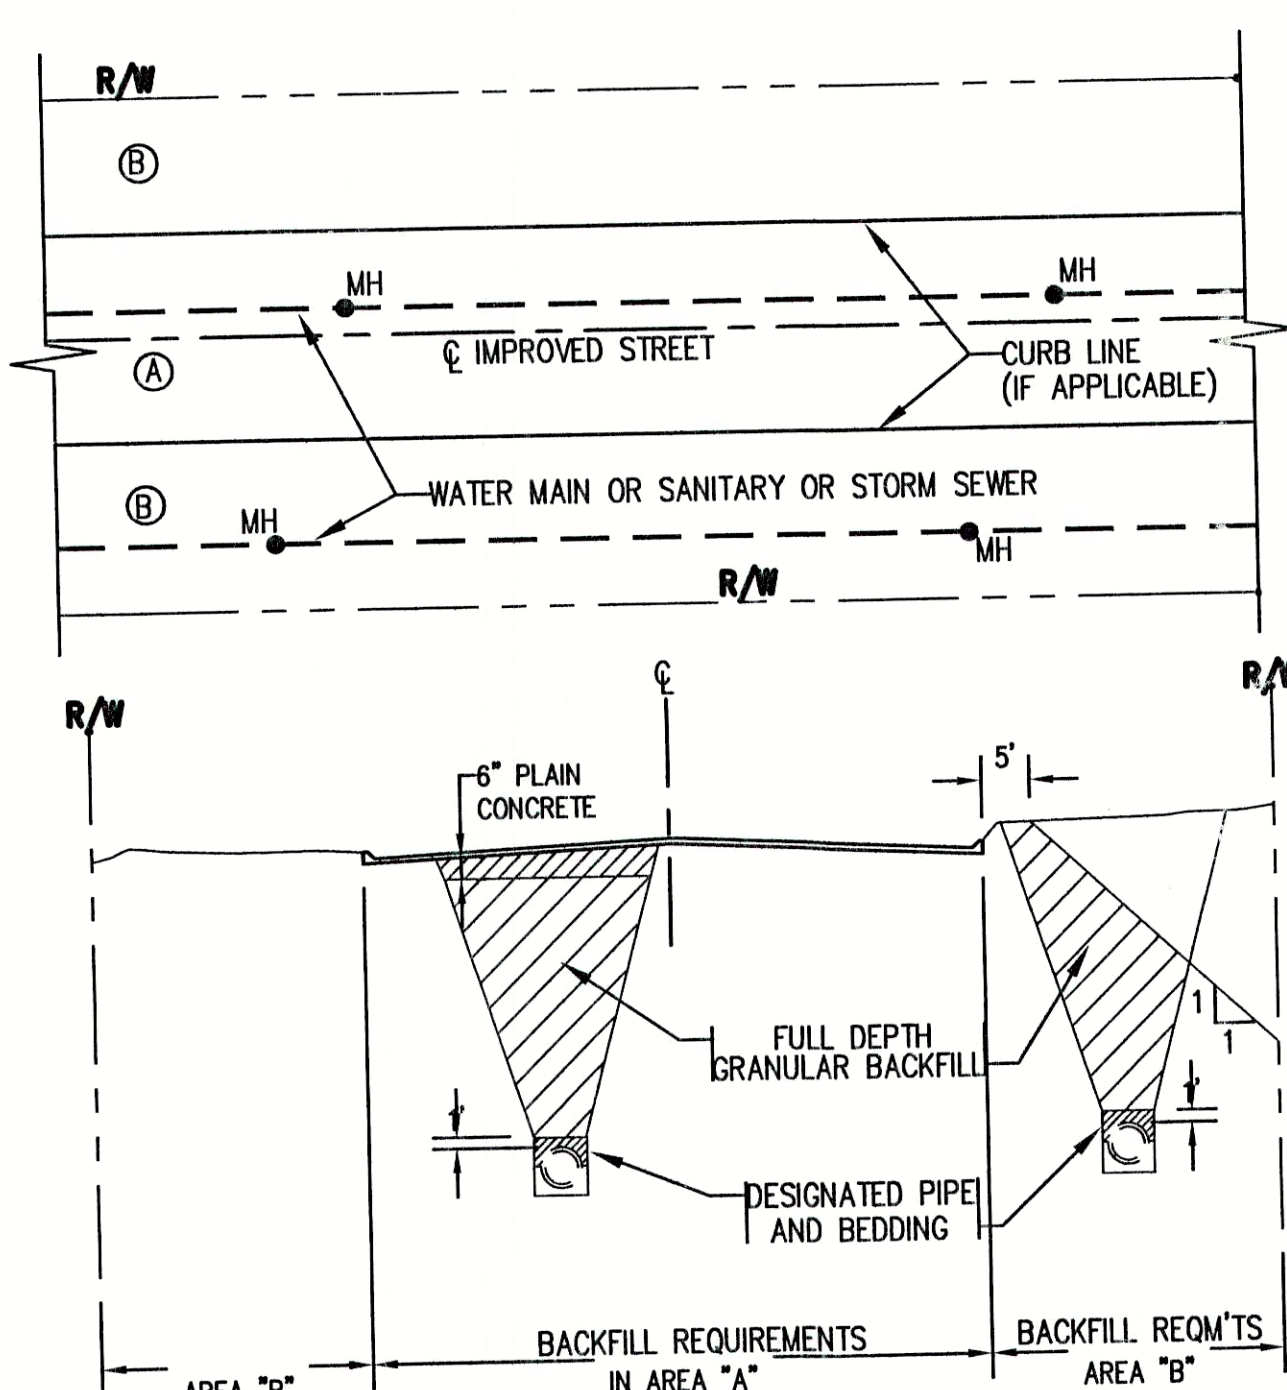

8 BACKFILL REQUIREMENTS
(FOR PIPELINES WITHIN RIGHT-OF-WAY FOR IMPROVED STREETS)

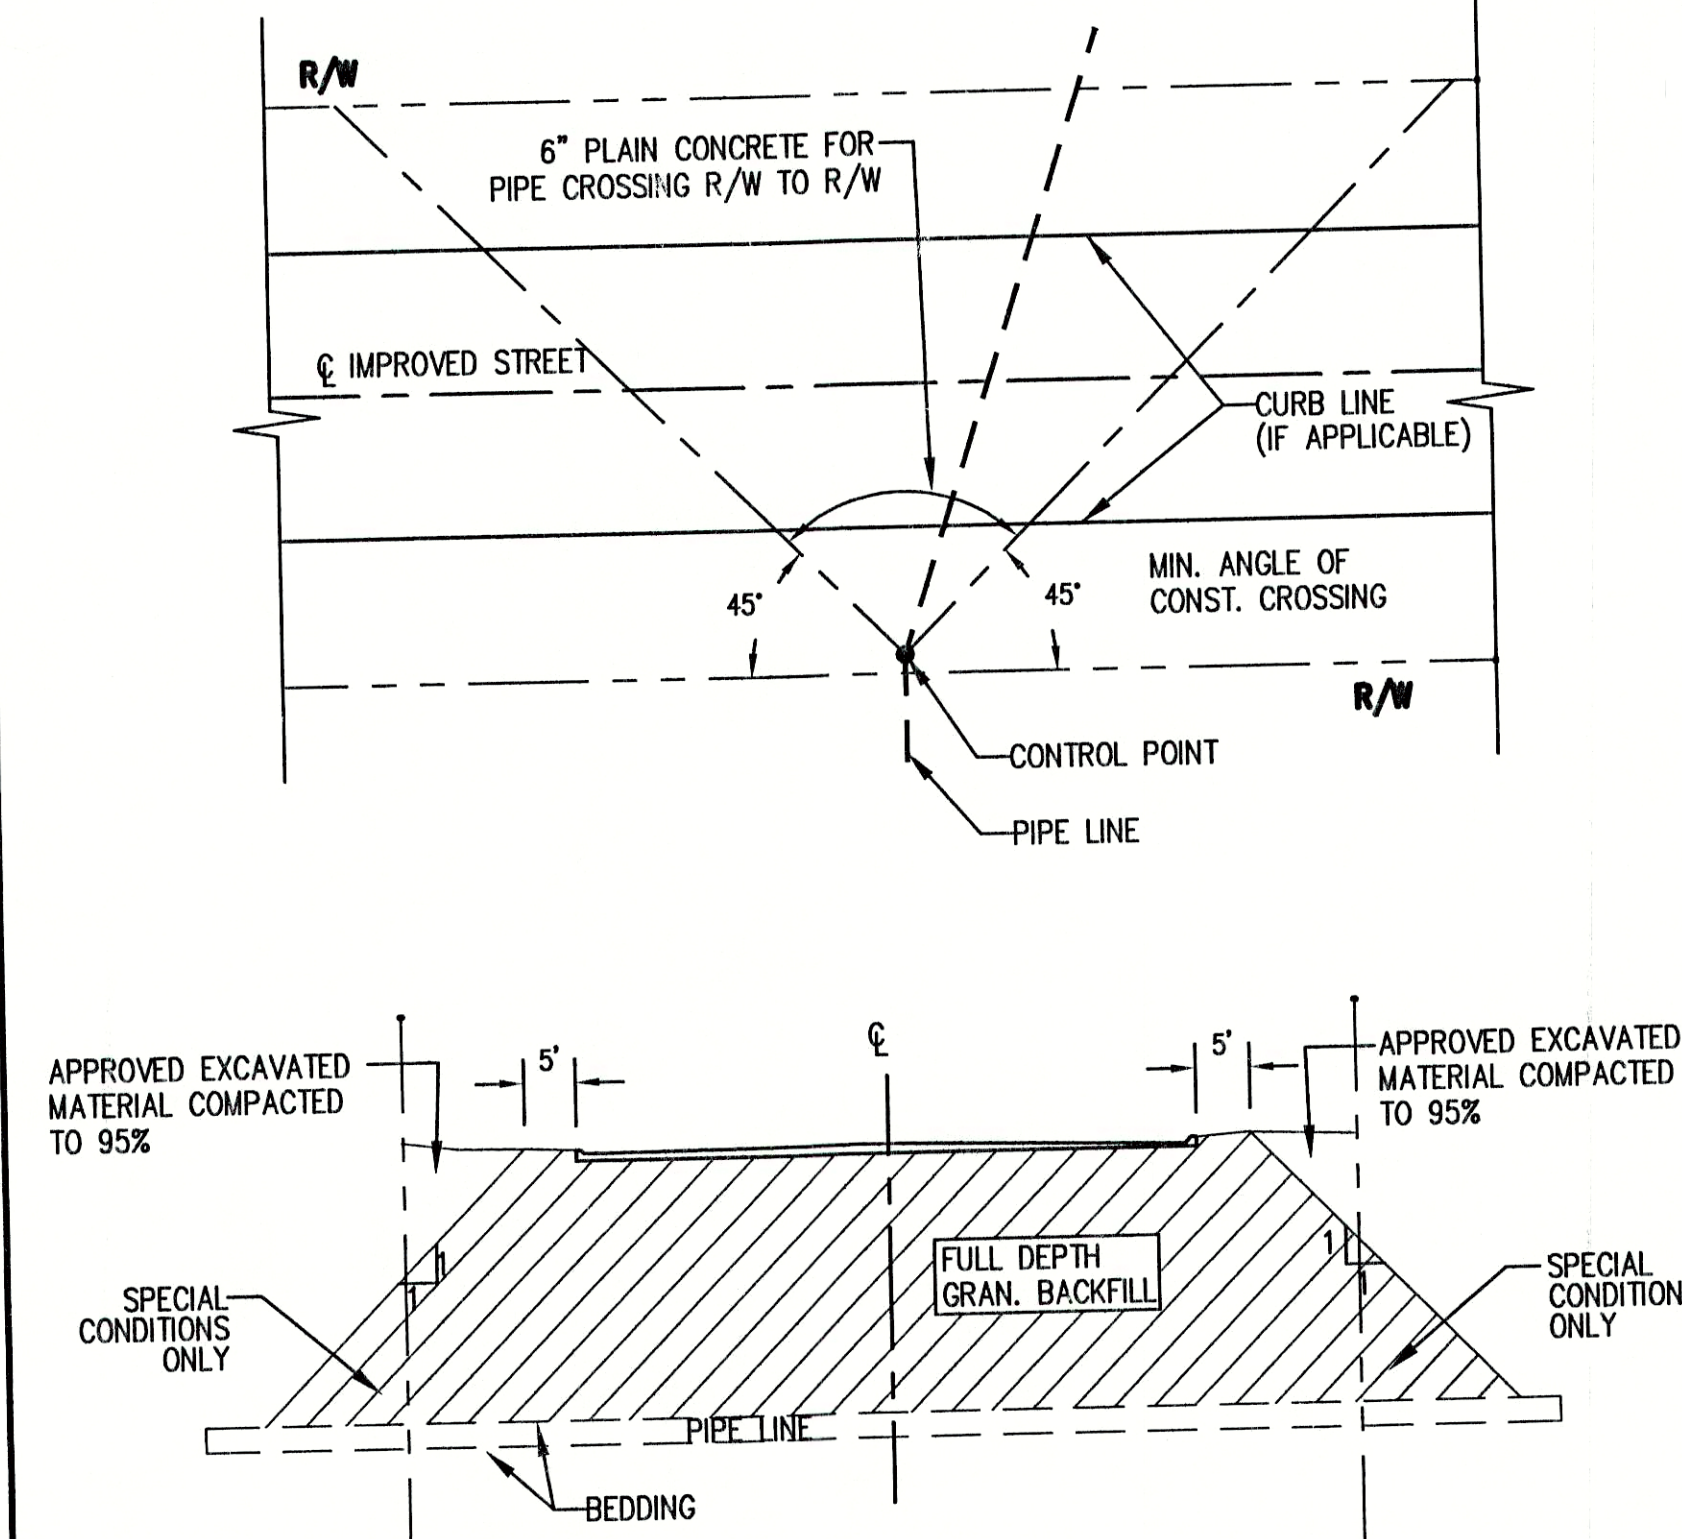

9 BACKFILL REQUIREMENTS
(FOR PIPELINES CROSSING RIGHT-OF-WAY FOR IMPROVED STREETS)

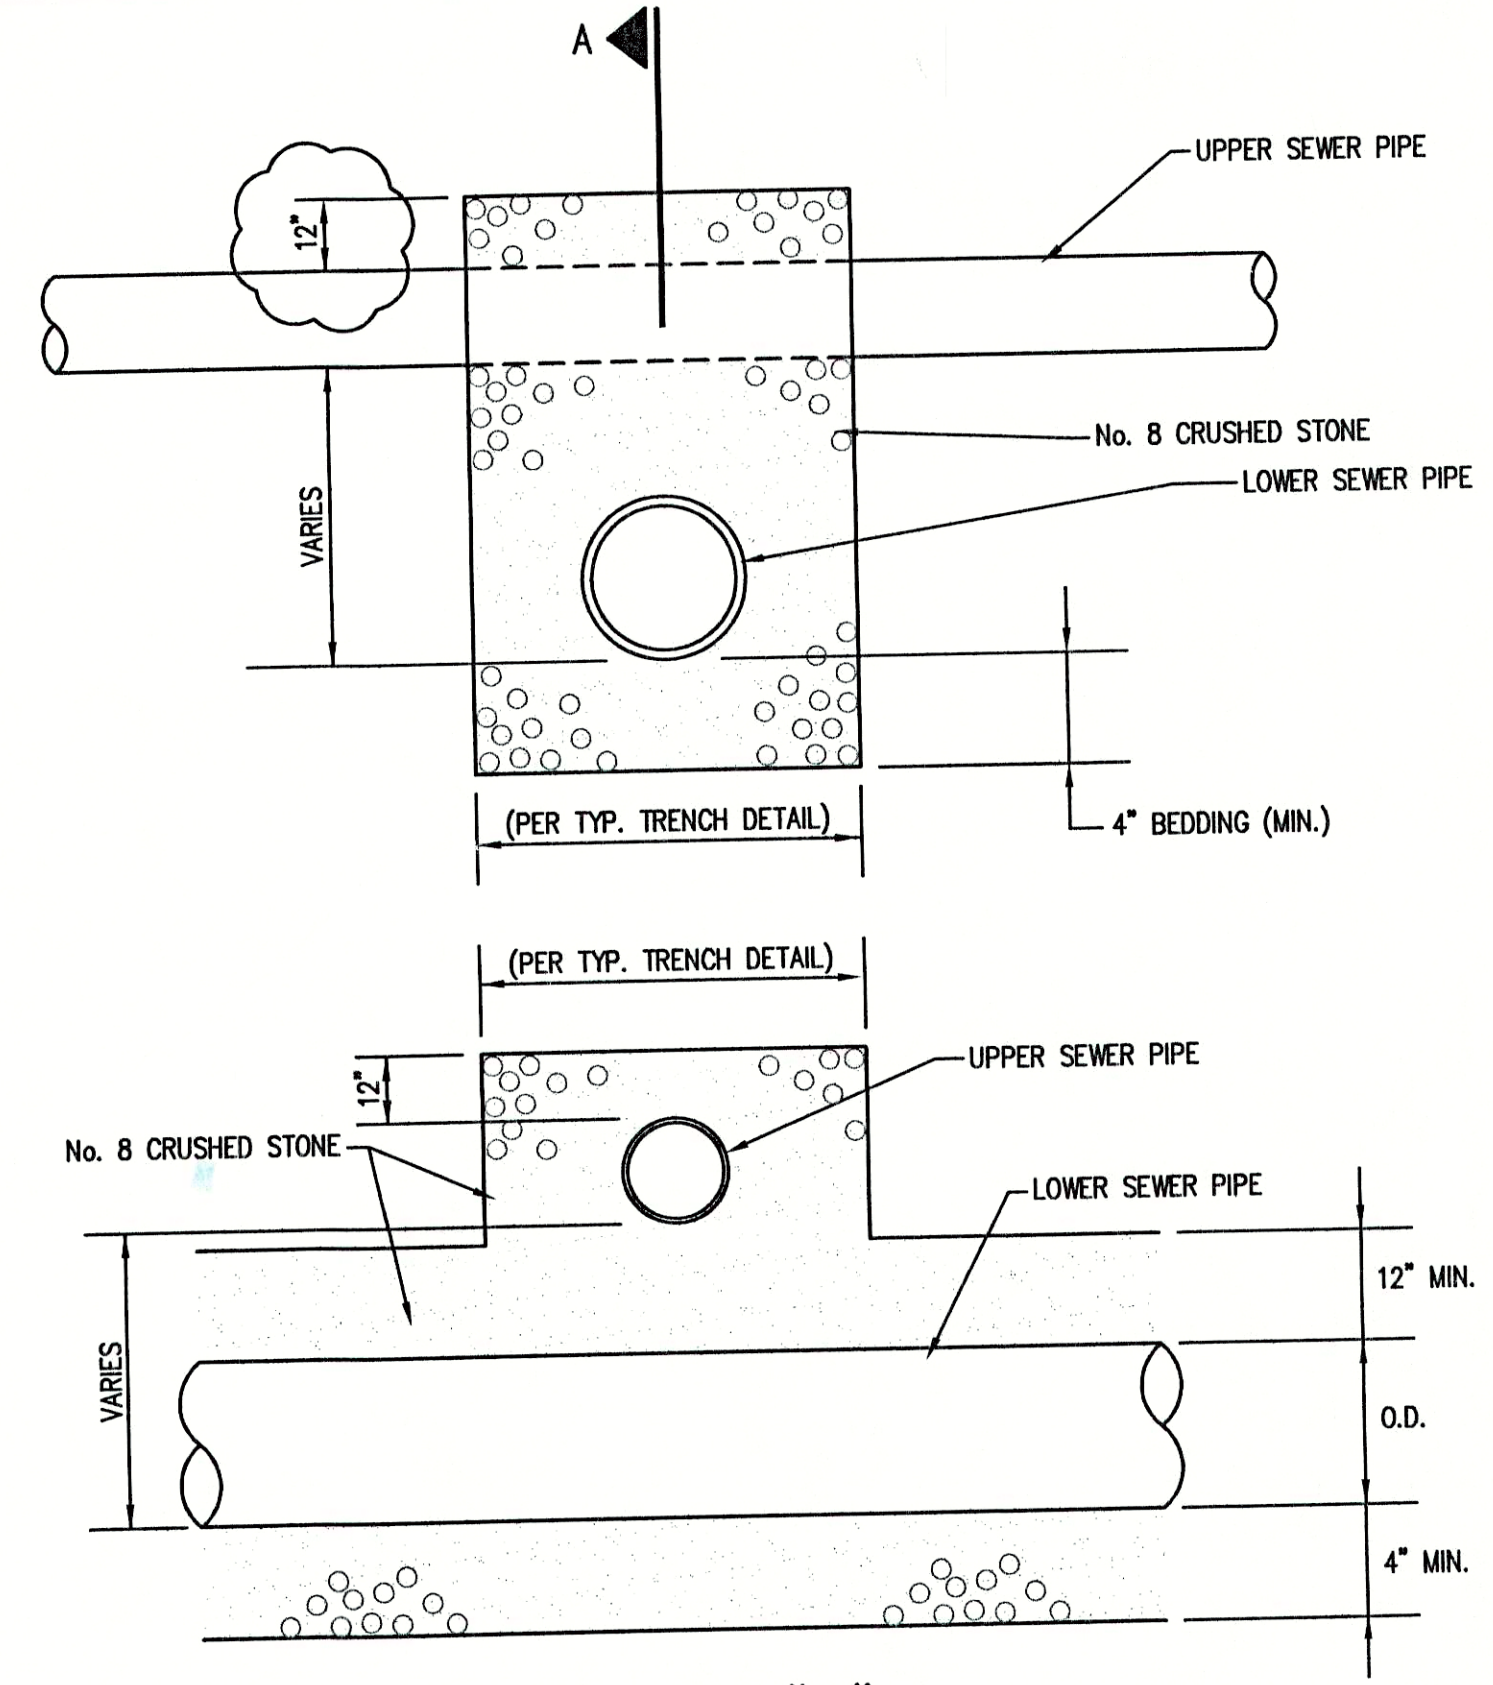

10 STORM SEWER/SANITARY SEWER CROSSING DETAIL
SCALE: N.T.S.

RECORD DRAWING
APRIL 2001

FILE NAME:	FRVL-D1-REC	PLOT SCALE:	1=1	PLOT DATE:	04/02
NO.	DATE	DESCRIPTION	BY		

TRIAD ASSOCIATES INC.
INDIANAPOLIS, INDIANA

APPROVED BY
THOMAS M. SCHUBERT
No. 15614
STATE OF INDIANA
PROFESSIONAL ENGINEER
Thomas M. Schubert, P.E.

FREEDS VILLAGE SUBDIVISION
FALL CREEK REGIONAL WASTE DISTRICT
STANDARD SANITARY SEWER DETAILS
DRAWN BY: DATE 04/12/98 PROJECT No. 98008A SHEET No. 19
SCALE AS NOTED
DESIGNED BY: D.A. Pauling
CHECKED BY: James W. Frazell, P.E.
Of 20