


FILE NAME: FRVIL_D2-REC PLOT SCALE: 1=1 PLOT DATE: 04/02 TRAD ASSOCIATES INC. INDIANAPOLIS, INDIANA DESCRIPTION

NO. DATE

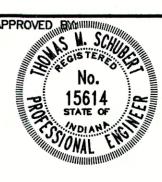

Thomas M. Schubert,

APRIL 2001 FREEDS VILLAGE SUBDIVISION FALL CREEK REGIONAL WASTE DISTRICT CTANDADD CANITADY CEWED DETAILS

	STANDARD SANITARY SEWER DETAILS				
	DRAWN BY:	DATE	04/12/98	PROJECT No.	SHEET No
	DAP	SCALE	AS NOTED	98008A	20
	DESIGNED BY:	D.A. Pauling			1/
P.E.	CHECKED BY:	James W. Frazell, P.E.			OF