


HICKORY HILLS SUBDIVISION FALL CREEK REGIONAL WASTE DISTRICT MADISON COUNTY, INDIANA SANITARY SEWER IMPROVEMENTS 1995


SHEET INDEX

SHEET NO.	DESCRIPTION
1	TITLE SHEET
2	PROPOSED BASE MAP
3	SANITARY SEWER PLAN & PROFILE — LINE 'B'
4	SANITARY SEWER PLAN & PROFILE — LINE 'B'
5	SANITARY SEWER PLAN & PROFILE — LINE 'E'
6	SANITARY SEWER PLAN & PROFILE — LINE 'D'
7	SANITARY SEWER PLAN & PROFILE — LINE 'C'
8	SANITARY SEWER PLAN & PROFILE — LINE 'F'
9	SANITARY SEWER PLAN & PROFILE — LINE 'F' & 'G'
10	SANITARY SEWER PLAN & PROFILE — LINE 'G'
11	SANITARY SEWER PLAN & PROFILE — LINE 'G'
12	SANITARY SEWER PLAN & PROFILE — LINE 'H'
13	STANDARD SANITARY SEWER DETAILS

AREA MAP

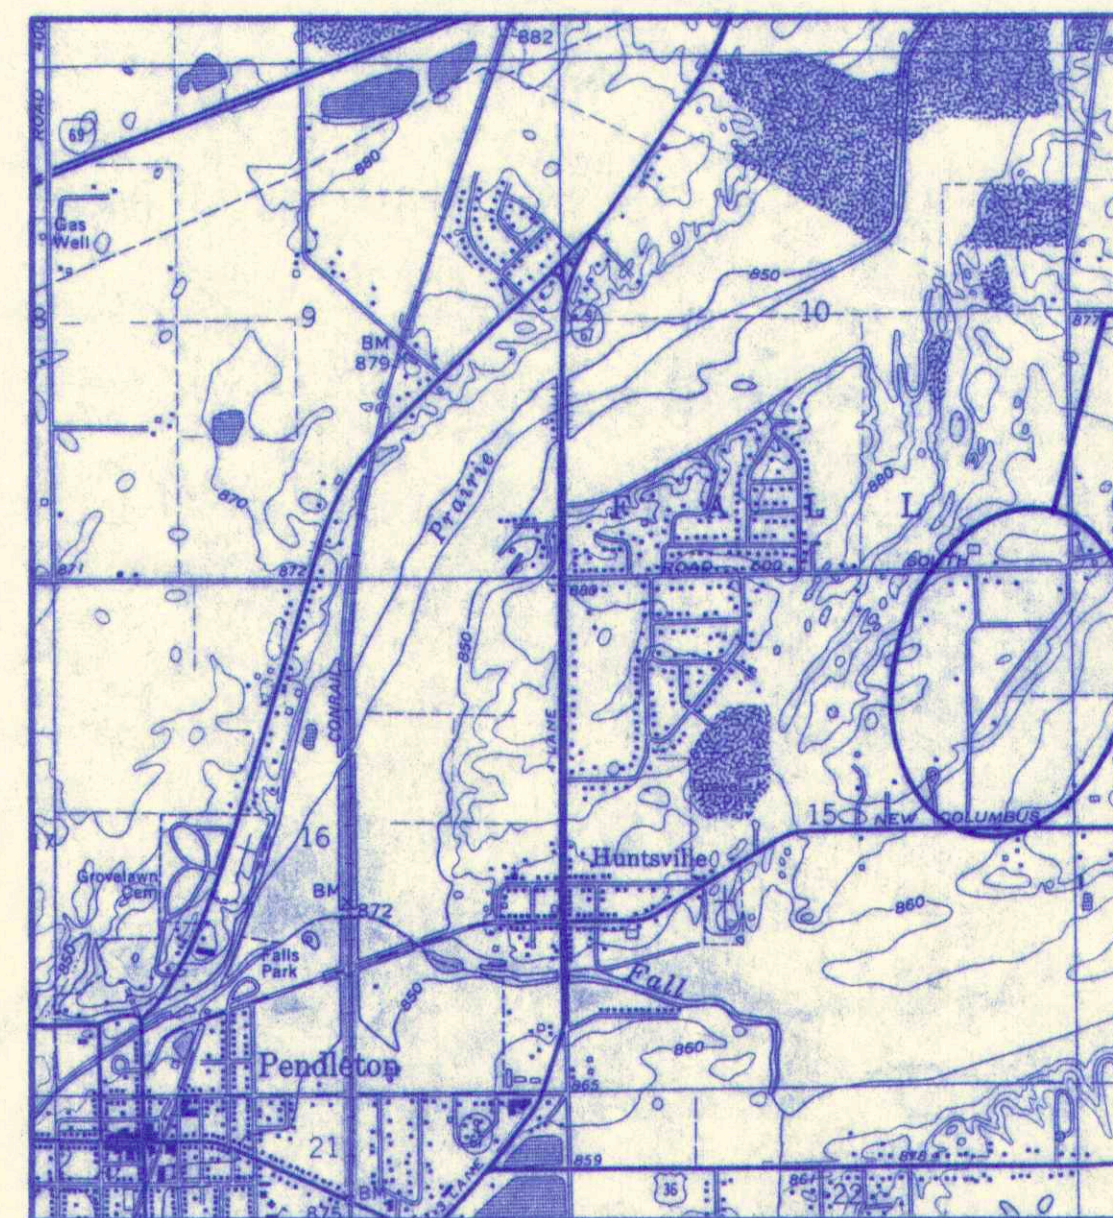


AREA LOCATION

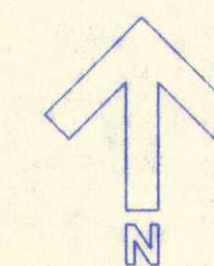

PROJECT LOCATION

LOCATION MAP

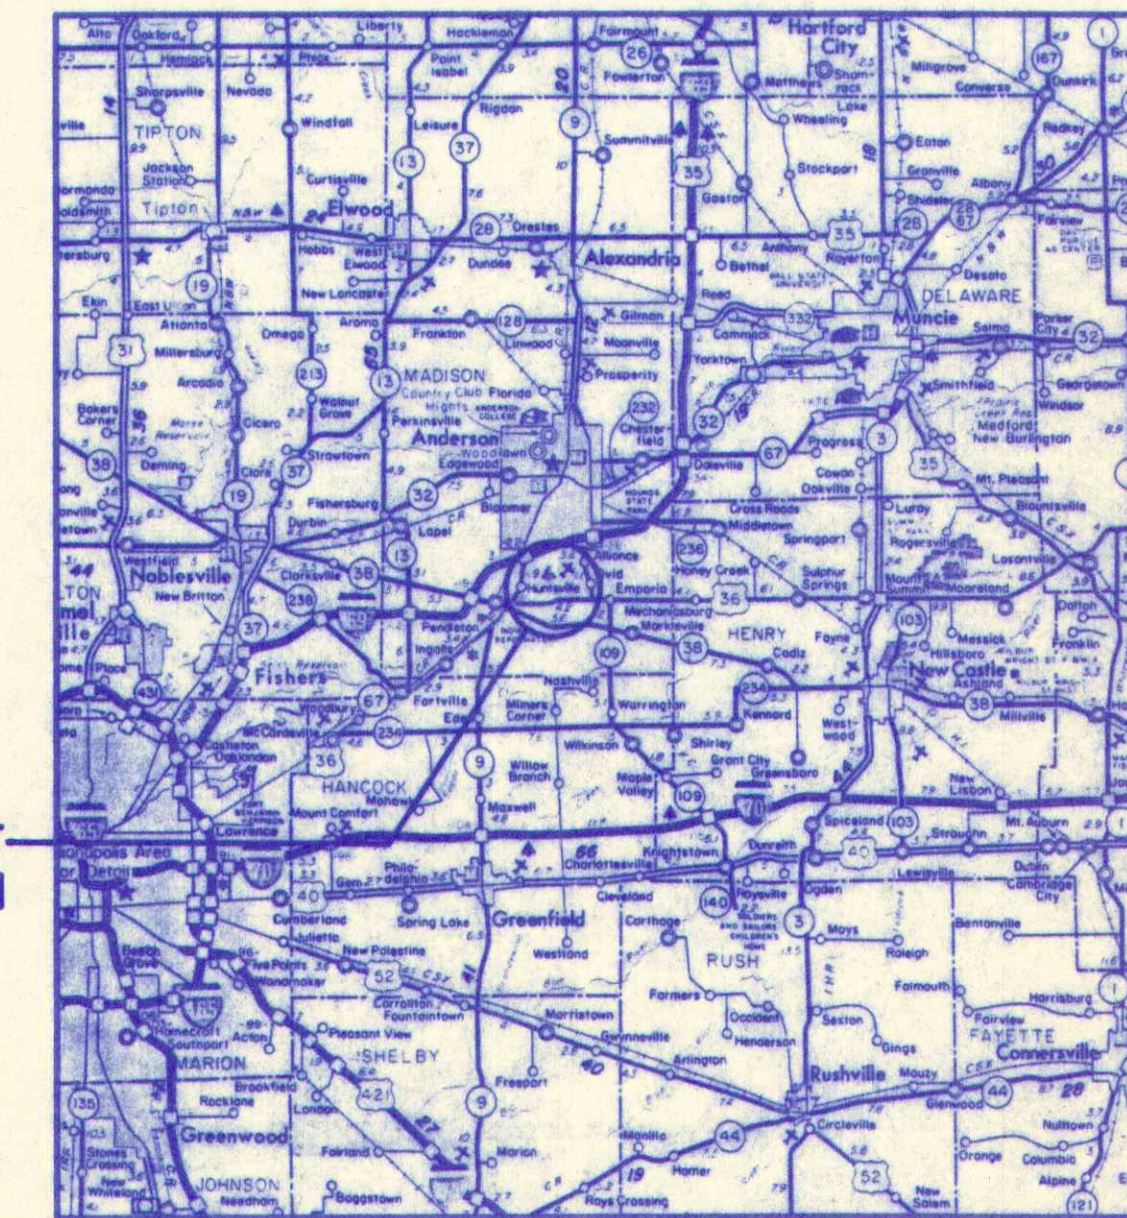

FALL CREEK REGIONAL WASTE DISTRICT BOARD

Bill Clark — President
Morris McCurdy — Member
Charles Hennis — Member
Mark Jablonski — Member
Agon Tolbert — Member
Marvin Kelly — Member
Stephen Poor — Member
Marion Morris — Member
John Ellingwood — Member
Joe Rowlett — General Manager

AS-BUILT
09/18/95

THESE PLANS CERTIFIED BY:

James W. Frazell, Professional Engineer



Thomas M. Schubert, Professional Engineer



PLANS PREPARED BY:

TRIAD
ASSOCIATES
INC.
INDIANAPOLIS, INDIANA

