


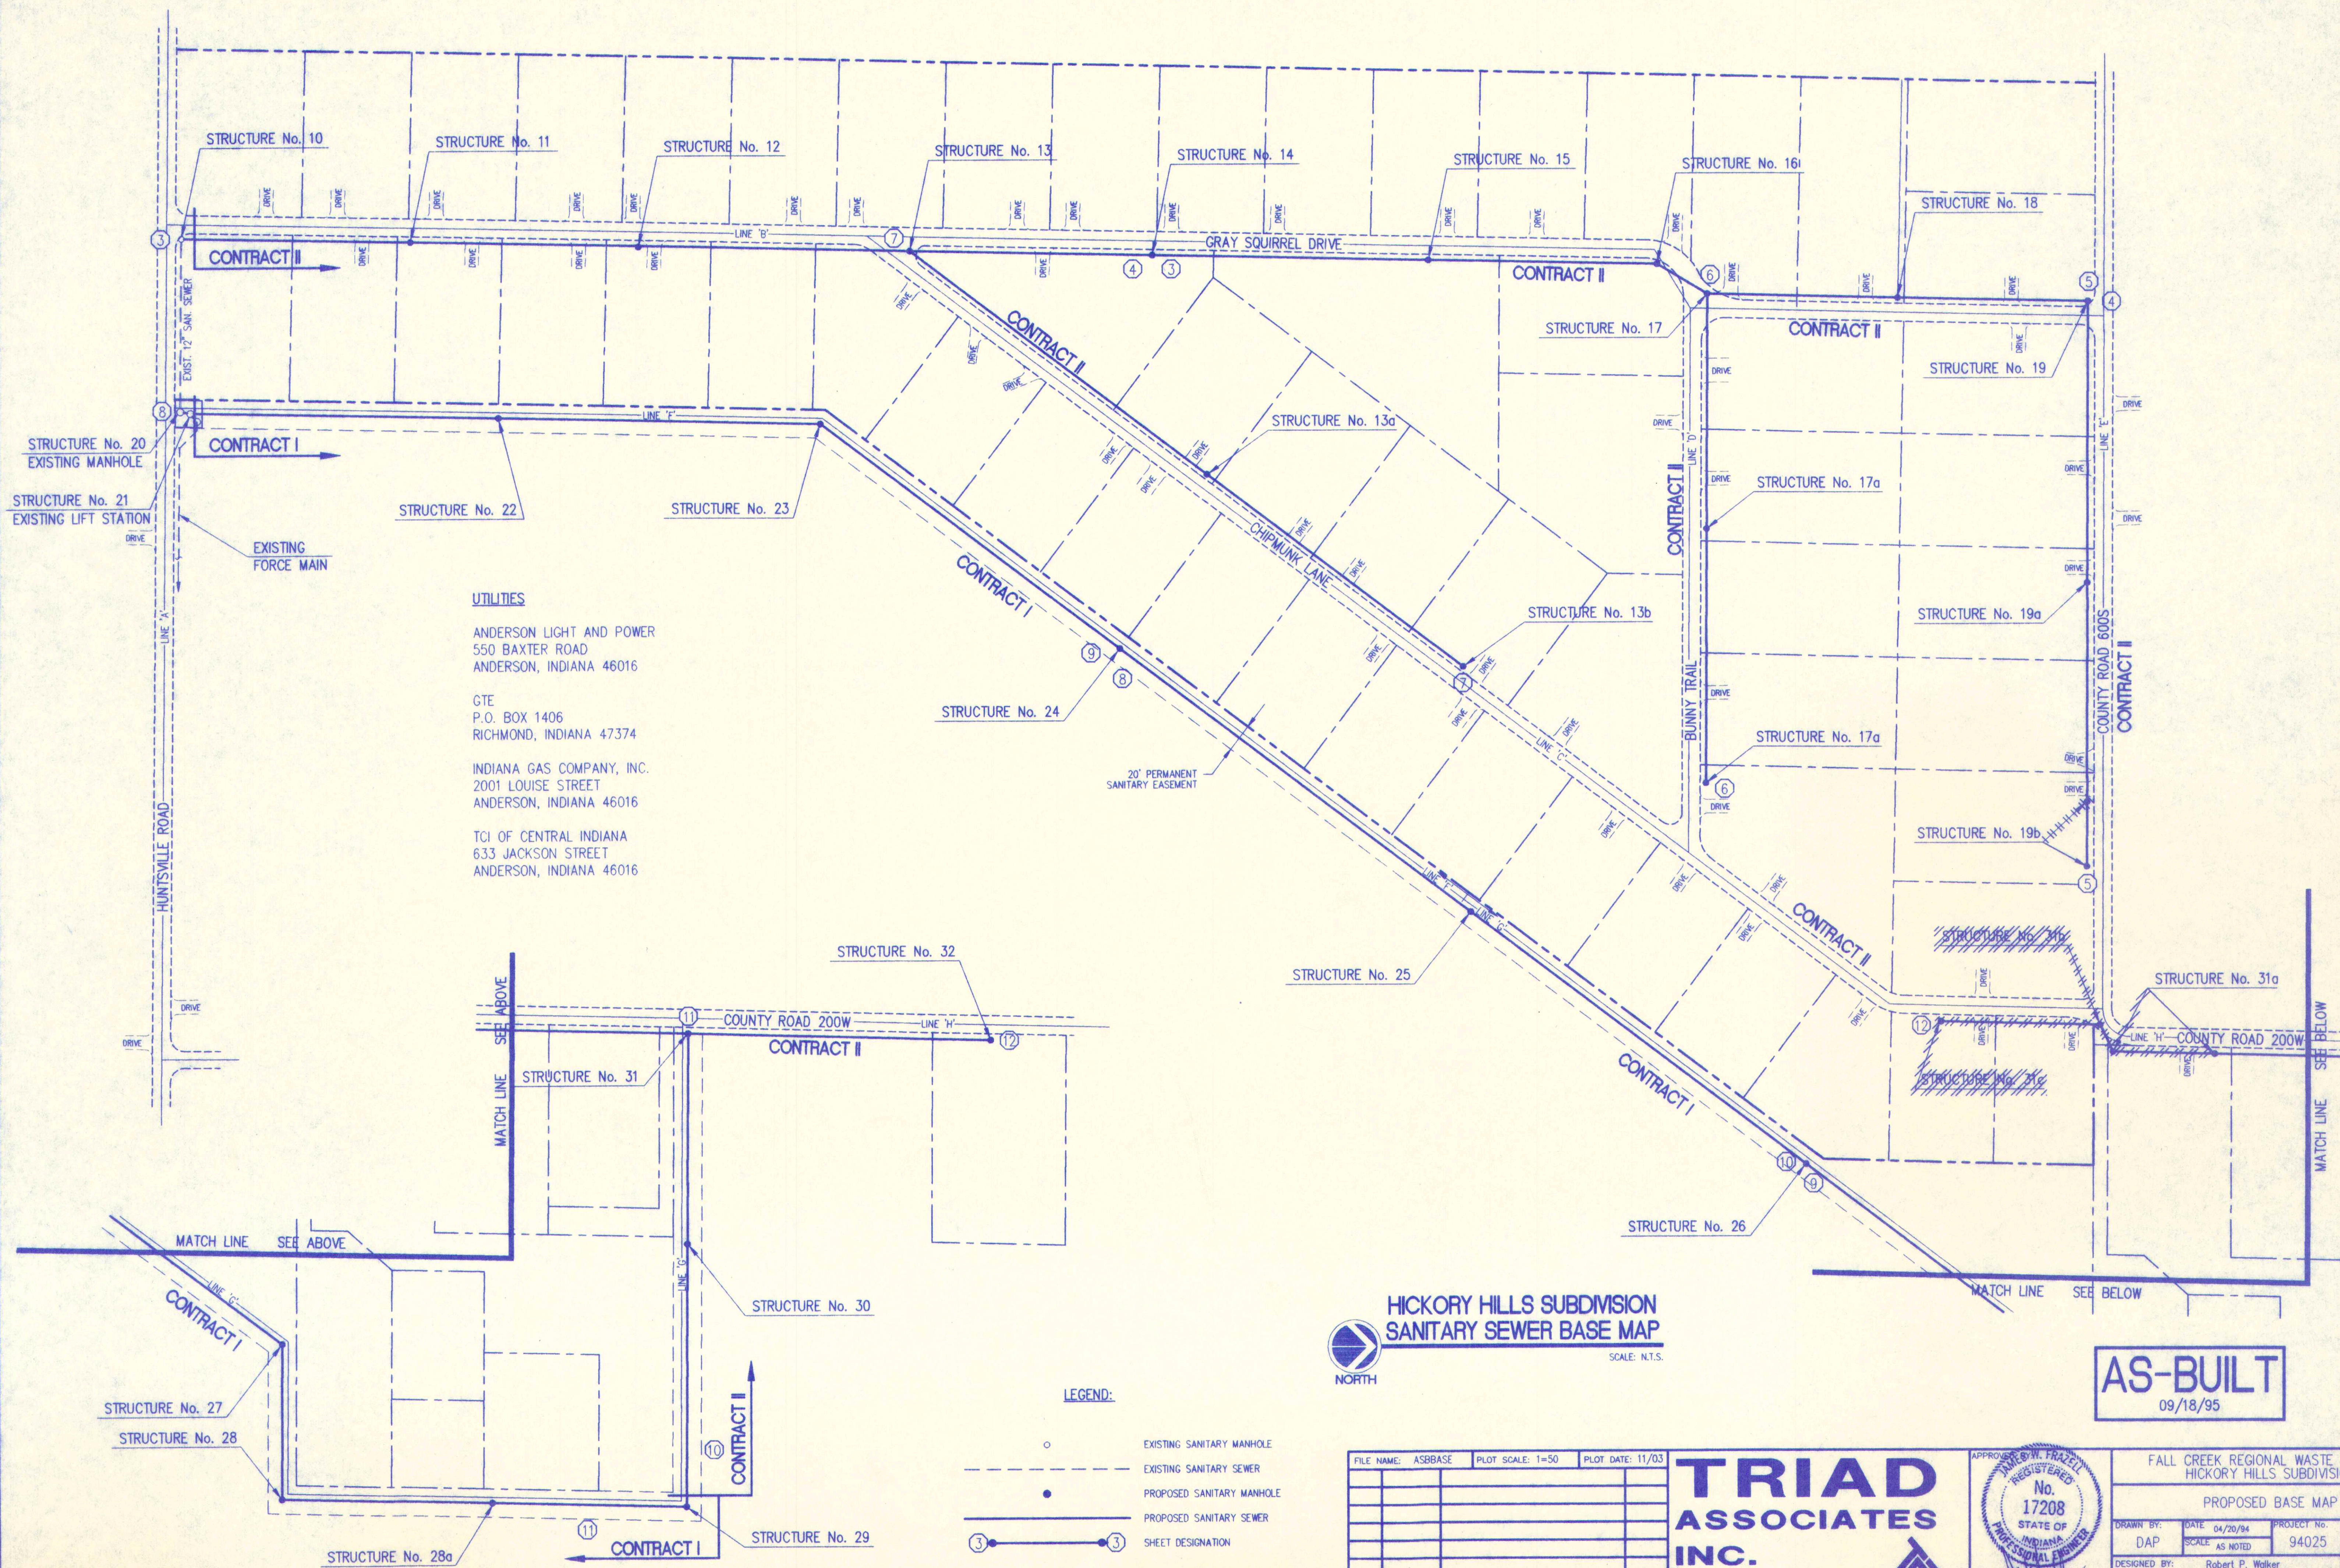

UTILITIES

ANDERSON LIGHT AND POWER
550 BAXTER ROAD
ANDERSON, INDIANA 46016

GTE
P.O. BOX 1406
RICHMOND, INDIANA 47374

INDIANA GAS COMPANY, INC.
2001 LOUISE STREET
ANDERSON, INDIANA 46016

TCI OF CENTRAL INDIANA
633 JACKSON STREET
ANDERSON, INDIANA 46016



**HICKORY HILLS SUBDIVISION
SANITARY SEWER BASE MAP**

SCALE: N.T.S.

LEGEND:

- EXISTING SANITARY MANHOLE
- EXISTING SANITARY SEWER
- PROPOSED SANITARY MANHOLE
- PROPOSED SANITARY SEWER
- ③—③ SHEET DESIGNATION

FILE NAME:	ASBBASE	PLOT SCALE:	1"=50'	PLOT DATE:	11/03
NO.	DATE	DESCRIPTION	BY		

TRIAD ASSOCIATES INC.
INDIANAPOLIS, INDIANA



AS-BUILT
09/18/95

FALL CREEK REGIONAL WASTE DISTRICT HICKORY HILLS SUBDIVISION			
PROPOSED BASE MAP			
DRAWN BY:	DATE: 04/20/94	PROJECT No.:	SHEET No.:
DAP	SCALE: AS NOTED	94025	2
DESIGNED BY:	Robert P. Walker		
CHECKED BY:	James W. Frazell, P.E.		