


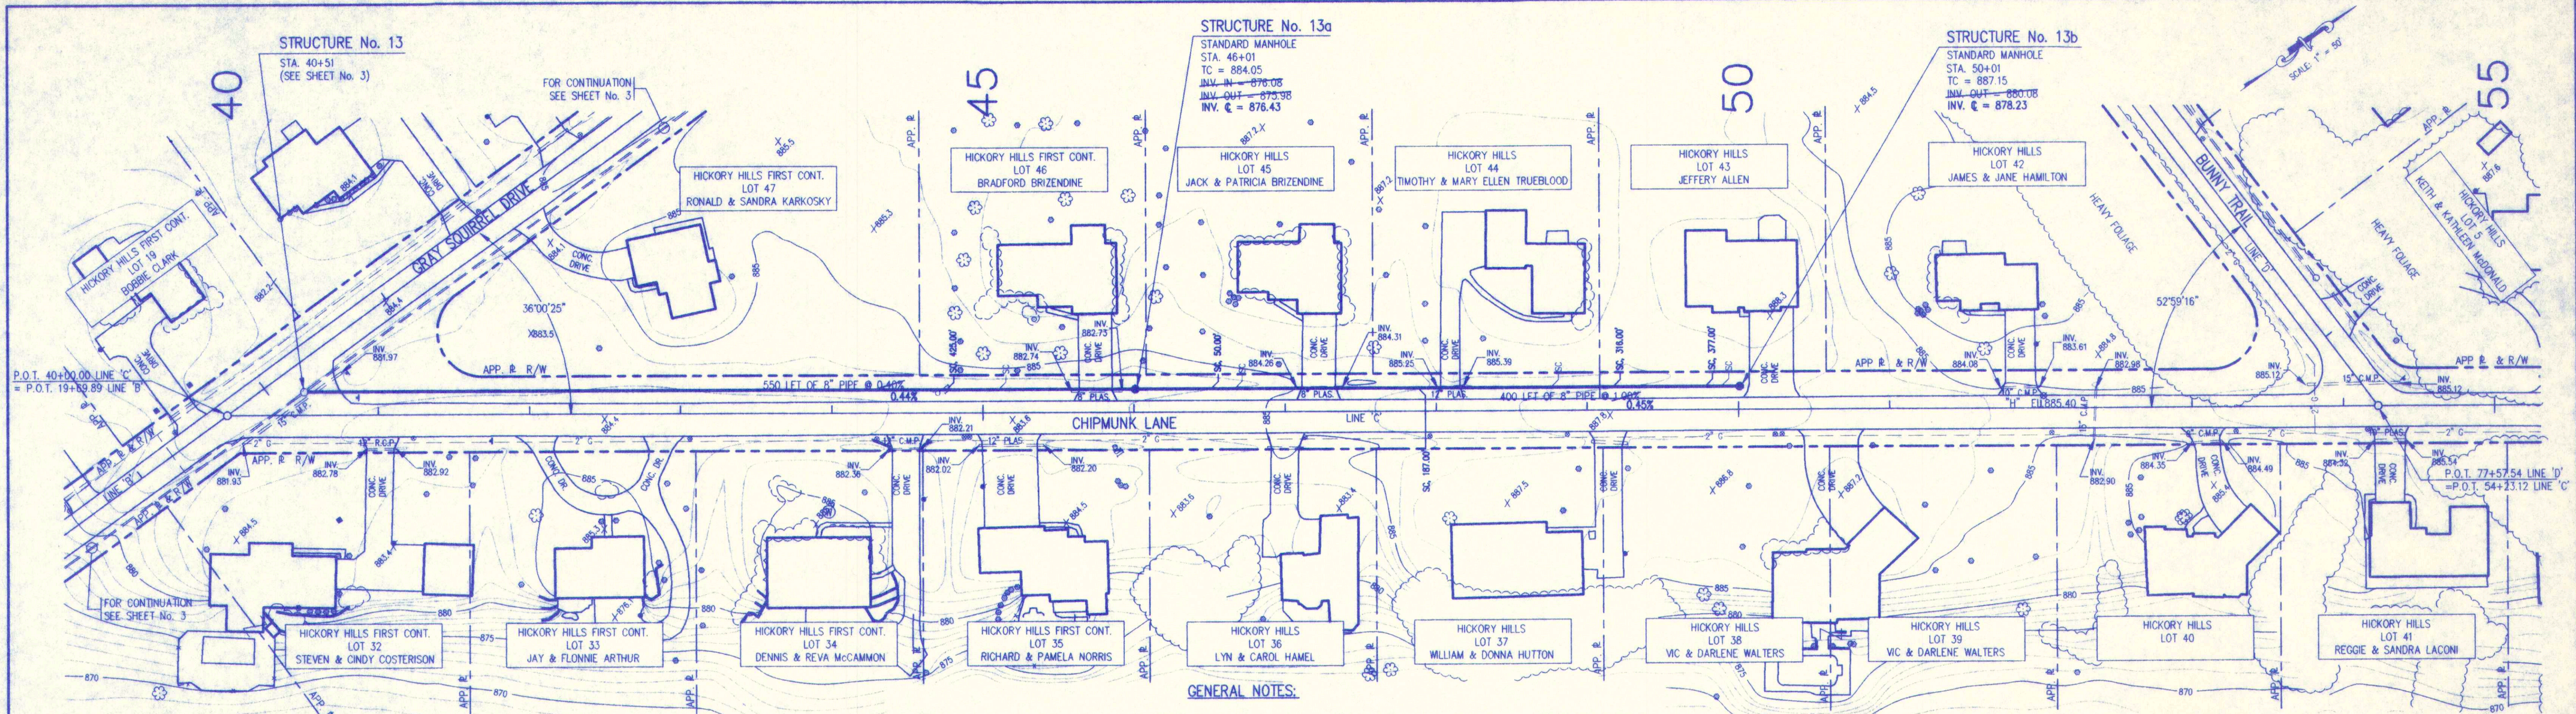


- LEGEND:**
- EXISTING DRAINAGE CULVERT
 - EXISTING TREE OR SHRUB
 - PROPOSED SANITARY MANHOLE
 - PROPOSED SANITARY SEWER
 - EXISTING SIGN
 - EXISTING MAILBOX
 - RIGHT OF WAY
 - PROPERTY LINE
 - AS-DESIGNED LATERAL LOCATION
 - AS-BUILT LATERAL LOCATION (CONTRACT II SEWER LATERALS ARE 4 TO 5 FEET DEEP AT R/W LINE)
 - WATER LINE
 - GAS LINE
 - EXISTING UTILITY POLE W/GUY
 - EXISTING UTILITY POLE
 - WATER WELL
 - EXISTING FENCE LINE
 - EXISTING ELECTRIC TRANSFORMER
- NOTE:**
ALL AS-BUILT SEWER LATERALS ARE MEASURED FROM DOWN STREAM MANHOLE

AS-BUILT
09/18/95

SCALE:
HORIZONTAL: 1" = 50'
VERTICAL: 1" = 5'

TBM #2 = RR SPIKE @ STA. 19+69.89 LINE 'B' EL. 864.03
TBM #6 = RR SPIKE @ STA. 54+23.12 LINE 'C' EL. 887.29

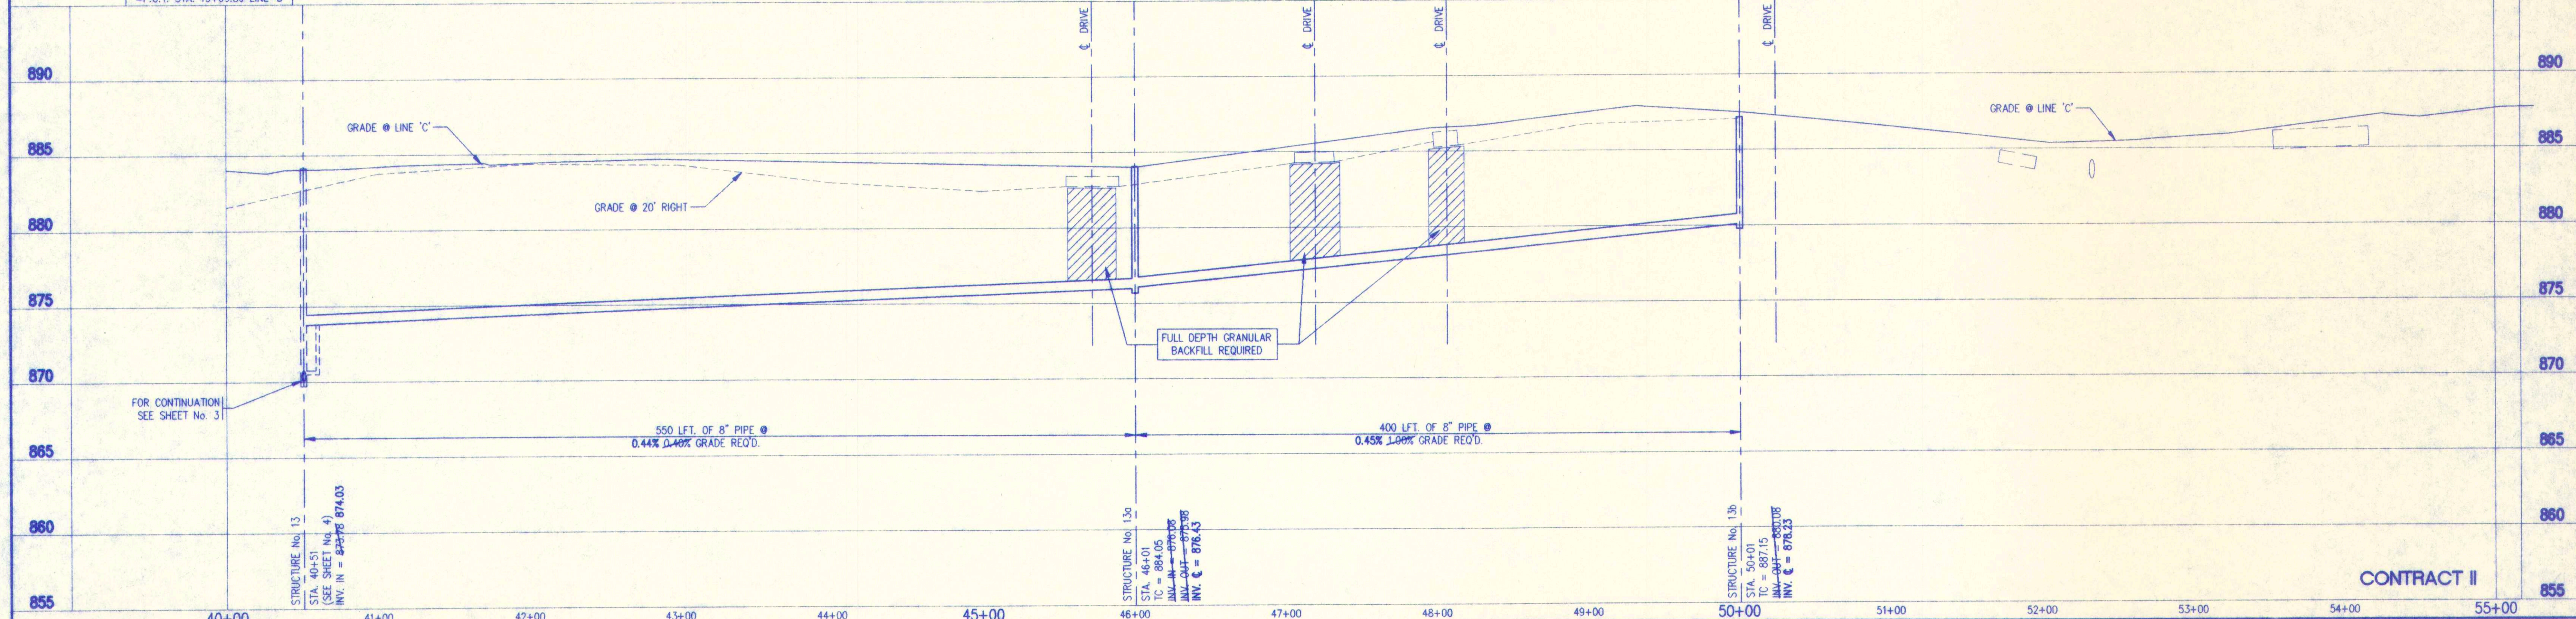

SURVEY LINE 'C'

NO.	DATE	DESCRIPTION	BY

TRIAD ASSOCIATES INC.
INDIANAPOLIS, INDIANA

APPROVED:
JAMES W. FRAZELL
REGISTERED
No. 17208
STATE OF INDIANA
Professional Engineer

FALL CREEK REGIONAL WASTE DISTRICT
HICKORY HILLS SUBDIVISION
PROPOSED SANITARY SEWER PLAN

DESIGNED BY: Robert P. Walker
CHECKED BY: James W. Frazell, P.E.

DATE: 04/20/94
SCALE: AS NOTED
PROJECT No.: 94025
SHEET No.: 7 OF 13