


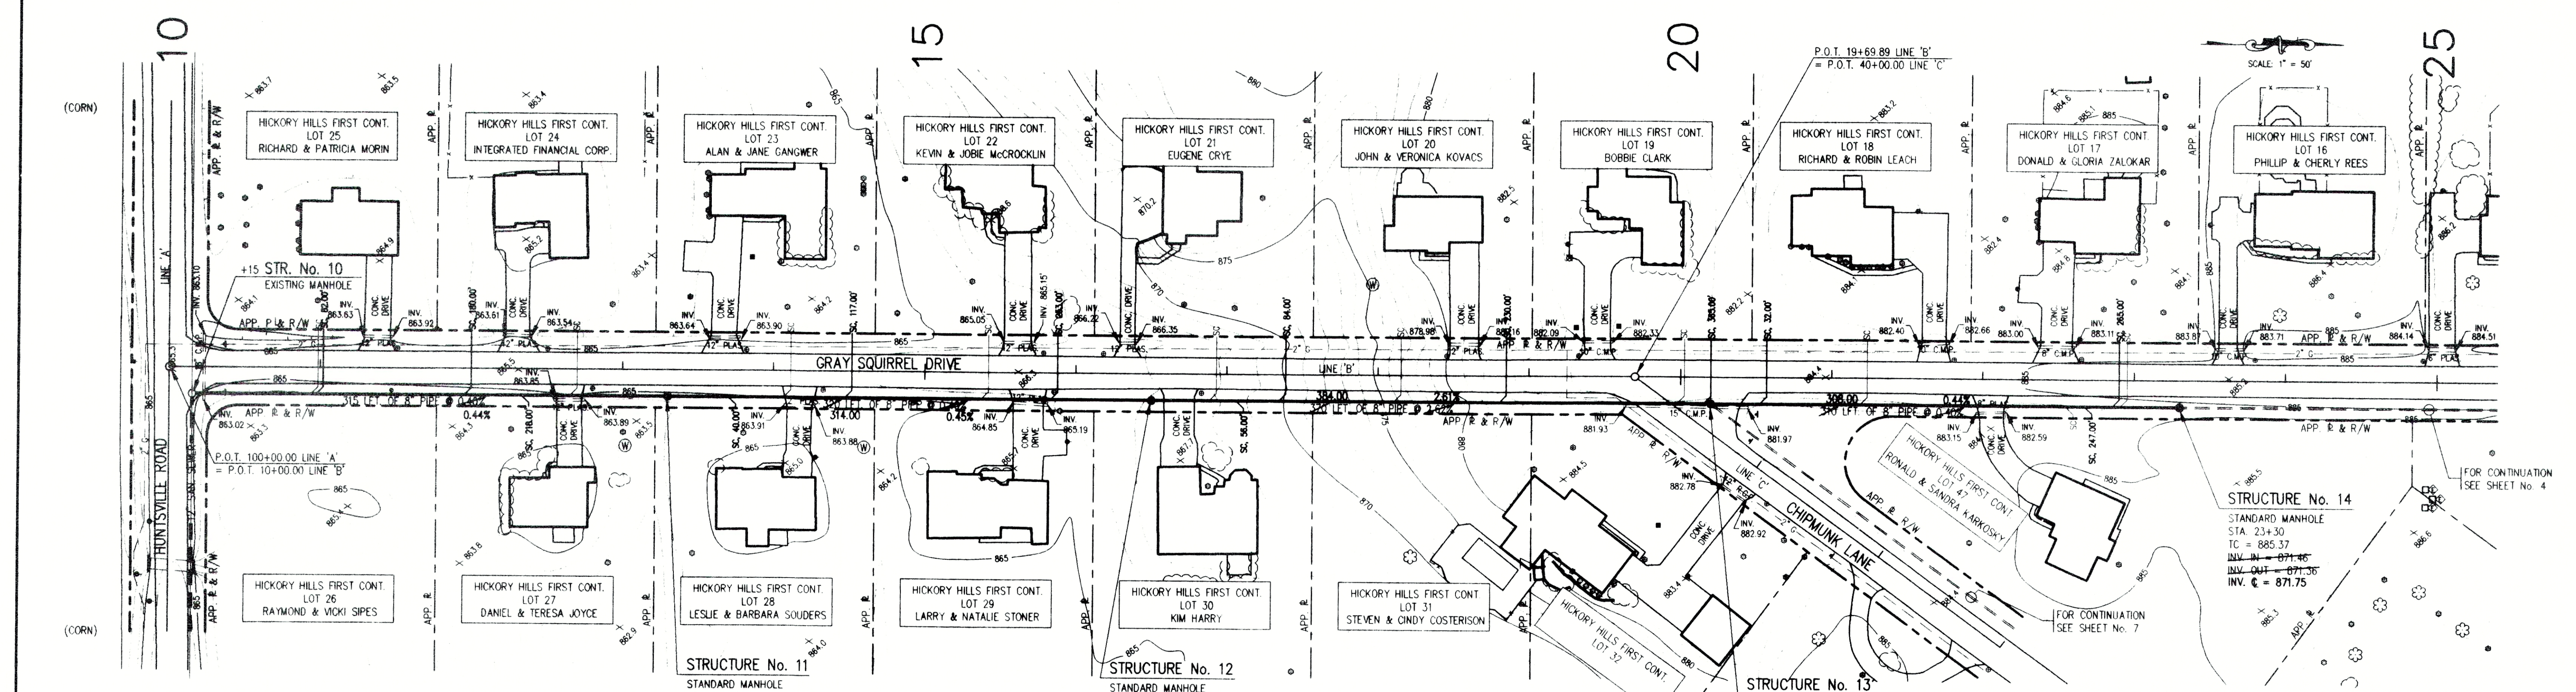

- GENERAL NOTES:**
- CONTRACTOR SHALL FIELD VERIFY ALL UTILITY LOCATIONS PRIOR TO CONSTRUCTION.
 - CONTRACTOR SHALL VISIT THE SITE PRIOR TO PLACING BID TO BECOME FAMILIAR WITH EXISTING CONDITIONS.
 - CONTRACTOR SHALL RESTORE ALL DISTURBED AREAS TO AT LEAST PRE-CONSTRUCTION CONDITIONS.
 - ALL PROPOSED MANHOLE CASTING ELEVATIONS SHOWN ARE APPROXIMATE AND FOR INFORMATION ONLY. THE CONTRACTOR IS RESPONSIBLE FOR CONSTRUCTING CASTINGS FLUSH WITH FINISH GRADE OR STREET GRADE. CASTINGS LOCATED IN DRAINAGE DITCHES SHALL BE SET HIGHER THAN INVERT OF DRAINAGE DITCH.
 - CONTRACTOR SHALL MAINTAIN A SEPARATION BETWEEN EXISTING WATER LINES AND SEWERS OF 18" VERTICALLY AND 10'-0" HORIZONTALLY. PRESSURE RATED SEWER PIPE AS SPECIFIED SHALL BE USED WHEN THIS SEPARATION CAN'T BE MAINTAINED.
 - FULL DEPTH COMPACTED GRANULAR FILL SHALL BE USED UNDER ALL PAVEMENT (I.E. DRIVES, WALKS, STREETS, ETC.) OR WHEN SEWER TRENCH IS WITHIN 3 FEET OF PAVEMENT. ALL PAVEMENT CROSSINGS REQUIRE SAW CUTTING.
 - CONTRACTOR SHALL PROVIDE EACH HOUSE OR BUSINESS IN THE SERVICE AREA WITH A 6-INCH PVC SDR-35, SERVICE CONNECTION TO THE RIGHT-OF-WAY LINE. THE CONTRACTOR SHALL COORDINATE THE SERVICE LOCATION WITH THE PROPERTY OWNER.
 - CONTRACTOR SHALL GRADE ALL DISTURBED AREAS TO ALLOW PROPER DRAINAGE.
 - CONTRACTOR SHALL PROTECT AND REINSTALL ALL DISTURBED MAILBOXES.


LEGEND:

- EXISTING DRAINAGE CULVERT
- EXISTING TREE OR SHRUB
- PROPOSED SANITARY MANHOLE
- PROPOSED SANITARY SEWER
- EXISTING SIGN
- EXISTING MAILBOX
- RIGHT OF WAY
- PROPERTY LINE
- AS-DESIGNED LATERAL LOCATION
- AS-BUILT LATERAL LOCATION (CONTRACT II SEWER LATERALS ARE 4 TO 5 FEET DEEP AT R/W LINE)
- WATER LINE
- GAS LINE
- EXISTING UTILITY POLE W/GUY
- EXISTING UTILITY POLE
- WATER WELL
- EXISTING FENCE LINE
- EXISTING ELECTRIC TRANSFORMER

SCALE:
HORIZONTAL: 1" = 50'
VERTICAL: 1" = 5'

AS-BUILT
09/18/95

TBM #1 = PK NAIL @ STA. 10+00.00 LINE 'B' EL. 865.44
TBM #2 = RR SPIKE @ STA. 19+69.89 LINE 'B' EL. 884.03

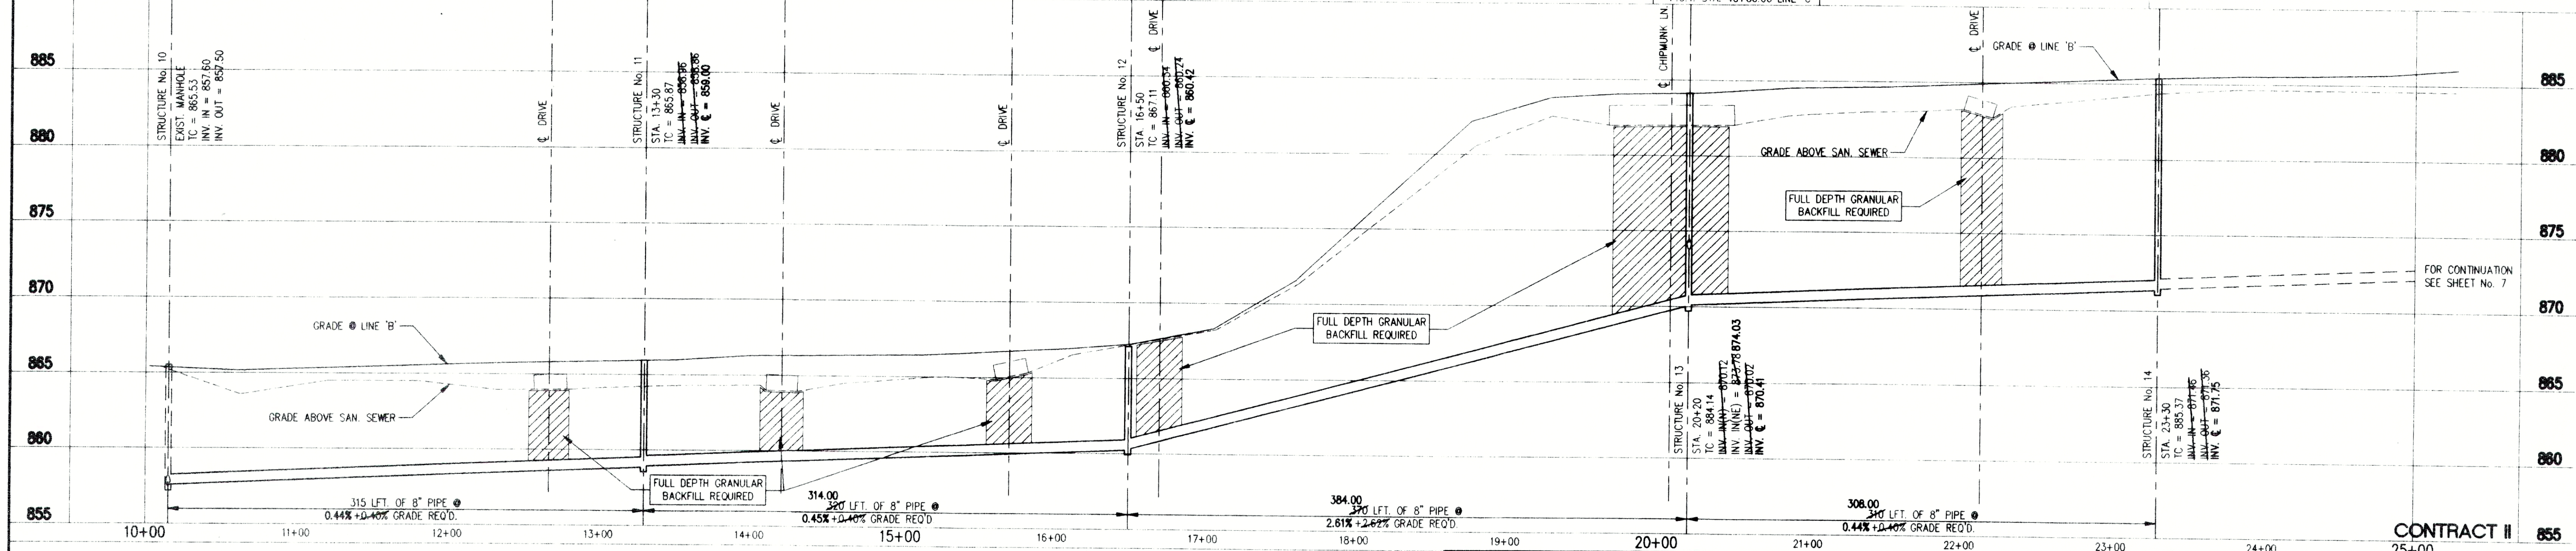

SURVEY LINE 'B'

FILE NAME: 94025AB3	PLOT SCALE: 1=50	PLOT DATE: 11/03
TRIAD ASSOCIATES INC. INDIANAPOLIS, INDIANA		
APPROVED: JAMES W. FRAZELL, REGISTERED PROFESSIONAL ENGINEER, No. 17208, STATE OF INDIANA		
FALL CREEK REGIONAL WASTE DISTRICT HICKORY HILLS SUBDIVISION PROPOSED SANITARY SEWER PLAN		
DRAWN BY: DAP/GSS	DATE: 04/20/94	PROJECT No. 94025
DESIGNED BY: Robert P. Walker	SCALE: AS NOTED	SHEET No. 3
CHECKED BY: James W. Frazell, P.E.		OF 13