



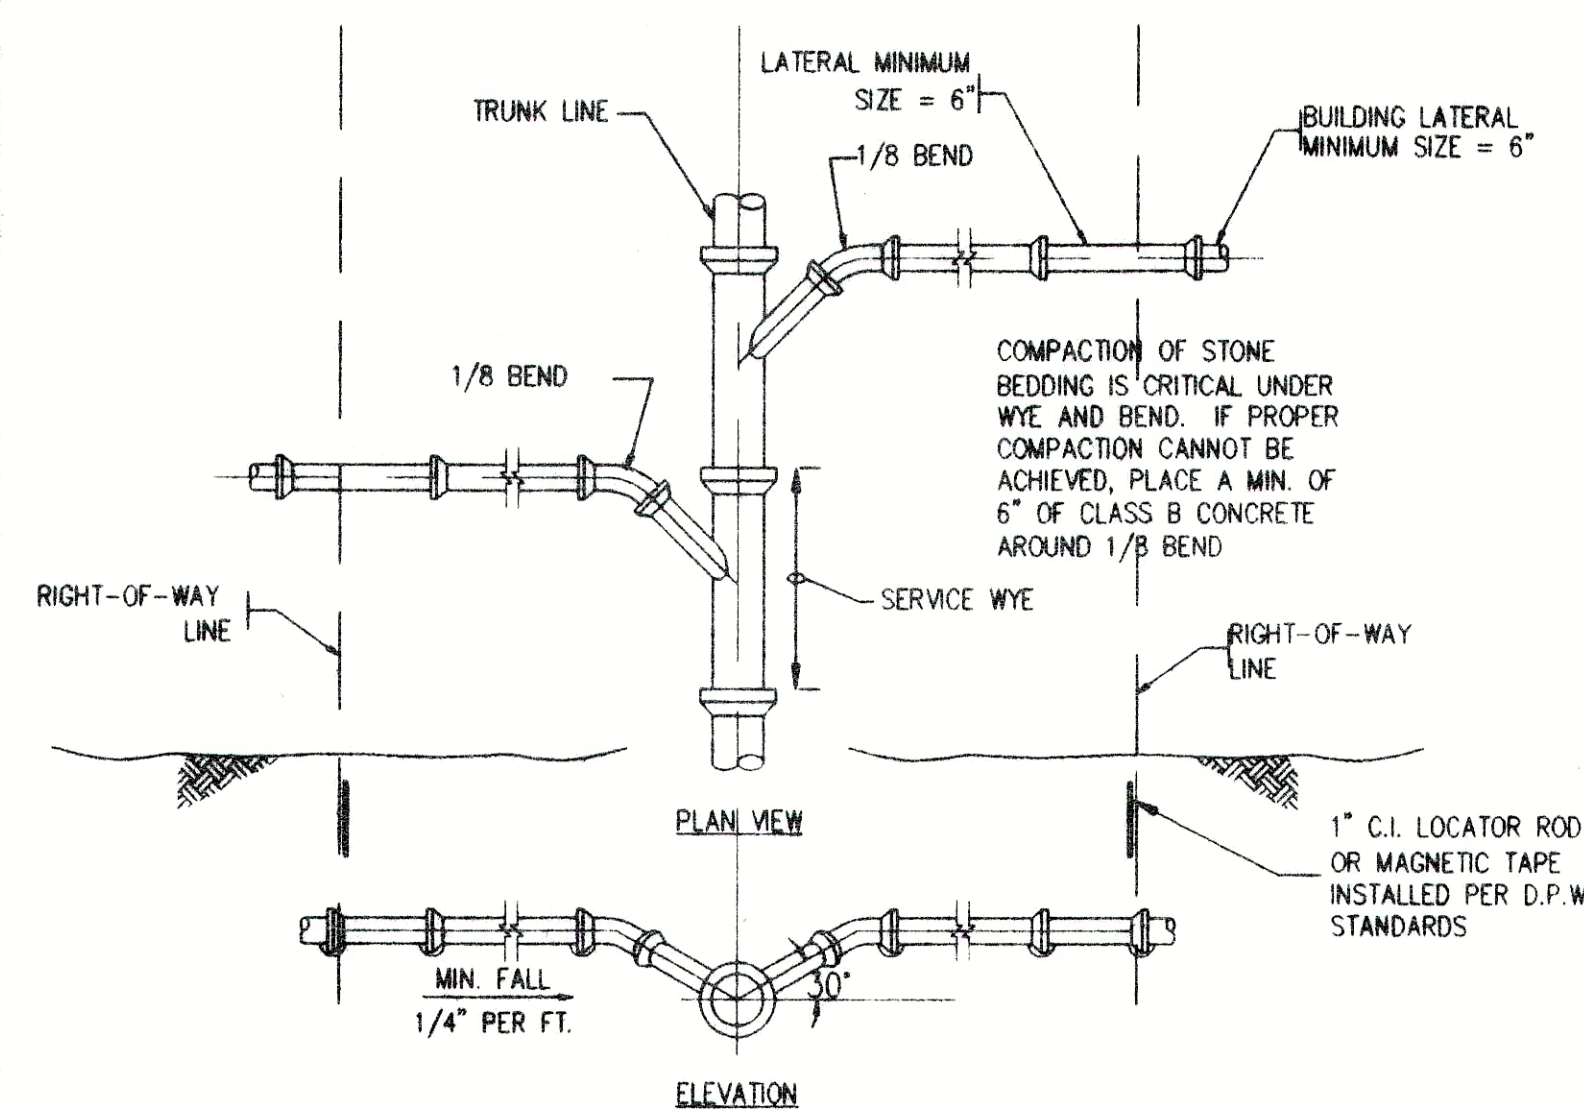


- NOTES:
1. CONTRACTOR TO ADEQUATELY PLUG AND MARK SERVICE LINE WHERE TERMINATED.
 2. ALL SERVICE PIPE TO BE PVC SDR-35.
 3. CONTRACTOR SHALL EXTEND SERVICE LATERALS TO PROPERTY LINE.

1 **SERVICE CONNECTION DETAIL**
SCALE: N.T.S.

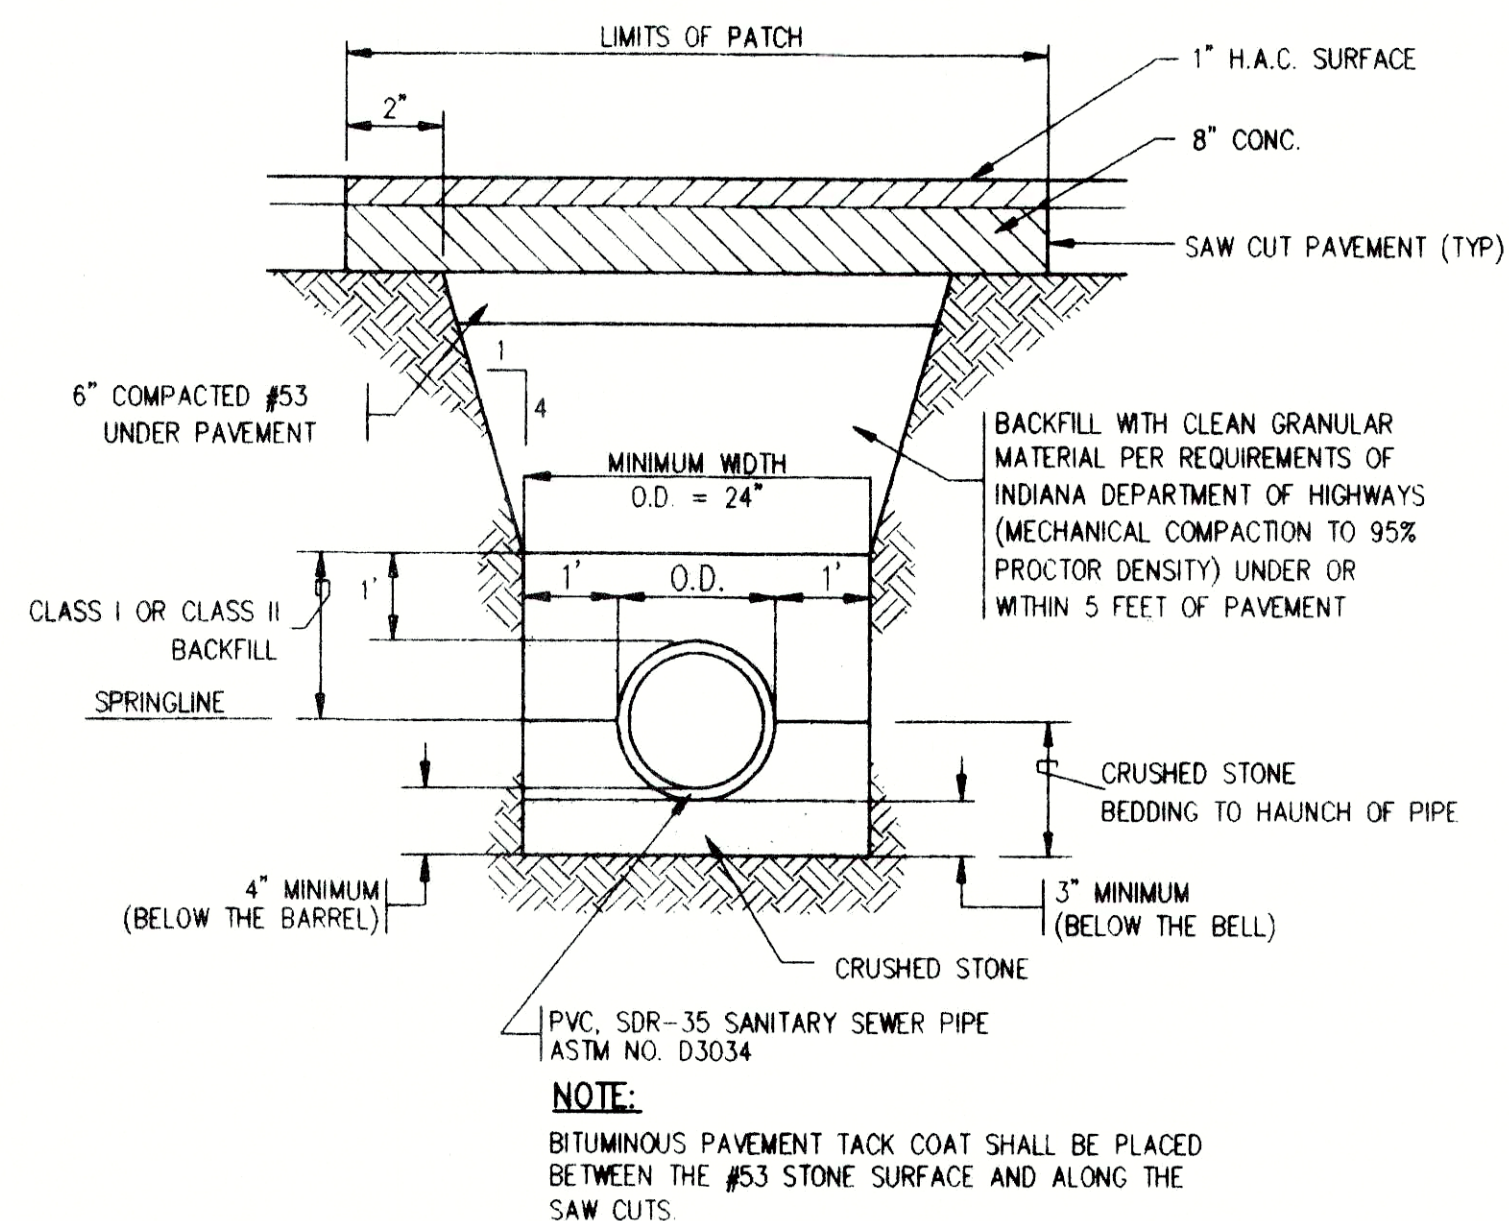


2 **TYPICAL TRENCH AND PAVEMENT PATCH DETAIL**
SCALE: N.T.S.

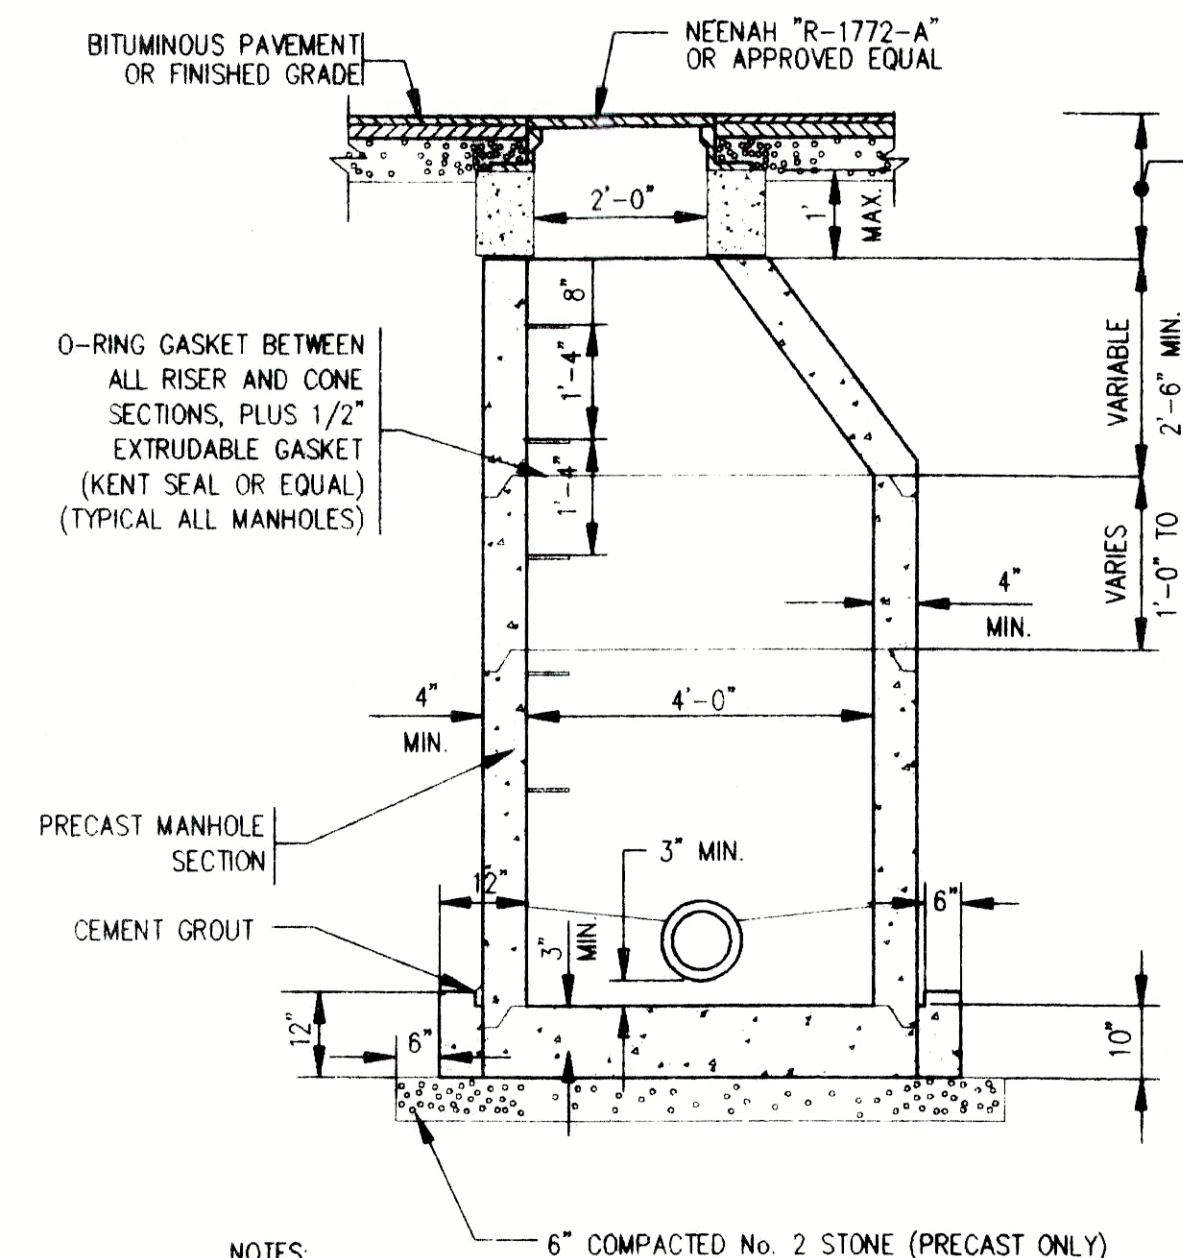


- NOTES:
1. MANHOLE STEPS SHALL BE POLYPROPYLENE, POLYPROPYLENE COATED STEEL REINFORCING OR APPROVED NON-CORROSIVE FIBERGLASS MATERIAL. COPOLYMER POLYPROPYLENE SHALL MEET ASTM D-4101 REINFORCED WITH DEFORMED 3/8\"/>
 - 2. MANHOLE CONFORMS TO ASTM C-478. JOINT CONFORMS TO ASTM C-443.


4 **SANITARY MANHOLE**
SCALE: N.T.S.

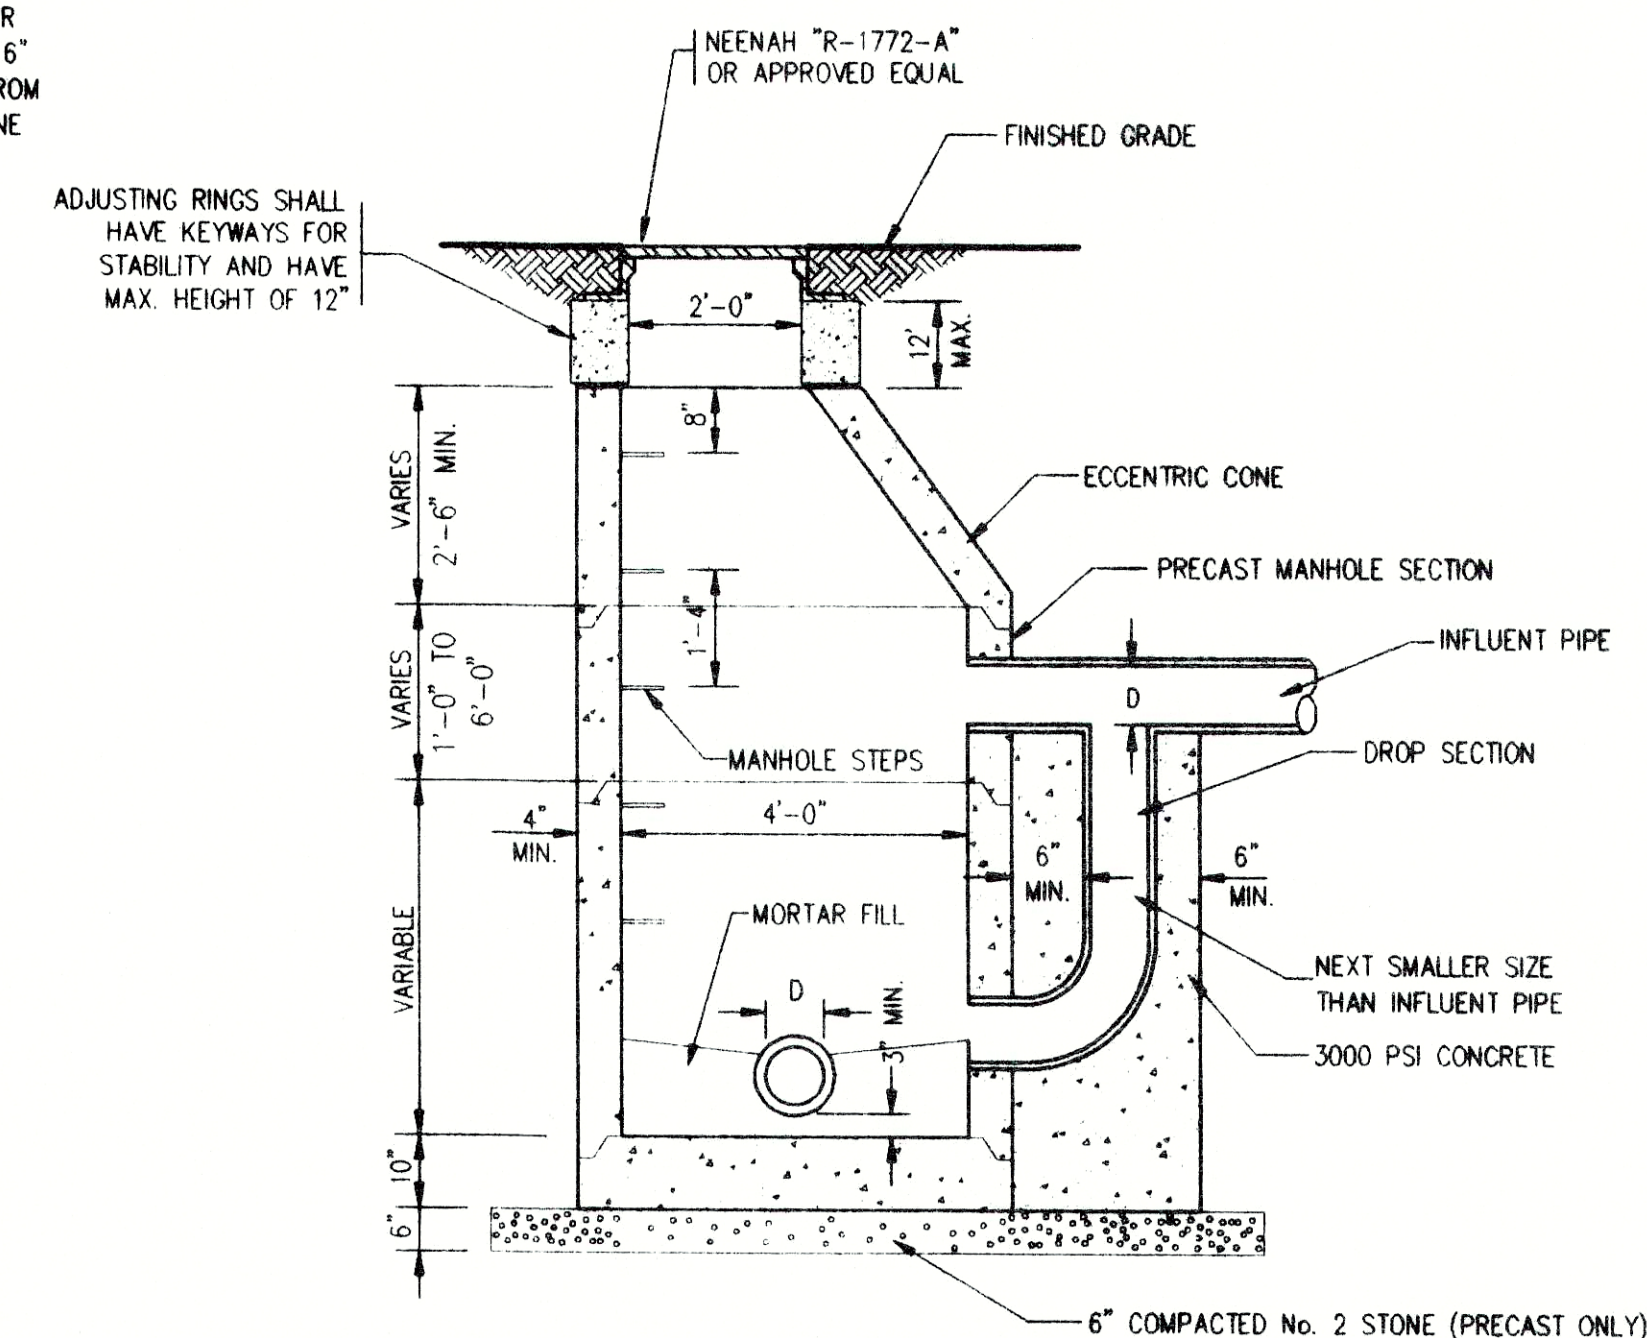


3 **DROP MANHOLE**
SCALE: N.T.S.

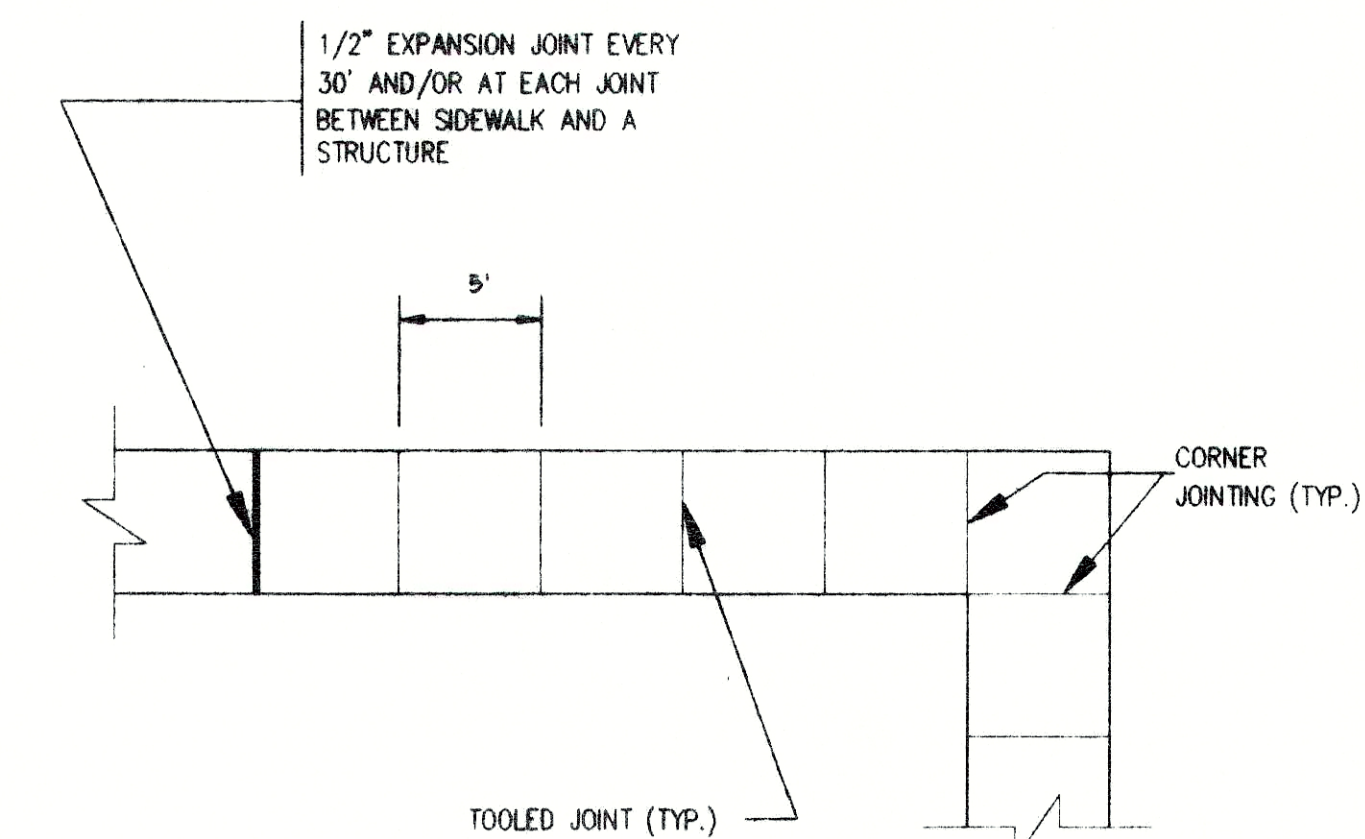


5 **TYPICAL SIDEWALK DETAIL**
SCALE: N.T.S.

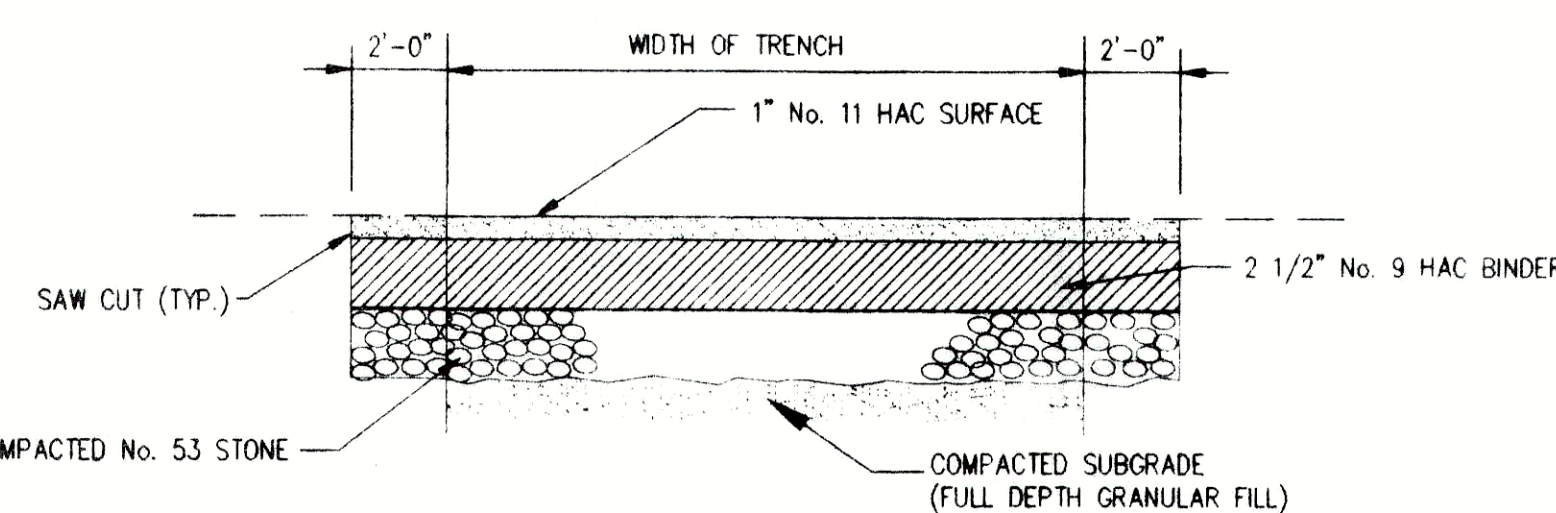


6 **ASPHALT DRIVE REPAIR DETAIL**
SCALE: N.T.S.

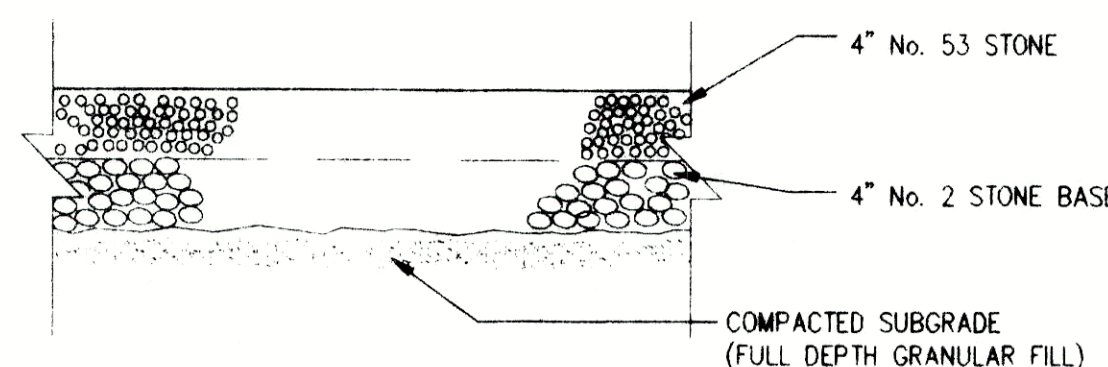

7 **STONE DRIVE REPAIR DETAIL**
SCALE: N.T.S.

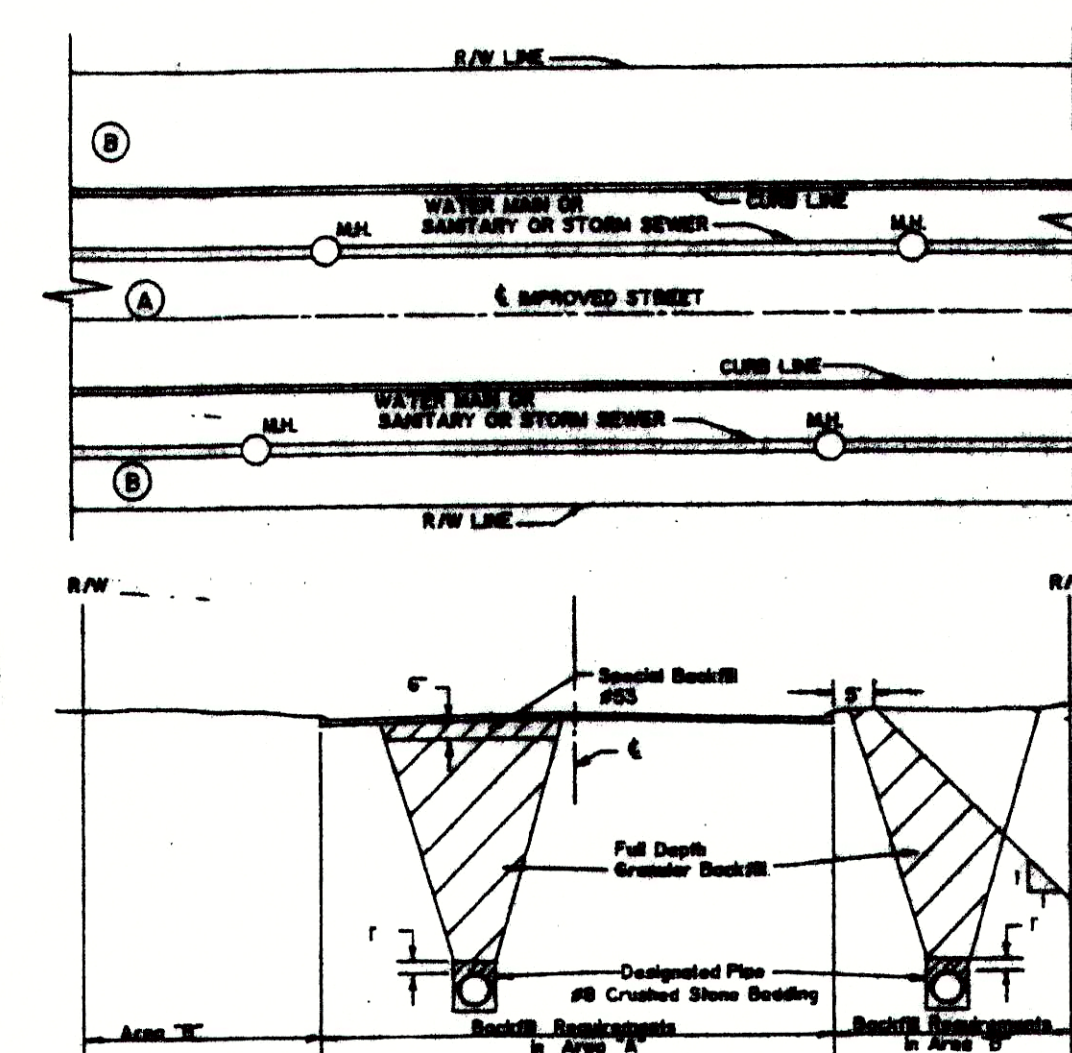

BACKFILL REQUIREMENTS
(FOR PIPELINES WITHIN RIGHT-OF-WAY FOR IMPROVED STREETS)

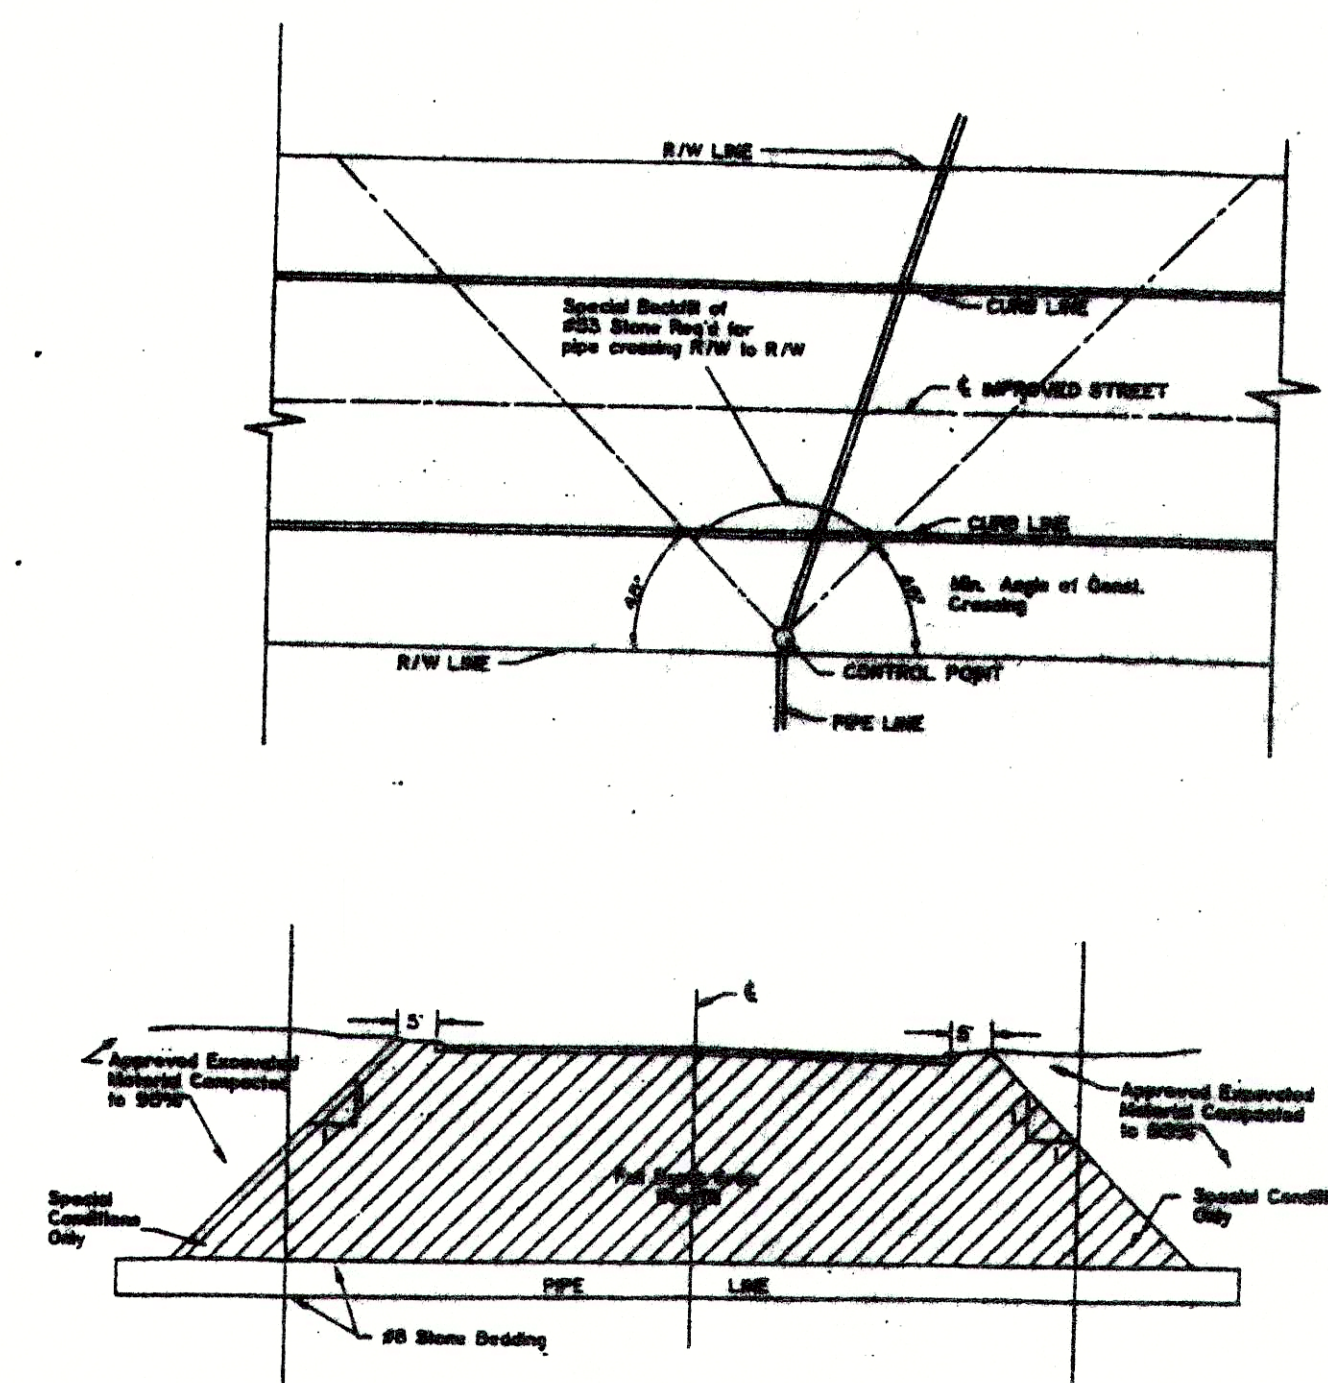

BACKFILL REQUIREMENTS
(FOR PIPELINES CROSSING RIGHT-OF-WAY FOR IMPROVED STREETS)

AS-BUILT
09/18/95

FILE NAME:	ABDETAIL	PLOT SCALE:	1=1	PLOT DATE:	11/03
NO.	DATE	DESCRIPTION	BY		

TRIAD ASSOCIATES INC.
INDIANAPOLIS, INDIANA

APPROVED
JAMES W. FRAZELL
REGISTERED
No. 17208
STATE OF INDIANA
Professional Engineer

FALL CREEK REGIONAL WASTE DISTRICT
HICKORY HILLS SUBDIVISION
STANDARD SANITARY SEWER DETAILS
DRAWN BY: DAP
DATE: 04/20/94
SCALE: AS NOTED
PROJECT No.: 94025
SHEET No.: 13
DESIGNED BY: Robert P. Walker
CHECKED BY: James W. Frazell, P.E.