


FALL CREEK REGIONAL
WASTE DISTRICT
HIGH ST. & JEFFERSON ST.

INDEX SA-7

KEYNOTES

- (A) MH #1-35-A
TC = 831.21
INV. = 824.66
(B) MH #1-35-A4
TC = 831.75
INV. = 827.85
(C) MH #1-35-A3
TC = 834.33
INV. = 829.43
(D) MH #1-35-A2
TC = 837.70
INV. = 831.10
(E) MH #1-35-A1
TC = 839.52
INV. = 832.92

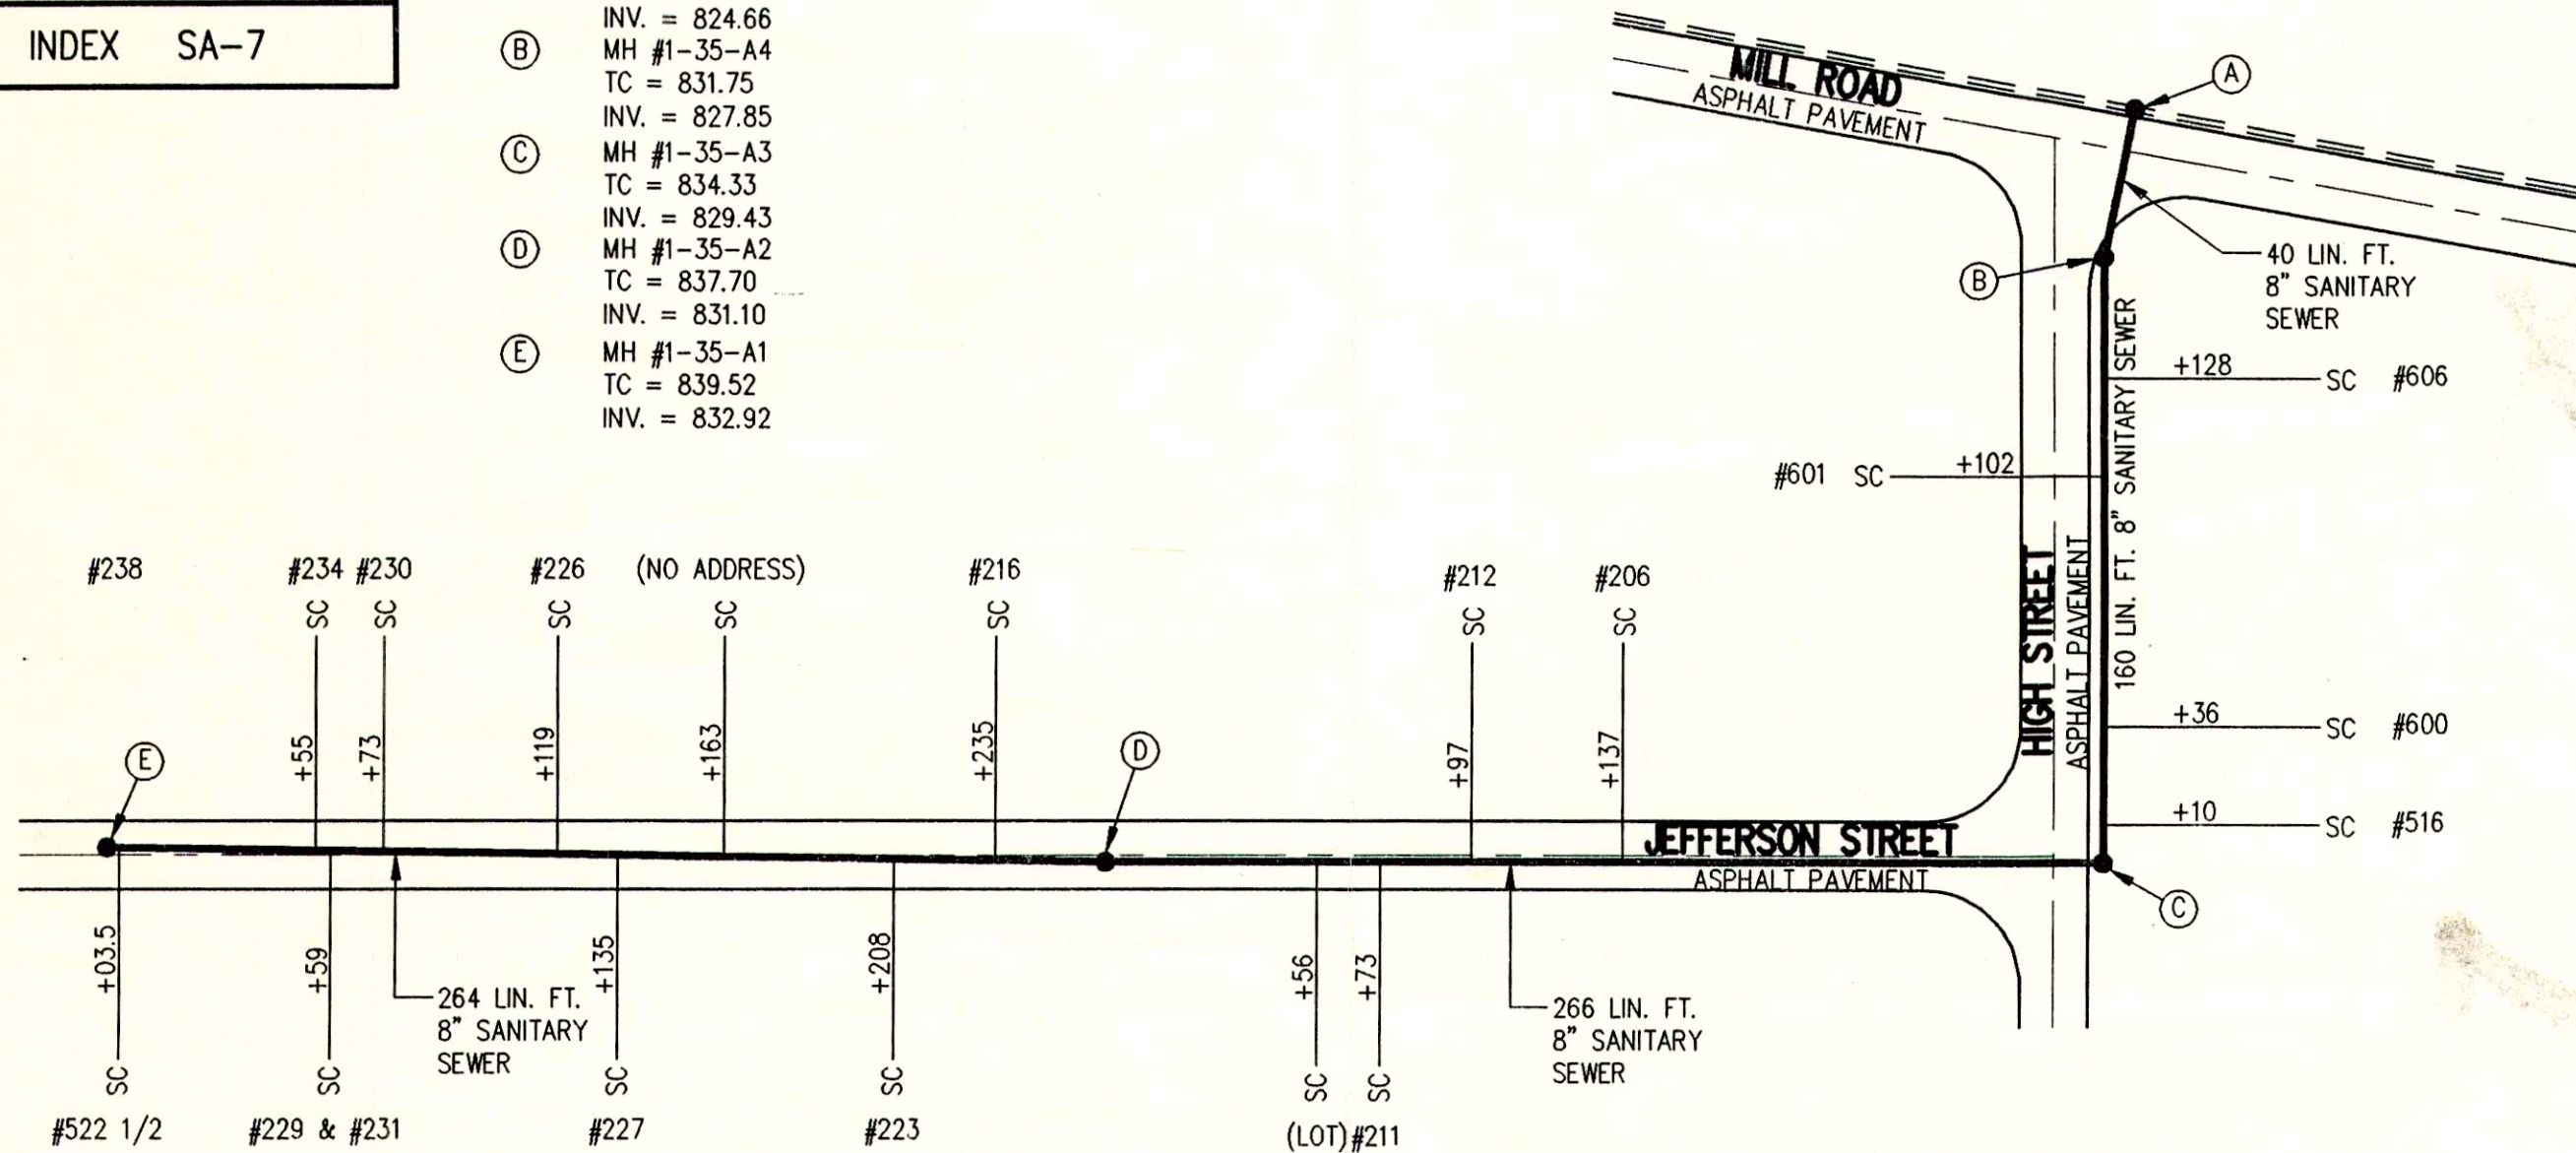

LEGEND

- | | |
|--------------------------------|---------------------------------|
| --- EASEMENT LIMITS | --- W --- WATERLINE LOCATION |
| --- RIGHT-OF-WAY LIMITS | --- G --- GAS LINE LOCATION |
| --- FORCE MAIN LOCATION | --- T --- UNDERGROUND TELEPHONE |
| --- SANITARY SEWER LOCATION | * * * FENCE LINE |
| --- STORM SEWER LOCATION | x LIGHT POLE |
| SC SANITARY SERVICE CONNECTION | ■ POWER POLE |

AS-BUILT INFORMATION

SCALE: 1" = 50'



TRIAD
ASSOCIATES
INC.
INDIANAPOLIS, INDIANA

