


Denotes approximate limits of granular backfill. Refer to respective specifications for exact limits and acceptable backfill materials.

NOTES:

1. Maintain a minimum of 18" of vertical separation per IDEM requirements.
2. Construct Cold Springs Drive (Line "CSDr") to the Neighborhood Collector Street Standard.
3. Construct Winding Brook Way (Line "WBW"), Elderberry Court (Line "ECt"), and Fair Weather Drive (Line "FWDr") to the Local Street Standards.

"WBW" denotes Winding Brook Way
"CSDr" denotes Cold Springs Drive
"ECt" denotes Elderberry Court
"FWDr" denotes Fair Weather Court
"SSC" denotes Sanitary Sewer Line "C"
"SSD" denotes Sanitary Sewer Line "D"
"SSE" denotes Sanitary Sewer Line "E"
"SSF" denotes Sanitary Sewer Line "F"
"SSG" denotes Sanitary Sewer Line "G"
"SSK" denotes Sanitary Sewer Line "K"

Scale:
Hor: 1"=50'
Ver: 1"=5'

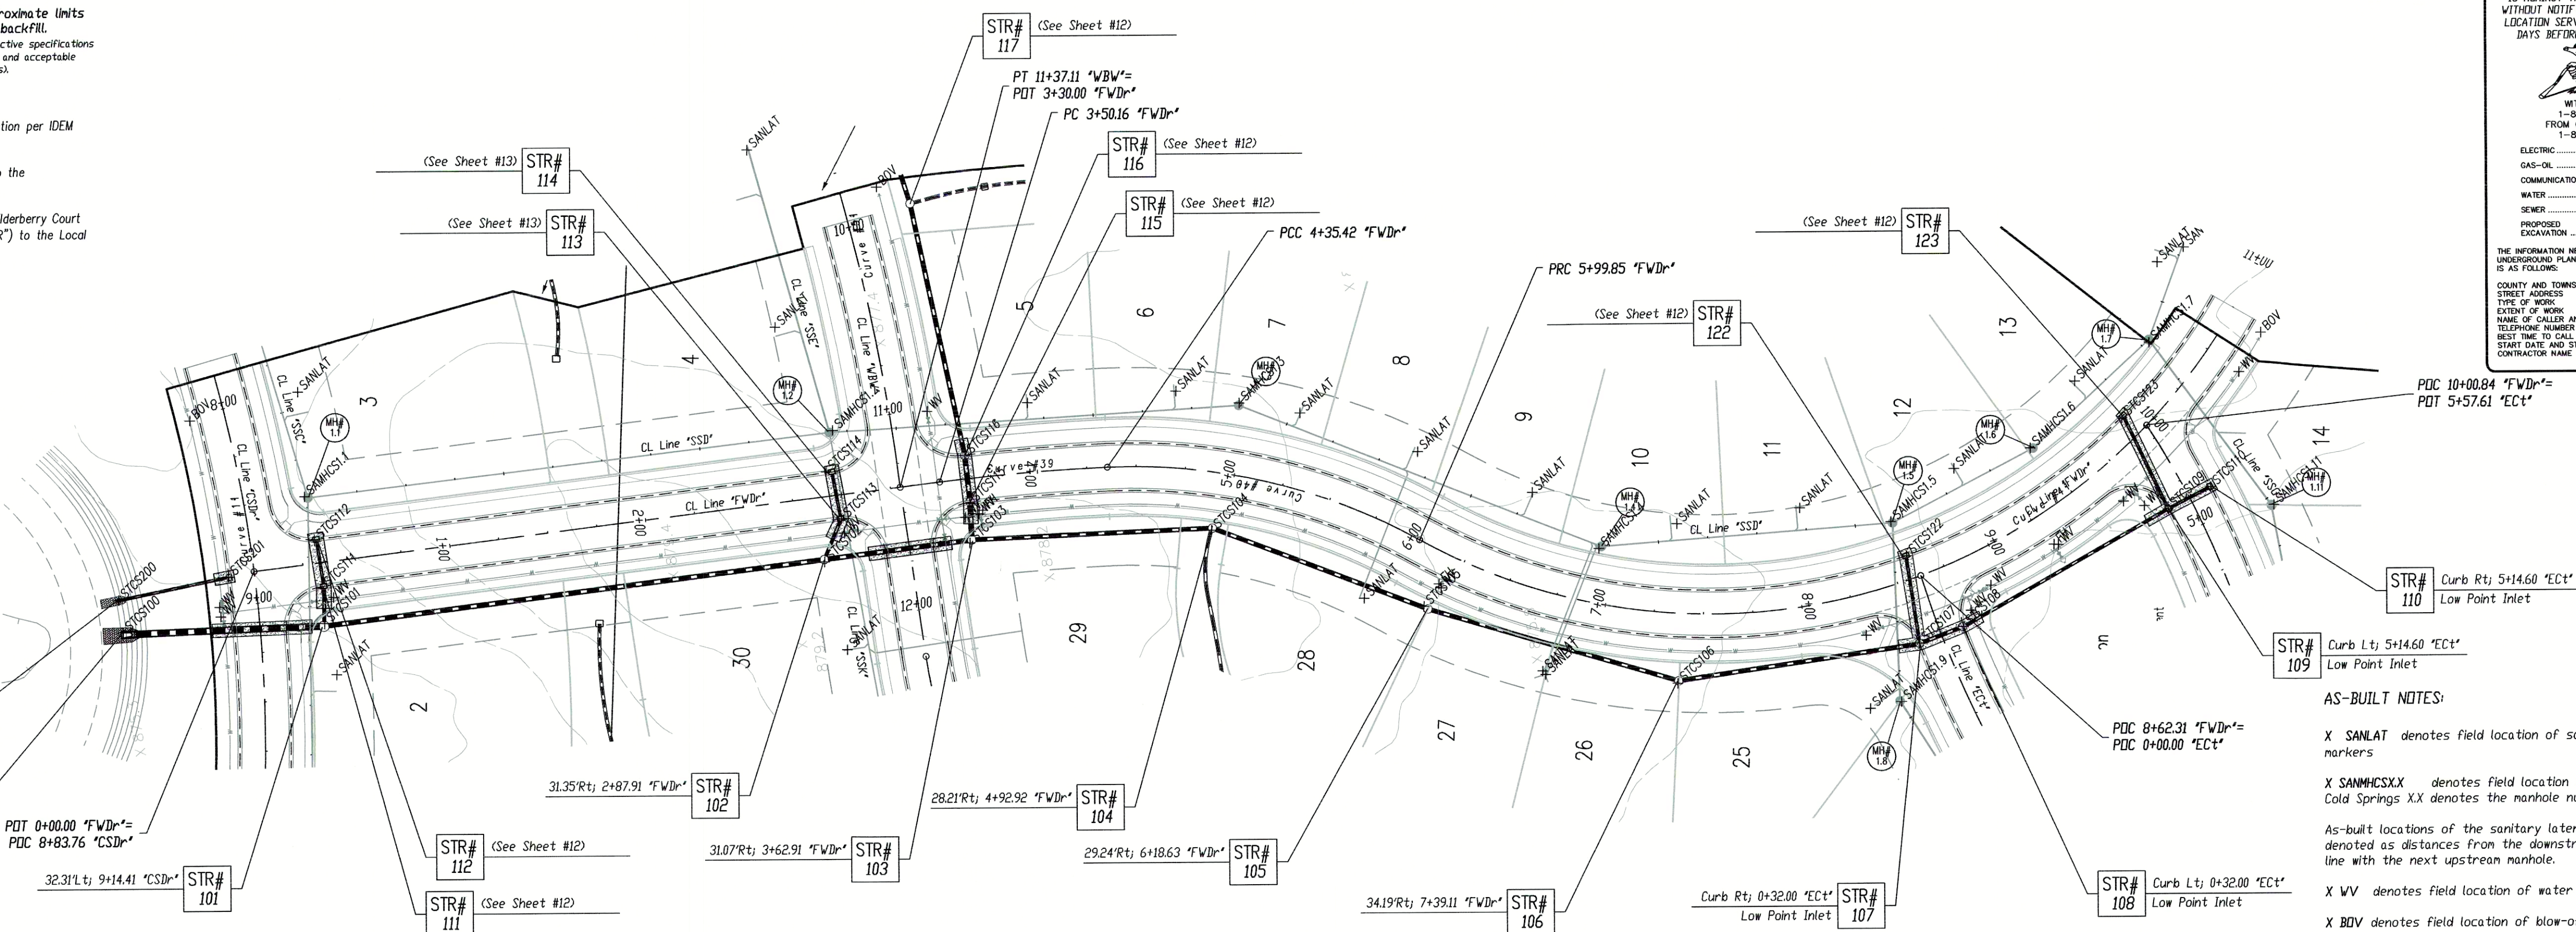

PER INDIANA STATE LAW 15-69-1991, IT IS AGAINST THE LAW TO EXCAVATE WITHOUT NOTIFYING THE UNDERGROUND LOCATION SERVICE TWO (2) WORKING DAYS BEFORE COMMENCING WORK.

WITHIN INDIANA:
1-800-362-5544
FROM OUTSIDE INDIANA:
1-800-428-5200


ELECTRIC RED
GAS-OIL YELLOW
COMMUNICATIONS ORANGE
WATER BLUE
SEWER GREEN
PROPOSED EXCAVATION WHITE

THE INFORMATION NEEDED WHEN CALLING INDIANA IS AS FOLLOWS:
COUNTY AND TOWNSHIP
STREET ADDRESS
TYPE OF WORK
NAME OF CALLER AND TITLE
TELEPHONE NUMBER
BEST TIME TO CALL
START DATE AND START TIME
CONTRACTOR NAME AND ADDRESS

AS-BUILT NOTES:

- X SANLAT denotes field location of sanitary lateral markers
- X SANMCSXX denotes field location of a manhole in Cold Springs XX denotes the manhole number
- As-built locations of the sanitary lateral tees are denoted as distances from the downstream manhole, in line with the next upstream manhole.
- X WV denotes field location of water valve.
- X BOV denotes field location of blow-off valve
- X FH denotes field location of Fire Hydrant
- See As-built Plan notes from contractor for measured locations of tees, ellis, valves, hydrants and other fittings from street centerline intersections.
- X STCSxxx denotes field location of storm structure in Cold Springs xxx denotes the structure number.
- (cnc) denotes "could not confirm"

Strs #100-110

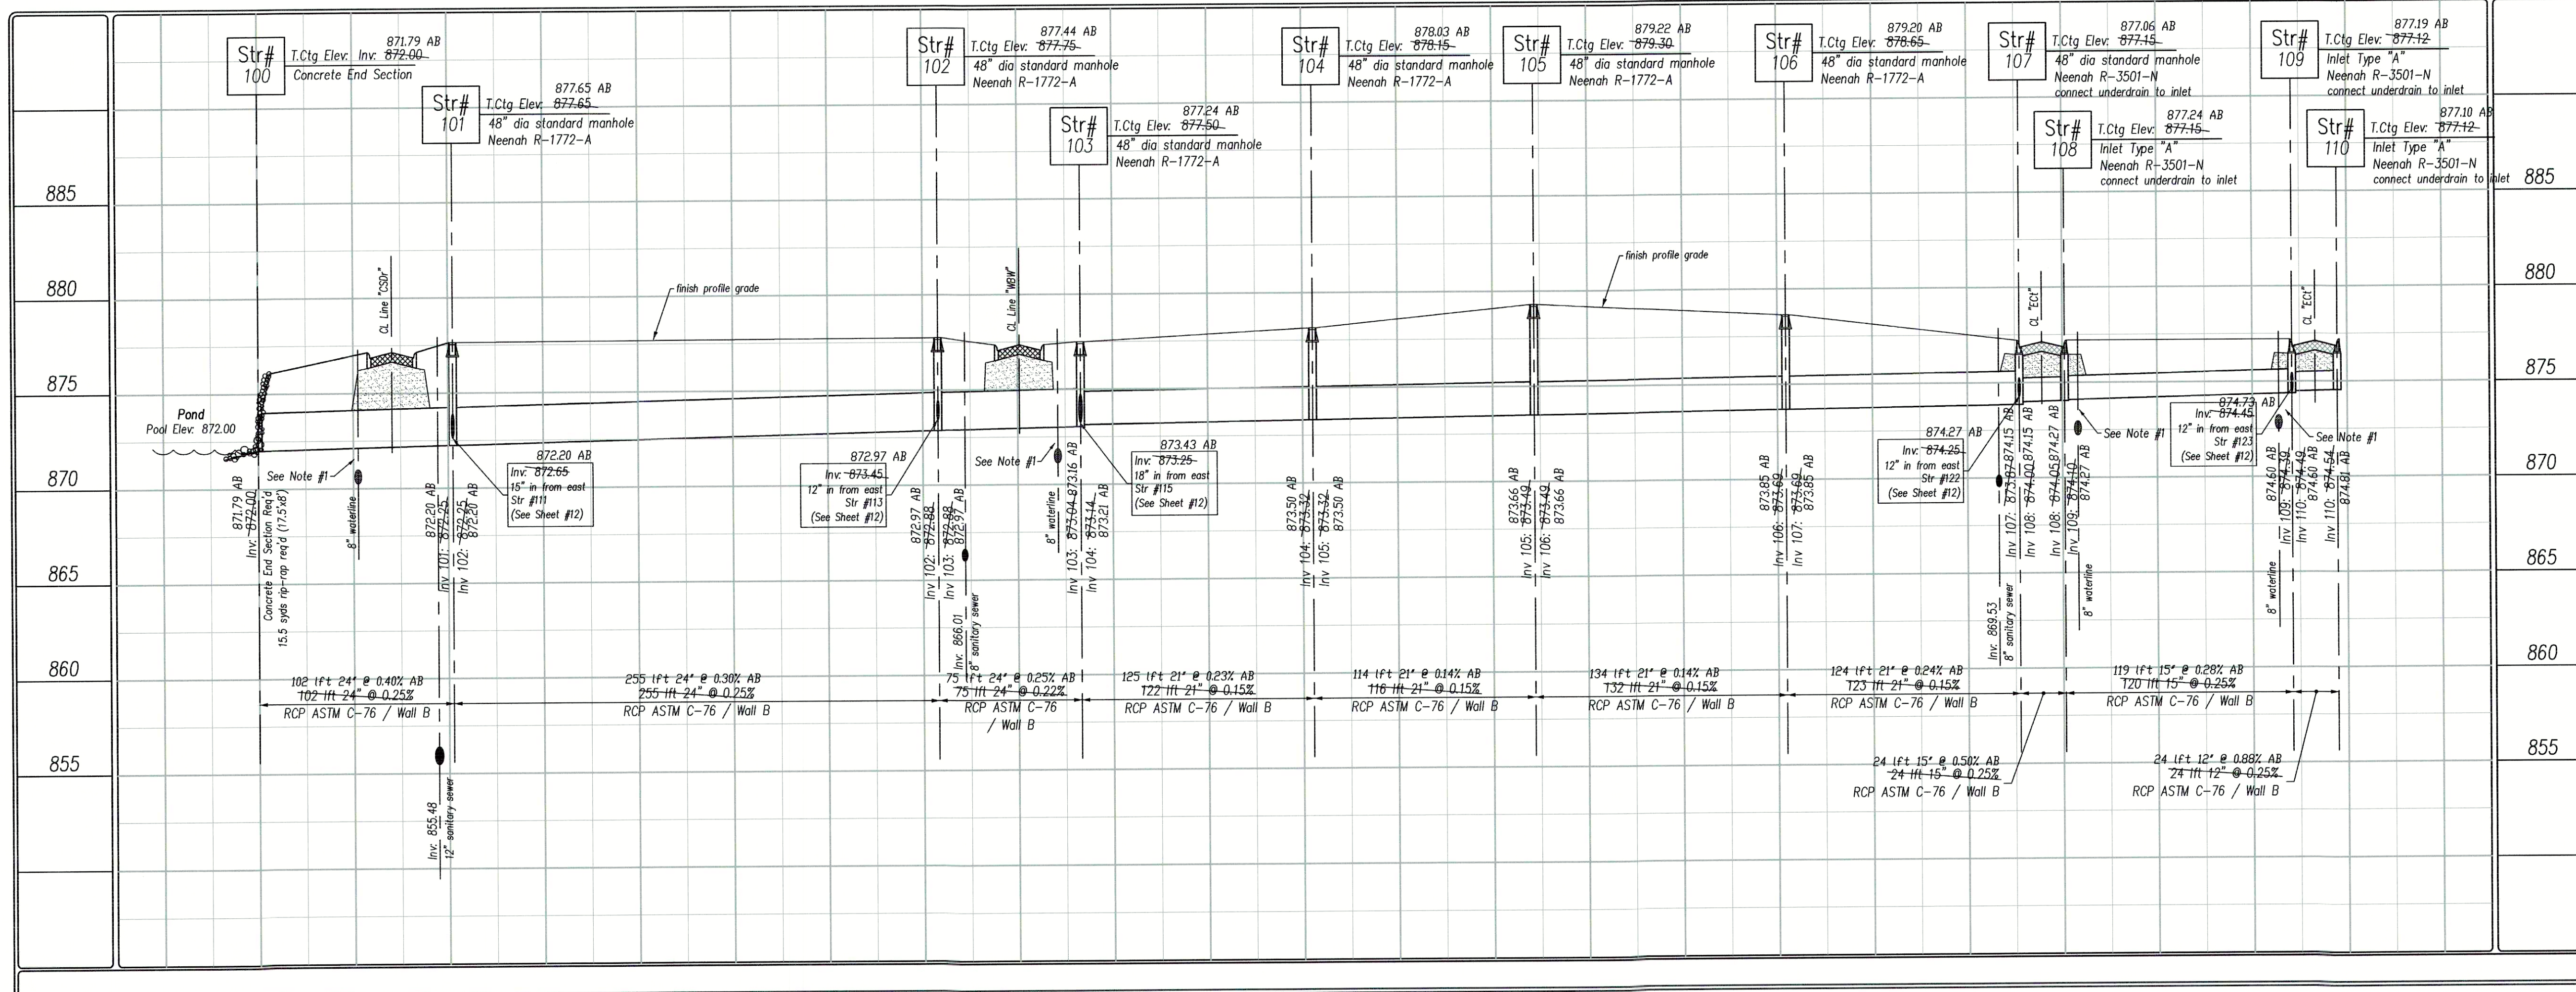

As-built Plans

Project: Cold Springs at Huntzinger Farms
Section 1
Pendleton, Madison County, Indiana
Sheet Title: Storm Sewer Plan - Profile
Storm Series 100 (Strs #100 - 110)



Sheet No. 11 of 18 Sheets

North
Scale: 1"=50'
Pendleton Land Company, LLC
9449 Priority Way West Drive
Indianapolis, Indiana 46240
Phone: 765-796-4540 Fax: 765-796-3571
email: pendco@aol.com

Date: 8/08/04
Revision: 9/23/05
Revised per client's lot lines / numbering.