


Denotes approximate limits of granular backfill. Refer to respective specifications for exact limits and acceptable backfill materials.

NOTES:

1. Maintain a minimum of 18" of vertical separation per IDEM requirements.
2. Construct Cold Springs Drive (Line "CSDr") to the Neighborhood Collector Street Standard.
4. Construct Winding Brook Way (Line "WBW"), Elderberry Court (Line "ECt"), and Fair Weather Drive (Line "FWDr") to the Local Street Standards.

'WBW' denotes Winding Brook Way
'CSDr' denotes Cold Springs Drive
'ECt' denotes Elderberry Court
'FWDr' denotes Fair Weather Court
'SSC' denotes Sanitary Sewer Line 'C'
'SSD' denotes Sanitary Sewer Line 'D'
'SSE' denotes Sanitary Sewer Line 'E'
'SSF' denotes Sanitary Sewer Line 'F'
'SSG' denotes Sanitary Sewer Line 'G'
'SSK' denotes Sanitary Sewer Line 'K'

Scale:
Hor: 1"=50'
Ver: 1"=5'

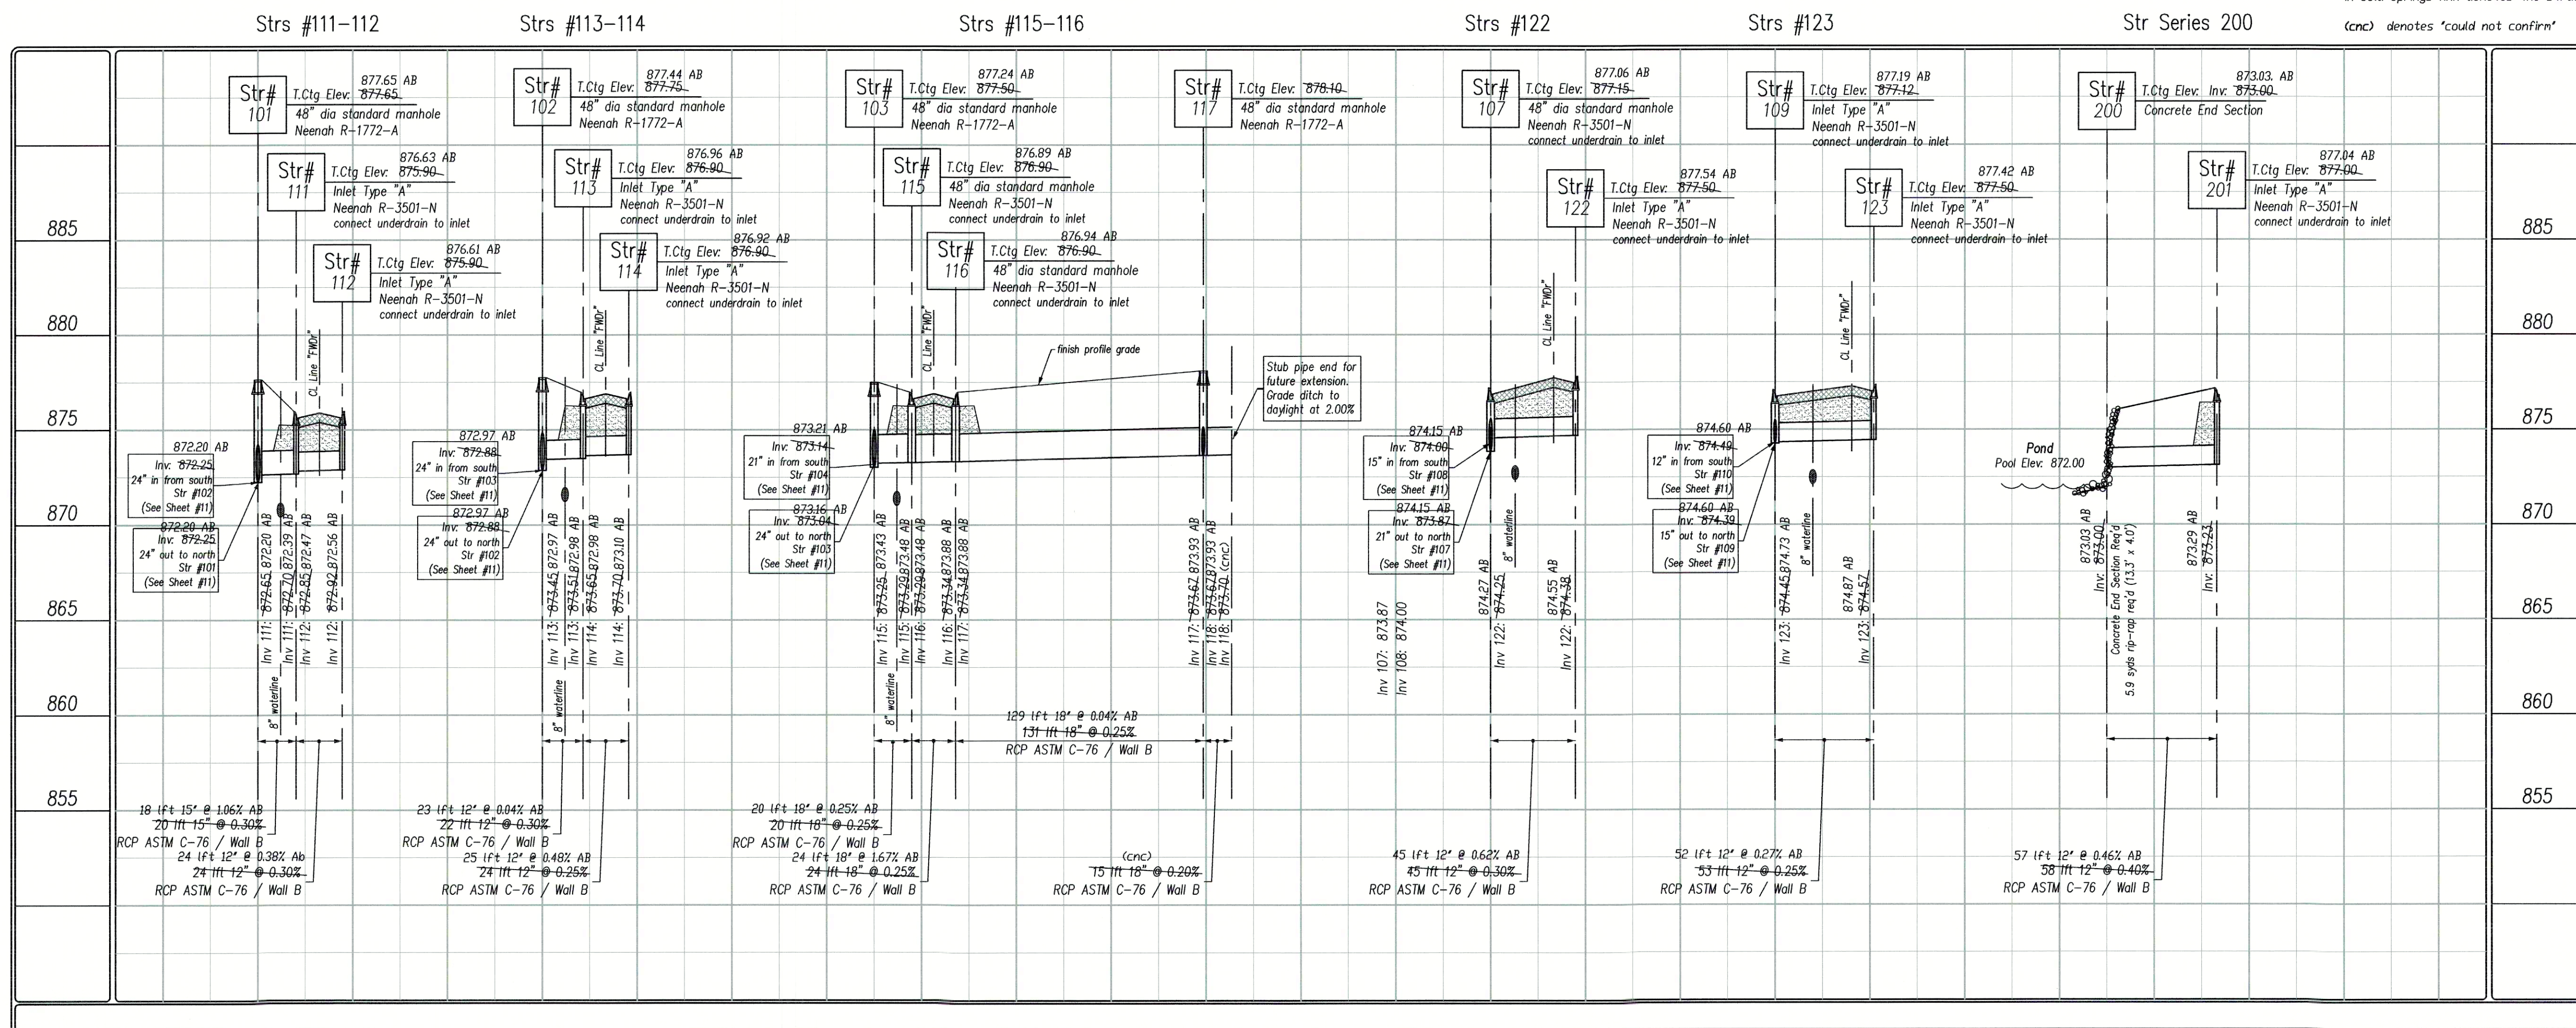

PER INDIANA STATE LAW IS-69-1991, IT IS AGAINST THE LAW TO EXCAVATE WITHOUT NOTIFYING THE UNDERGROUND LOCATION SERVICE TWO (2) WORKING DAYS BEFORE COMMENCING WORK.

WITHIN INDIANA: 1-800-382-5544
FROM OUTSIDE INDIANA: 1-800-458-5200

ELECTRIC: RED
GAS-OIL: YELLOW
COMMUNICATIONS: ORANGE
WATER: BLUE
SEWER: GREEN
PROPOSED: WHITE

THE INFORMATION NEEDED WHEN CALLING INDIANA UNDERGROUND PLANT PROTECTION SERVICES, INC. IS AS FOLLOWS:

COUNTY AND TOWNSHIP
STREET ADDRESS
TYPE OF WORK
EXTENT OF WORK
NAME OF CALLER AND TITLE
TELEPHONE NUMBER
BEST TIME TO CALL
START DATE AND START TIME
CONTRACTOR NAME AND ADDRESS

North

Scale: 1"=50'

Pendleton Consulting
P.O. Box 67 Pendleton, Indiana 46064
Phone: 765-776-4640 Fax: 765-776-3971
email: pendcon@netdirect.net

Pendleton Land Company, LLC
9449 Priority Way West Drive
Suite 120
Indianapolis, Indiana 46240
Tel: 317-706-5985 Fax: 317-706-5209

Date: 8/08/04

Revision: Revised per client lot lines / numbering.

Date: 9/23/05

Cold Springs at Huntzinger Farms
Section 1
Pendleton, Madison County, Indiana

Storm Sewer Plan - Profile
Storm Series 200 & 100 (Strs #111 - 123)

REGISTERED PROFESSIONAL ENGINEER
No. 50441
STATE OF INDIANA
LAND SURVEYOR

Sheet No. 12
18 Sheets

As-built Plans