
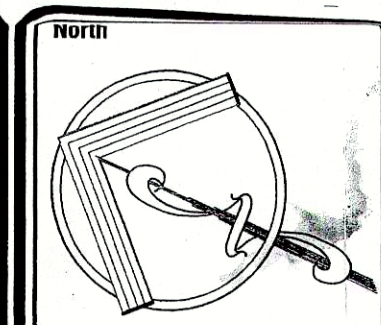
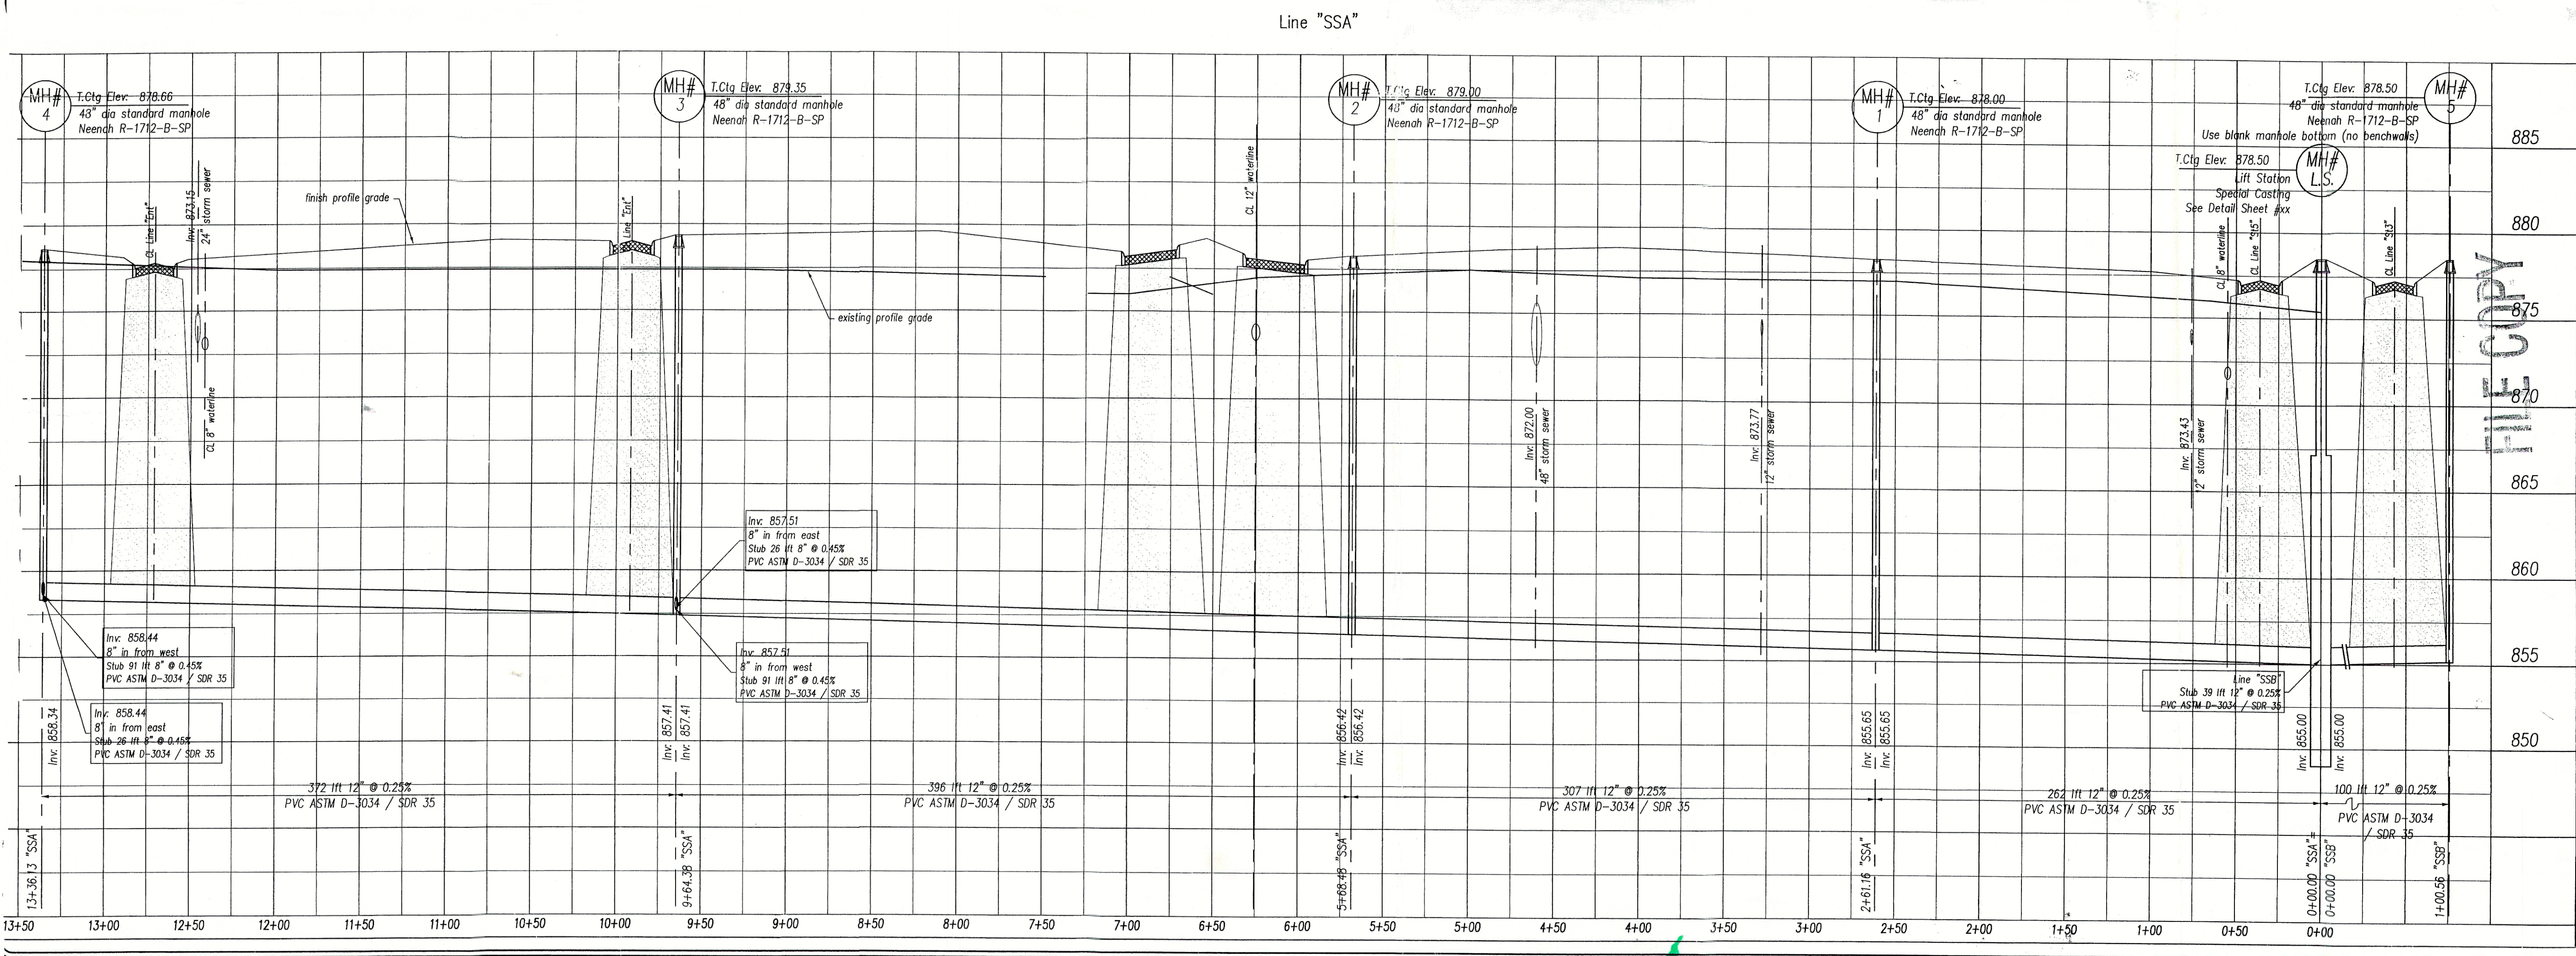


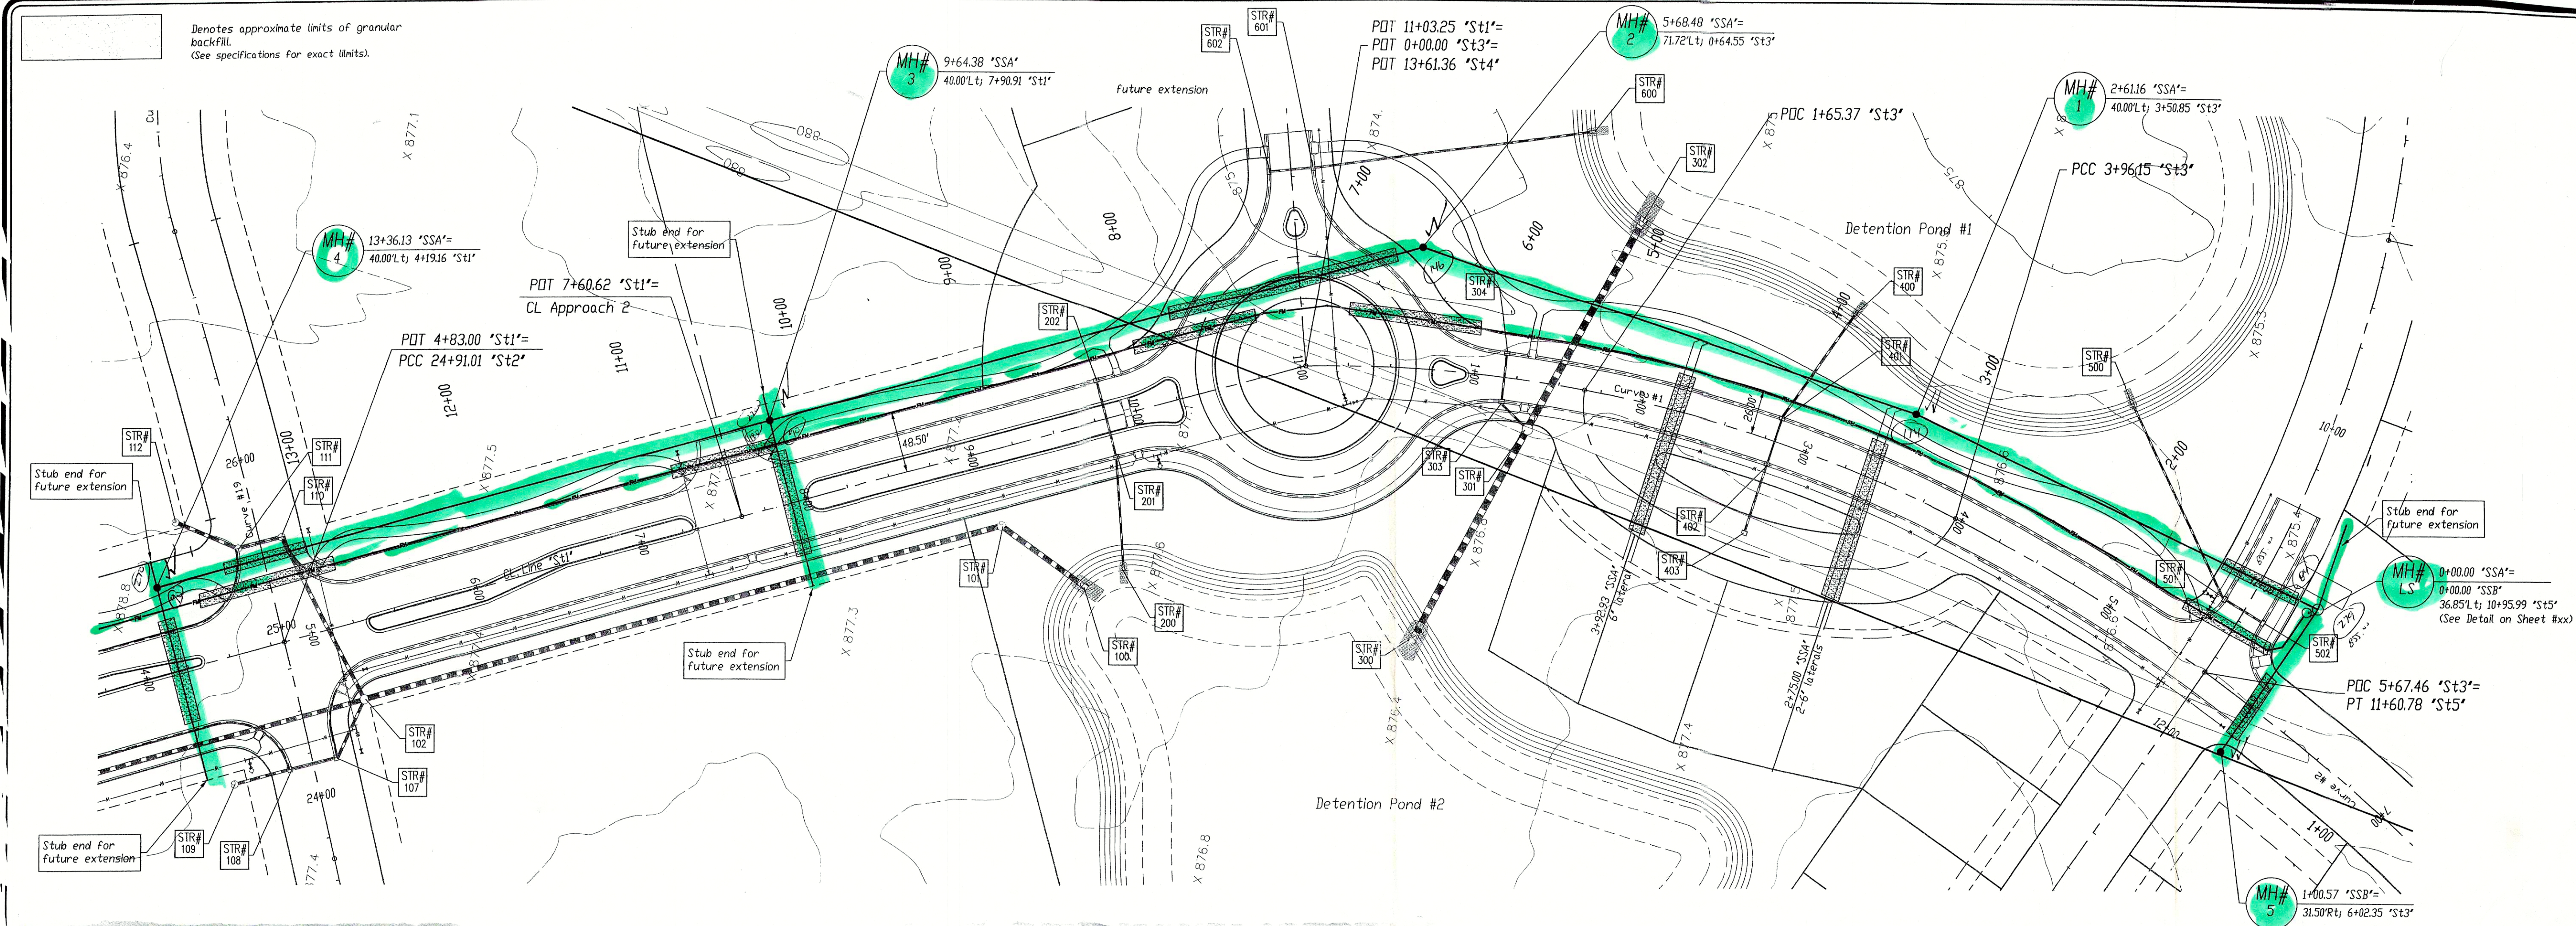

Scale: 1" = 50'


Pendleton Consulting
 P.O. Box 67 Pendleton, Indiana 46064
 Phone: 765-778-4540 Fax: 765-778-3571
 email: pendletonindirect.net

Pendleton Land Company, LLC
 9449 Priority Way West Drive
 Suite 120
 Indianapolis, Indiana 46240
 Fax: 317-286-2868

Date: 1.30.04

Revised per client direction on alignments.
 3/4/04

Huntzinger Farms Phase I
 Pendleton, Madison County, Indiana
Sanitary Sewer Plan-Profile
 Line "SSA"

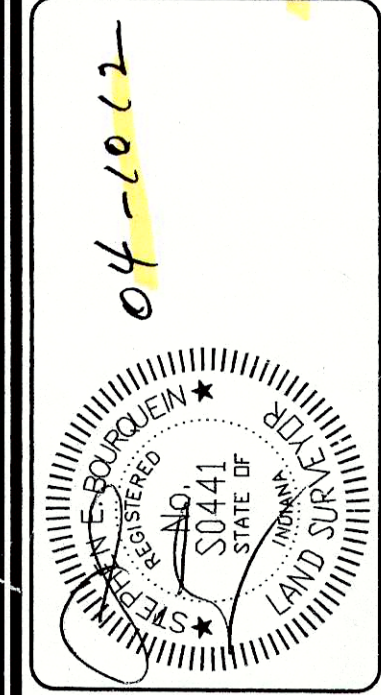

Sheet No. **9**
 of 21