




Denotes approximate limits of granular backfill.
(See specifications for exact limits).

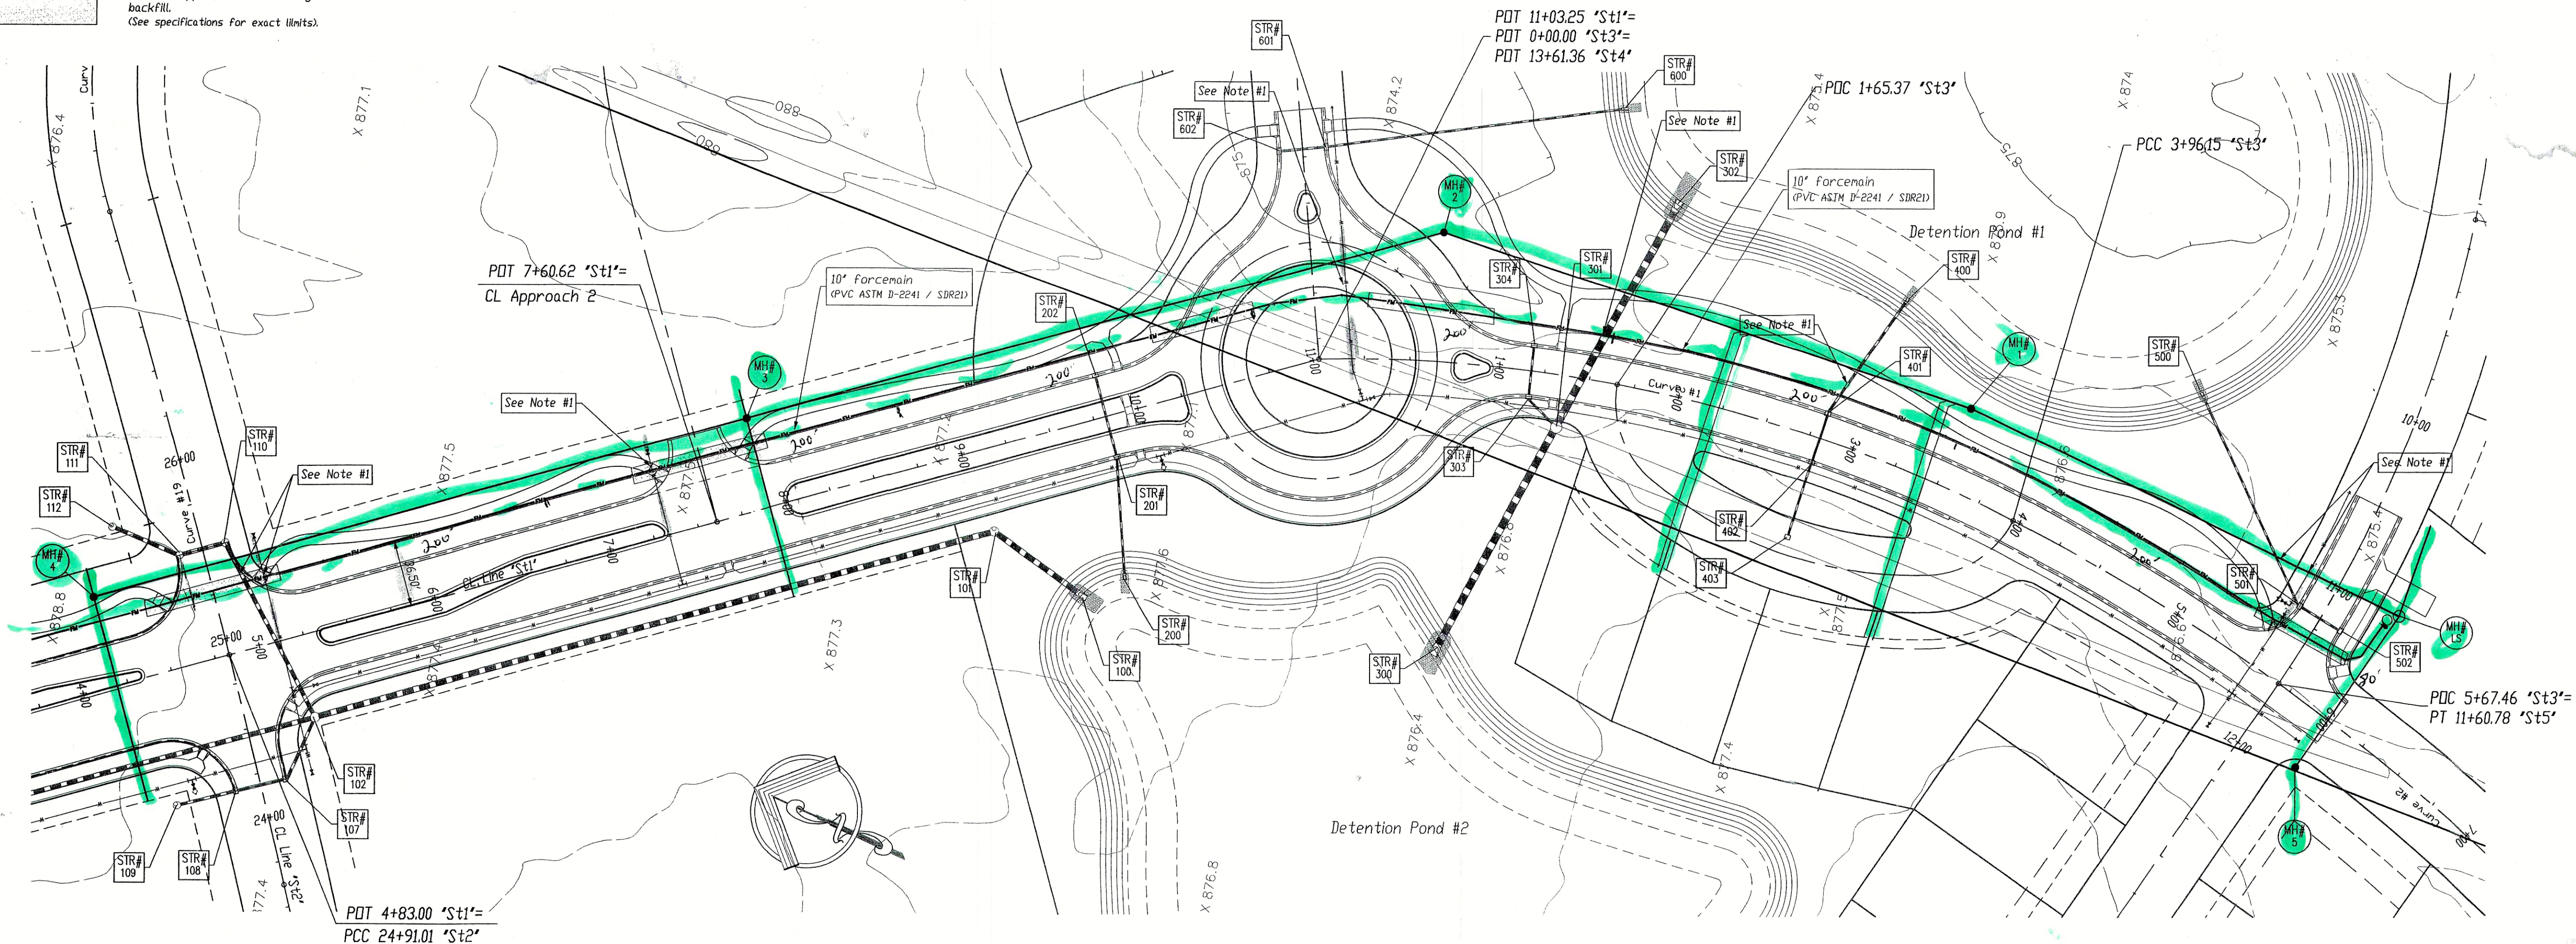


NOTES:
1. Maintain a minimum of 18" of vertical separation between the forcemain and the waterlines and storm sewers.

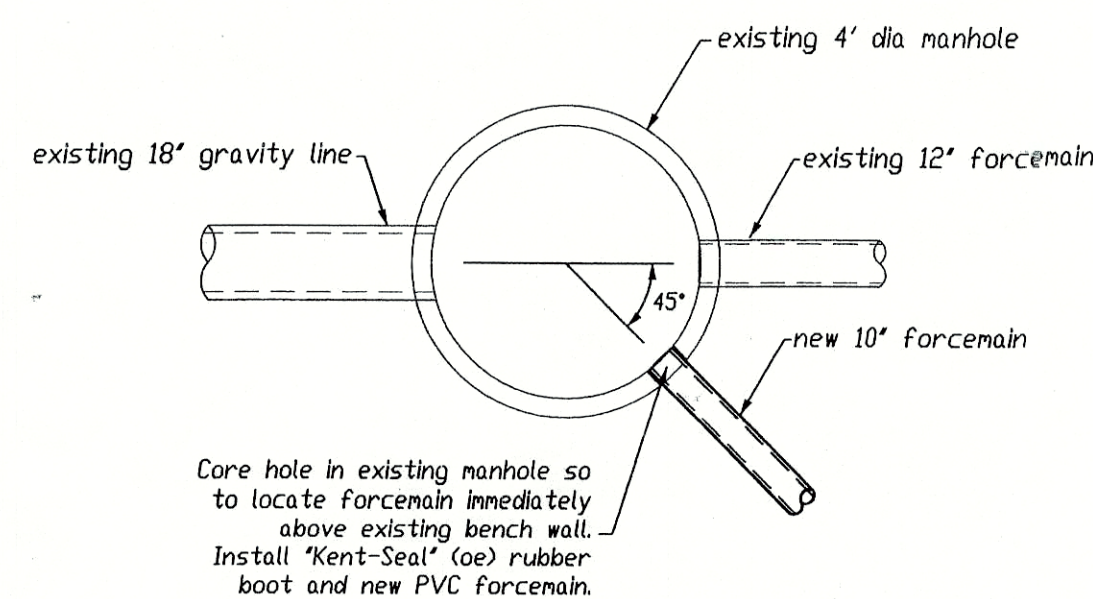

Forcemain Connection Detail

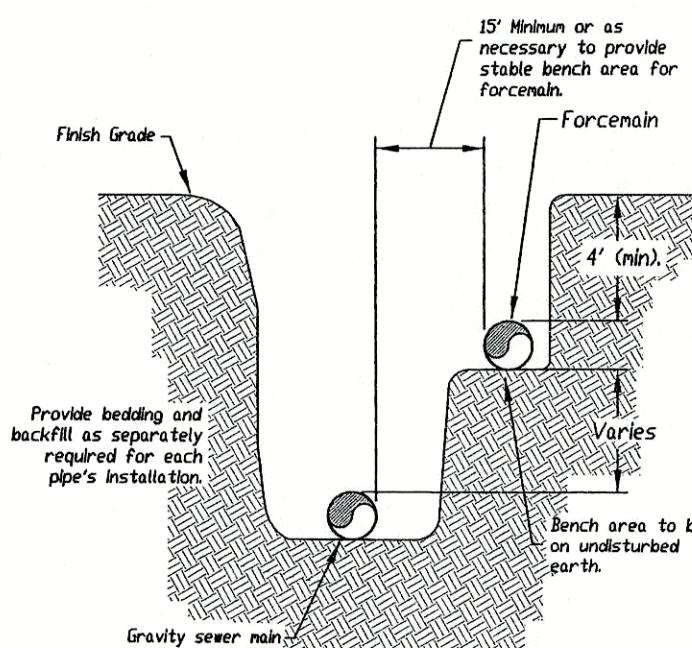

JOINT GRAVITY - FORCEMAIN INSTALLATION

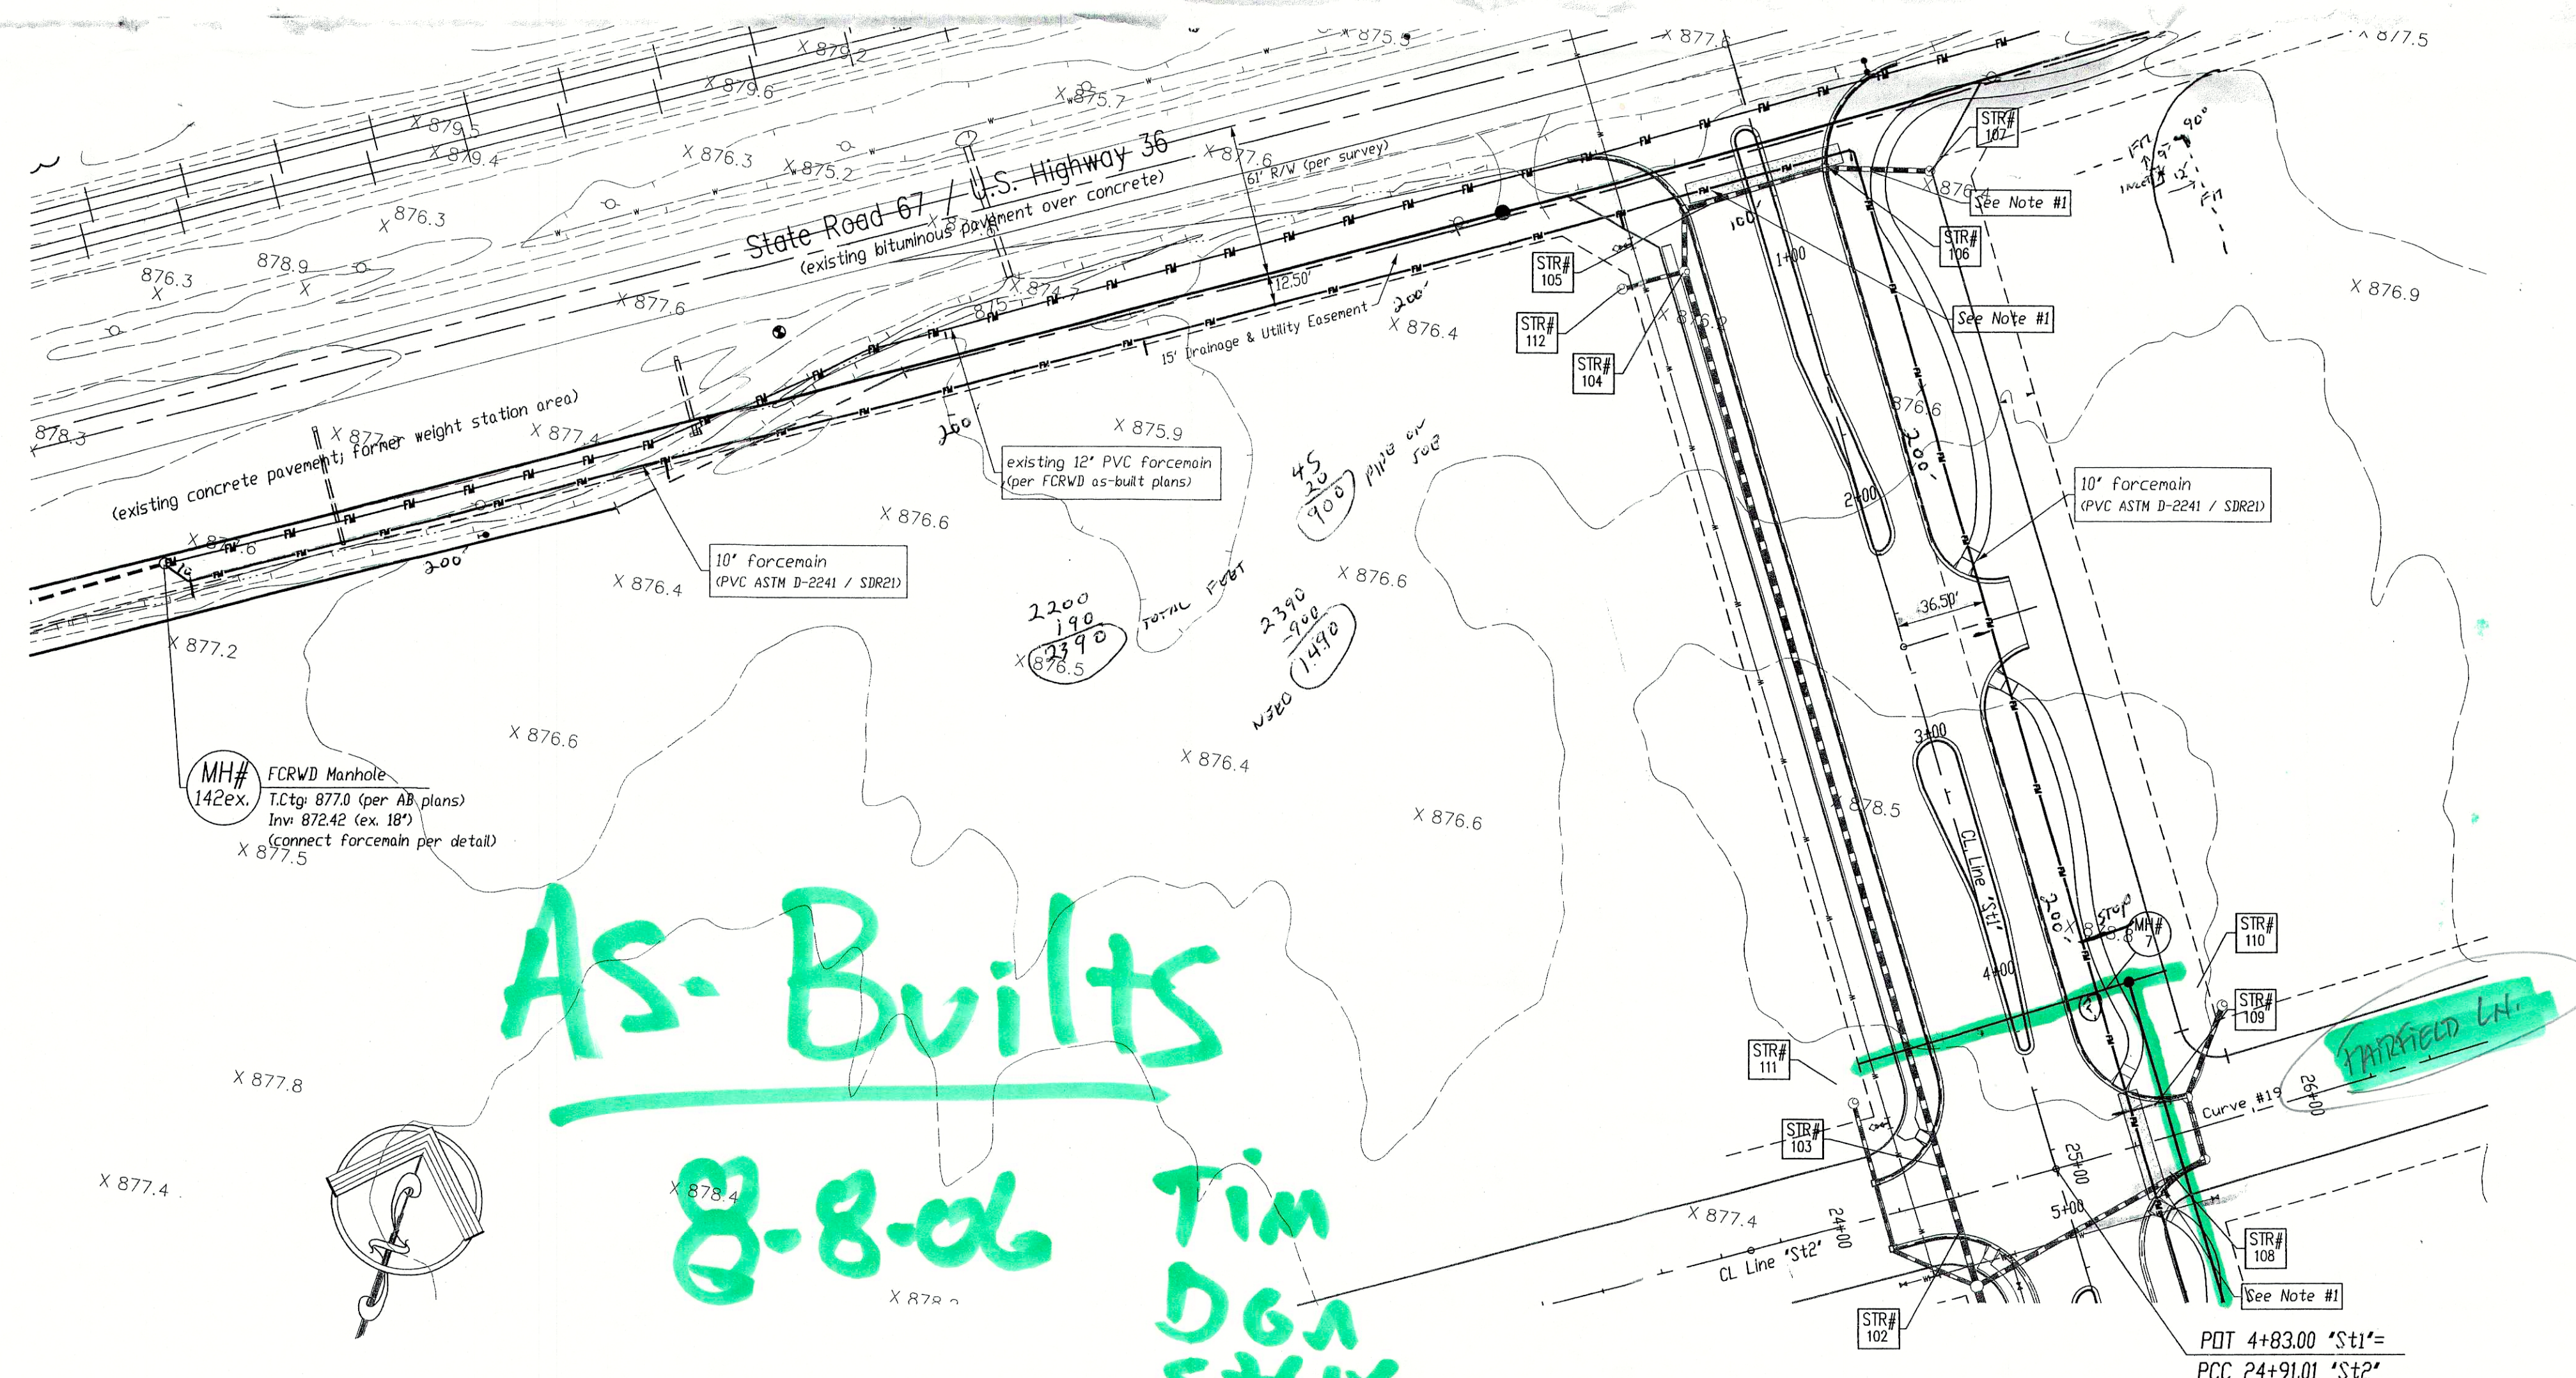

AS-BUILTS

8-8-06 Tim Don Steve

North

Scale: 1" = 50'

Pendleton Land Company, LLC
9449 Priority Way Drive
Suite 120
Indianapolis, Indiana 46240
Tel: 317.705.2063
Fax: 317.705.2069
email: pendleton@indirect.net

Date: 1.30.04

Revised per client direction on alignments.

3/4/04

Huntzinger Farms
Phase I
Pendleton, Madison County, Indiana

Sanitary Sewer Forcemain

Project

Sheet No. 10 of 21

10
21 Sheets