


Denotes approximate limits of granular backfill.
(See specifications for exact limits).

NOTES:

1. Maintain a minimum of 18" of vertical separation per IDEM requirements.
2. Unless otherwise noted all noted casting elevations are approximately 0.33' (4") above planned finish grade.
3. The noted length for pipe segments are rounded lengths between centerline stations of manholes.

"SSA" denotes Sanitary Sewer Line "A"
"SSC" denotes Sanitary Sewer Line "B"
"SSC" denotes Sanitary Sewer Line "C"
"HBLvd" denotes Huntzinger Blvd
"FLn" denotes Fairfield Lane
"WERd" denotes Waters Edge Road
"CSDr" denotes Cold Springs Drive

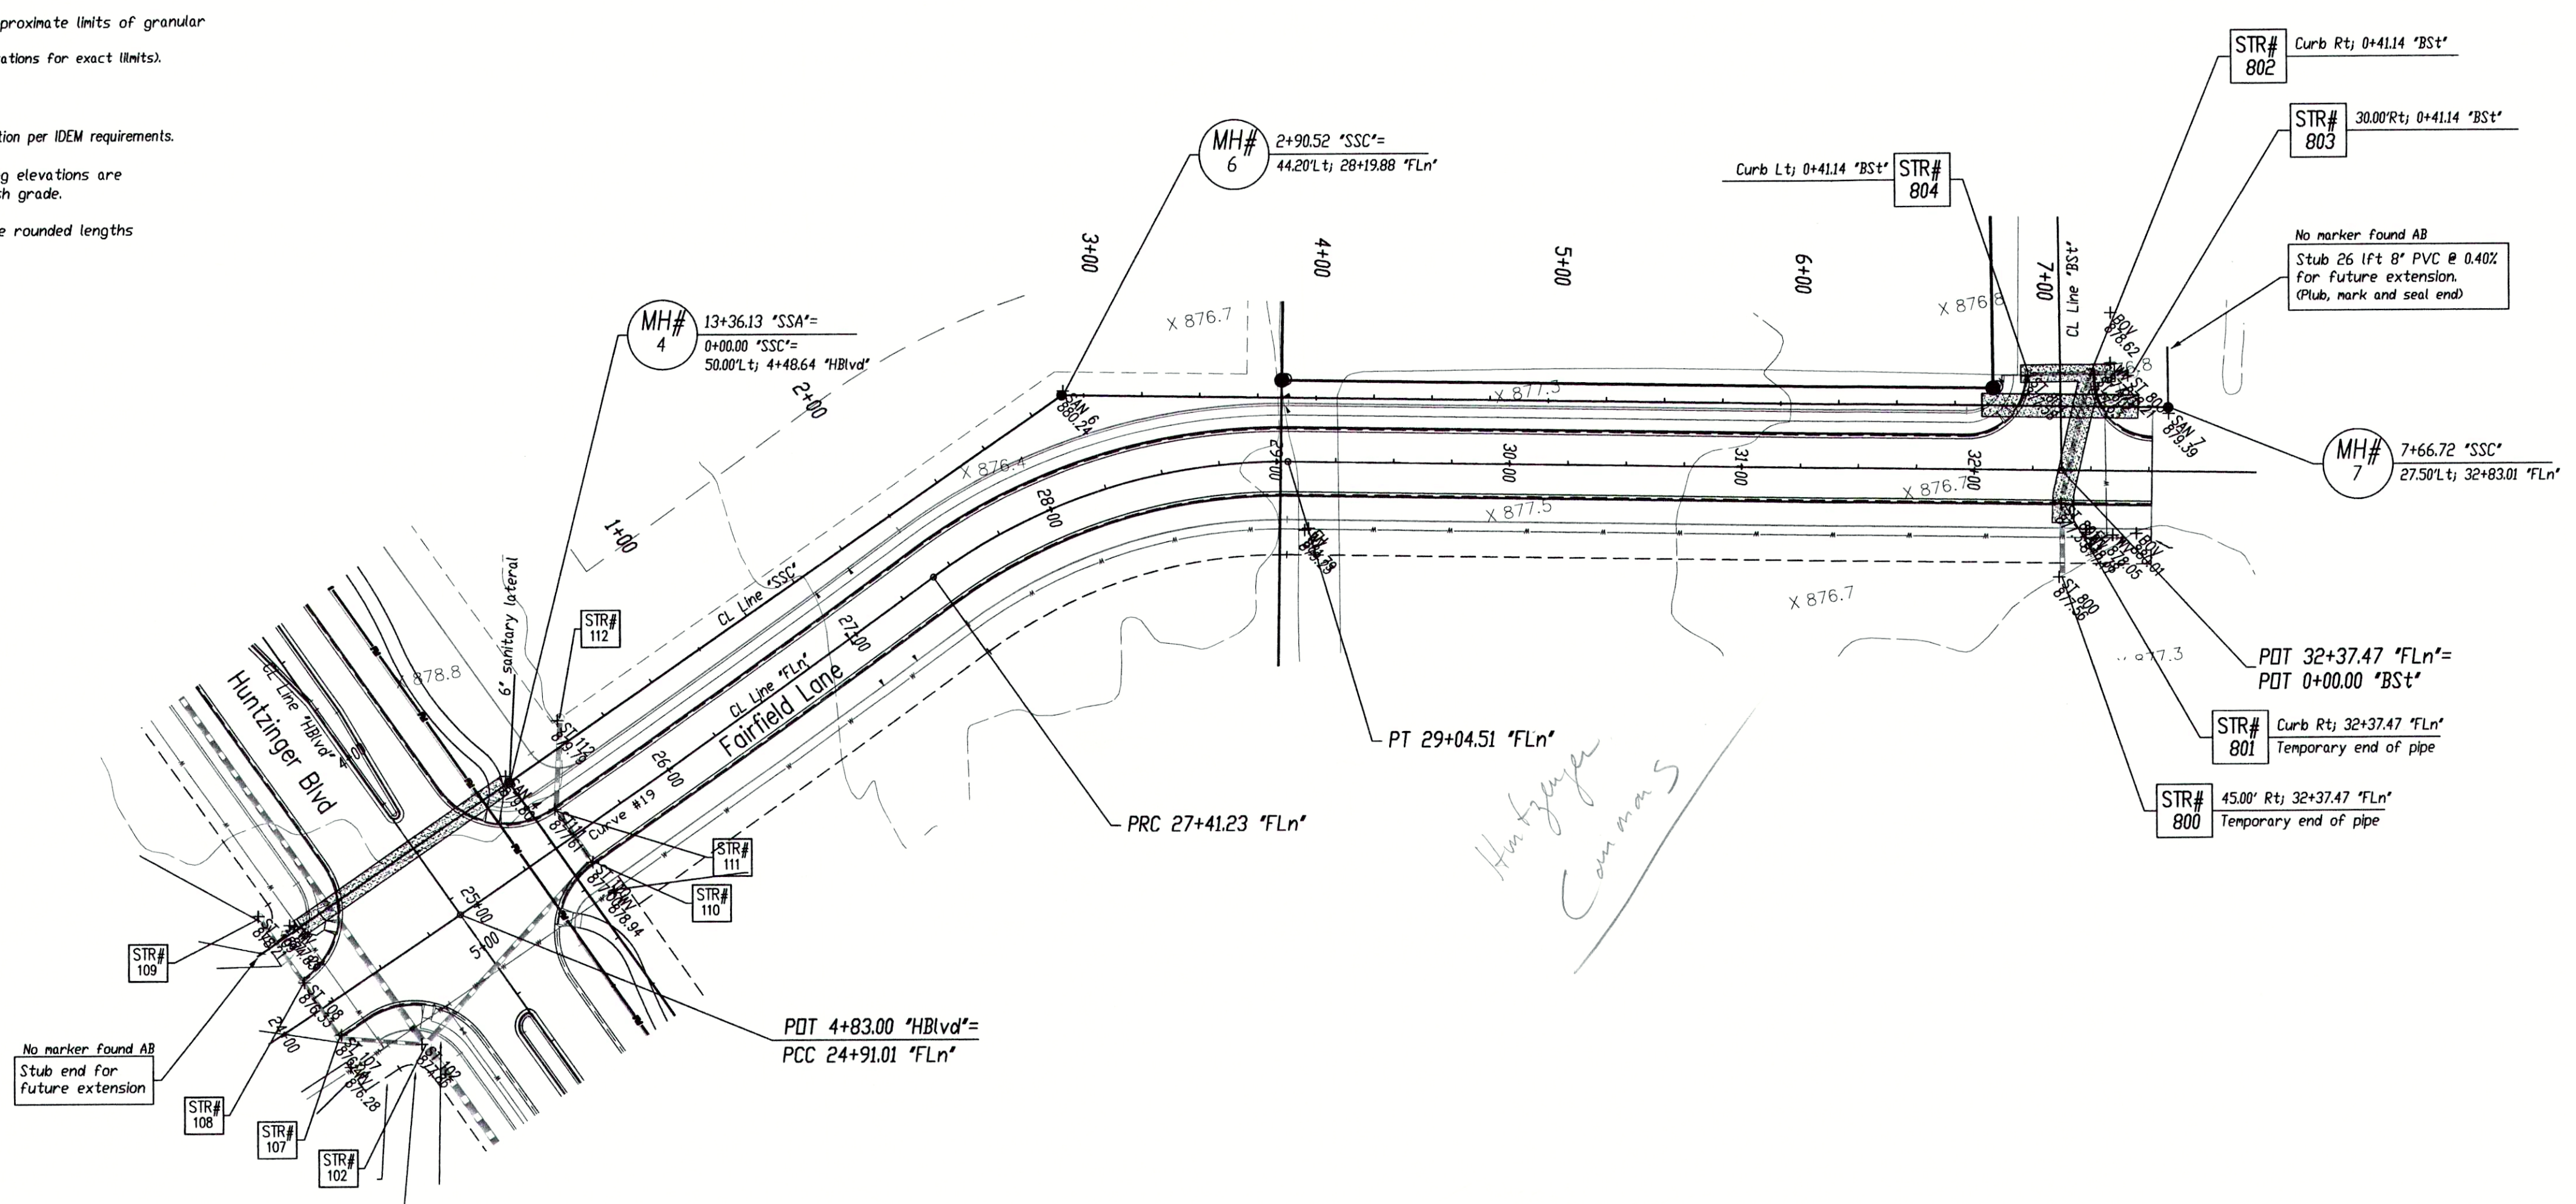


AS-BUILT NOTES:

- X SANLAT denotes field location of sanitary lateral markers
- X SANHCSXX denotes field location of a manhole in Cold Springs XX denotes the manhole number
- As-built locations of the sanitary lateral tees are denoted as distances from the downstream manhole, in line with the next upstream manhole.
- X WV denotes field location of water valve.
- X BDV denotes field location of blow-off valve
- X FH denotes field location of Fire Hydrant
- See As-built Plan notes from contractor for measured locations of tees, ells, valves, hydrants and other fittings from street centerline intersections.
- X STCSXX denotes field location of storm structure in Cold Springs xxx denotes the structure number.
- (cnc) denotes 'could not confirm'

Line "SSC"

Structure Series 800

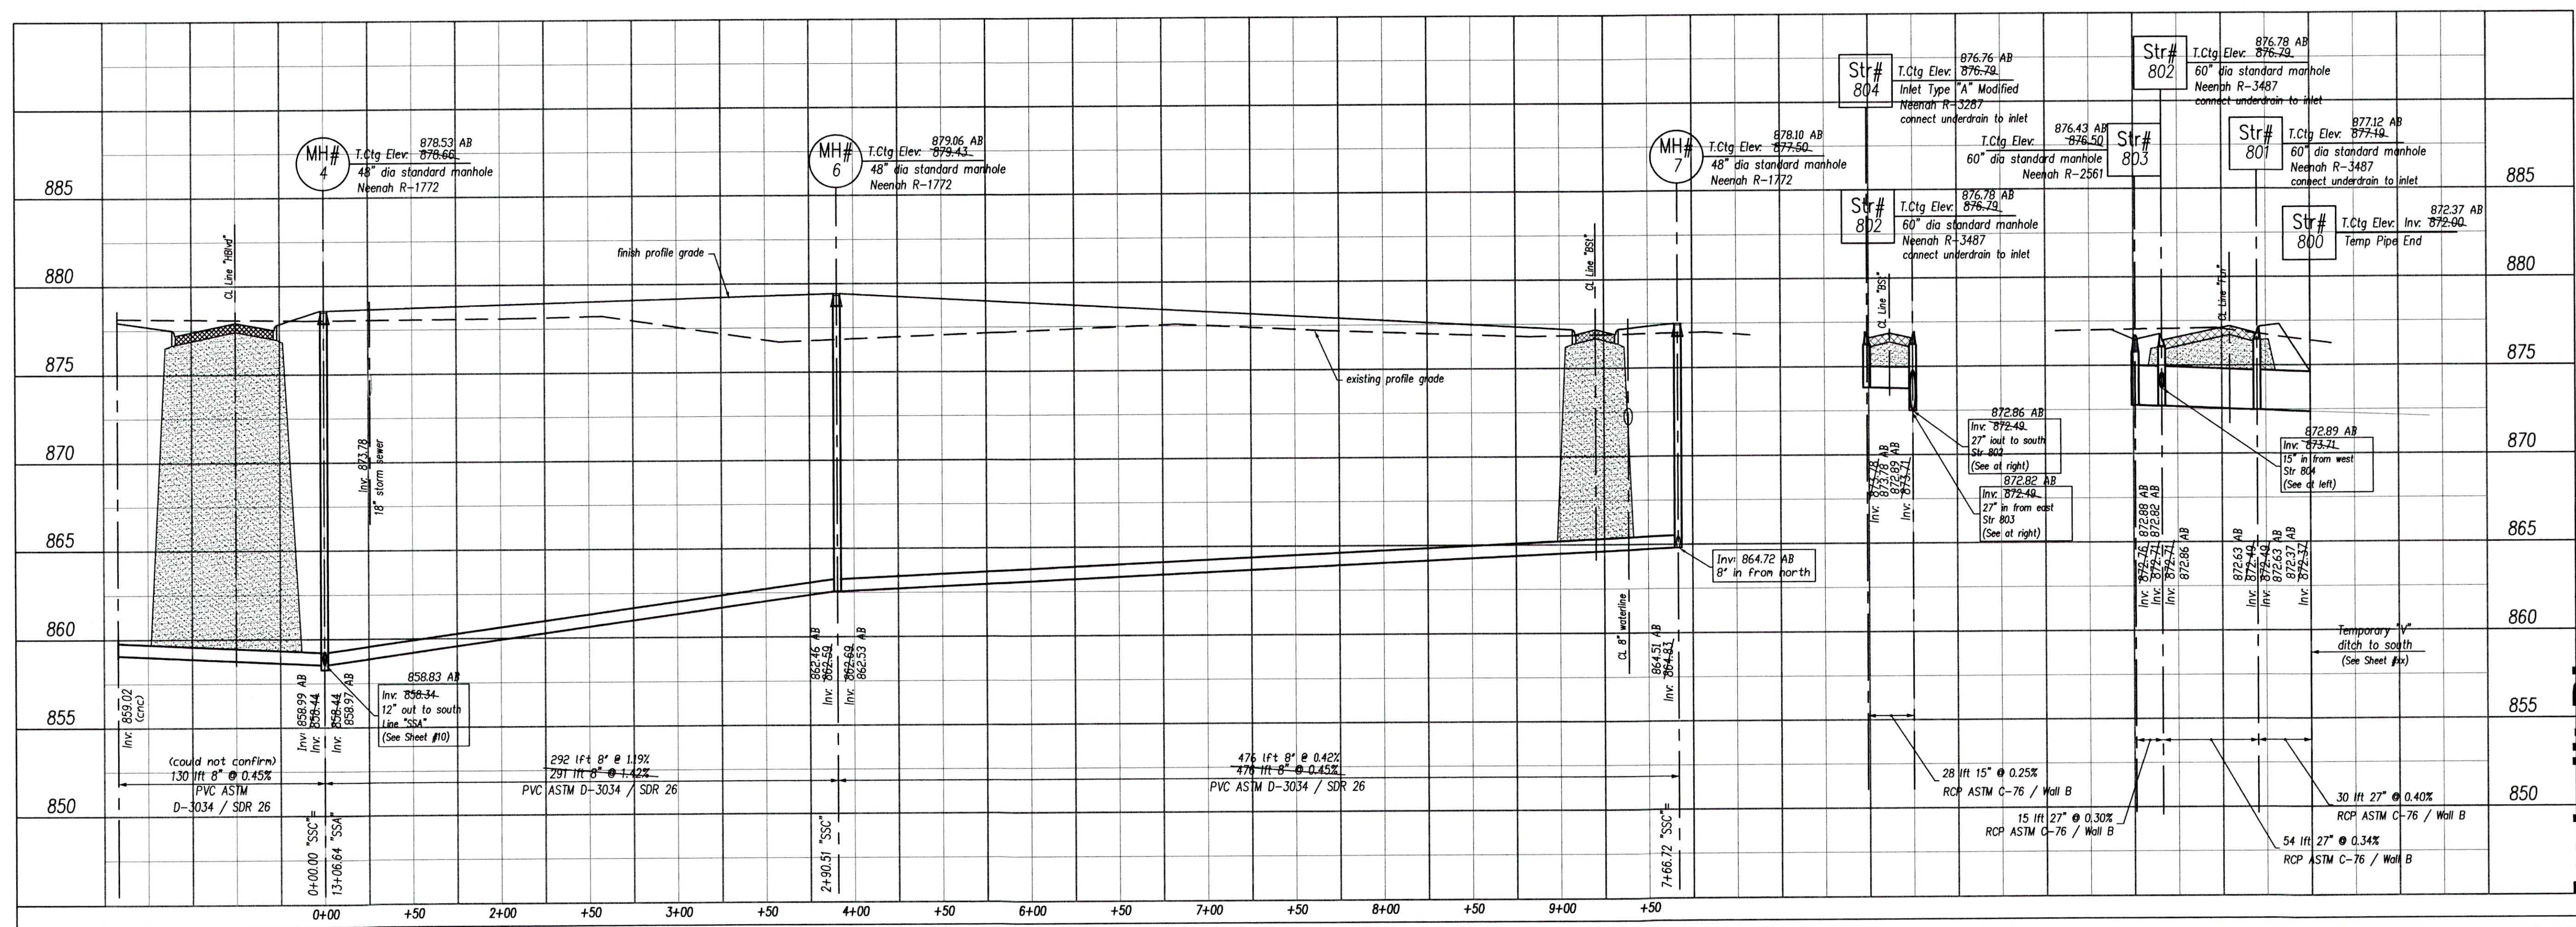

As-built Plans

North

Scale: 1"=50'

Pendleton Land Company, LLC
9449 Priority Way West Drive
Suite 120
Indianapolis, Indiana 46240
Phone: 765-778-4540 Fax: 765-778-3571
email: pendcal@earthlink.net

Huntzinger Farms
Phase I
Pendleton, Madison County, Indiana

Sanitary / Storm Plan-Profile
Line "SSC" / Structure Series 800

Revised per client direction on alignments.
Revised per client direction on alignments.
Date: 1.30.04

Revision: 3/14/04, 5/21/04, 6/29/04

Project: 13

Sheet No. 27