


Denotes approximate limits of granular backfill.
(See specifications for exact limits).

NOTES:

1. Maintain a minimum of 18" of vertical separation per IDEM requirements.
2. Unless otherwise noted all noted curb casting elevations are to top of curb.
3. The noted length for pipe segments with end sections include the concrete end section.

"SSA" denotes Sanitary Sewer Line "A"
"SSB" denotes Sanitary Sewer Line "B"
"SSC" denotes Sanitary Sewer Line "C"
"HBLvd" denotes Huntzinger Blvd
"FLN" denotes Fairfield Lane
"VERd" denotes Waters Edge Road
"CSDr" denotes Cold Springs Drive


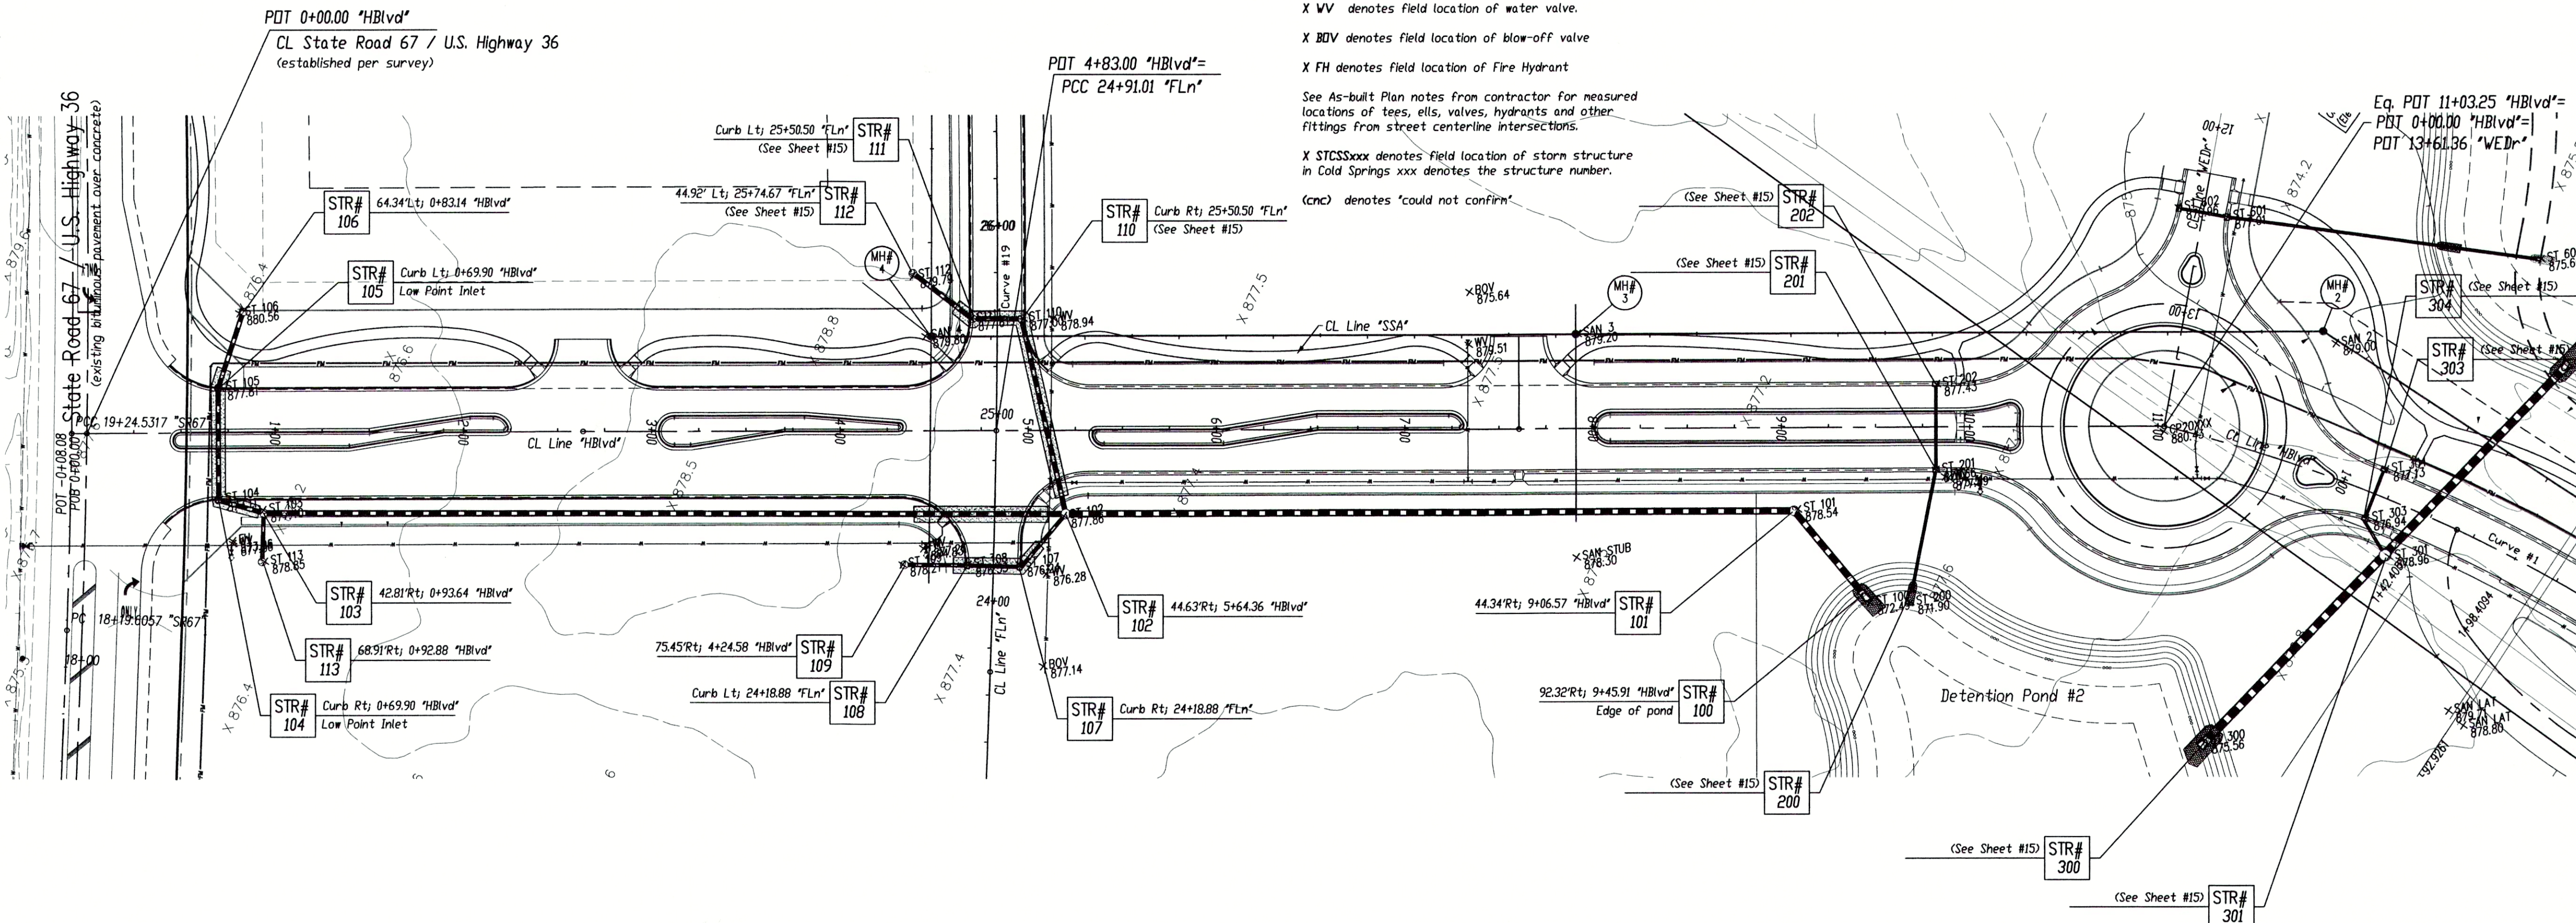


AS-BUILT NOTES:

- X SANLAT denotes field location of sanitary lateral markers
X SANMHCSXX denotes field location of a manhole in Cold Springs XX denotes the manhole number
As-built locations of the sanitary lateral tees are denoted as distances from the downstream manhole, in line with the next upstream manhole.
X WV denotes field location of water valve.
X BOV denotes field location of blow-off valve
X FH denotes field location of Fire Hydrant
See As-built Plan notes from contractor for measured locations of tees, ells, valves, hydrants and other fittings from street centerline intersections.
X STCSxxx denotes field location of storm structure in Cold Springs xxx denotes the structure number.
(cnc) denotes 'could not confirm'

Str #100-106

Str #113

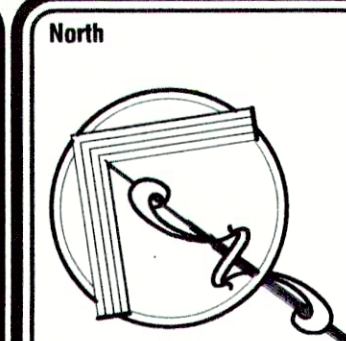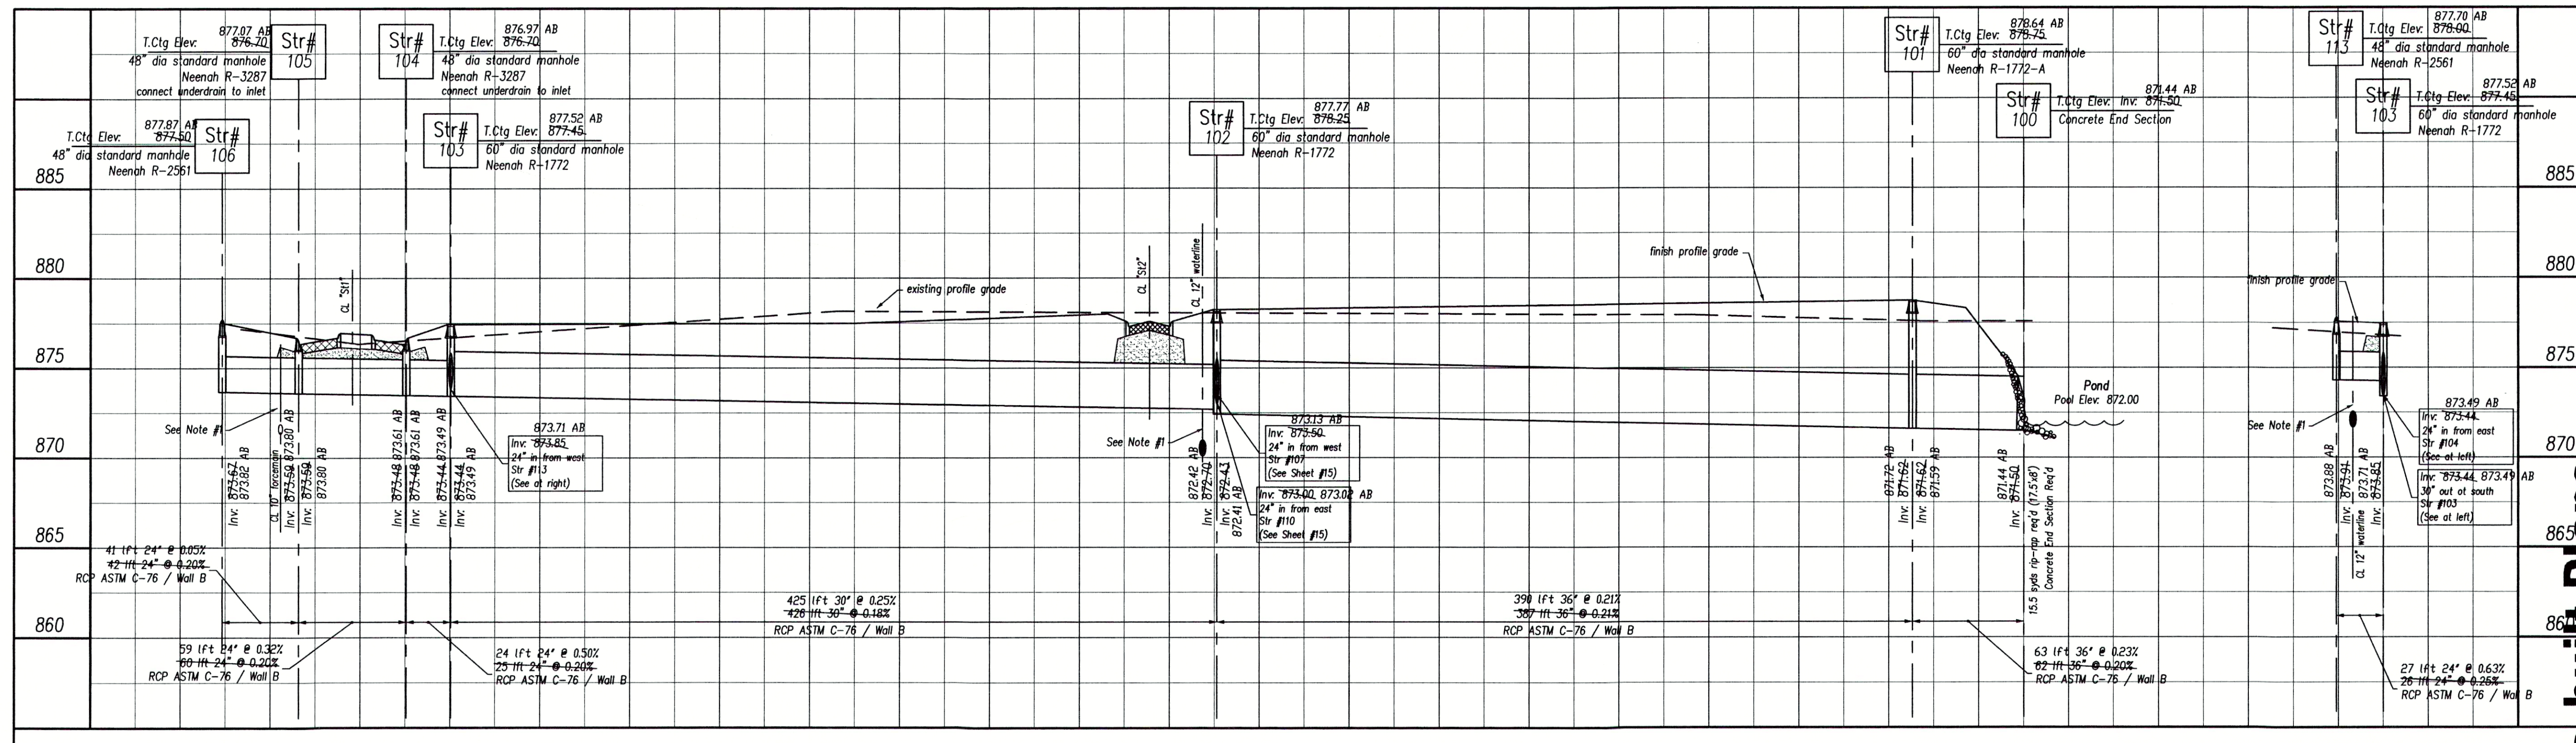

Scale: 1"=50'

Pendleton Land Company, LLC
9449 Priority Way, West Drive
Suite 120
Indianapolis, Indiana 46240
Phone: 317-776-4540 Fax: 317-776-3571
email: pendmail@pendirect.net

Huntzinger Farms
Phase I
Pendleton, Madison County, Indiana
Storm Sewer Plan-Profile
Storm Series 100

Date: 1.30.04

Revisions	Date
Revised per client direction on alignments.	3/4/04
Corrected str numbering	4/1/04
Adjusted inverts of Strs #103-106 for clearance per client.	4/13/04
Revised to add segment of Fairfield Road to plans per client.	6/29/04

Project: **Huntzinger Farms**
Phase I
Pendleton, Madison County, Indiana



Sheet No.

14
27 Sheets

As-built Plans