


Denotes approximate limits of granular backfill.  
(See specifications for exact limits).

# AS-BUILT NOTES:

- X SANLAT denotes field location of sanitary lateral markers
- X SANHCSXX denotes field location of a manhole in Cold Springs. XX denotes the manhole number.
- As-built locations of the sanitary lateral tees are denoted as distances from the downstream manhole, in line with the next upstream manhole.
- X WV denotes field location of water valve.
- X BOV denotes field location of blow-off valve.
- X FH denotes field location of Fire Hydrant.
- See As-built Plan notes from contractor for measured locations of tees, els, valves, hydrants and other fittings from street centerline intersections.
- (CNC) denotes "could not confirm"

## NOTES:

1. Maintain a minimum of 18" of vertical separation per IDEM requirements.
  2. Unless otherwise noted all noted curb casting elevations are to top of curb.
  3. The noted length for pipe segments with end sections include the concrete end section.
- \*SSA\* denotes Sanitary Sewer Line "A"  
 \*SSB\* denotes Sanitary Sewer Line "B"  
 \*SSC\* denotes Sanitary Sewer Line "C"  
 \*HBLvd\* denotes Huntzinger Blvd  
 \*FLn\* denotes Fairfield Lane  
 \*WERd\* denotes Waters Edge Road  
 \*CSDr\* denotes Cold Springs Drive

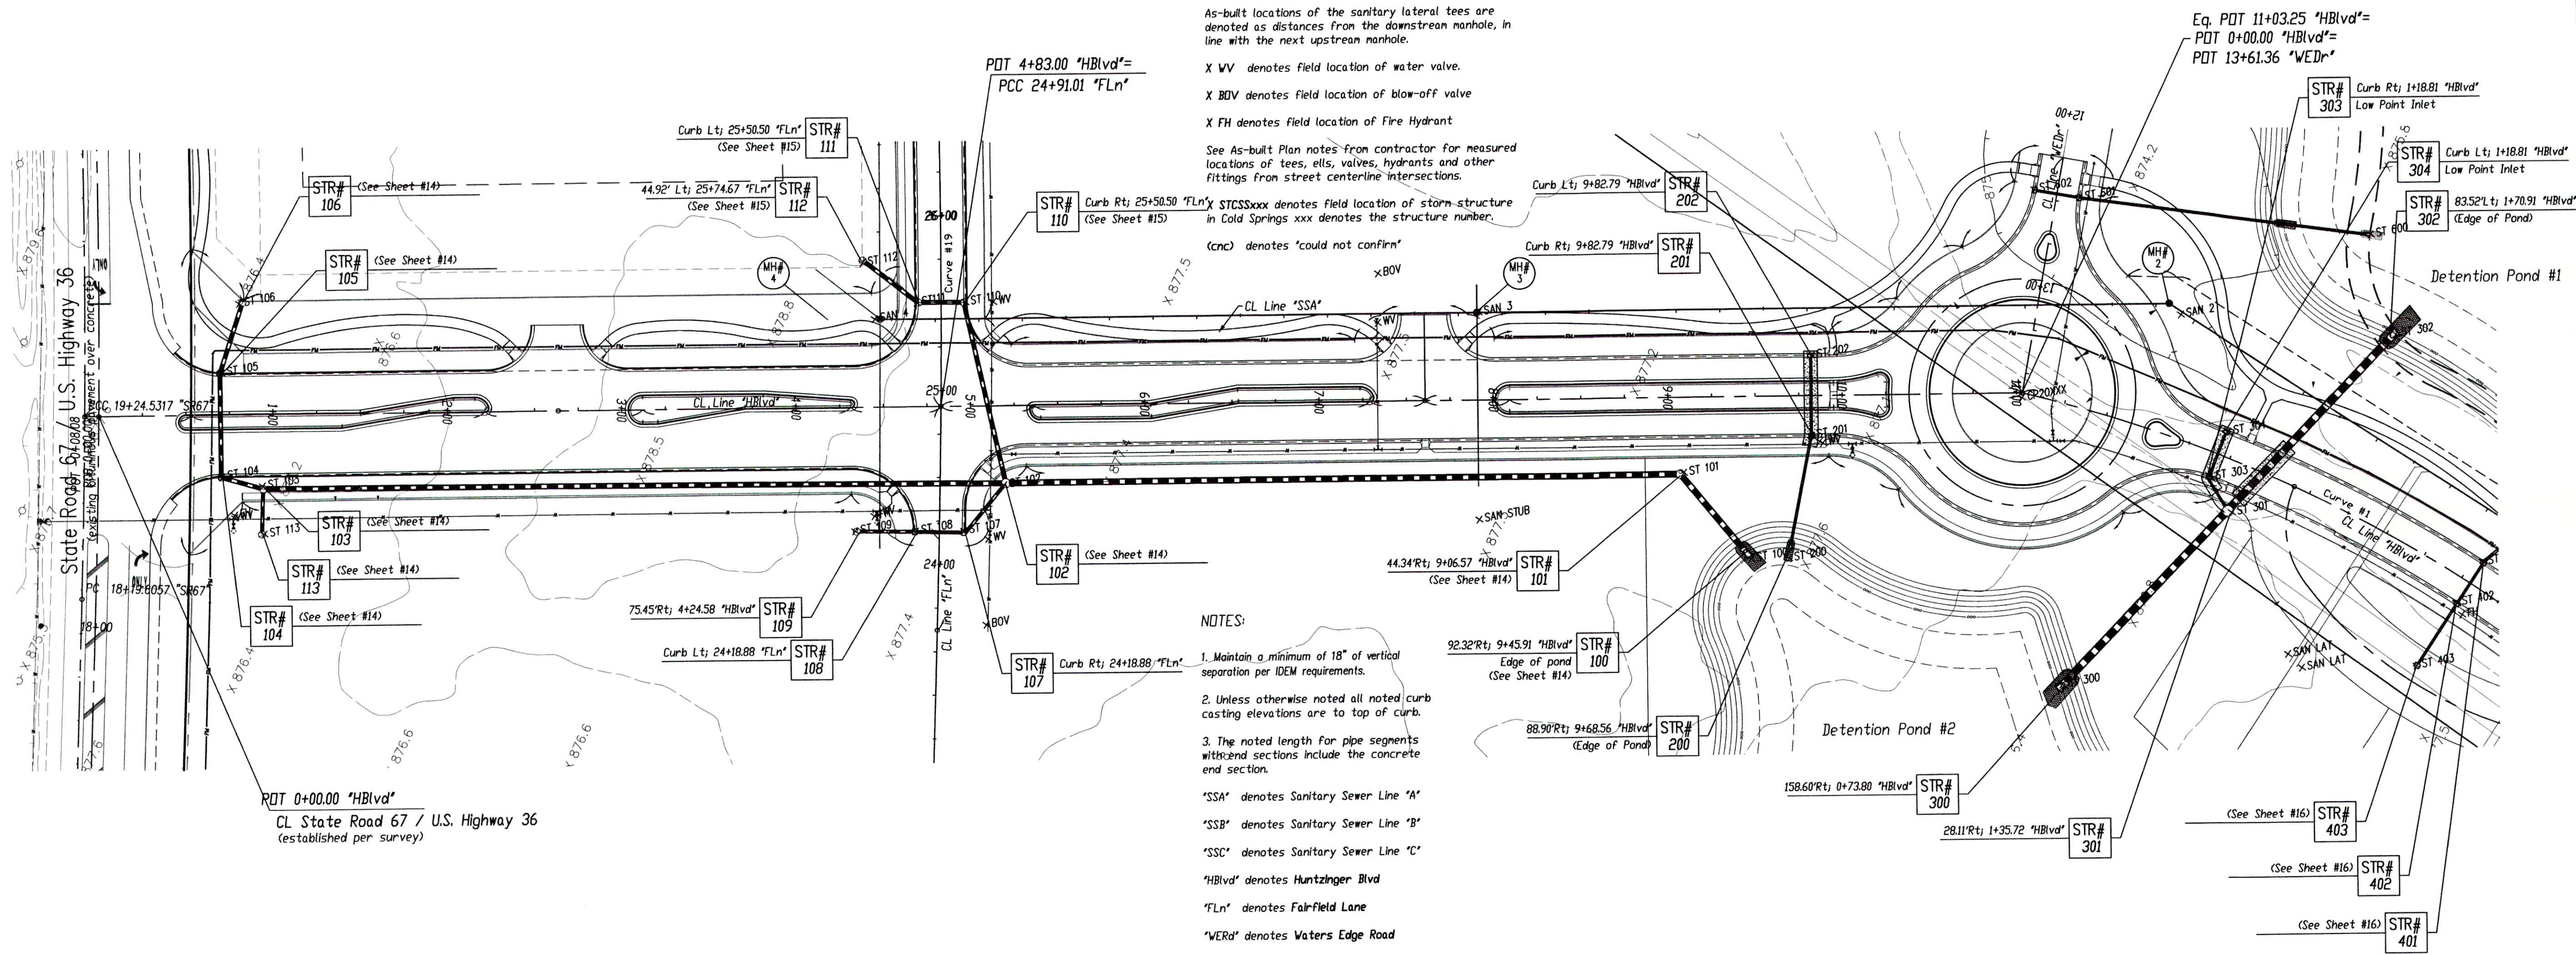


Str #107-109

Str #110-112

Str Series 200

Str #300-302

Str #303-304

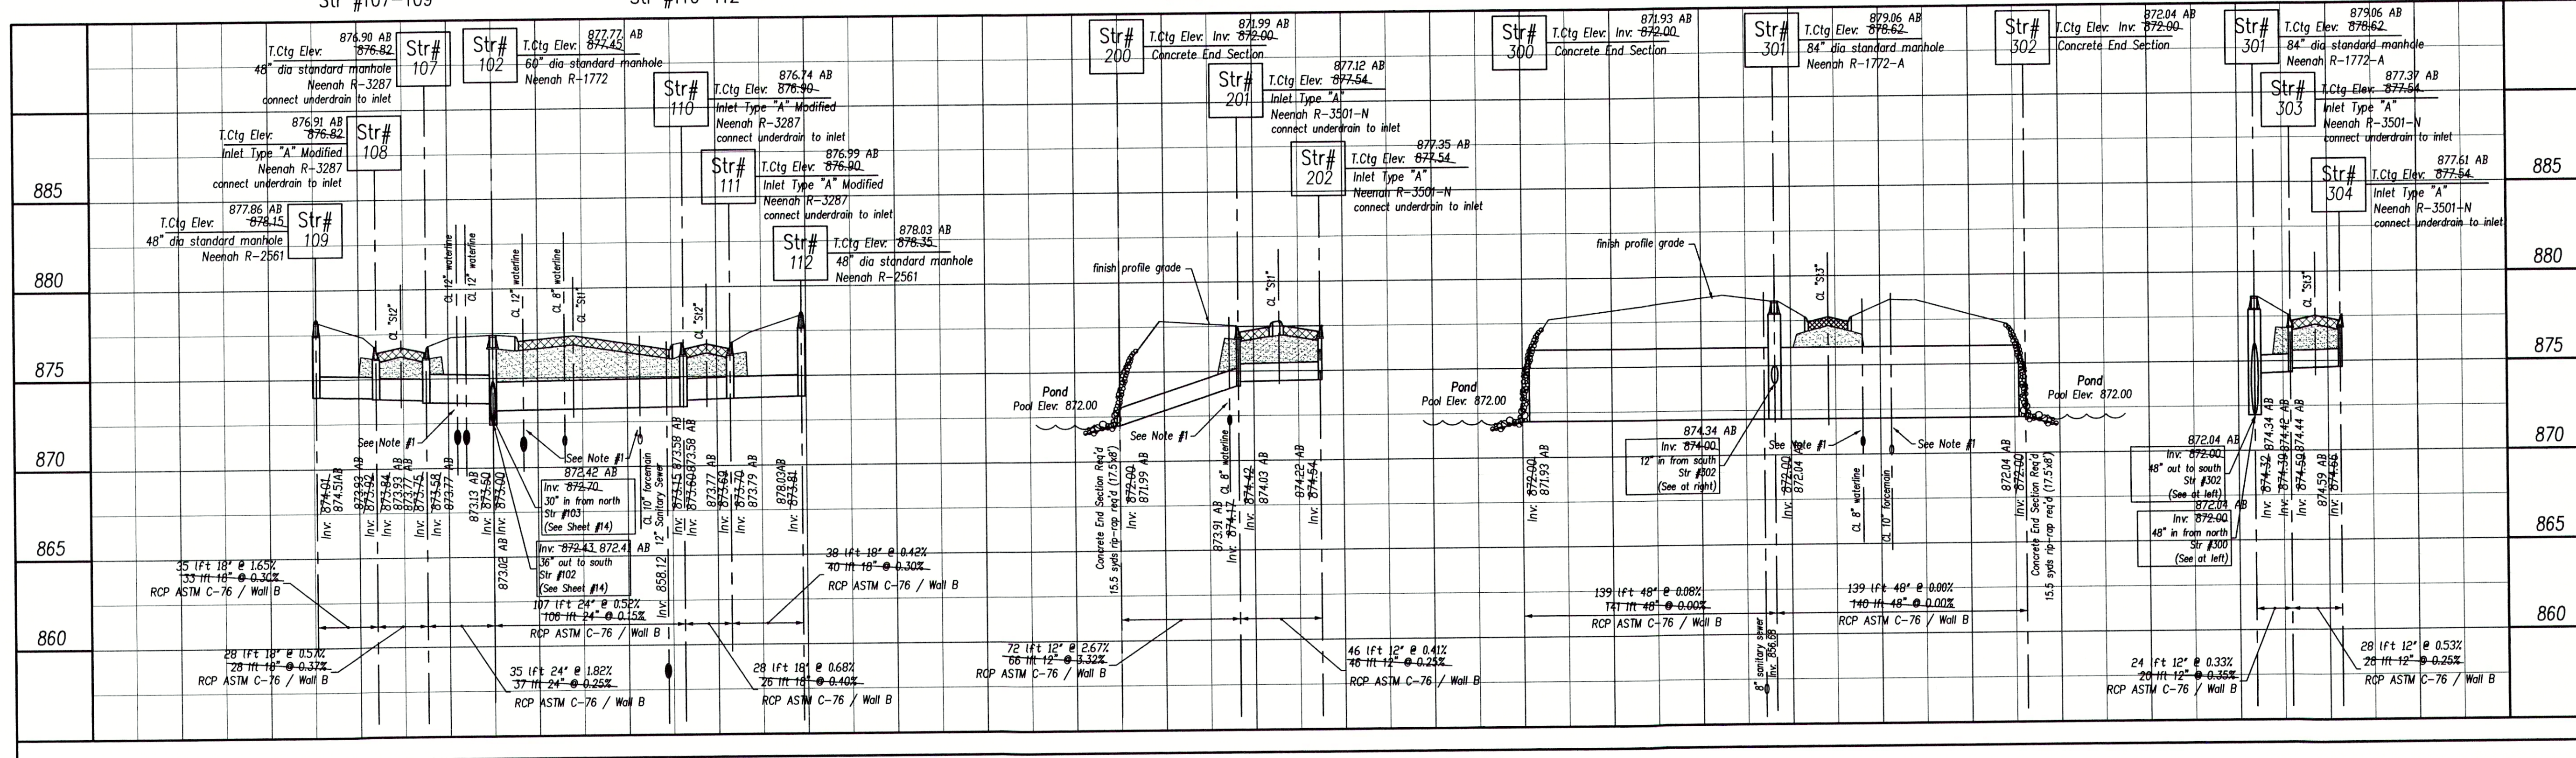

## As-built Plans

North

Scale: 1"=50'

**Pendleton Land Consulting**  
 Pendleton, Indiana 46064  
 P.O. Box 67  
 Phone: 765-776-4940 Fax: 765-776-5871  
 email: pend@pendconsulting.com

**Pendleton Land Company, LLC**  
 9449 Priority Way, West Drive  
 Suite 120  
 Indianapolis, Indiana 46240  
 Tel: 317.05.2083 Fax: 317.05.2089

Date: 1.30.04

Revision:  
 Revised per client direction on alignments.  
 Corrected str numbering  
 Revised to add segment of Fairfield Road to plans per client.

Date:  
 3/4/04  
 4/1/04  
 6/25/04

**Huntzinger Farms Phase I**  
 Pendleton, Madison County, Indiana

**Storm Sewer Plan-Profile**  
 Storm Series 100, 200, 300

Project: Sheet Title

SEAL

NO. 5041

STATE OF INDIANA

LAND SURVEYOR

EXPIRATION DATE: 12/31/2004

Sheet No.

**15**

27 Sheets