
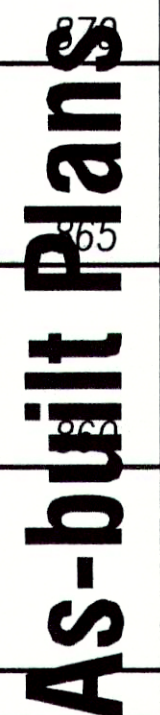


"SSA" denotes Sanitary Sewer Line "A"
 "SSB" denotes Sanitary Sewer Line "B"
 "SSC" denotes Sanitary Sewer Line "C"
 "HBlvd" denotes Huntzinger Blvd
 "FLn" denotes Fairfield Lane
 "WERd" denotes Waters Edge Road
 "CSDr" denotes Cold Springs Drive

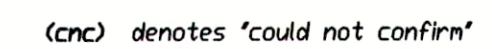

•

Sheet No. **16**

of **27** Sheets