


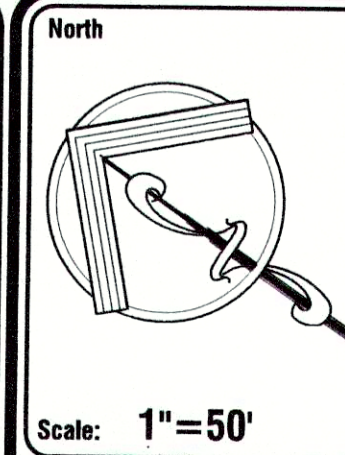

**Pendleton Land
Company, LLC**
9449 Priority Way West Drive
Suite 120
Indianapolis, Indiana 46240
Tel: 317.705.2063
Fax: 317.705.2069

Date	Revision
4/4/04	Revised per client direction on alignments.
2/29/04	Revised to add segment of Fairfield Road to plans per client.

--	--

Sheet No.

17

27 Sheets

(cnc) denotes 'could not confirm'

'SSA' denotes Sanitary Sewer Line 'A'
'SSB' denotes Sanitary Sewer Line 'B'
'SSC' denotes Sanitary Sewer Line 'C'
'HBlvd' denotes Huntzinger Blvd
'FLn' denotes Fairfield Lane
'WERd' denotes Waters Edge Road
'CSDr' denotes Cold Springs Drive

