

Denotes approximate limits of granular backfill.
(See specifications for exact limits).

NOTES:

- All radii are measured to back of curb.
- See Sheets #9 & 10 for details of the street and intersections.

SSA denotes Sanitary Sewer Line "A"

SSB denotes Sanitary Sewer Line "B"


SSC denotes Sanitary Sewer Line "C"

HBvd denotes Huntzinger Blvd

FLn denotes Fairfield Lane

VERd denotes Waters Edge Road

CSDr denotes Cold Springs Drive

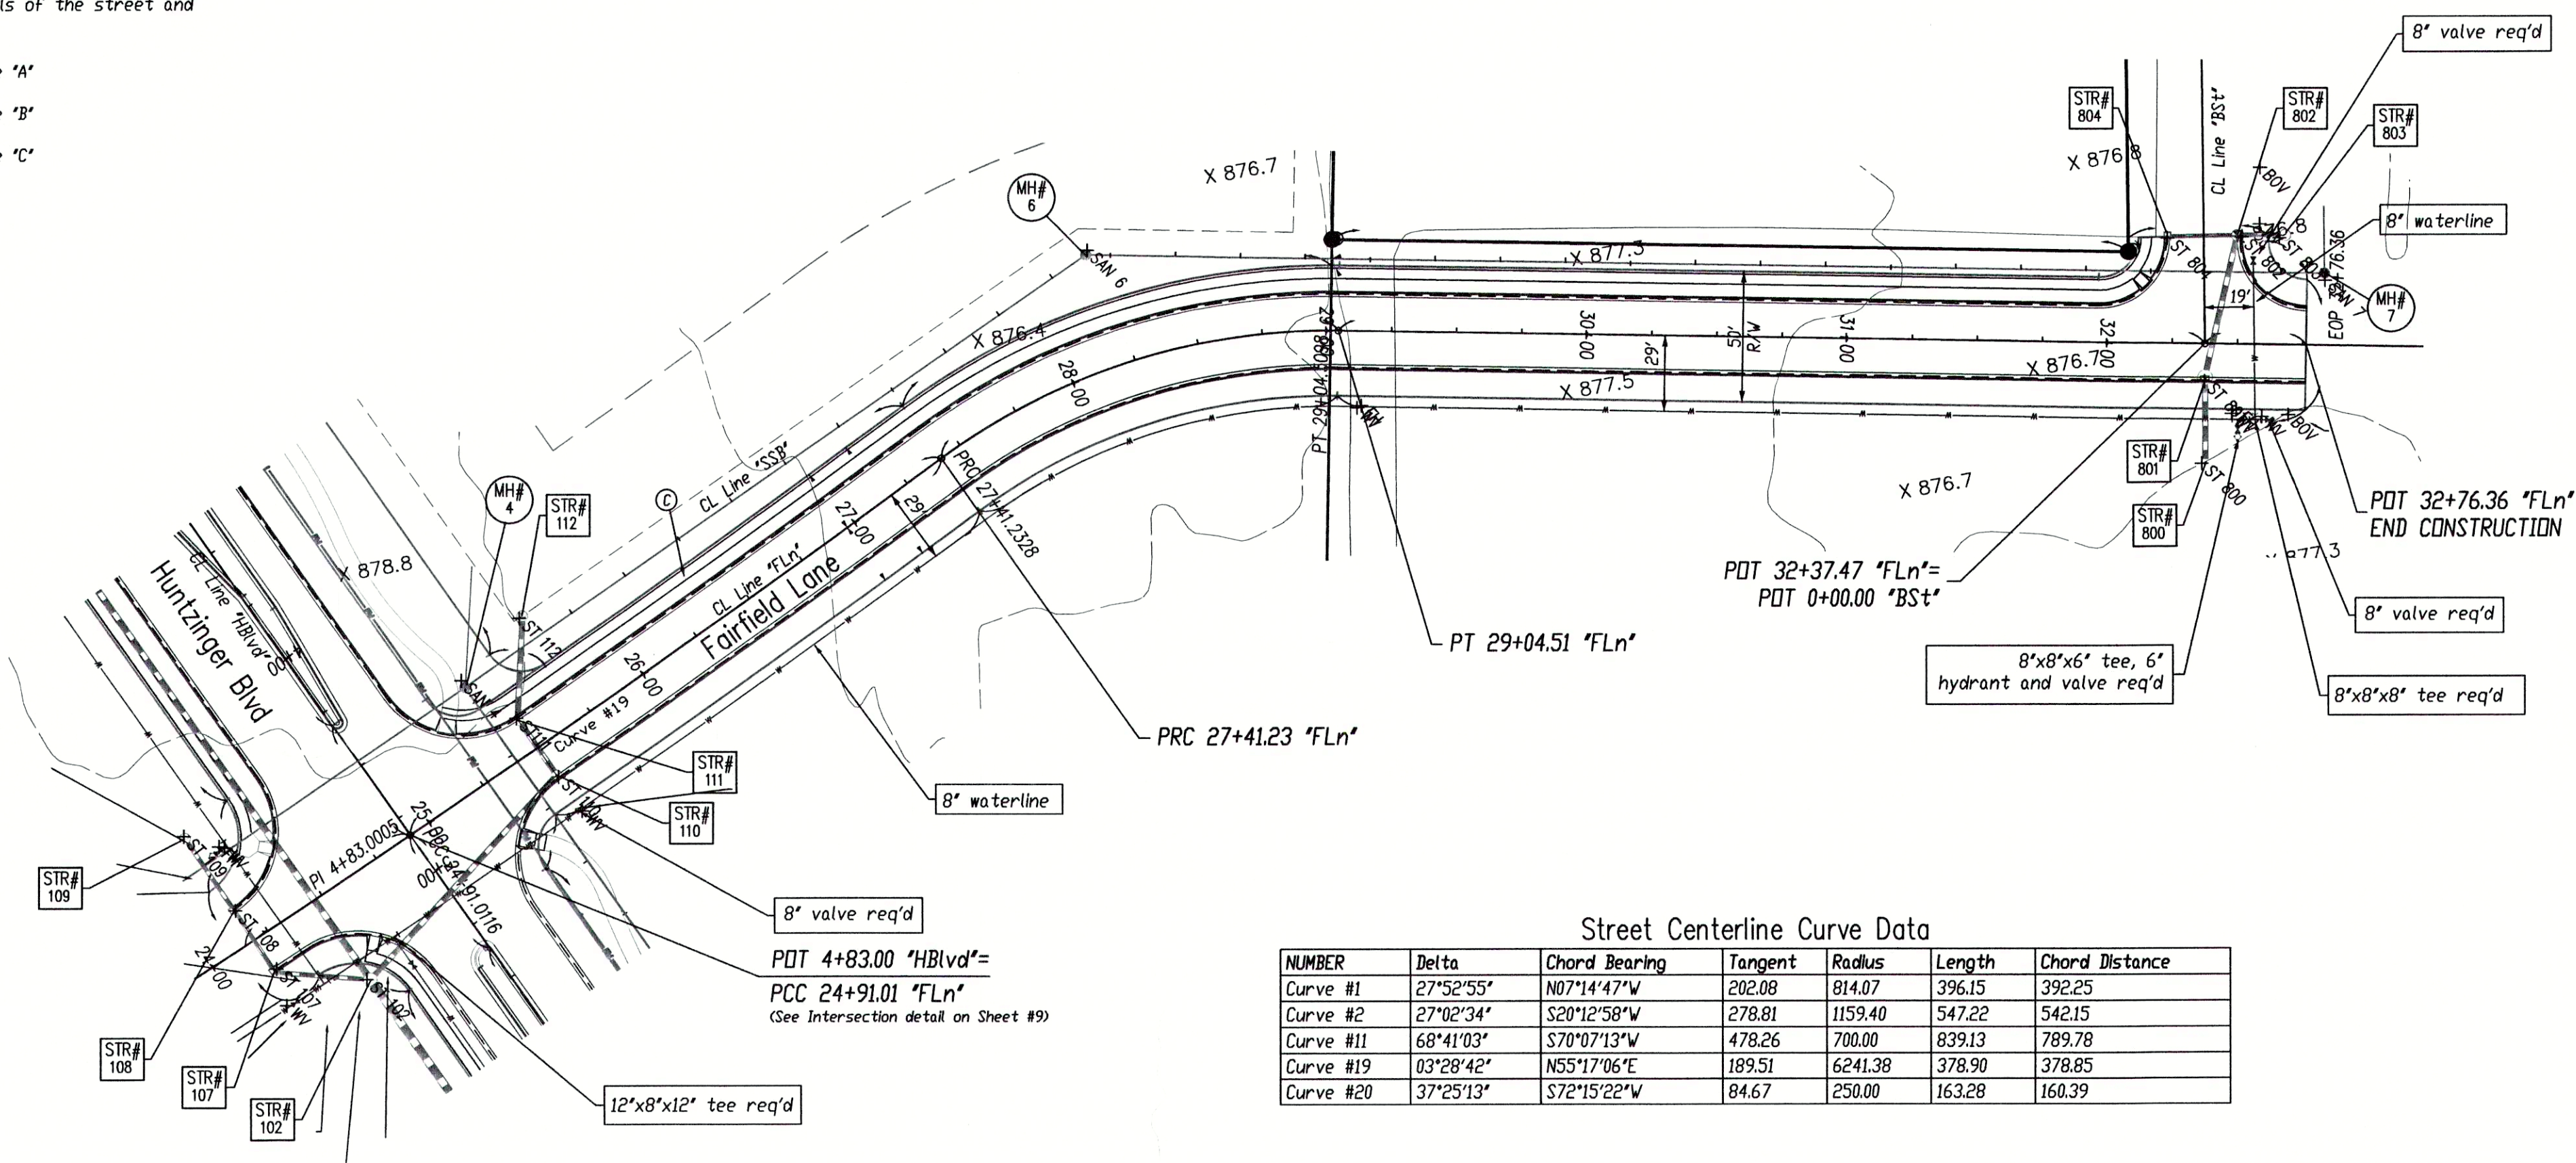


Street Centerline Curve Data						
NUMBER	Delta	Chord Bearing	Tangent	Radius	Length	Chord Distance
Curve #1	27°52'55"	N07°14'47"W	202.08	814.07	396.15	392.25
Curve #2	27°02'34"	S20°12'58"W	278.81	1159.40	547.22	542.15
Curve #11	68°41'03"	S70°07'13"W	478.26	700.00	839.13	789.78
Curve #19	03°28'42"	N55°17'06"E	189.51	6241.38	378.90	378.85
Curve #20	37°25'13"	S72°15'22"W	84.67	250.00	163.28	160.39

PER INDIANA STATE LAW IS-69-1991, IT IS AGAINST THE LAW TO EXCAVATE WITHOUT NOTIFYING THE UNDERGROUND LOCATION SERVICE TWO (2) WORKING DAYS BEFORE COMMENCING WORK.

WITHIN INDIANA: 1-800-362-5544
FROM OUTSIDE INDIANA: 1-800-428-5200

ELECTRIC: ...RED
GAS-OIL: ...YELLOW
COMMUNICATIONS: ...ORANGE
WATER: ...BLUE
SEWER: ...GREEN
UNRECORDED EXCAVATION: ...WHITE

THE INFORMATION NEEDED WHEN CALLING INDIANA UNDERGROUND PLANT PROTECTION SERVICES, INC. IS AS FOLLOWS:
COUNTY AND TOWNSHIP
STREET ADDRESS
TYPE OF WORK
EXTENT OF WORK
NAME OF CALLER AND TITLE
TELEPHONE NUMBER
BEST TIME TO CALL
START DATE AND START TIME
CONTRACTOR NAME AND ADDRESS

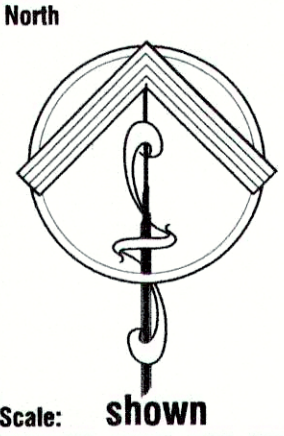

Pendleton Land Consulting
P.O. Box 67 Pendleton, Indiana 46064
Phone: 765-778-4540 Fax: 765-778-3571
email: pendlat@direct.net

Pendleton Land Company, LLC
9449 Priority Way West Drive
Suite 120
Indianapolis, Indiana 46240
Tel: 317.702.2863
Fax: 317.702.2865

AS-BUILT NOTES:

X SANLAT denotes field location of sanitary lateral markers

X SANHCSXX denotes field location of a manhole in Cold Springs XX denotes the manhole number

As-built locations of the sanitary lateral tees are denoted as distances from the downstream manhole, in line with the next upstream manhole.

X WV denotes field location of water valve.

X BOV denotes field location of blow-off valve

X FH denotes field location of Fire Hydrant

See As-built Plan notes from contractor for measured locations of tees, ells, valves, hydrants and other fittings from street centerline intersections.

X STCSSxxx denotes field location of storm structure in Cold Springs xxx denotes the structure number.

(cnc) denotes "could not confirm"

Date 6.29.04

Revision

Date

Huntzinger Farms
Phase I
Pendleton, Madison County, Indiana

Waterline Plan
Line "FLn" Fairfield Lane

Sheet No.

18

27 Sheets

As-built Plans