


PLAN
 SURVEYED
 NOTE BOOK GRADES CHECKED
 NO. 1
 STRUCTURE NOTING CH-10

PROFILE
 SURVEYED
 NOTE BOOK GRADES CHECKED
 NO. 1
 STRUCTURE NOTING CH-10



RECORD DRAWING

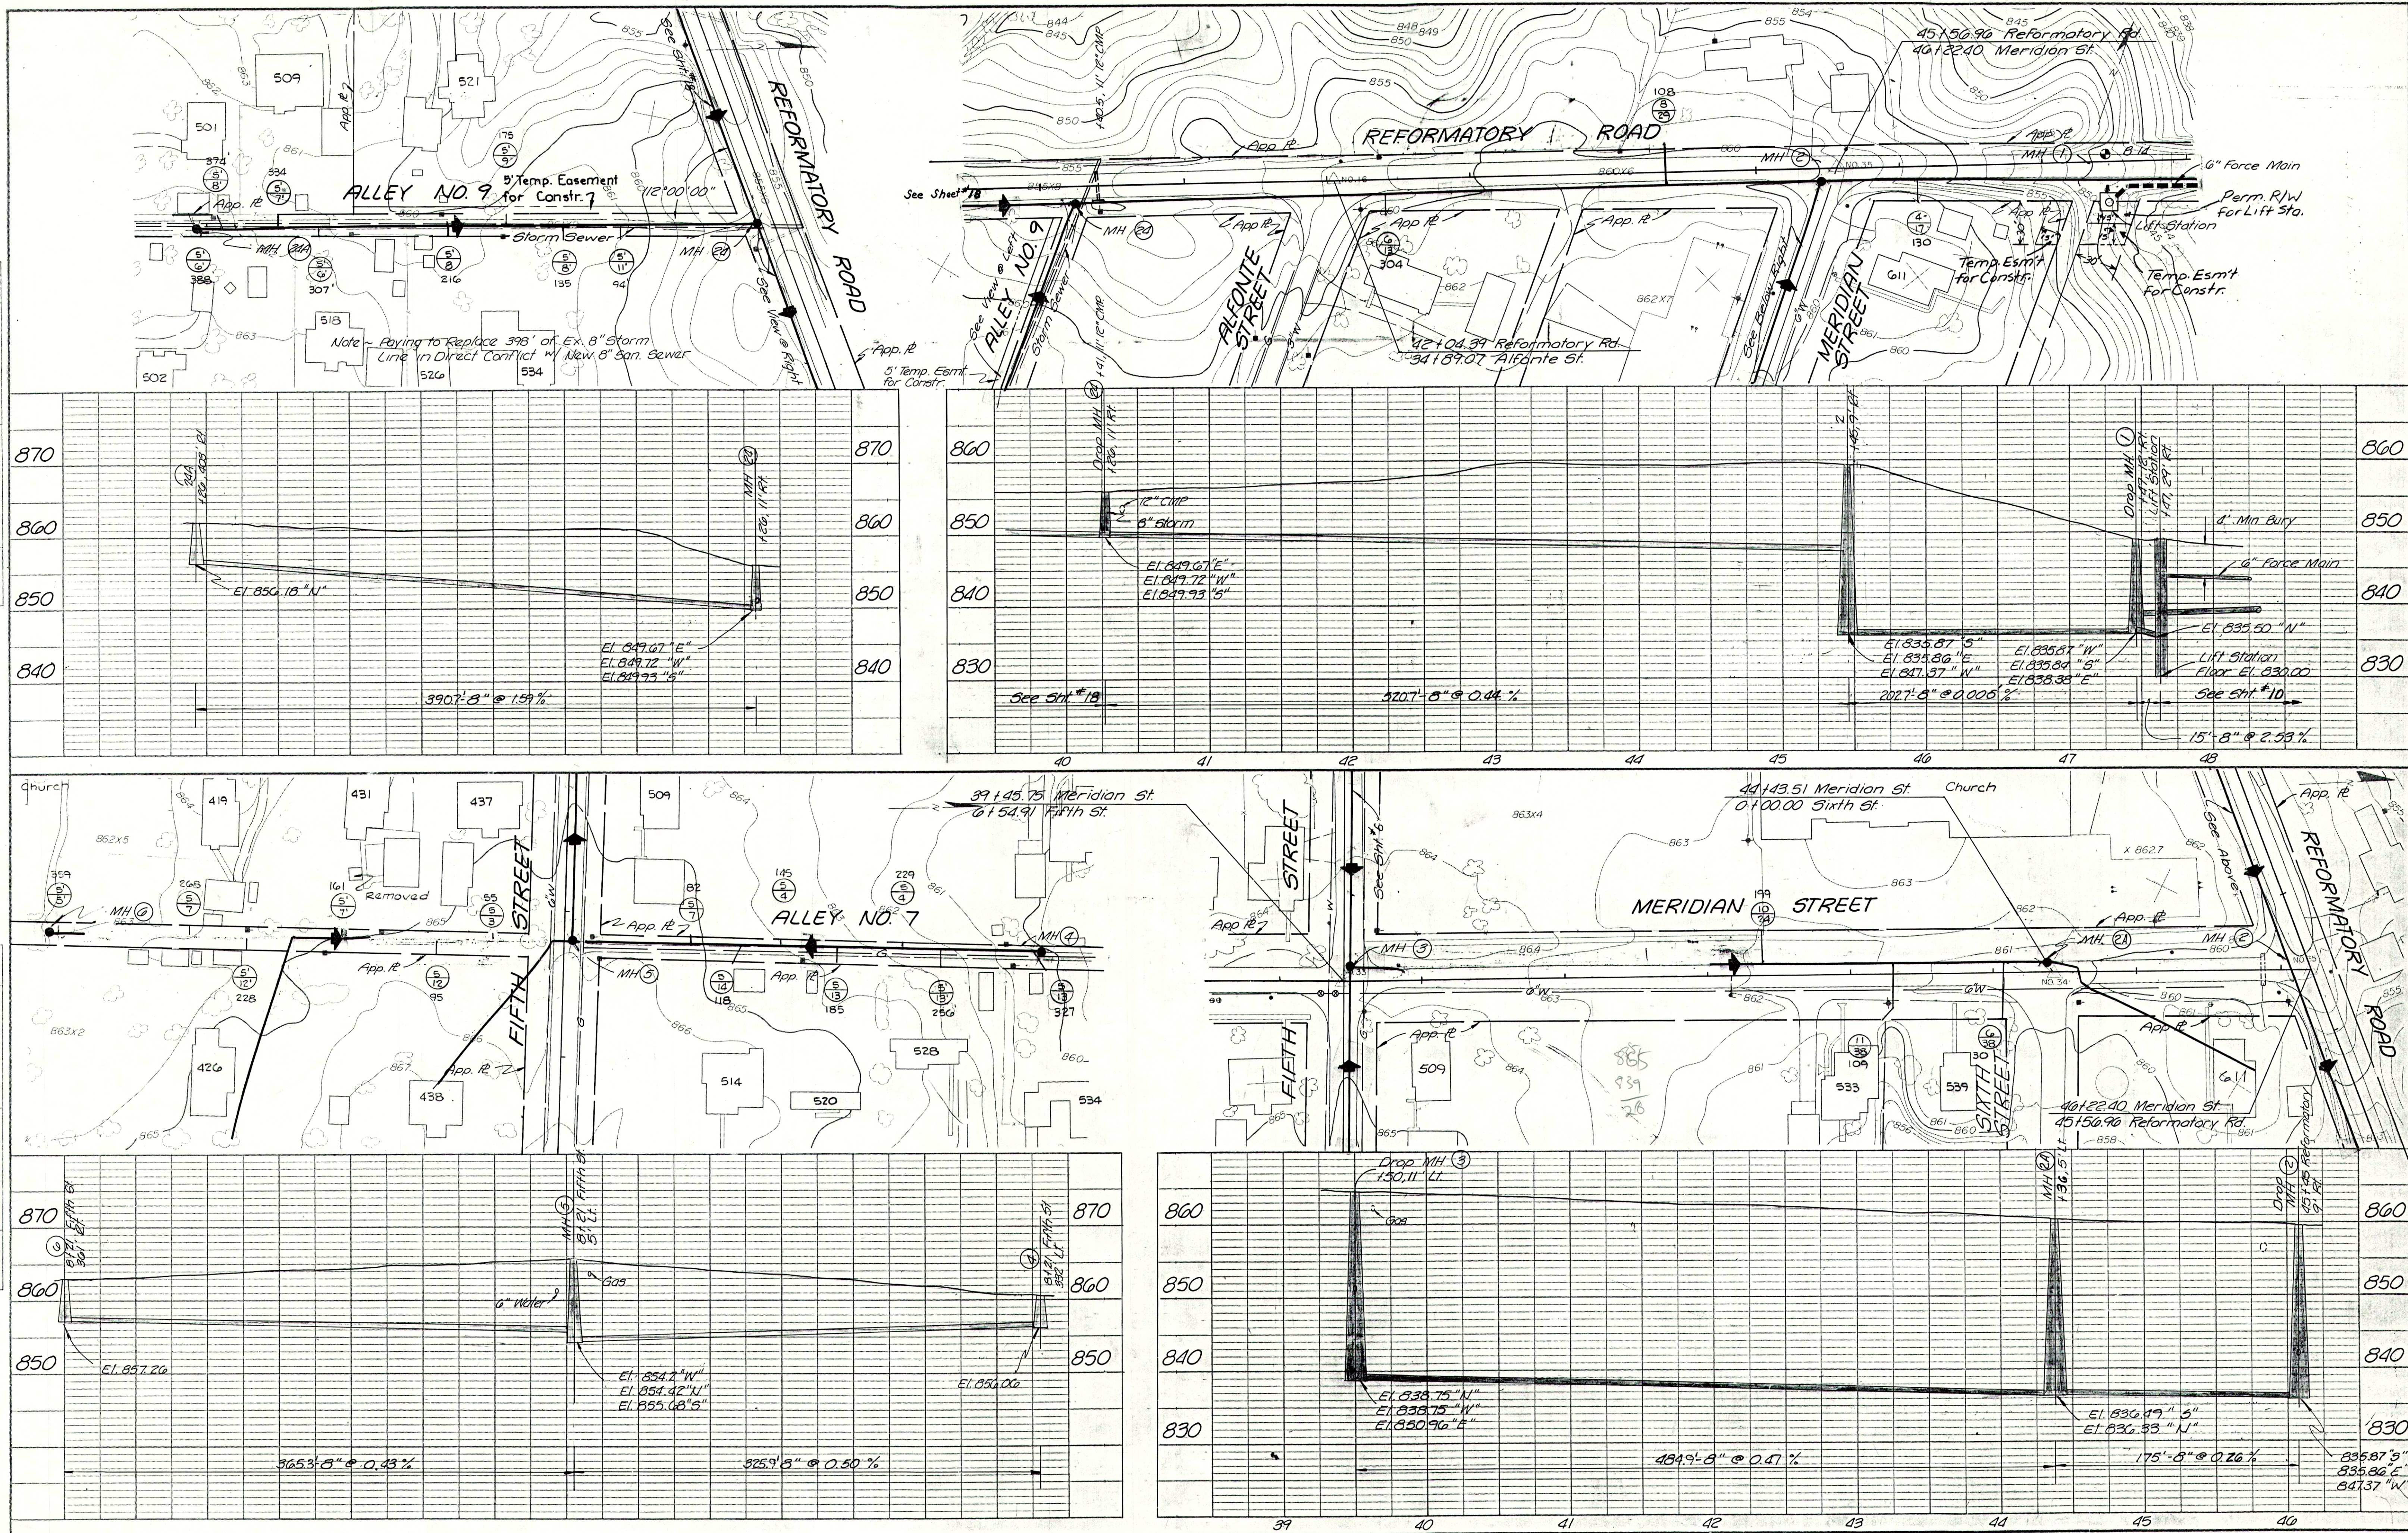

REFORMATORY RD. ALLEY #9
 ALLEY #7 MERIDIAN ST.
 FALL CREEK R.W.D. PLAN & PROFILE SHEET
 HORIZ. 1"=50' BEAM, LONGEST & NEFF, INC.
 VERT. 1"=10' CONSULTING ENGINEERS
 INDIANAPOLIS, INDIANA 4