


PLAN	DATE	BY
	SURVEYED	
	NOTED	
	NO.	

PROFILE	DATE	BY
	SURVEYED	
	NOTED	
	NO.	



RECORD DRAWING

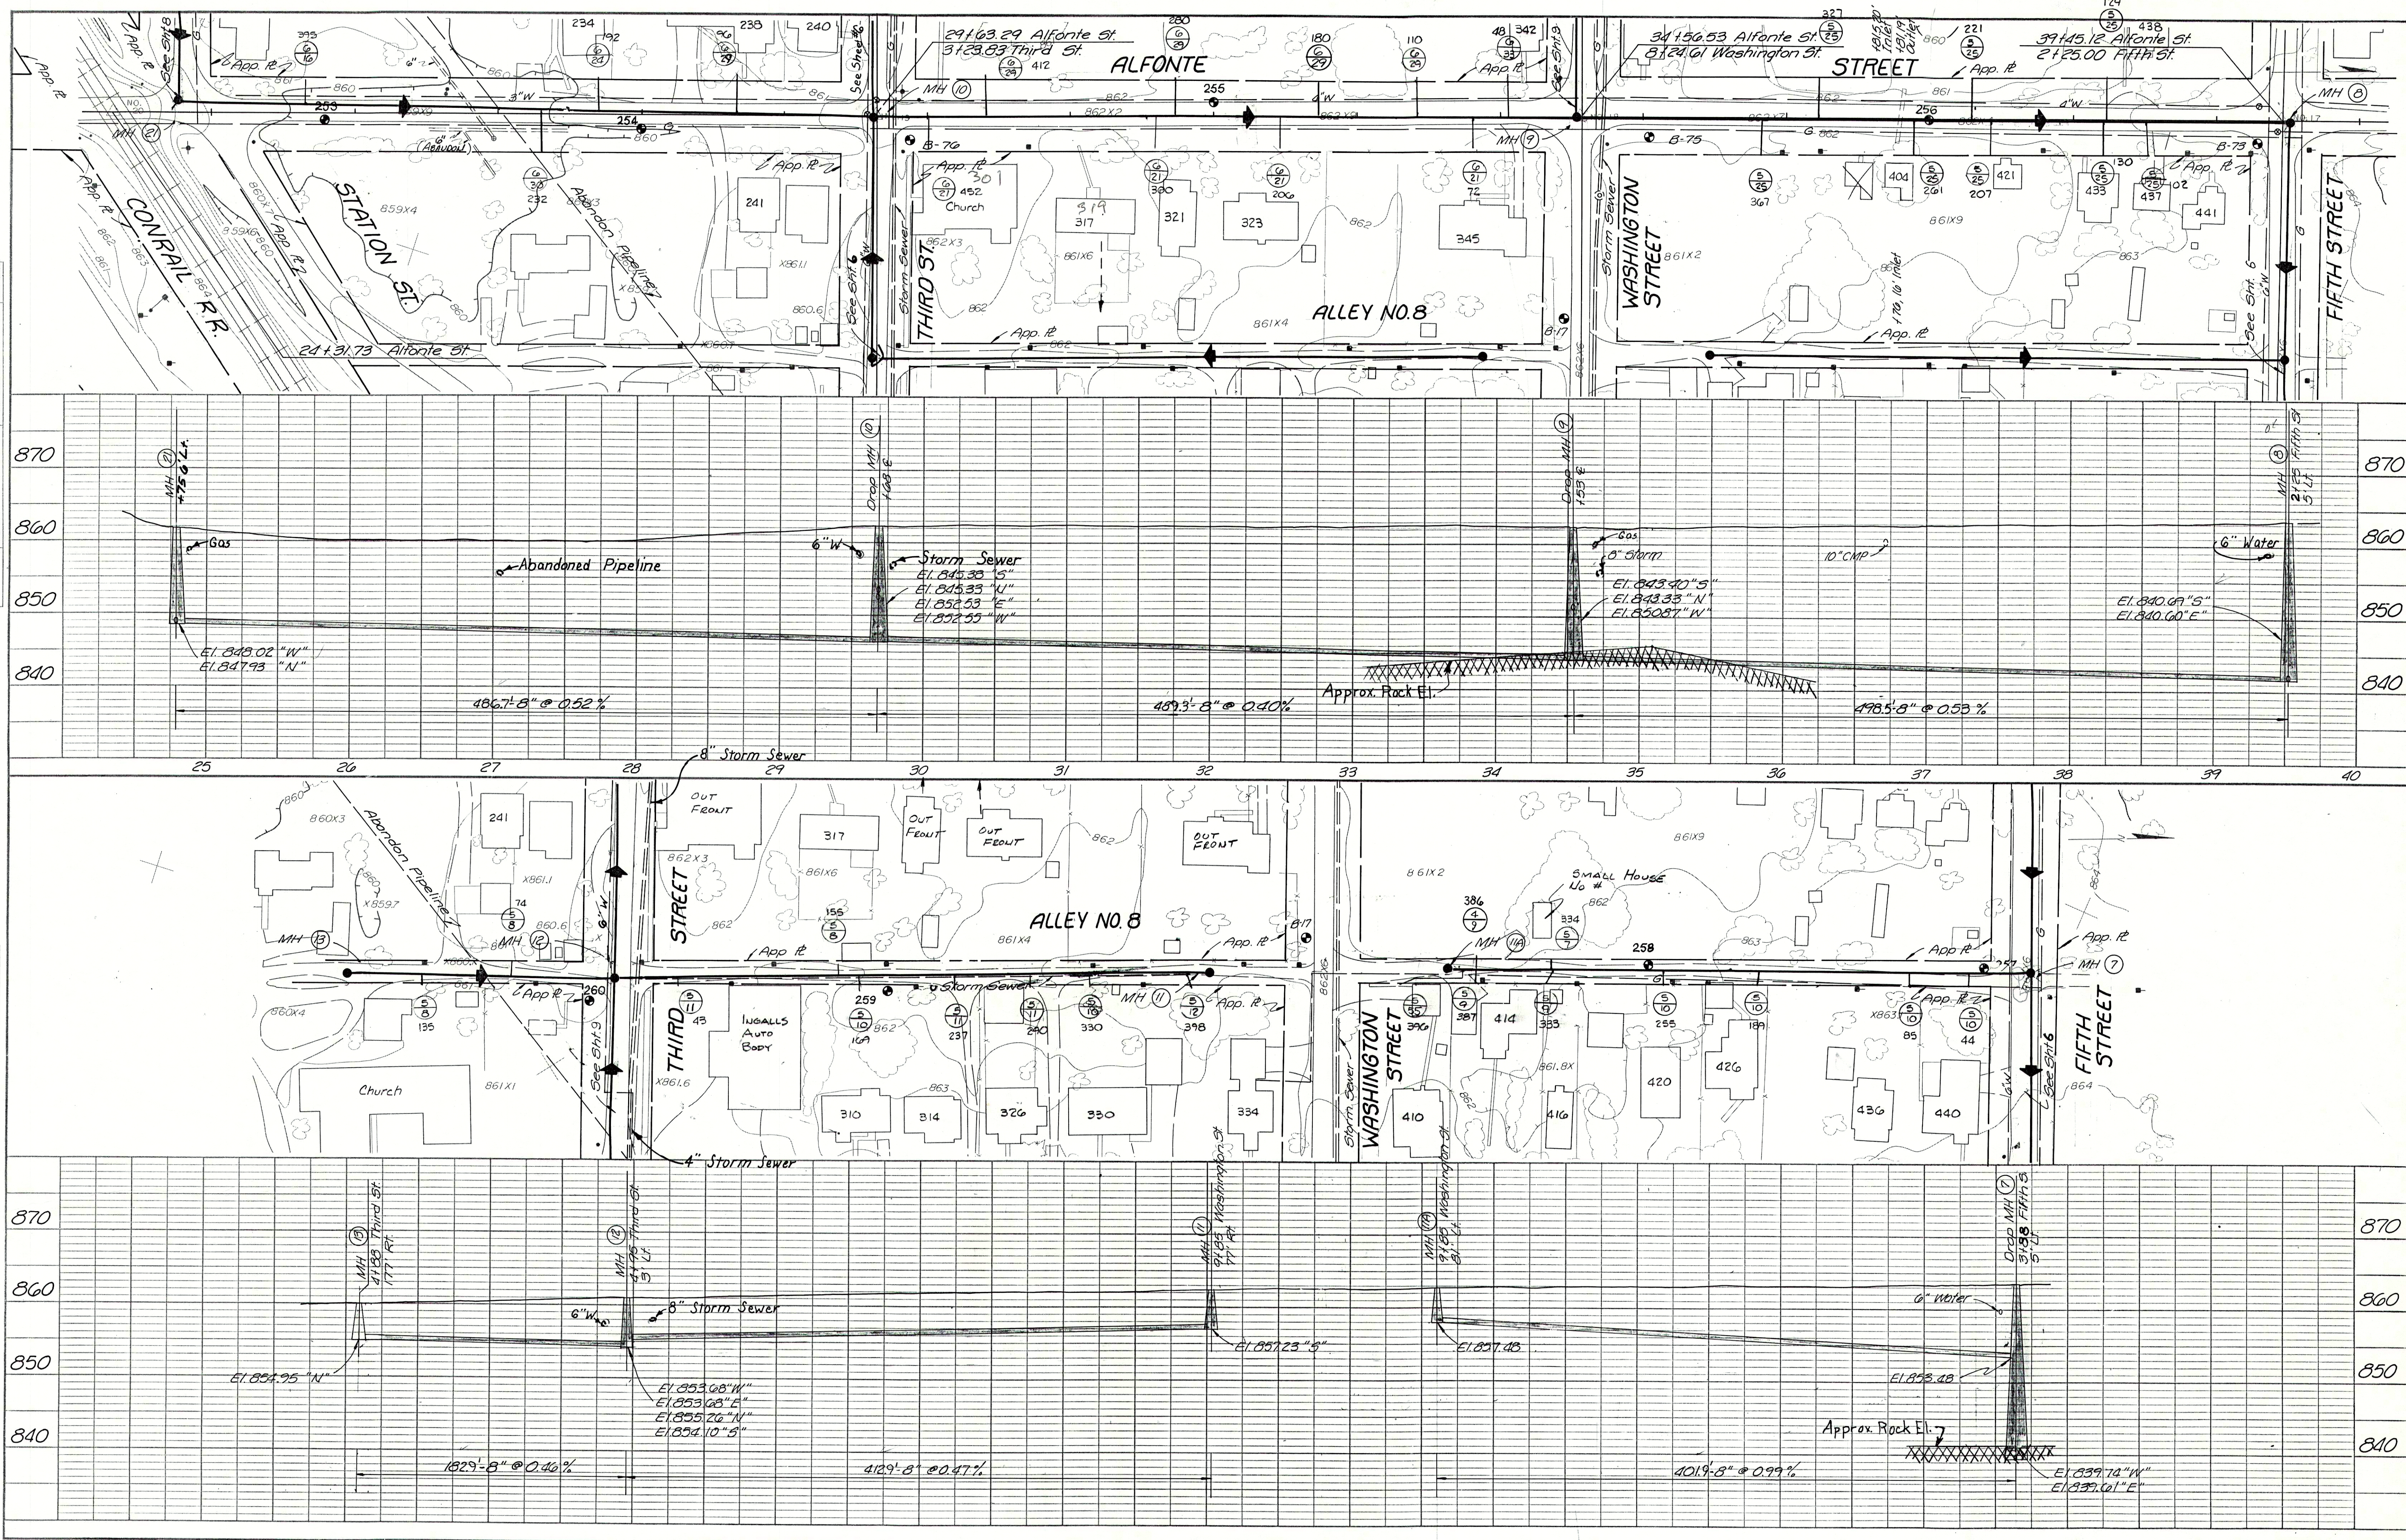

ALFONTE ST. ALLEY #8

FALL CREEK R.W.D. PLAN & PROFILE SHEET
 HORIZ. 1"=50'
 VERT. 1"=10'

BEAM, LONGEST & NEFF, INC.
 CONSULTING ENGINEERS
 INDIANAPOLIS, INDIANA

5