

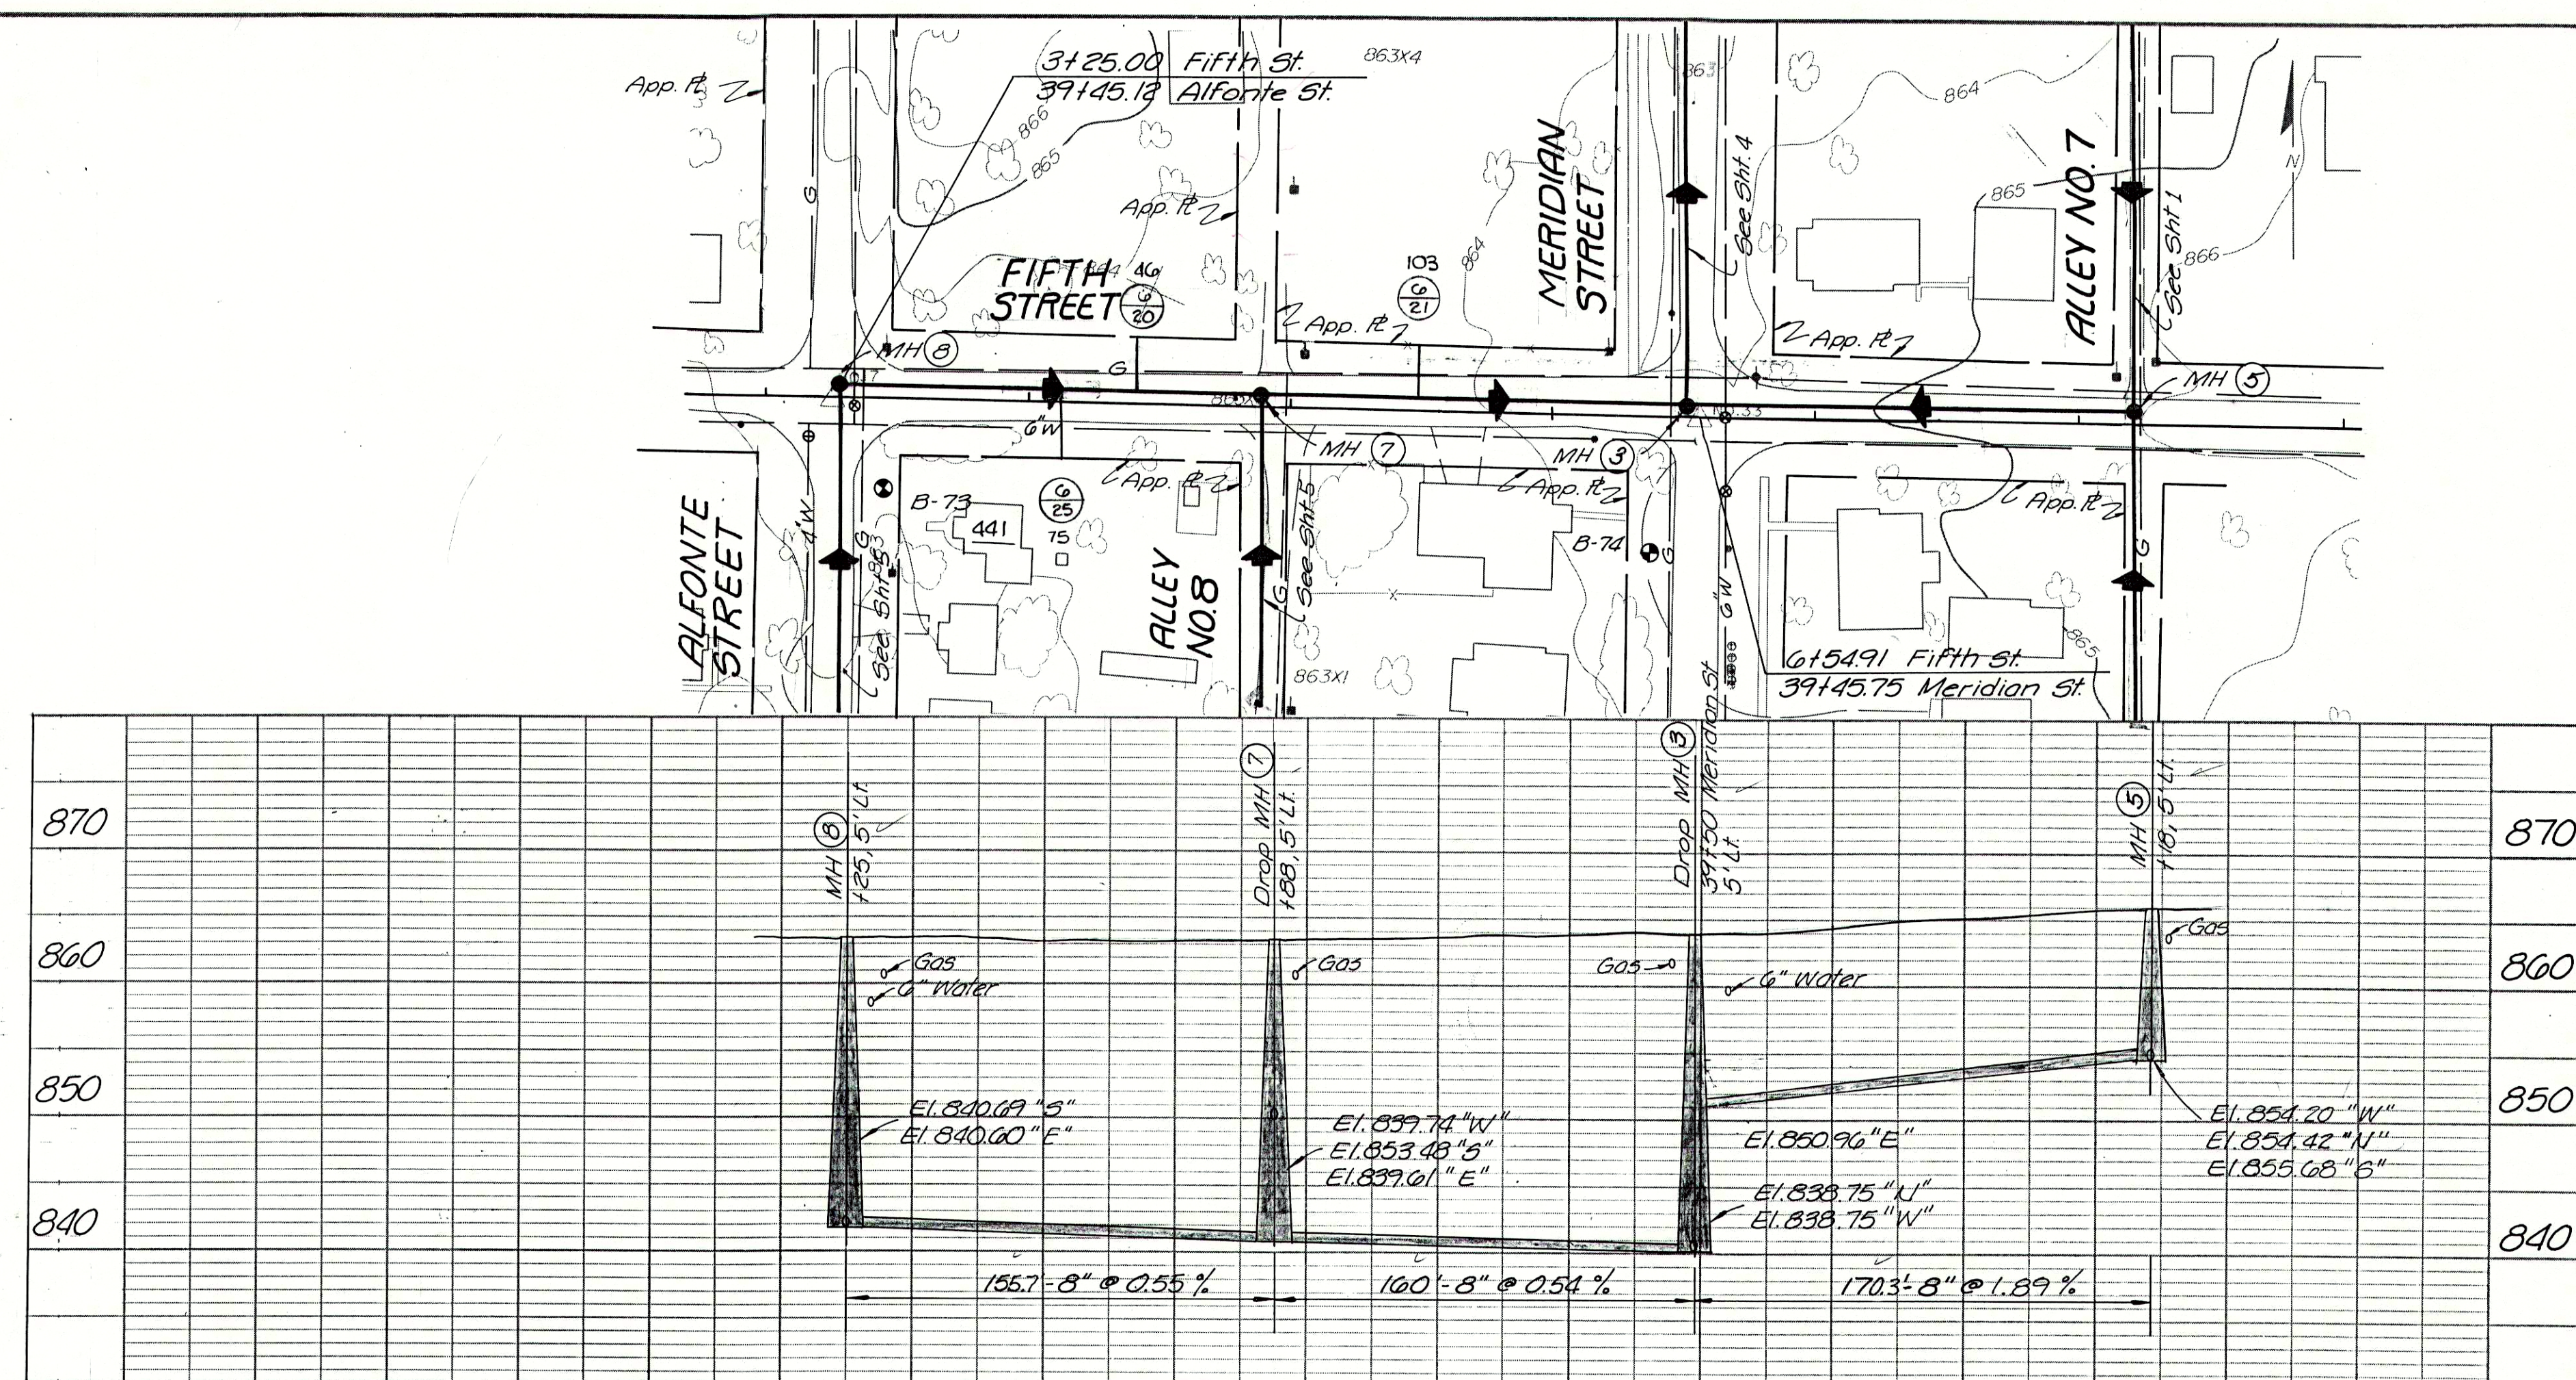
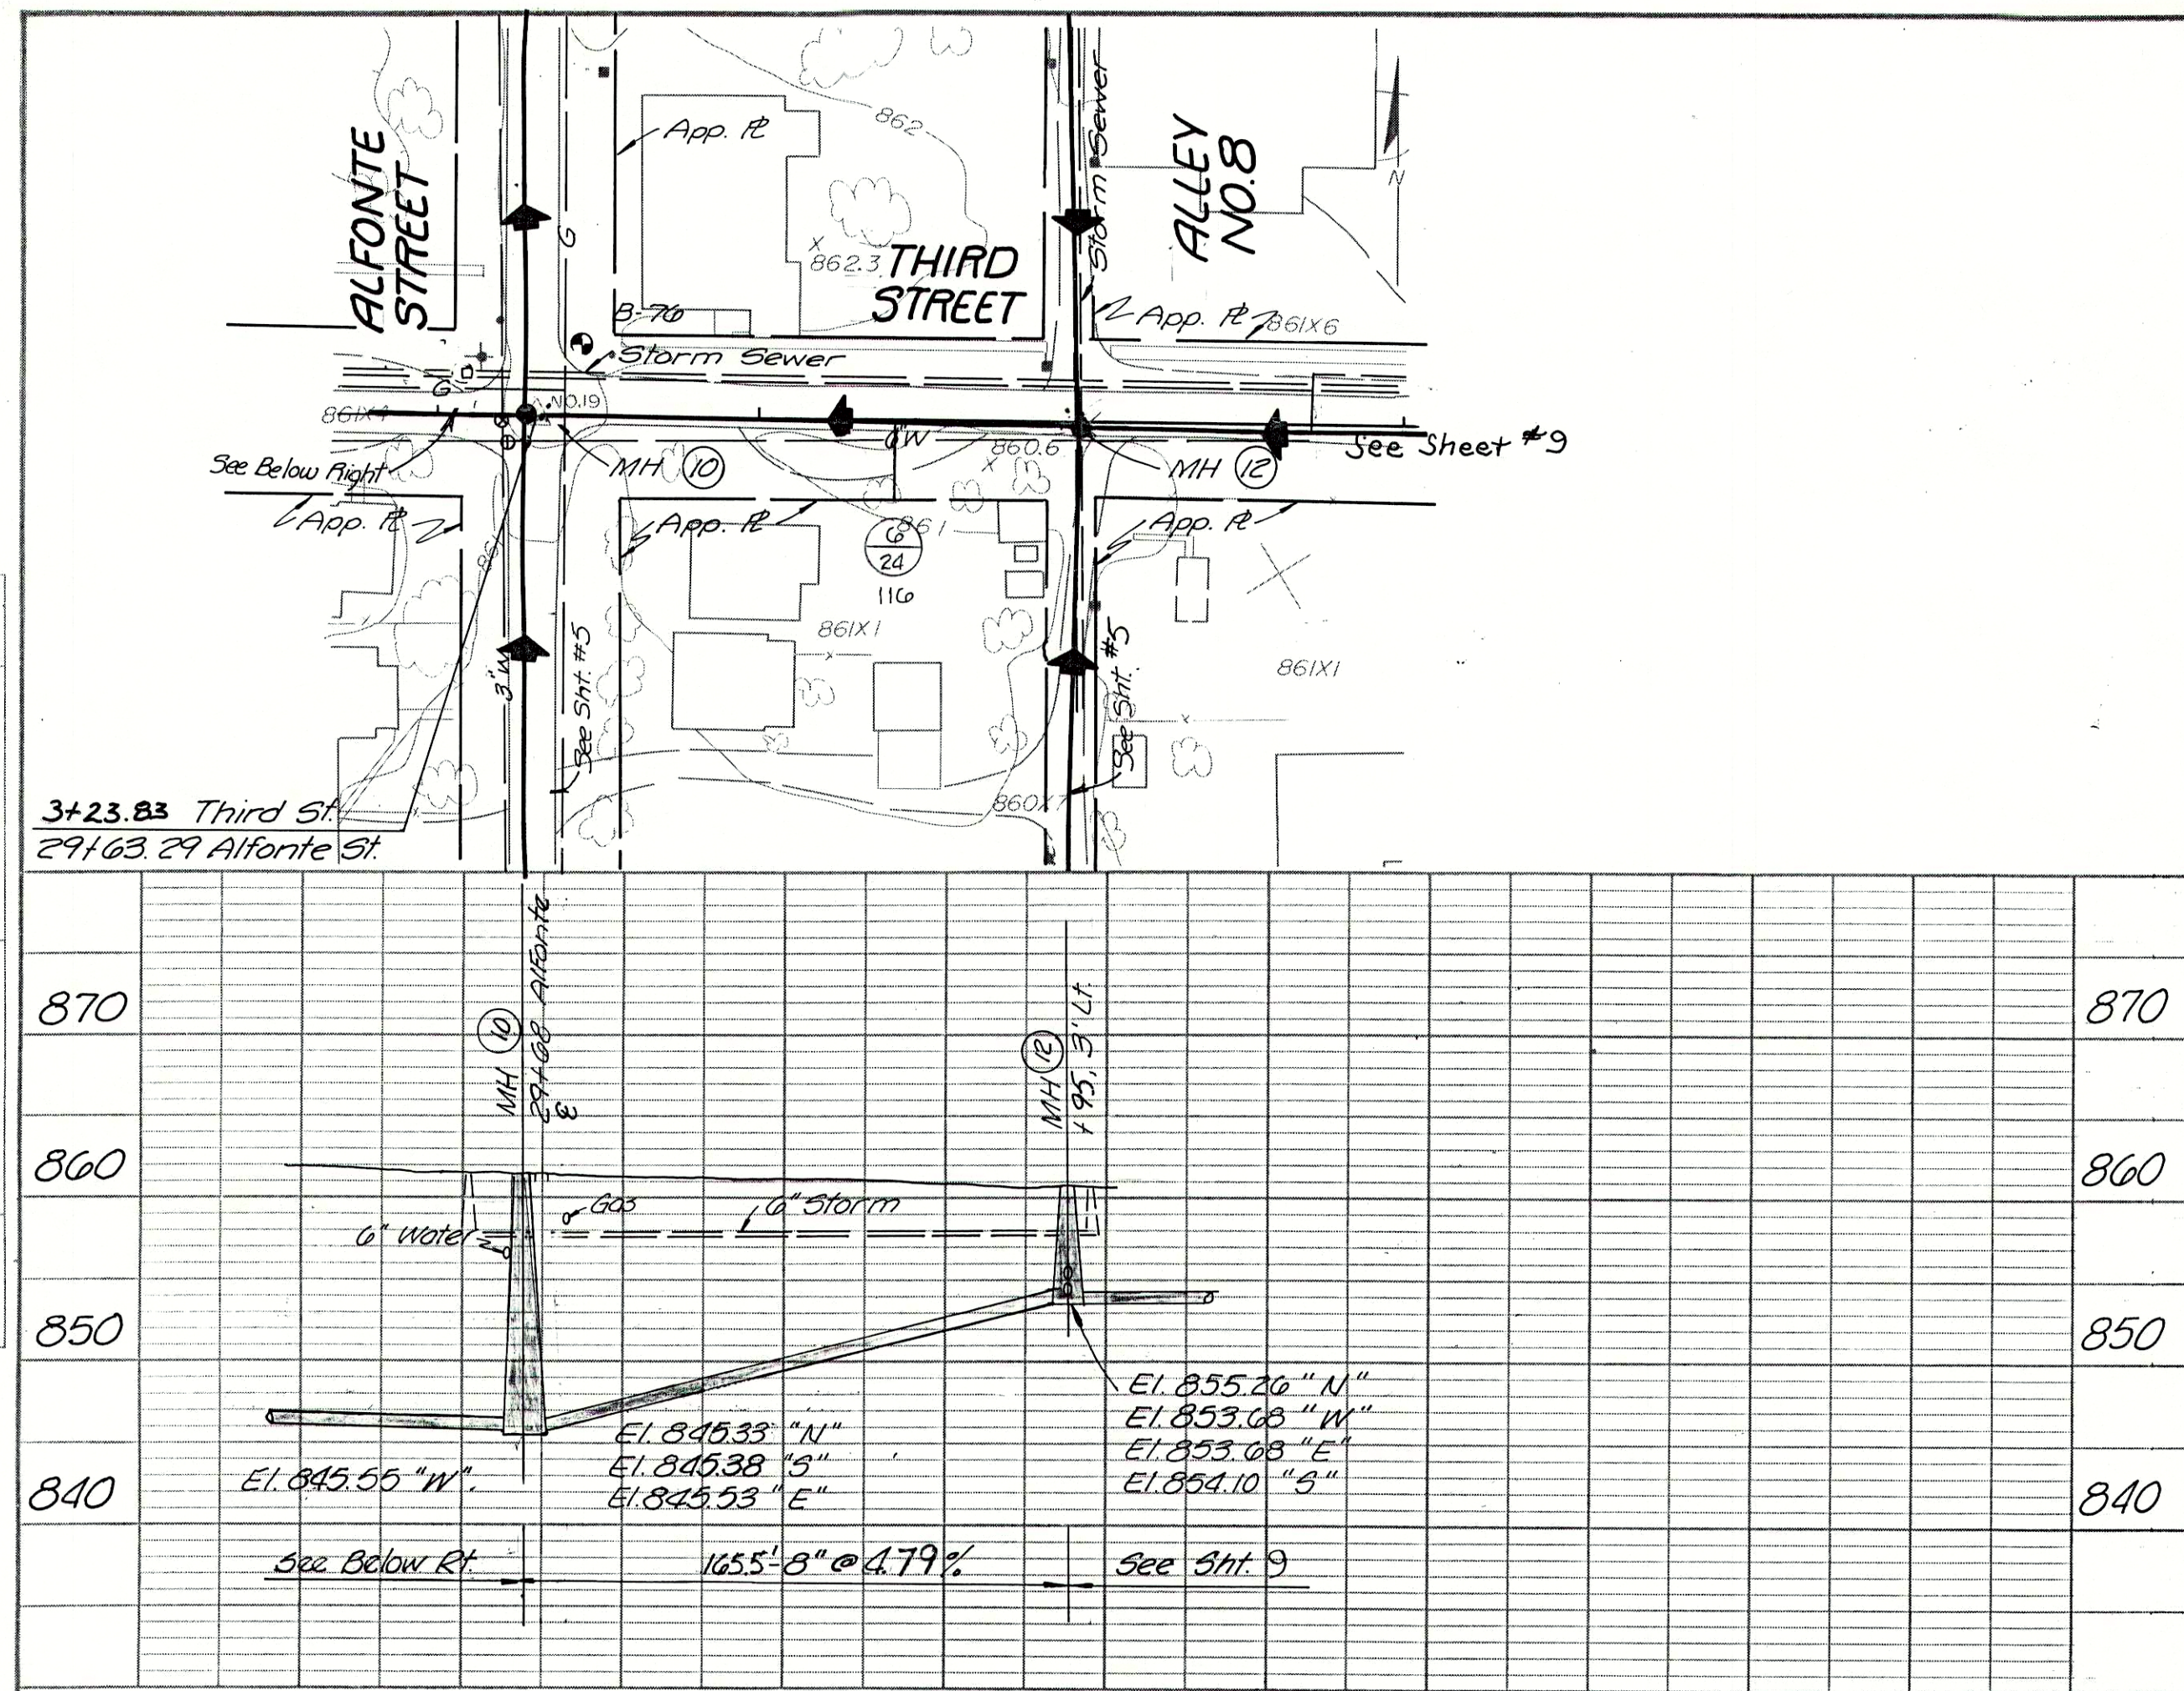


PLAN	DATE
NO.	
BY	
REVISIONS	
1. DATE	
2. BY	
3. DESCRIPTION	
4. CHECKED	
5. APPROVED	

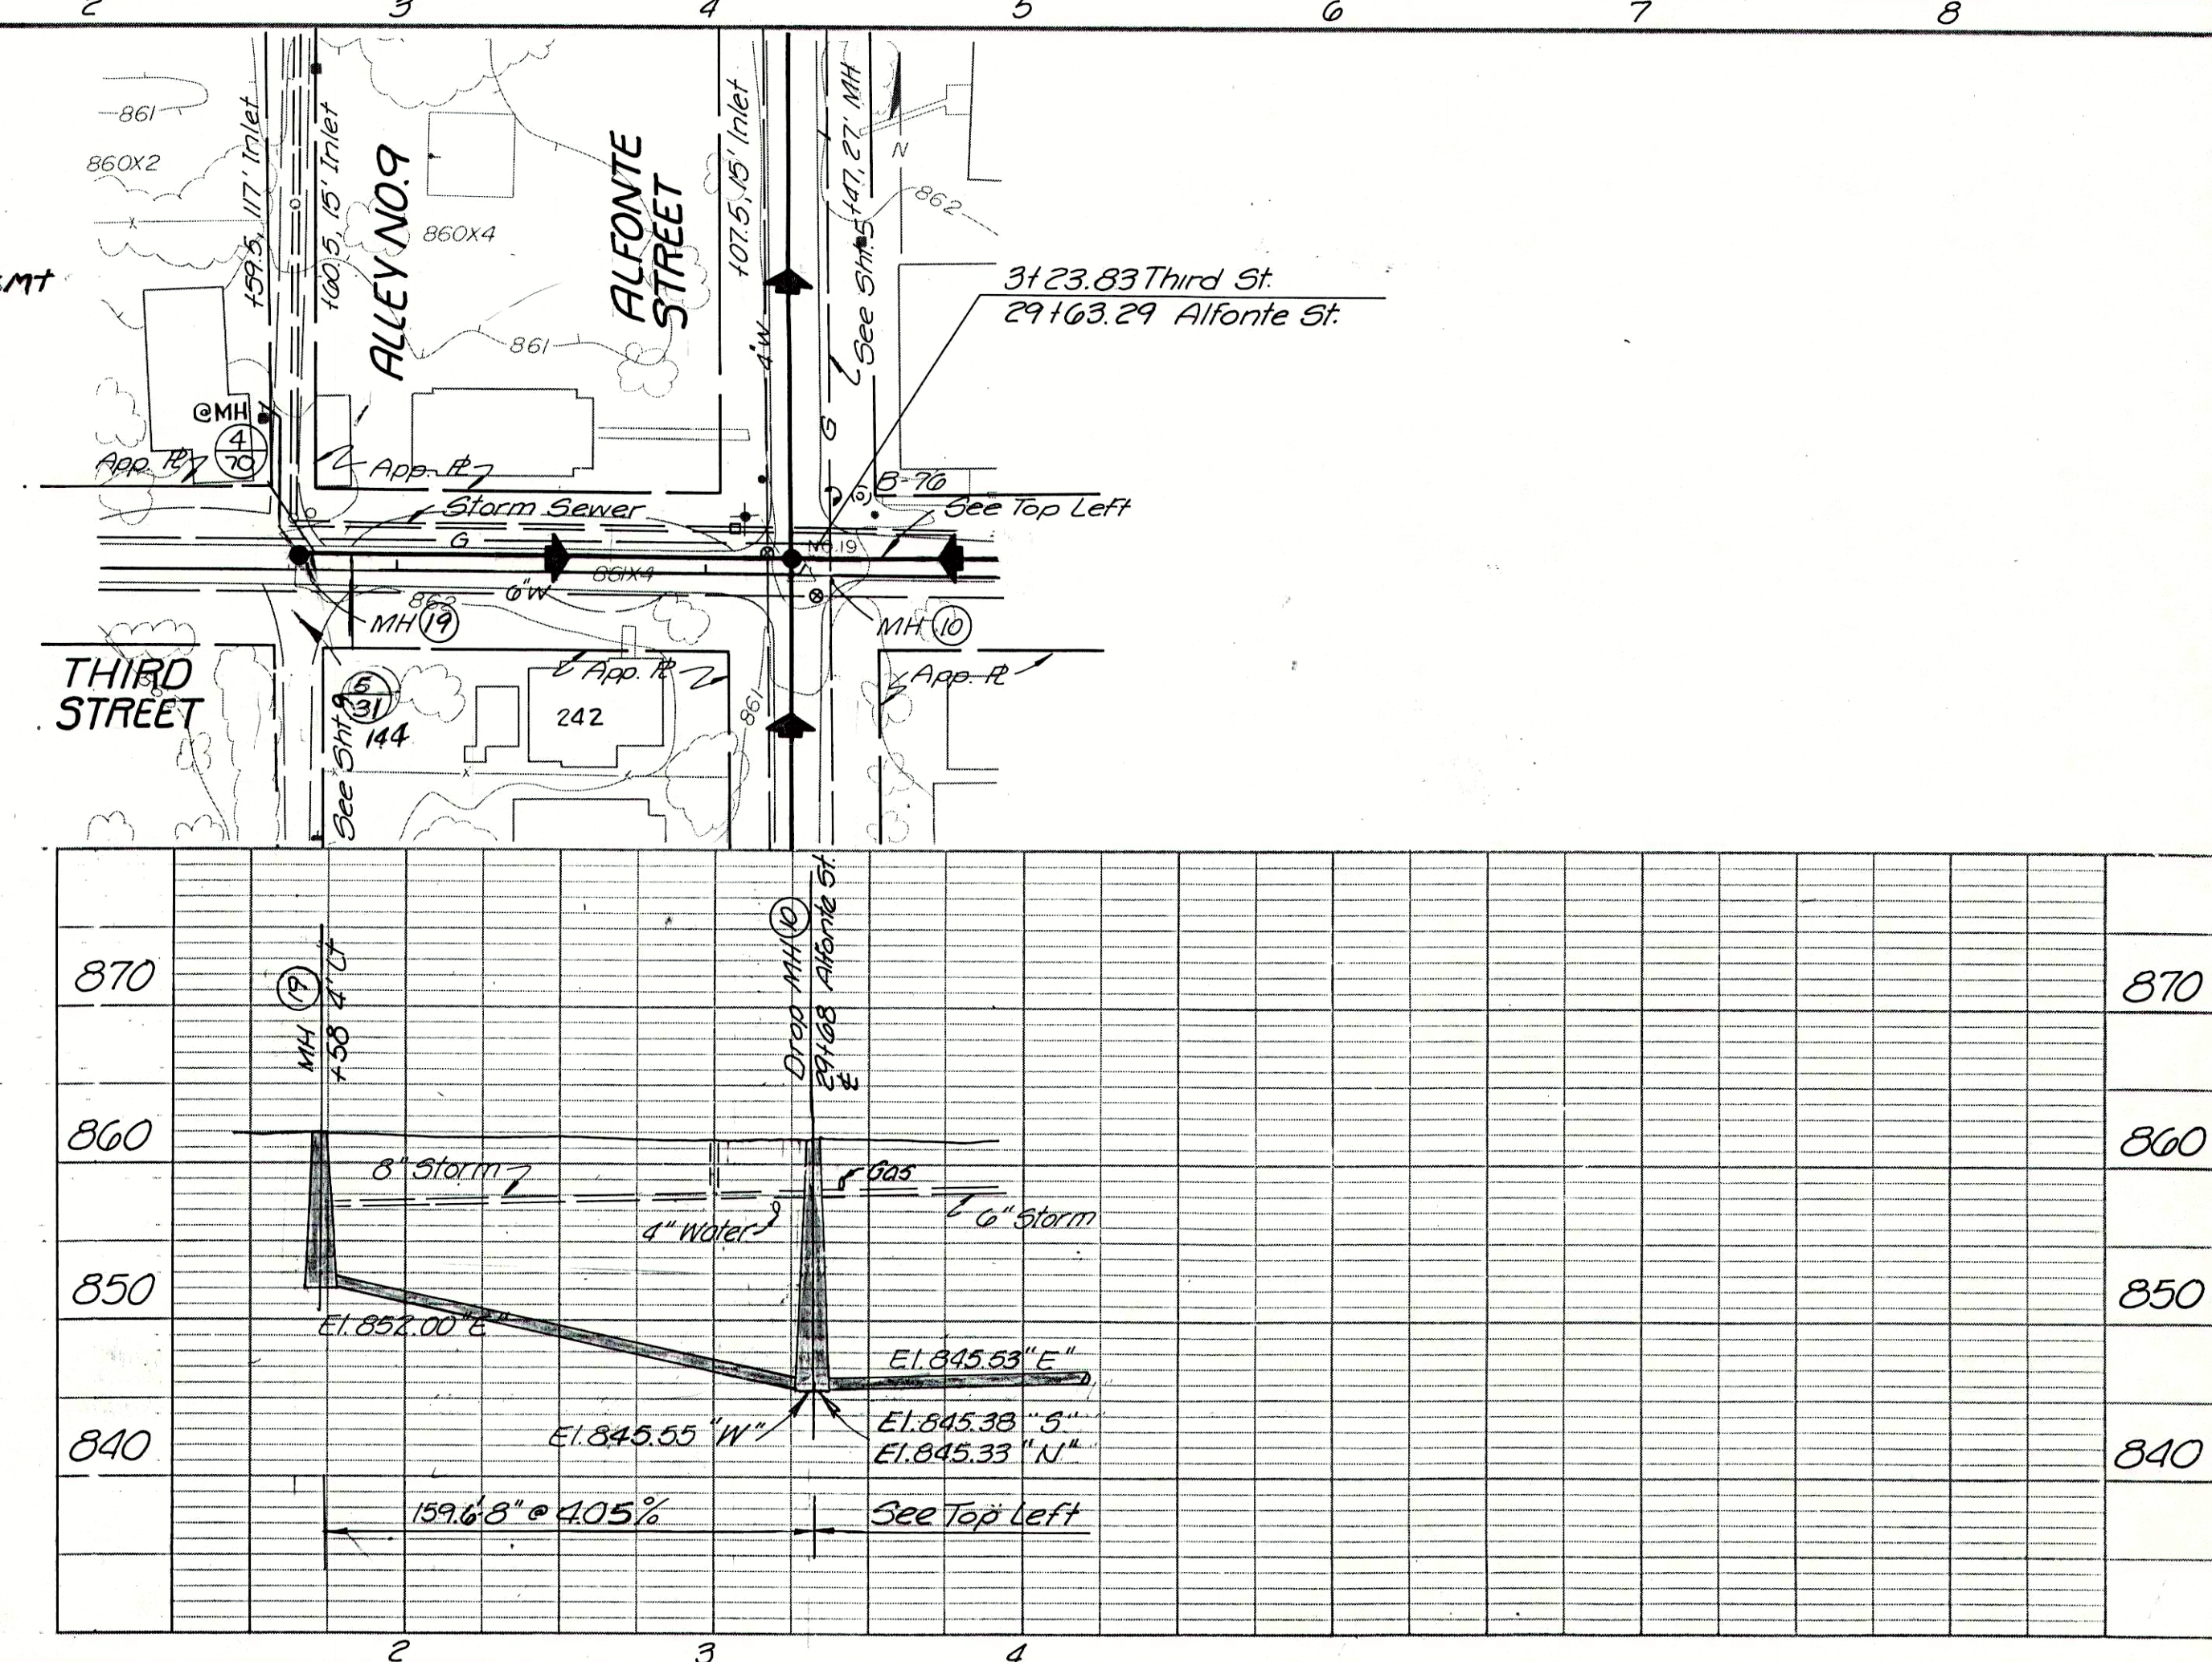

PROFILE	DATE
NO.	
BY	
REVISIONS	
1. DATE	
2. BY	
3. DESCRIPTION	
4. CHECKED	
5. APPROVED	

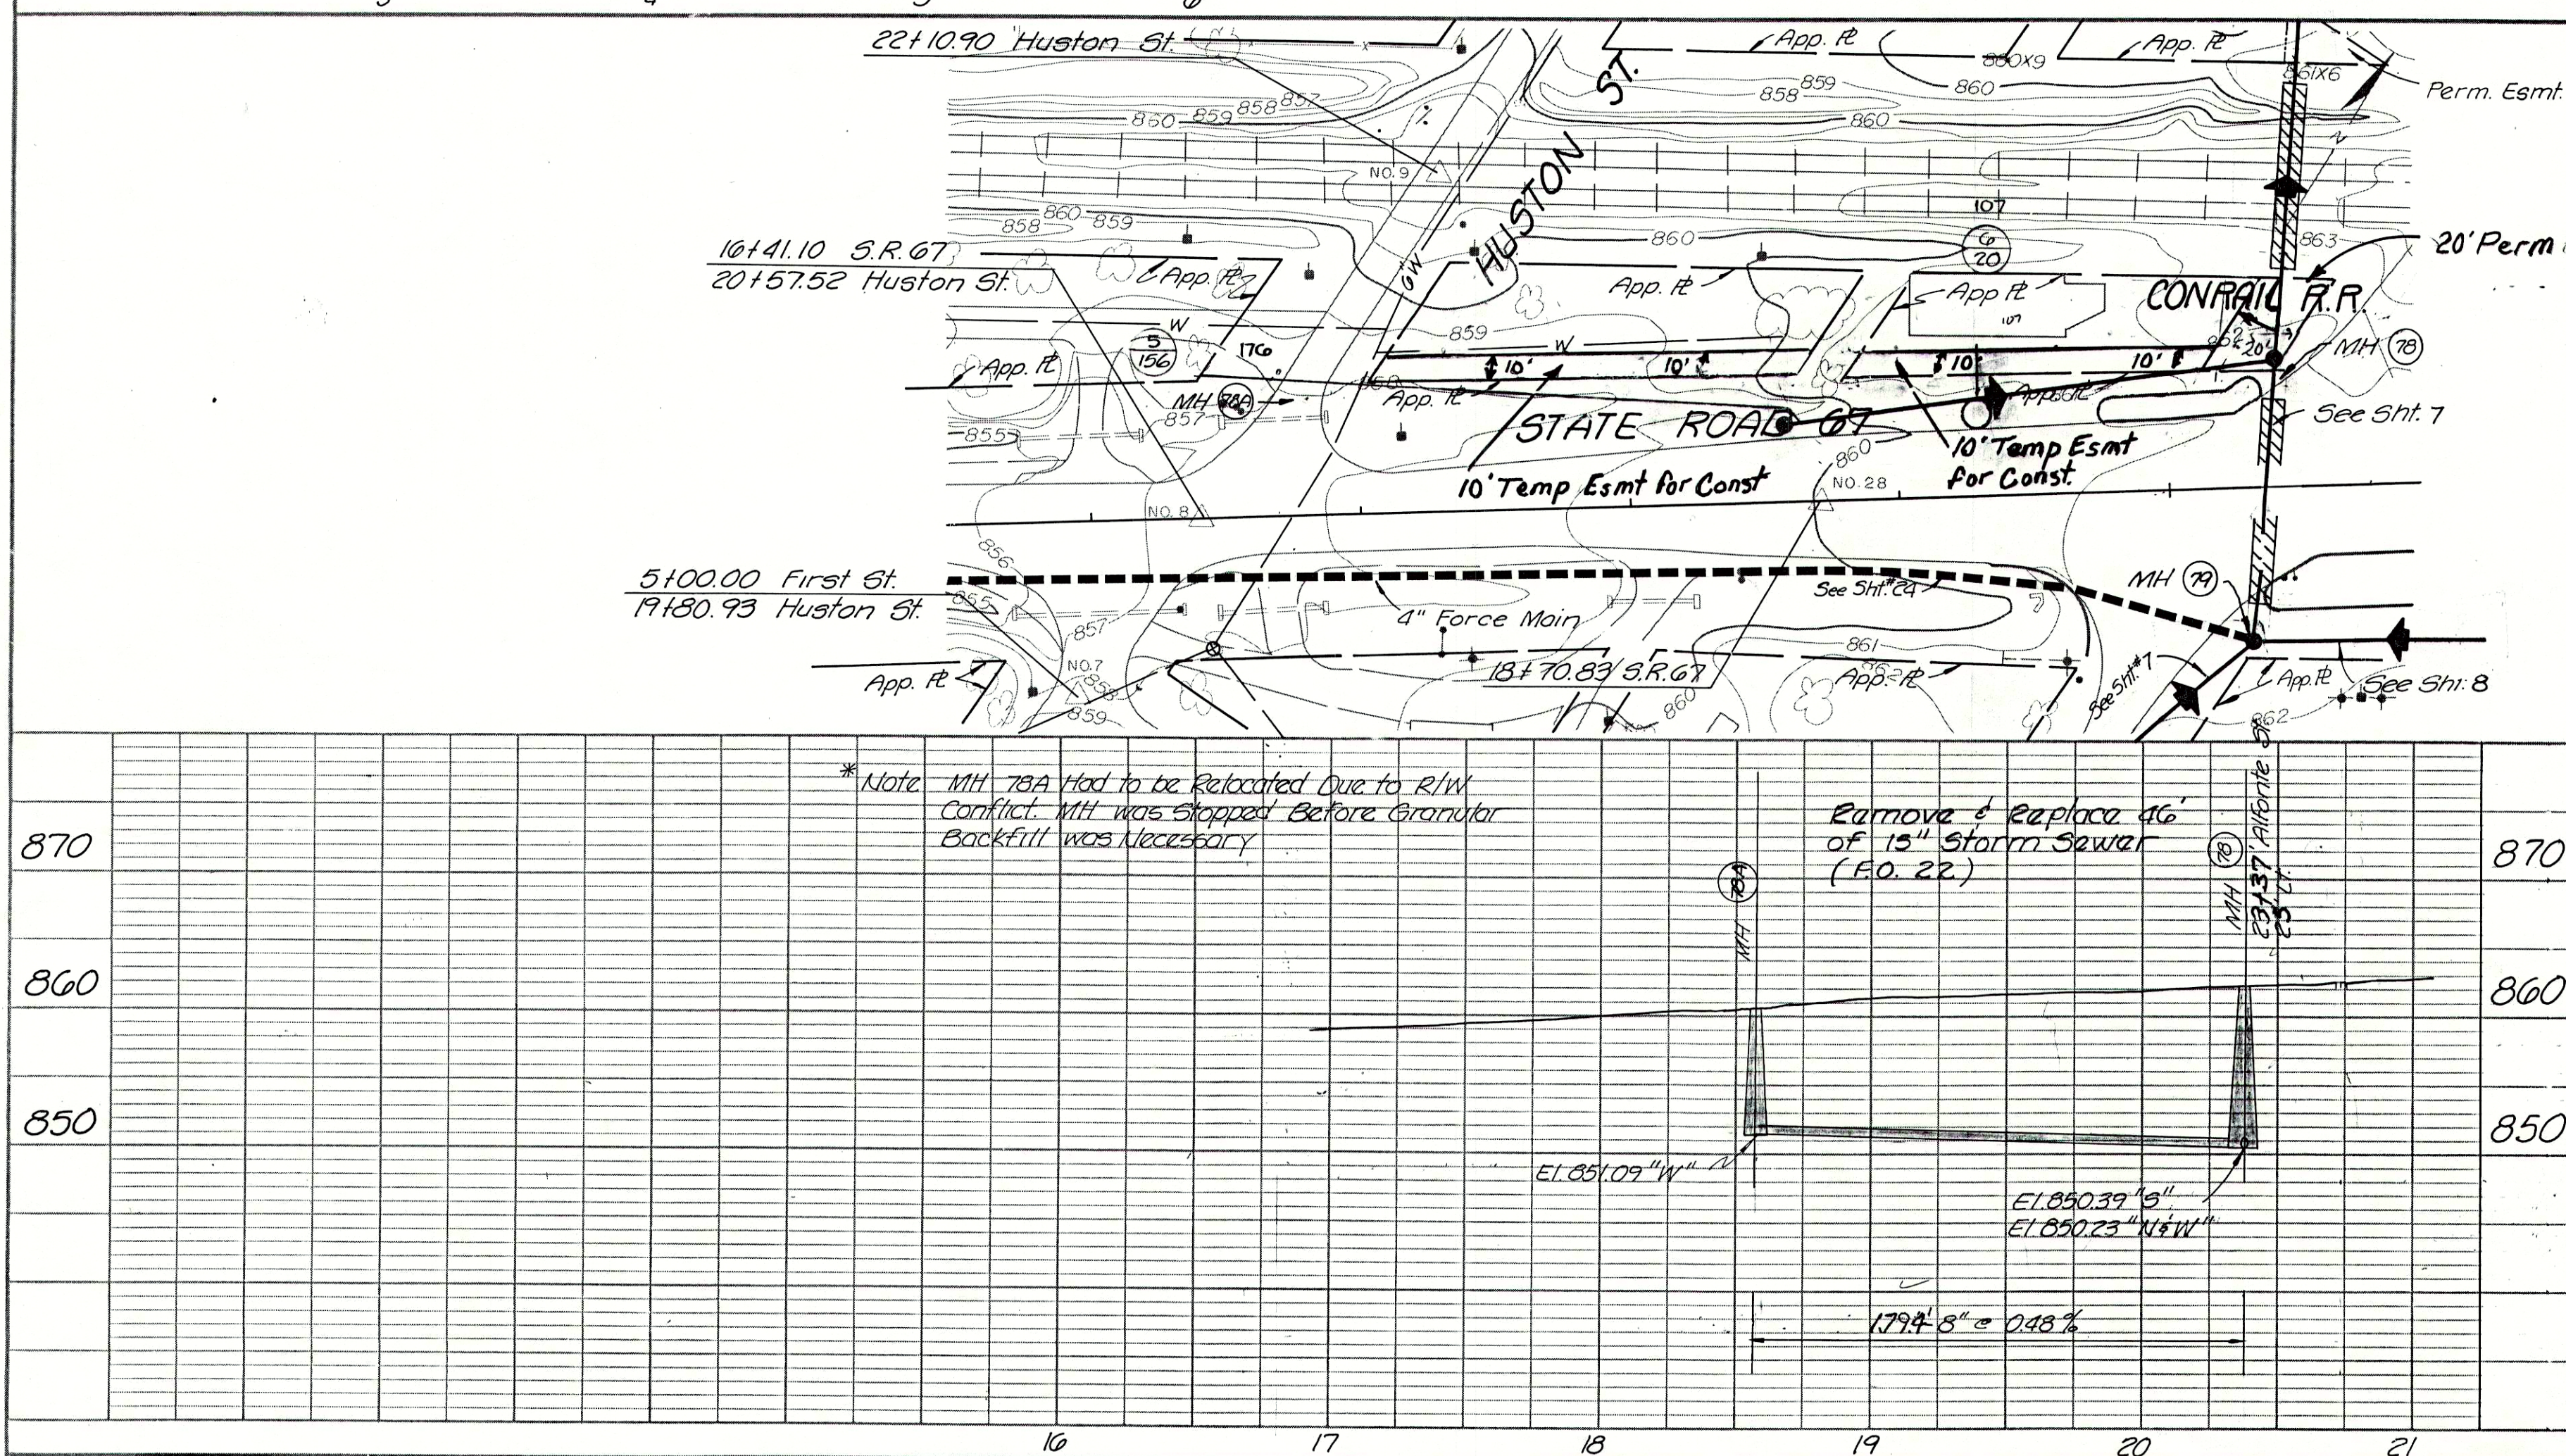

RECORD DRAWING



THIRD ST. FIFTH ST. S.R. 67	FALL CREEK R.W.D. PLAN & PROFILE SHEET
HORIZ. 1"=50'	BEAM, LONGEST & NEFF, INC.
VERT. 1"=10'	CONSULTING ENGINEERS
	INDIANAPOLIS, INDIANA