

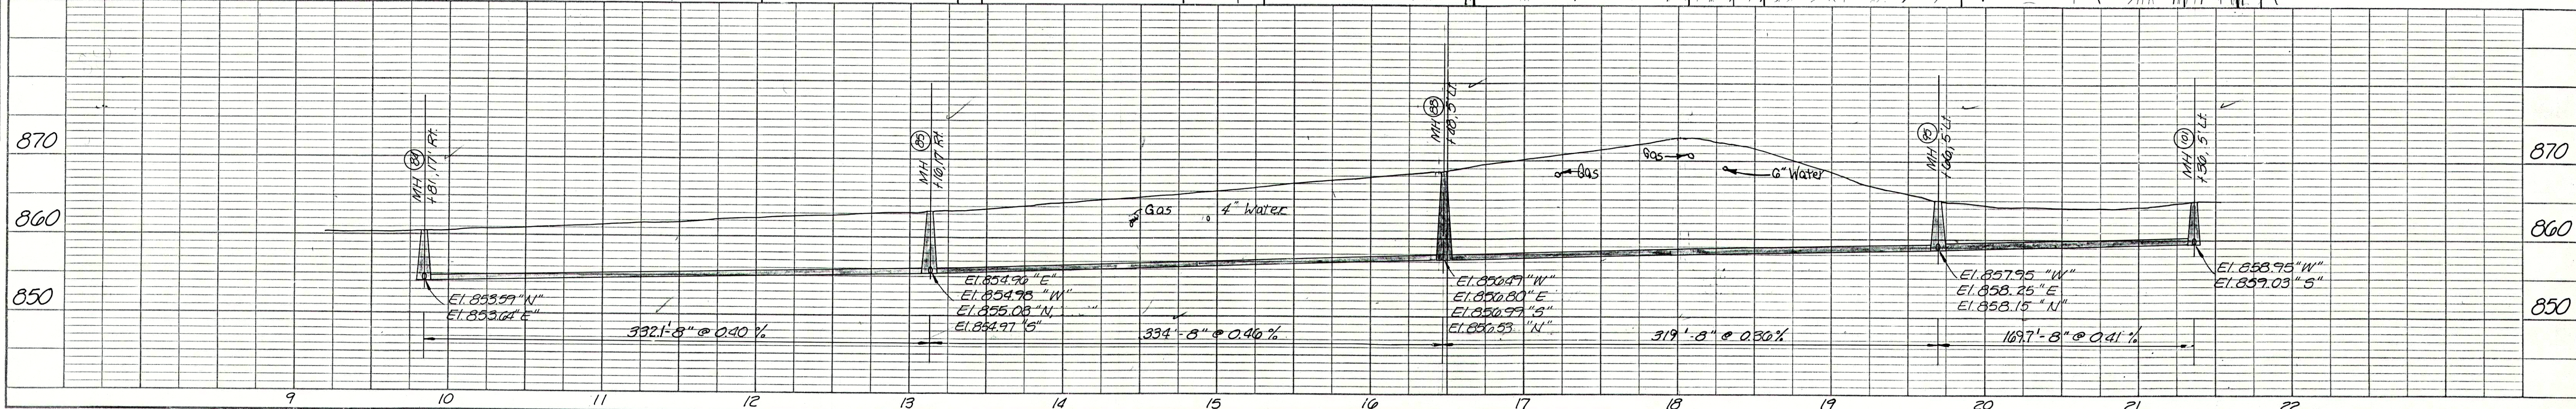
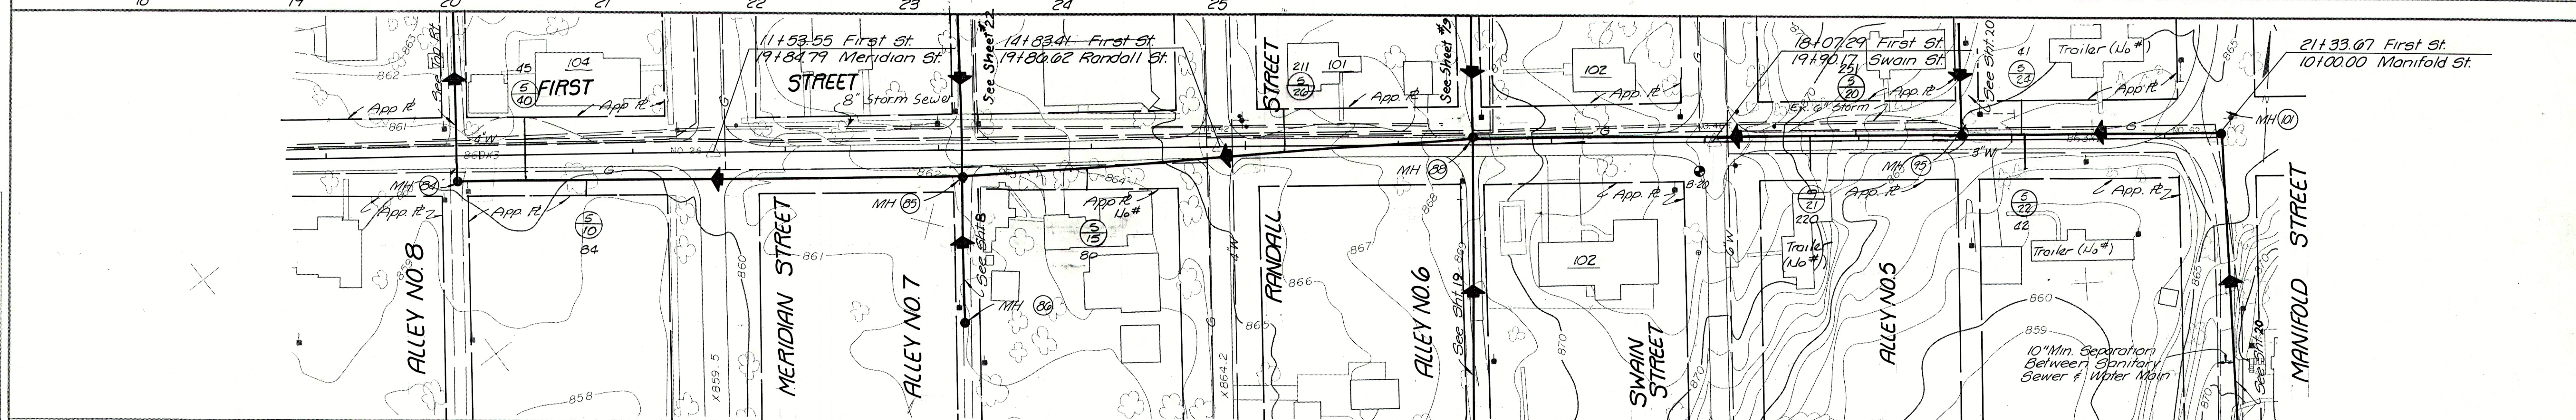
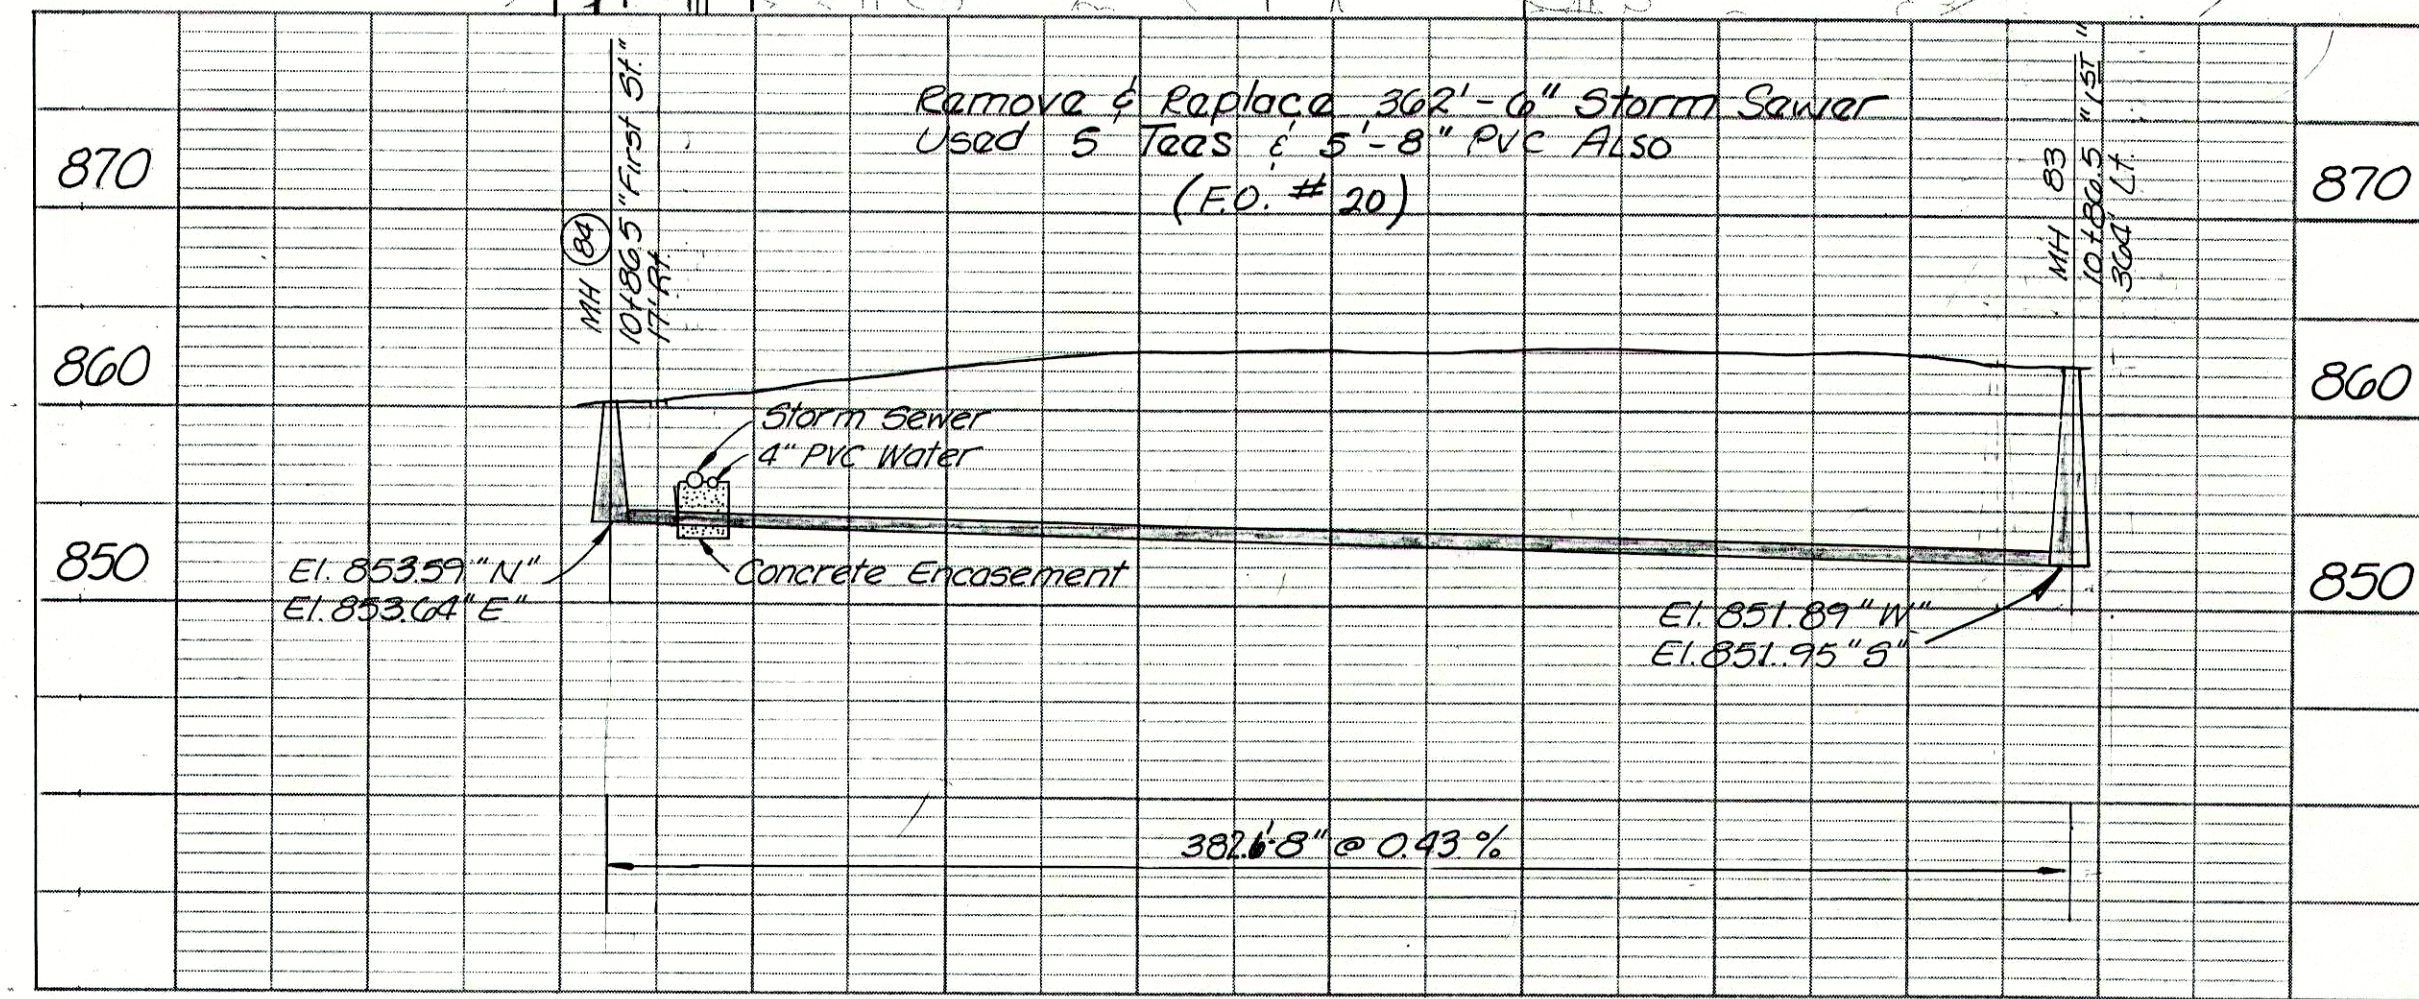
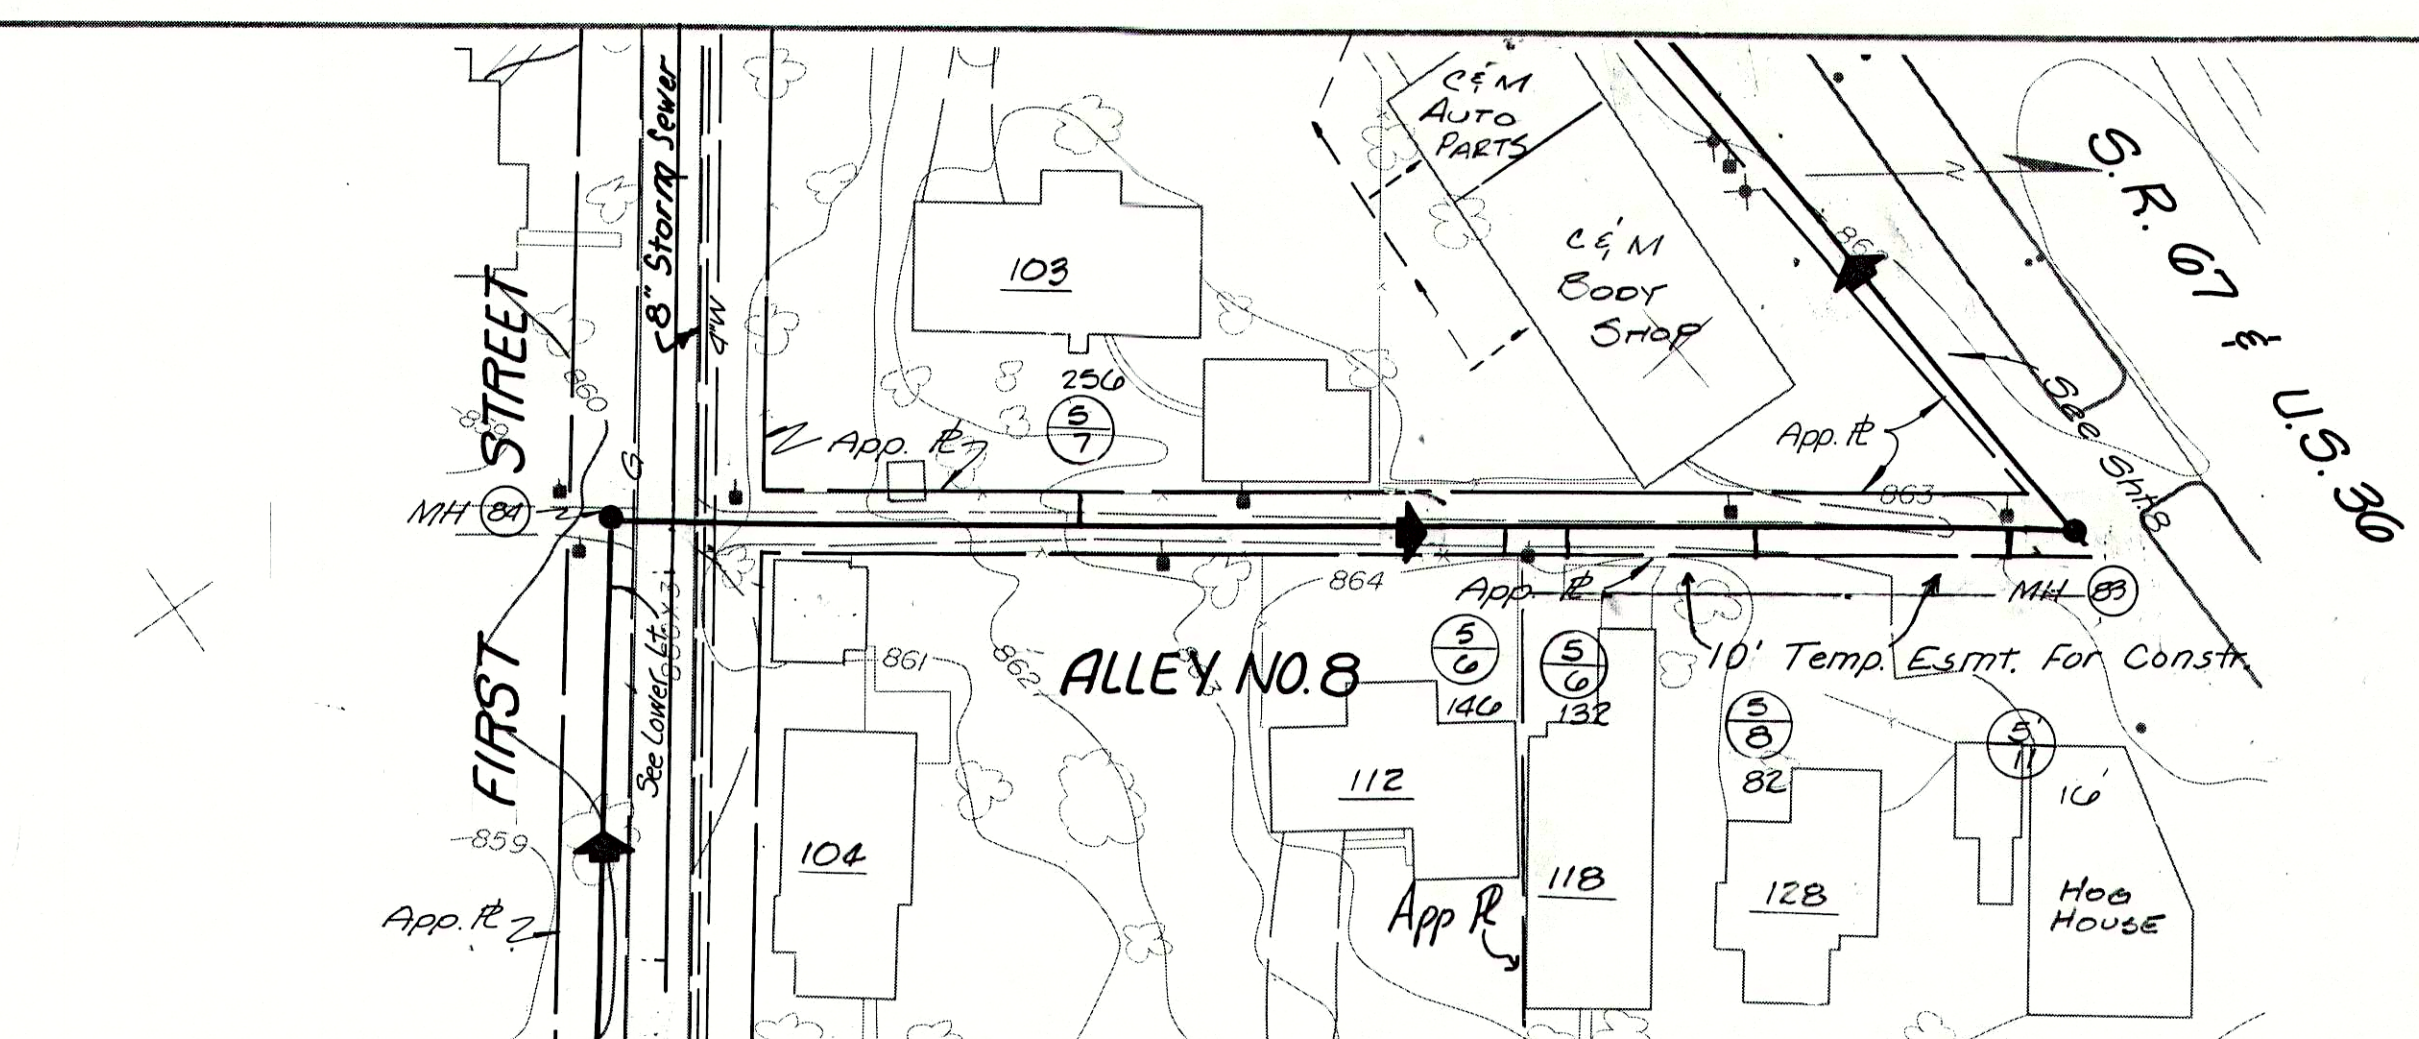


PLAN	SURVEYED	DATE
	NOTED	BY
	PLOTTED	BY
	NOTE BOOK	NO.

PROFILE	SURVEYED	DATE
	NOTED	BY
	PLOTTED	BY
	NOTE BOOK	NO.

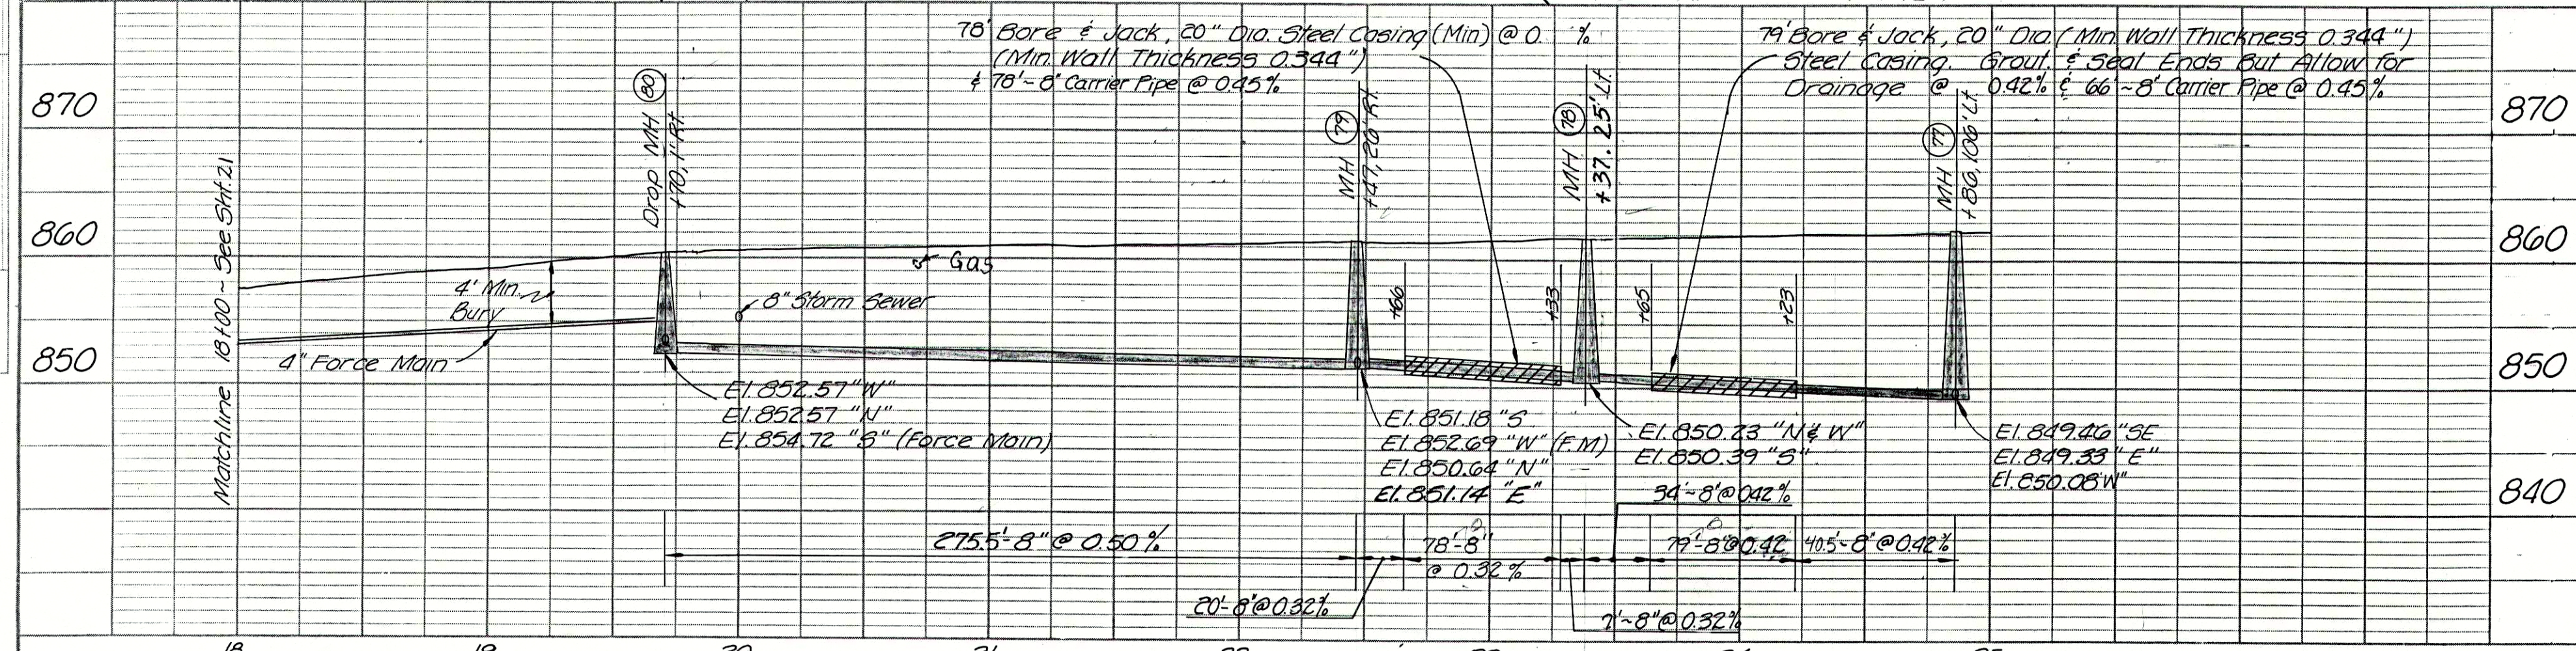

RECORD DRAWING

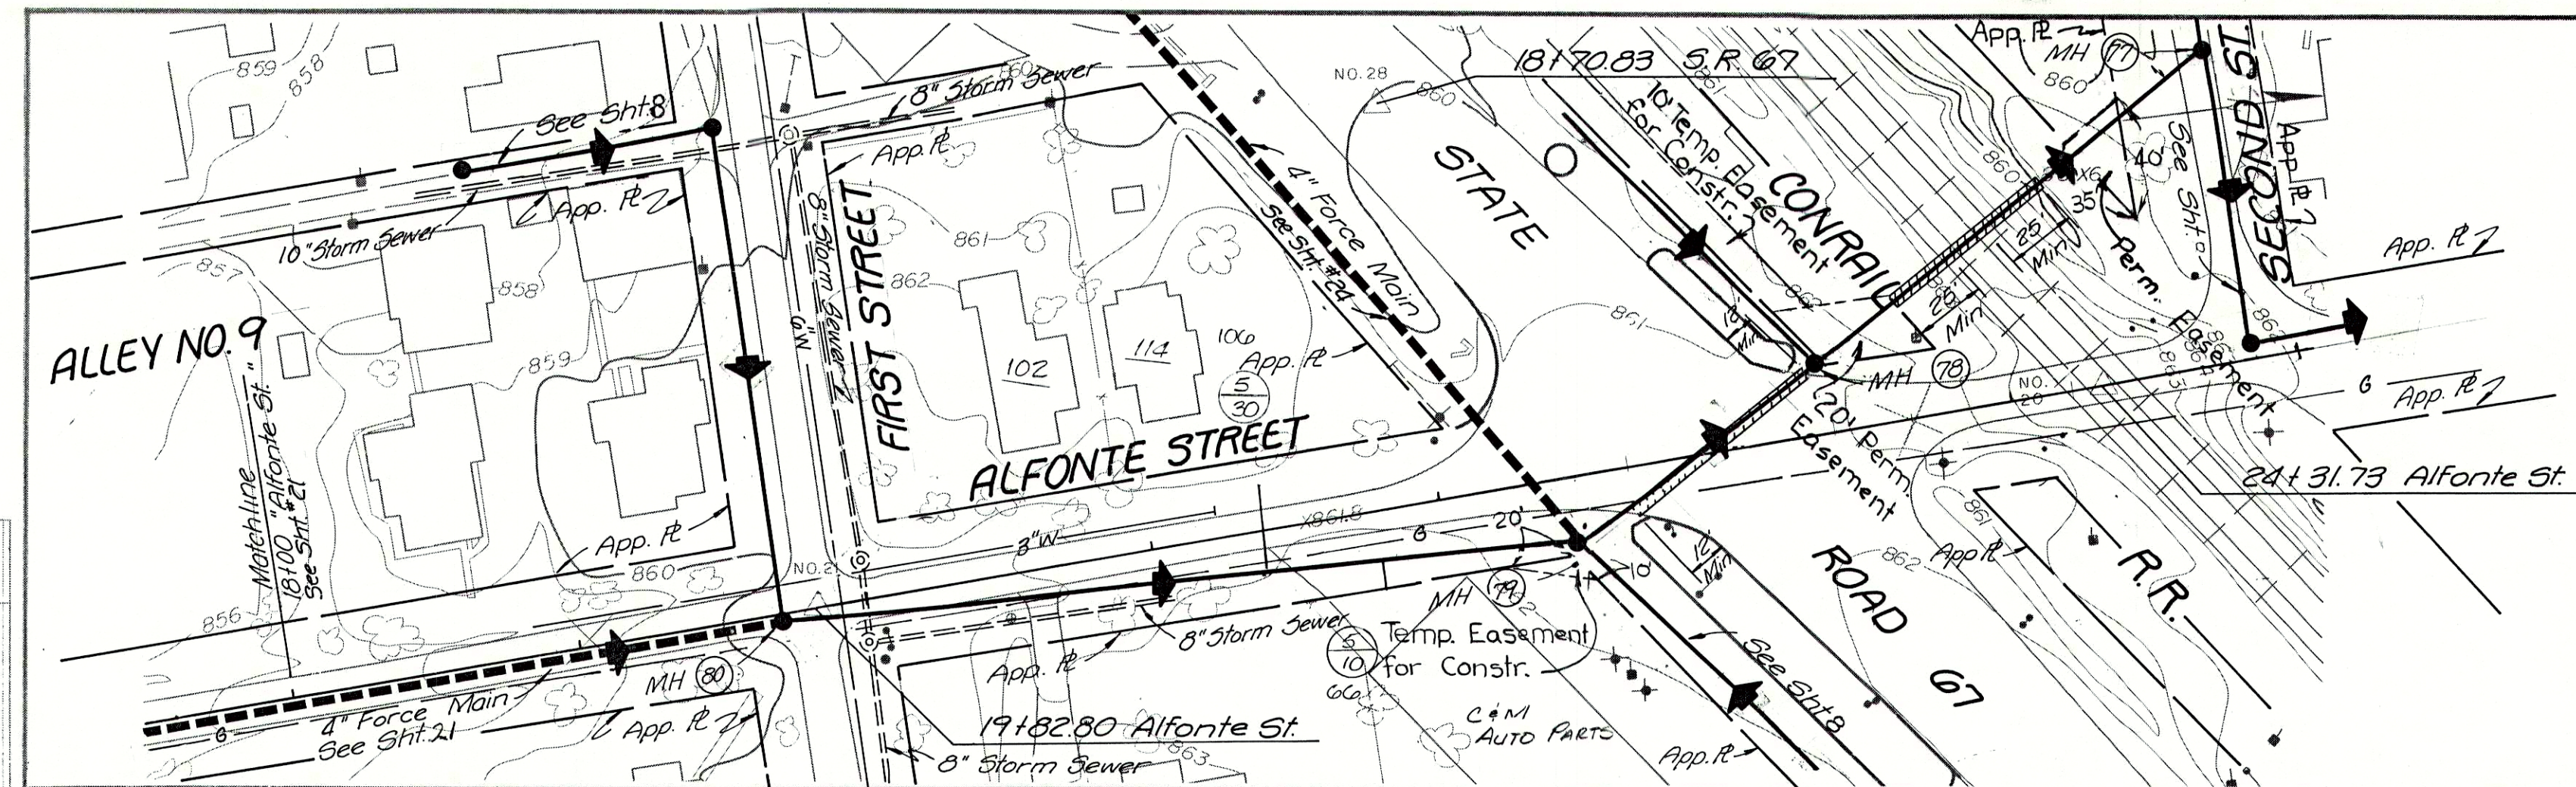

ALFONTE ST. ALLEY #8	
FIRST ST.	
FALL CREEK R.W.D. PLAN & PROFILE	SHEET
HORIZ. 1"=50'	BEAM, LONGEST & NEFF, INC.
VERT. 1"=10'	CONSULTING ENGINEERS
	INDIANAPOLIS, INDIANA

PHOTODUPLICATION BY KCU/AS SURFACES, INC. BEWAHA, INDIANA