

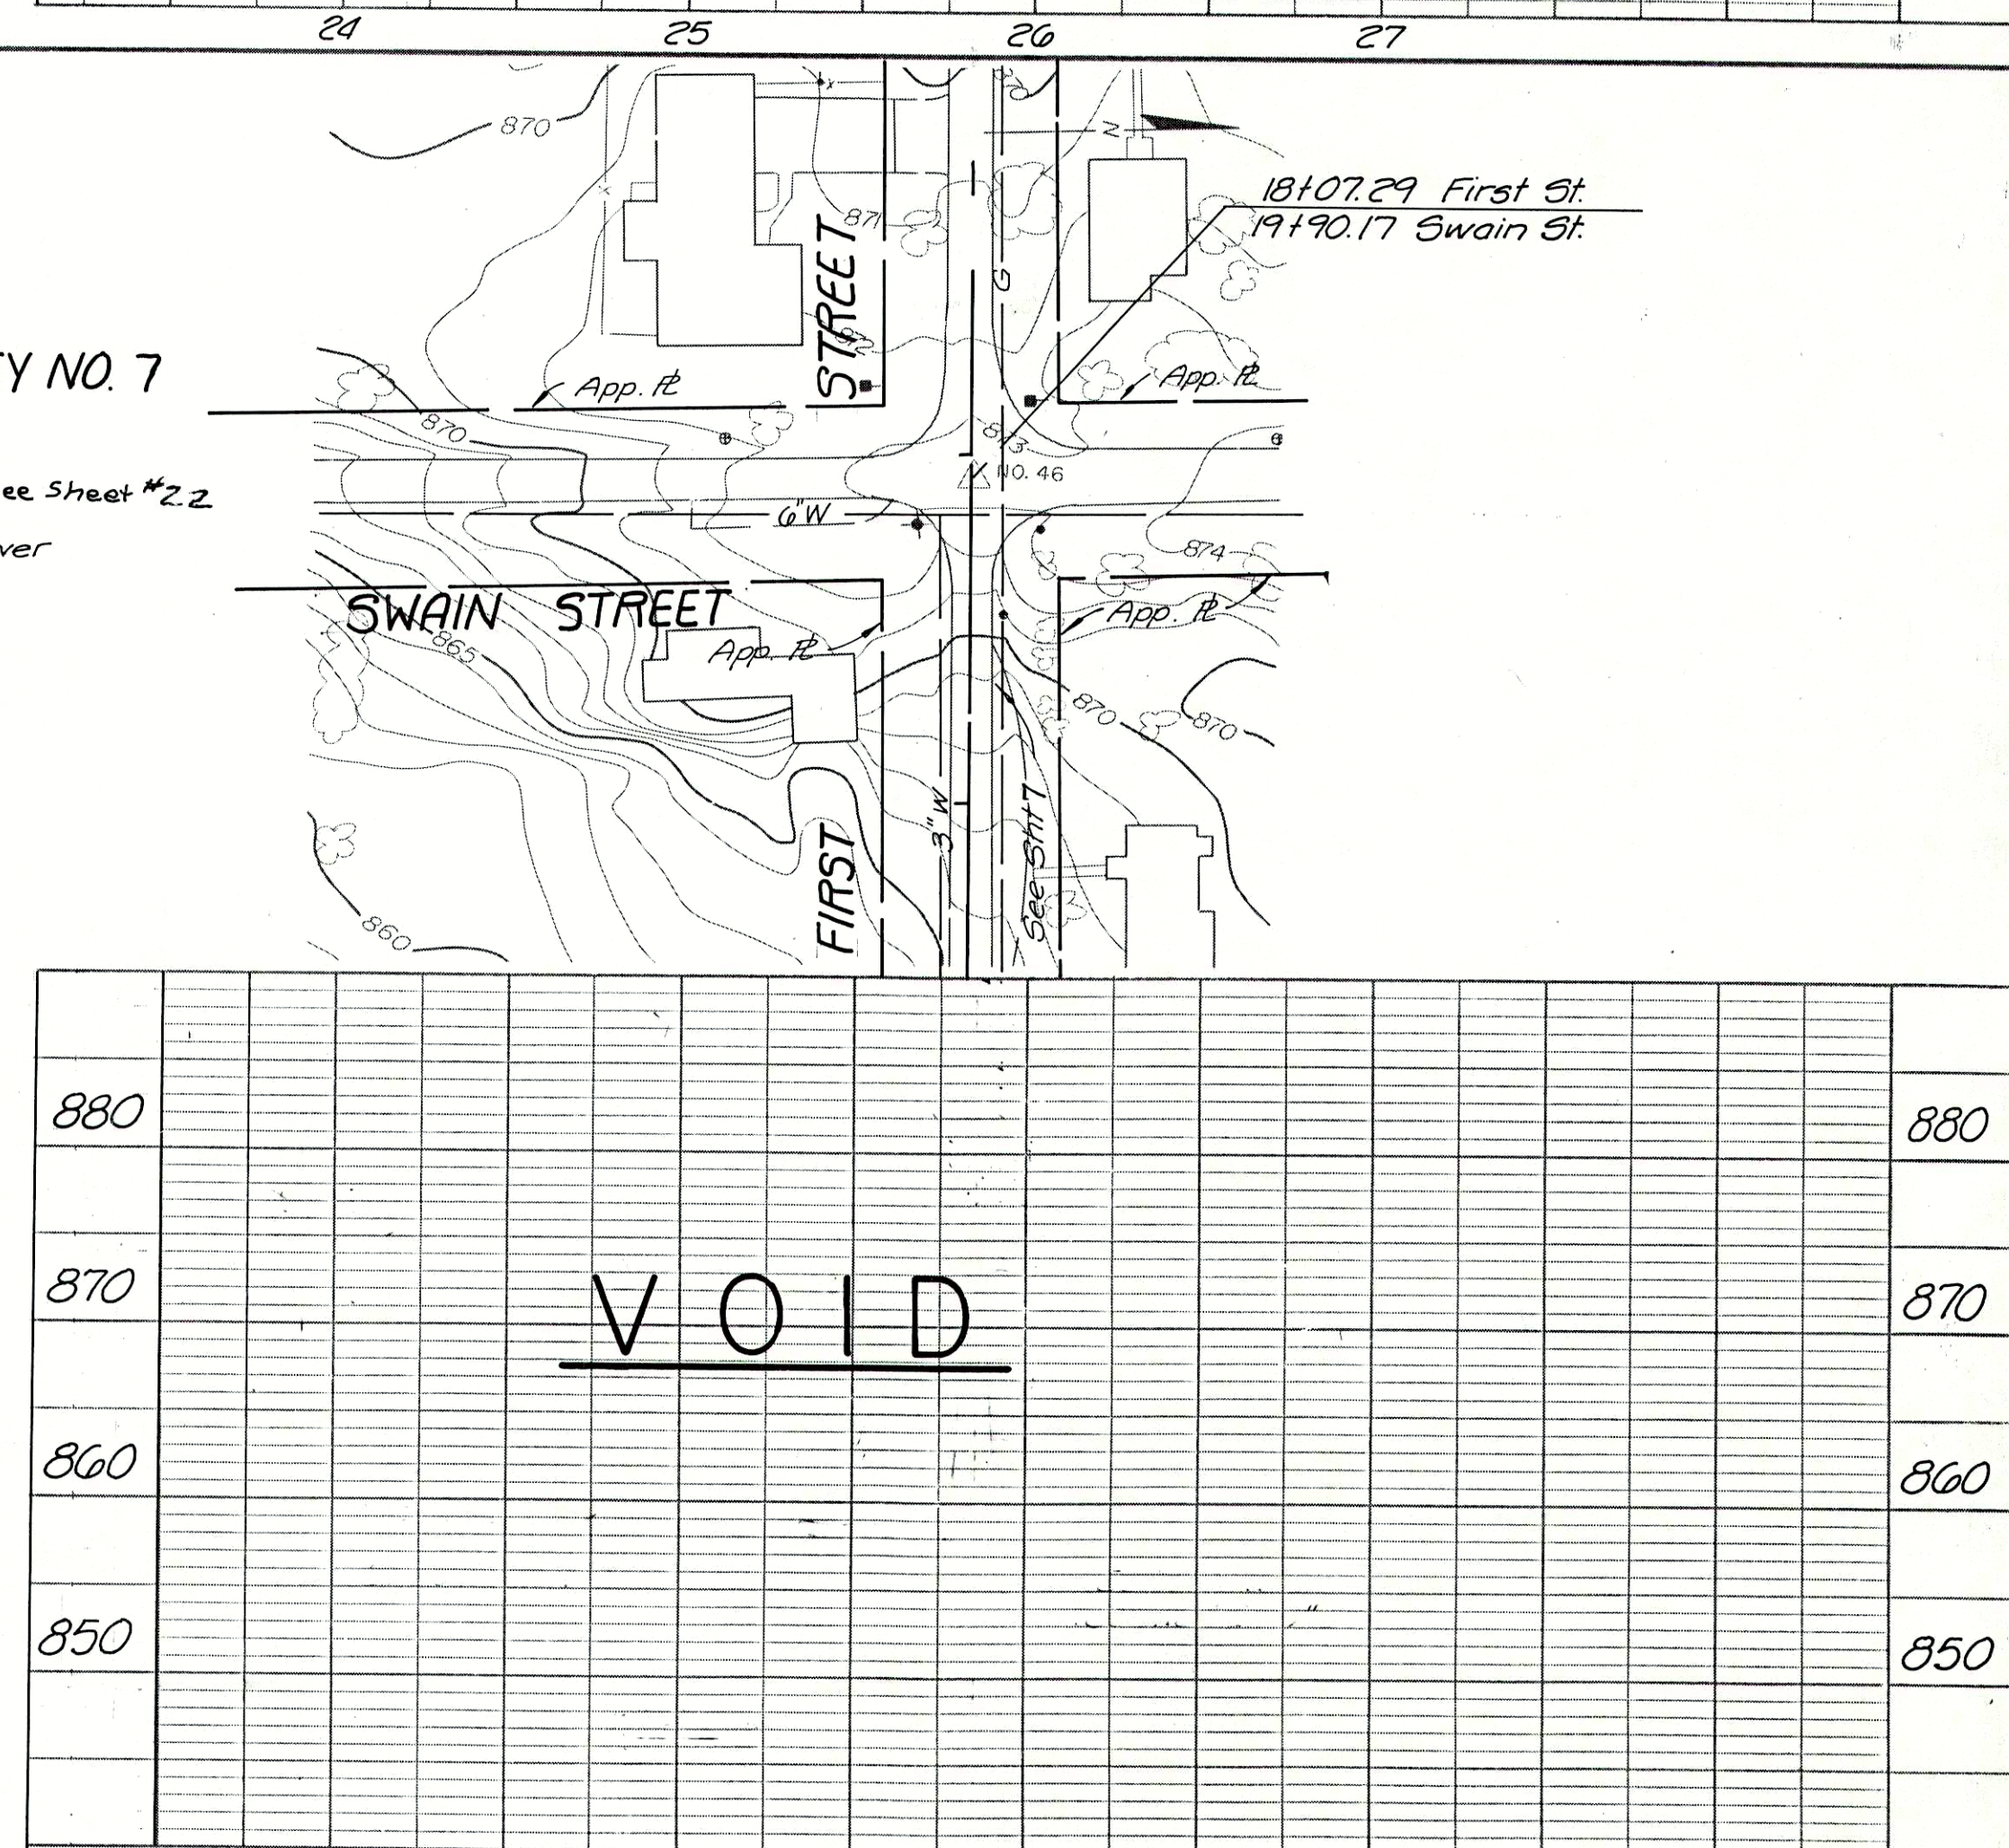
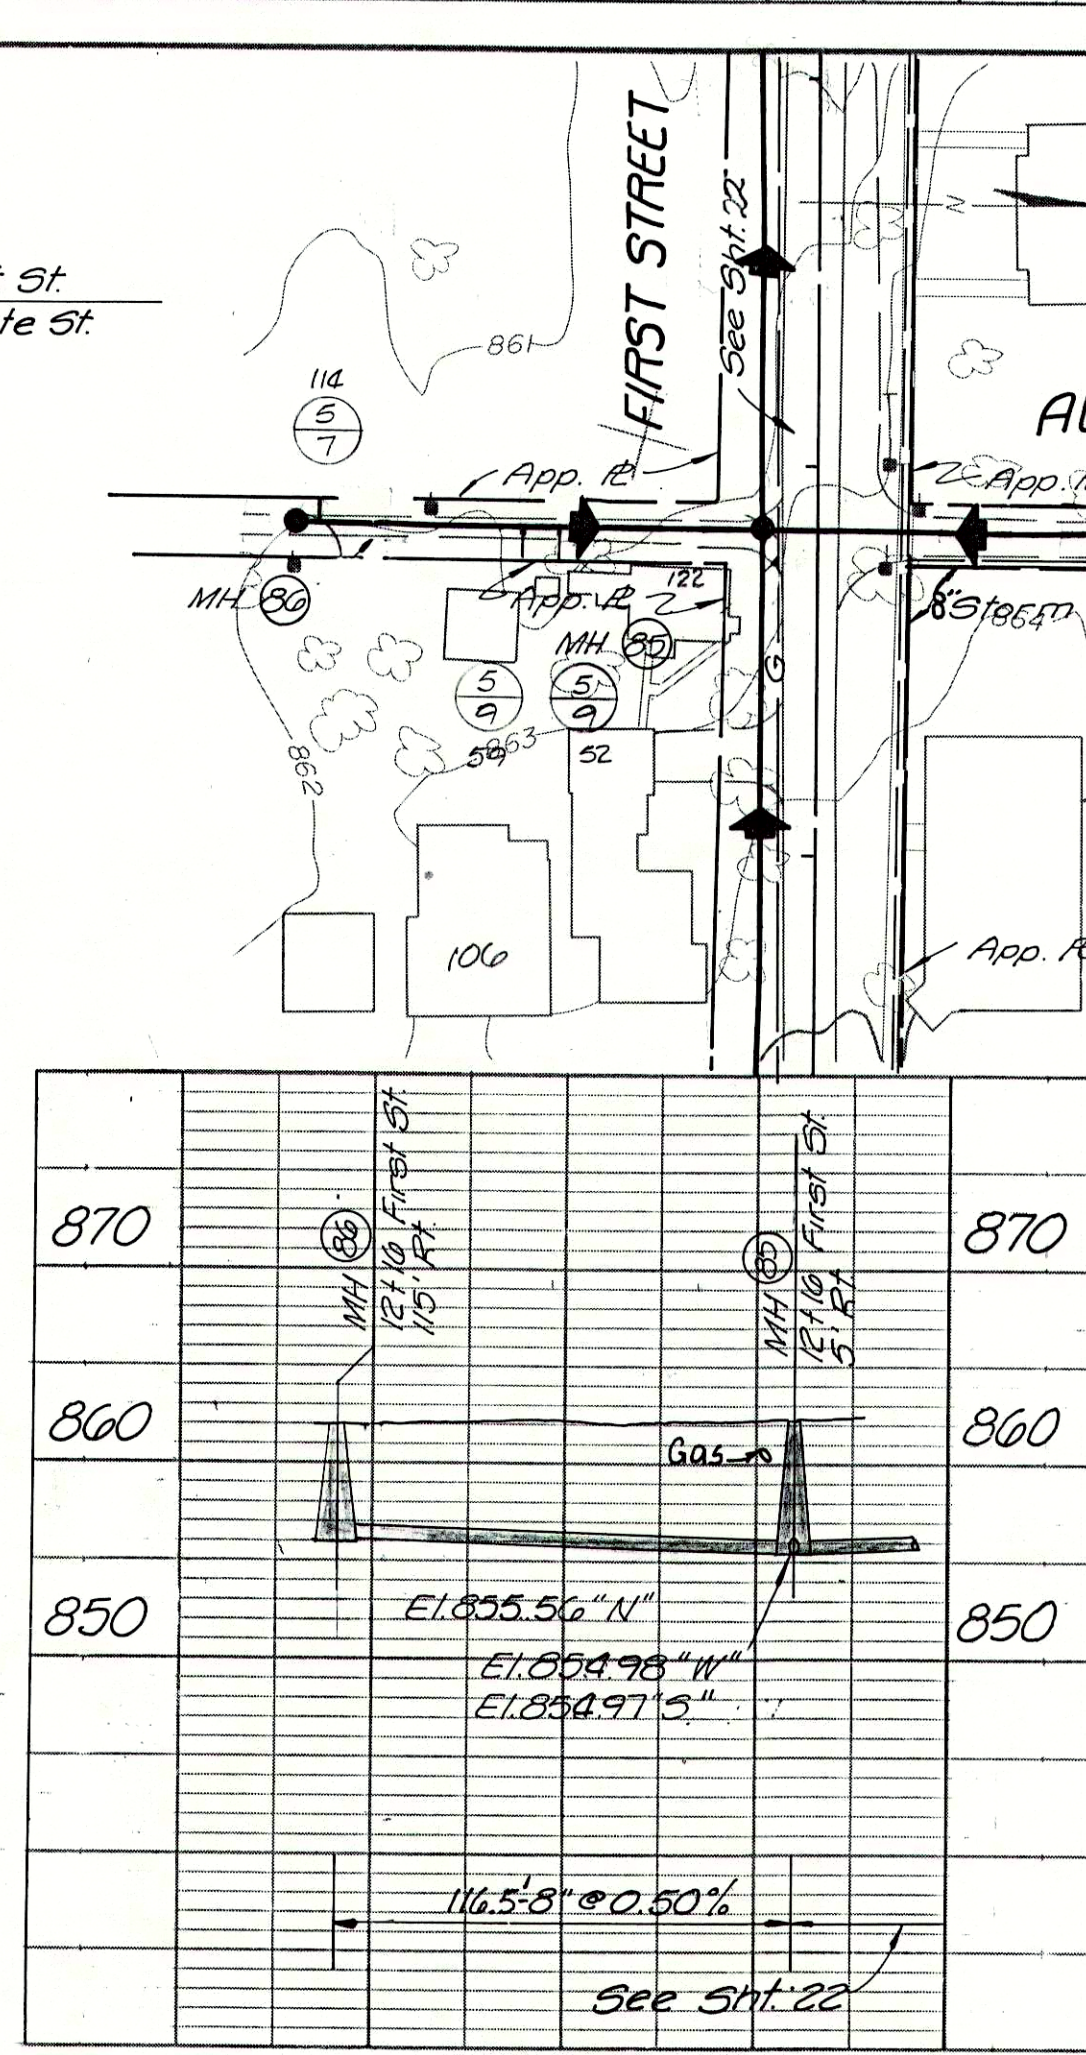
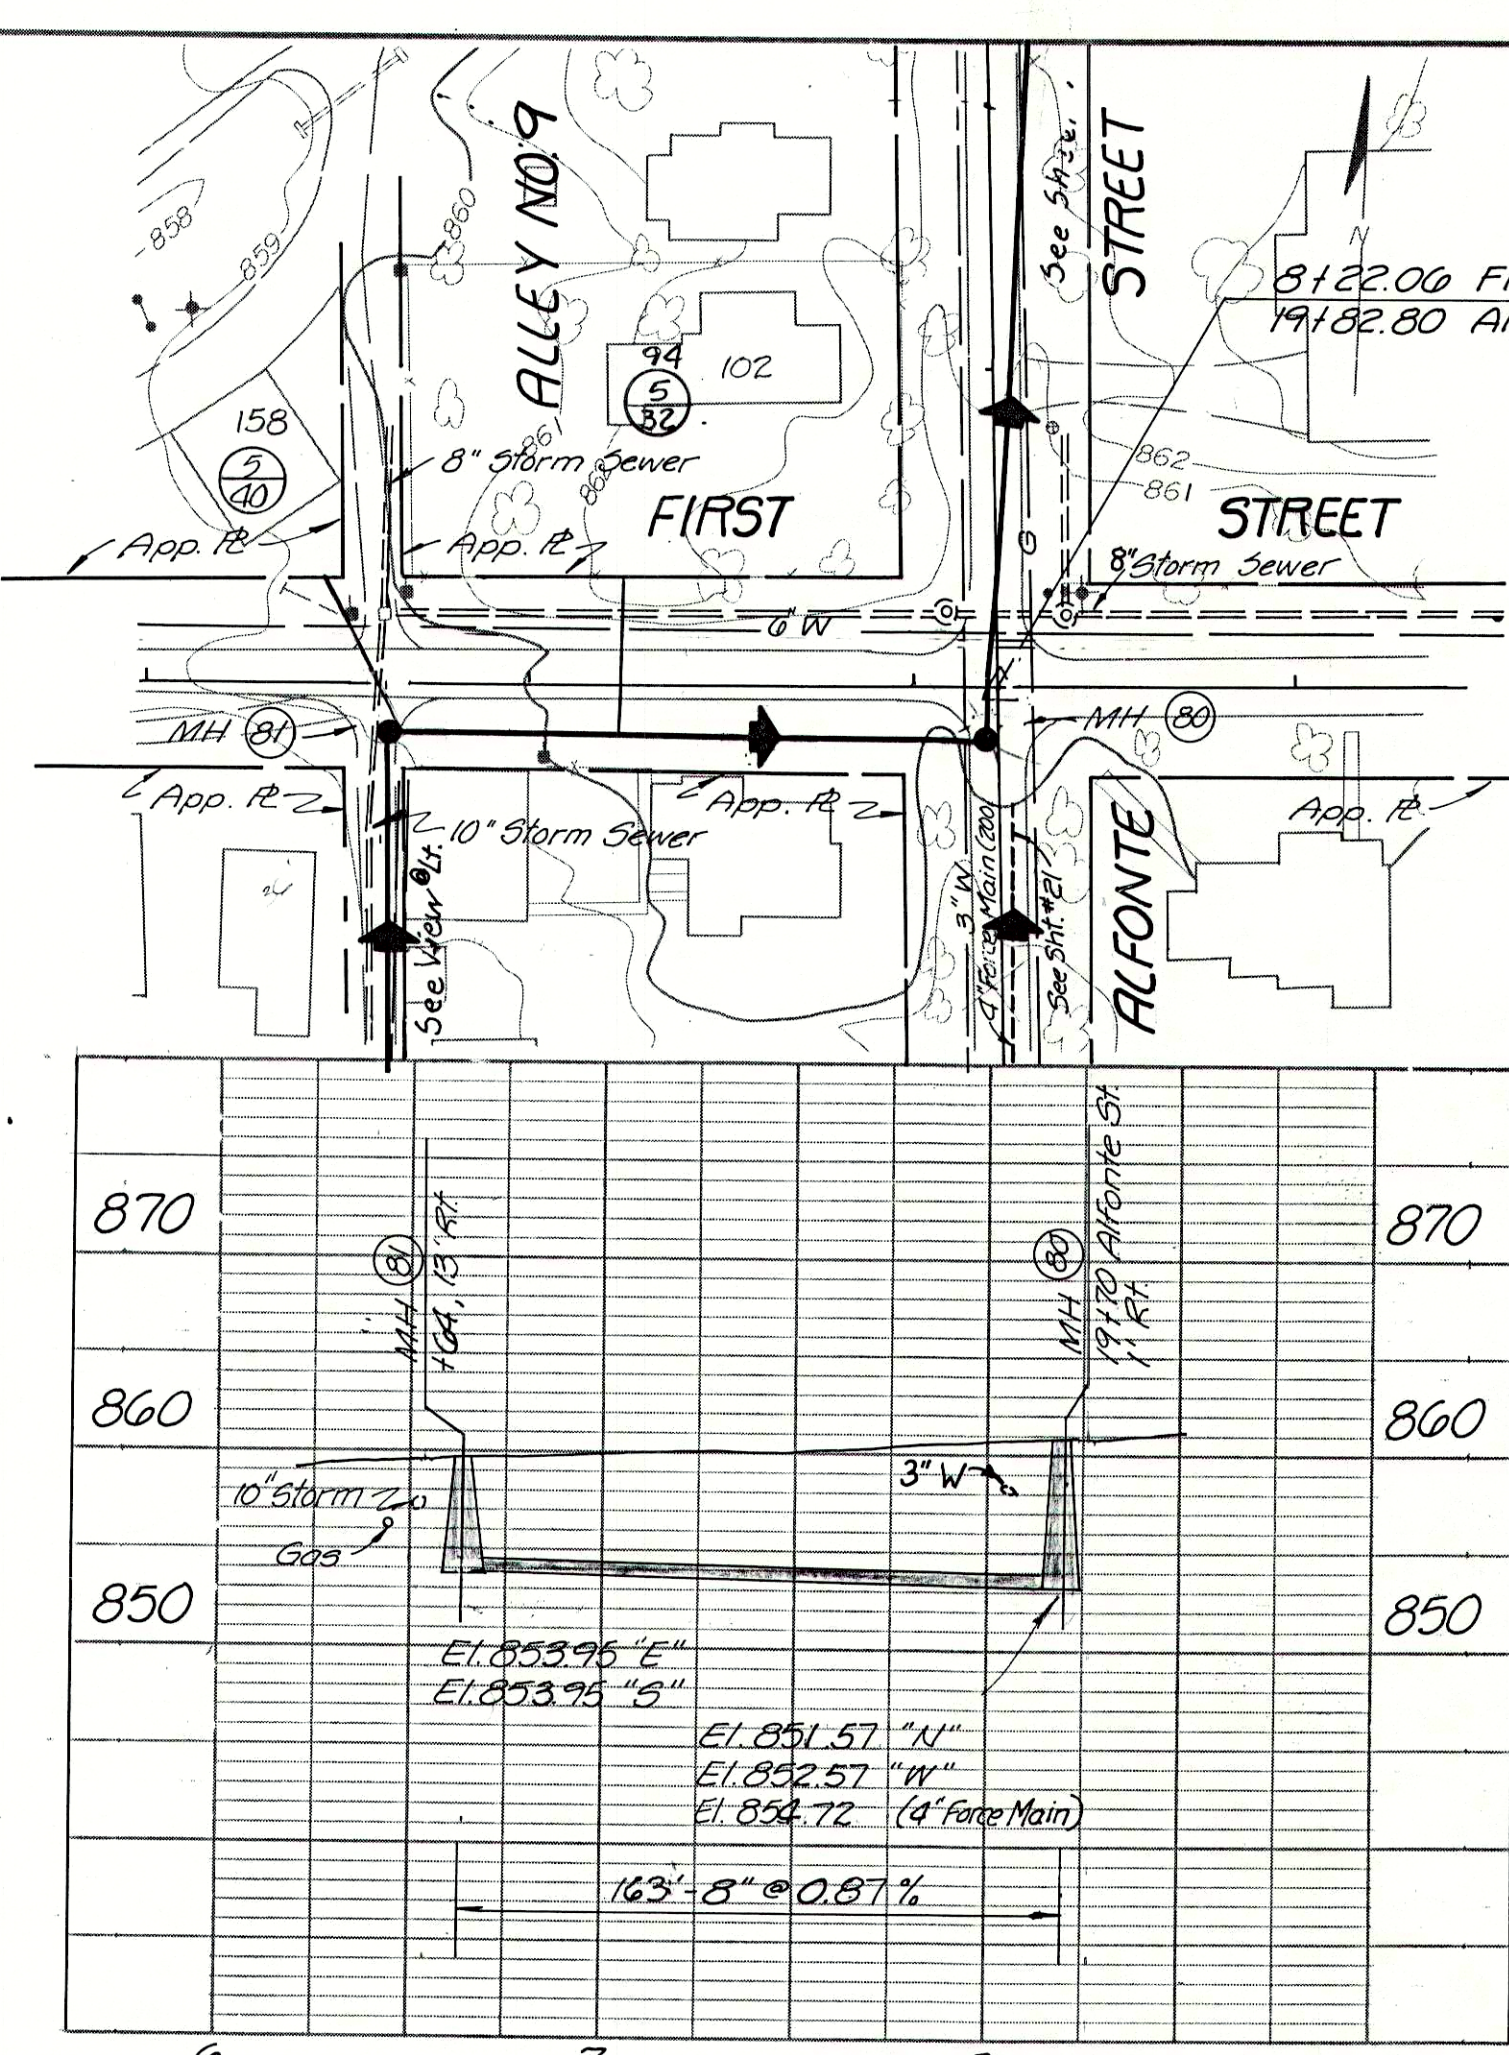
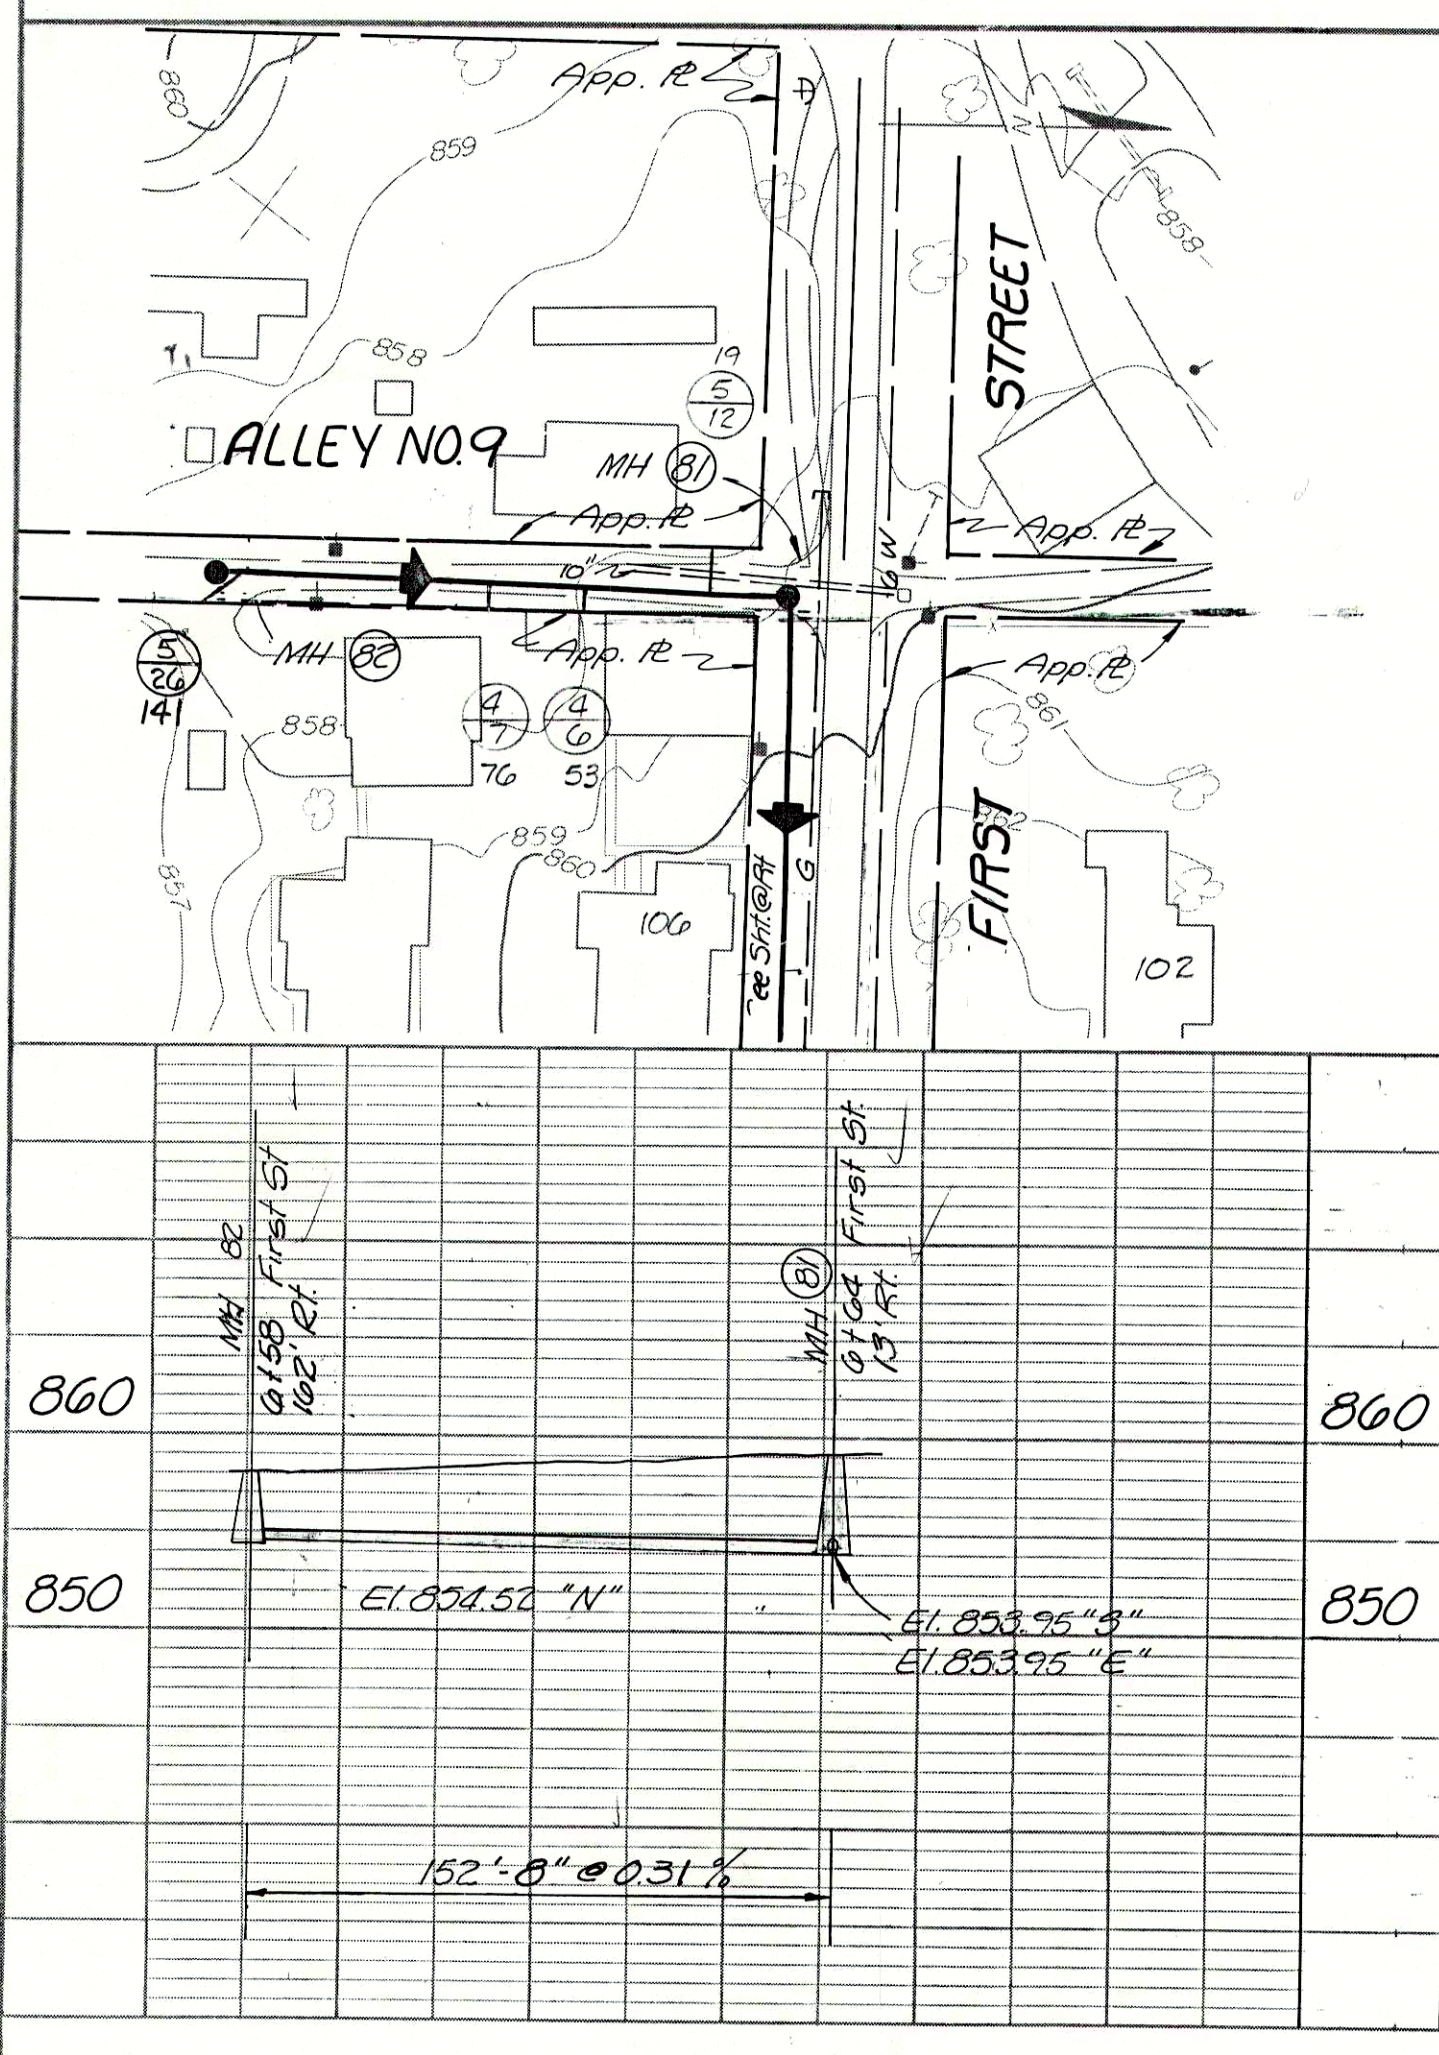
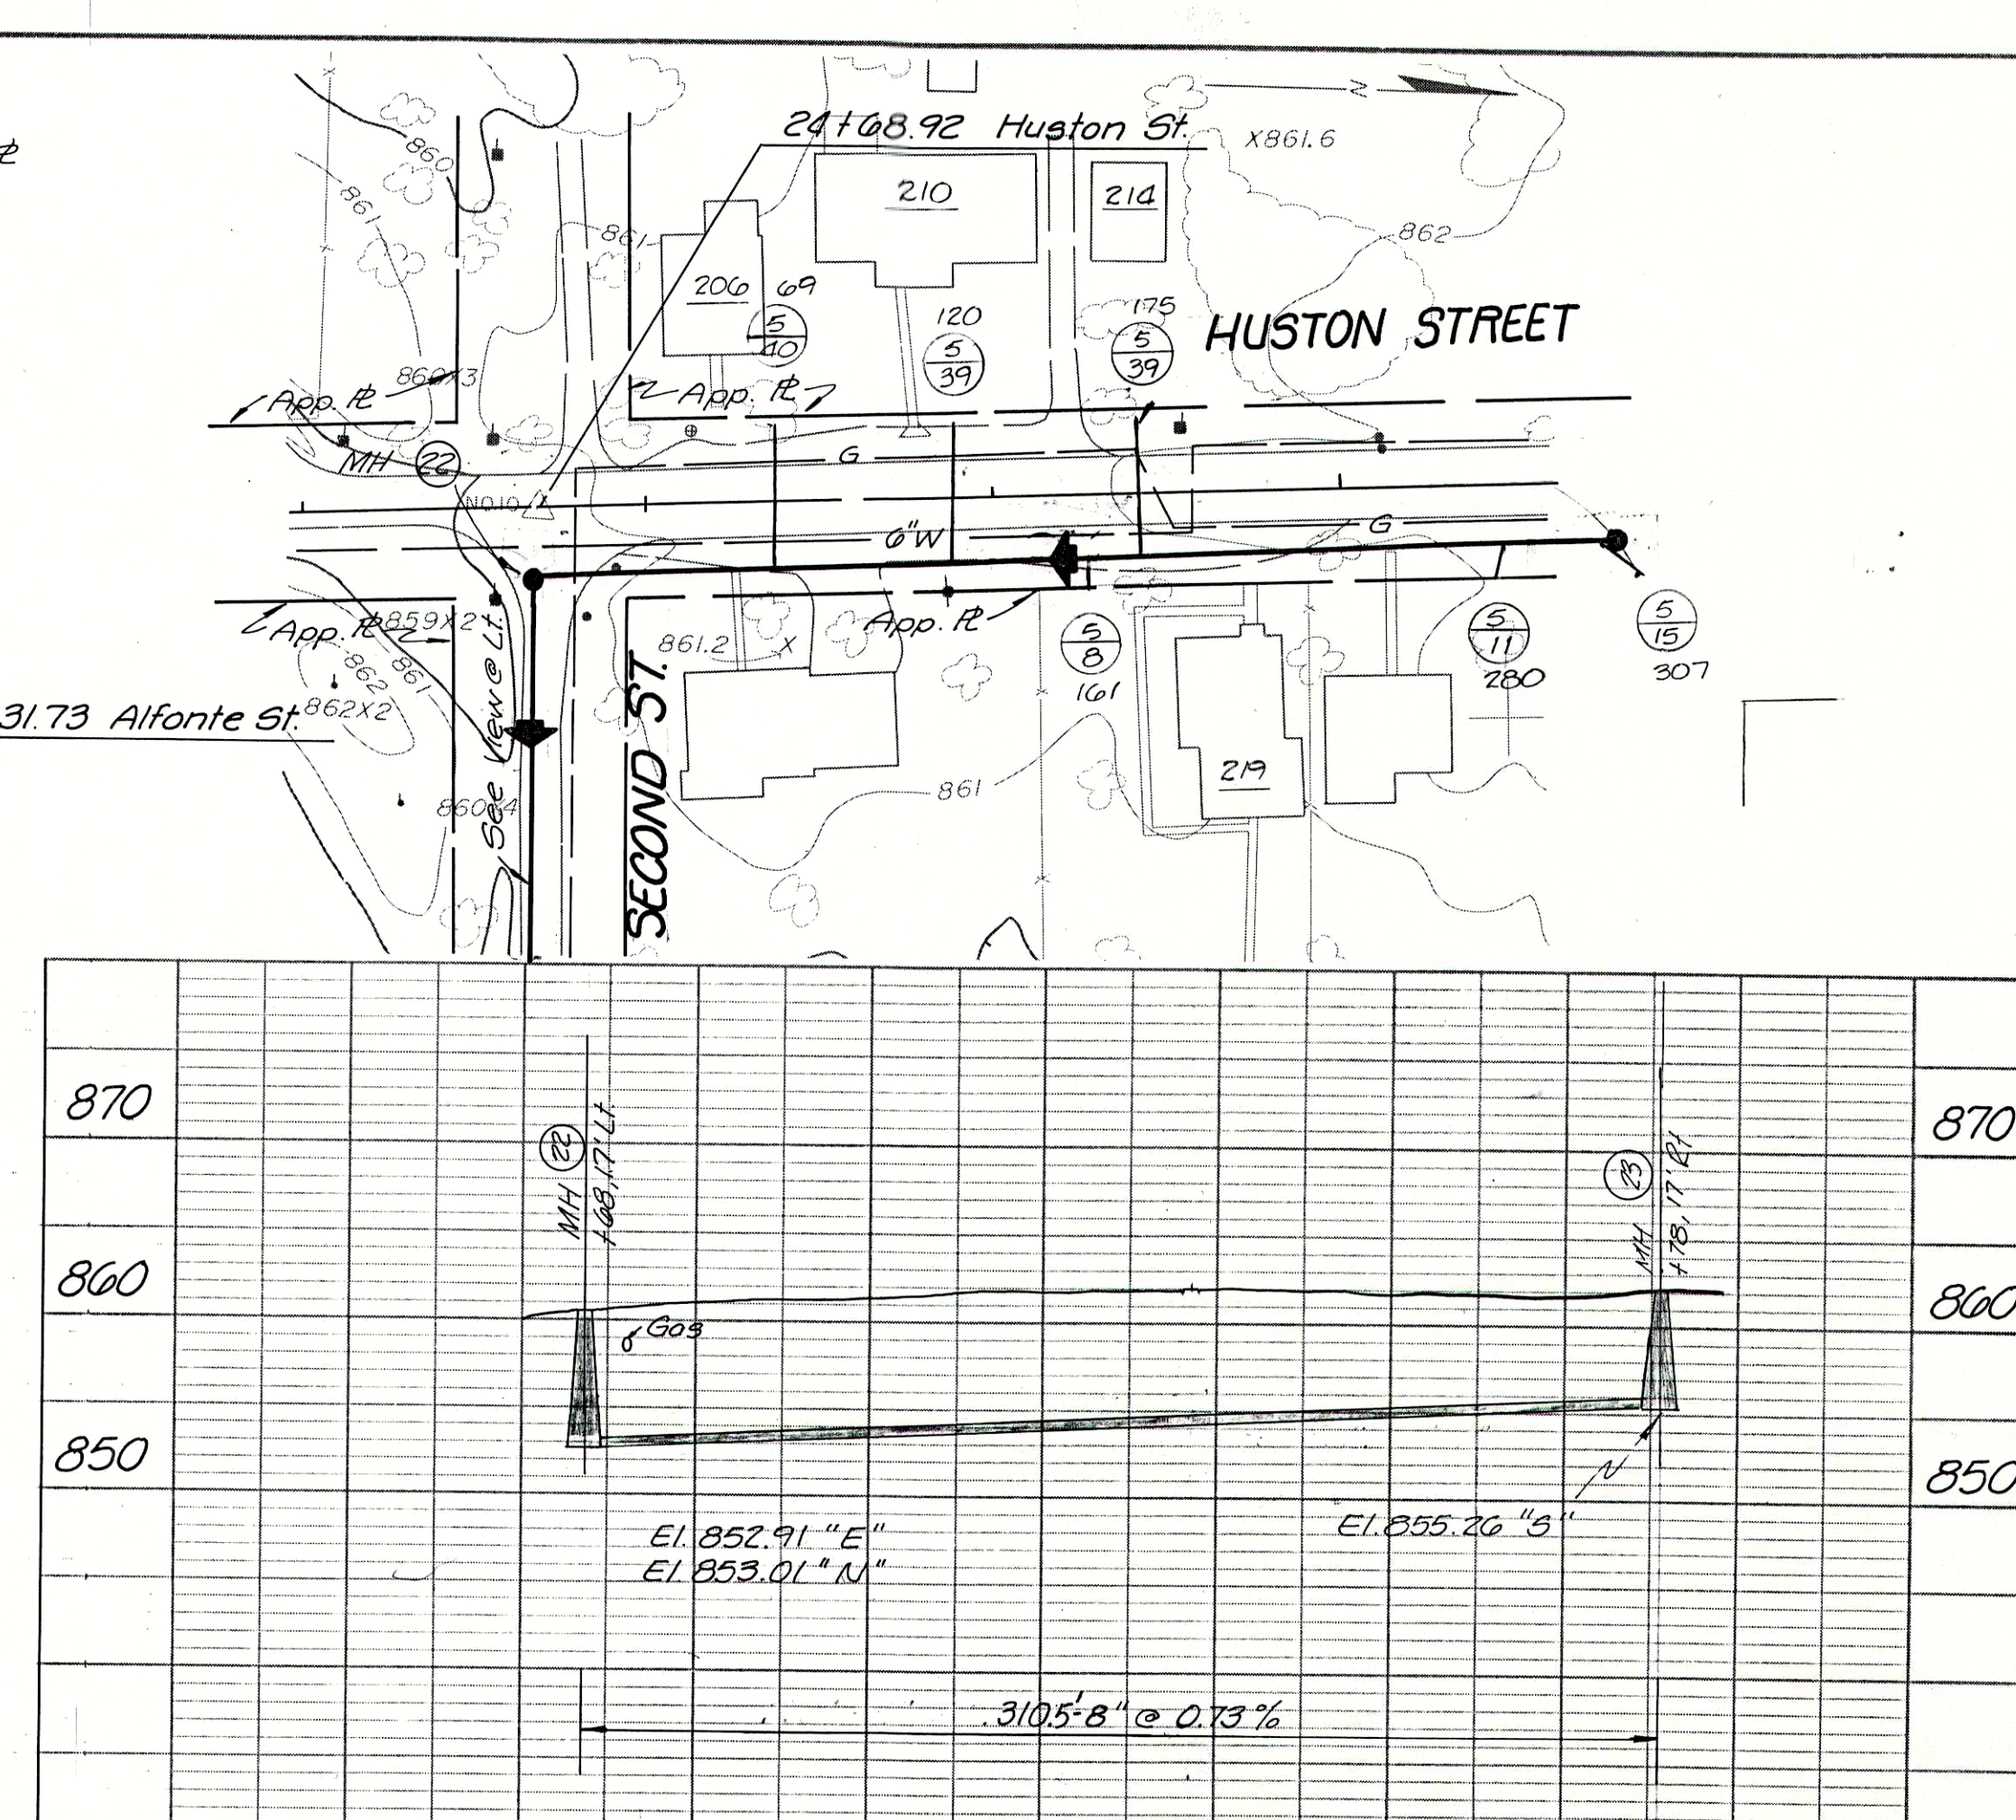


PLAN	SURVEYED	DATE
	PLANNED	BY
	NOTED	BY
	NO.	NO.

PROFILE	SURVEYED	DATE
	PLANNED	BY
	NOTED	BY
	NO.	NO.

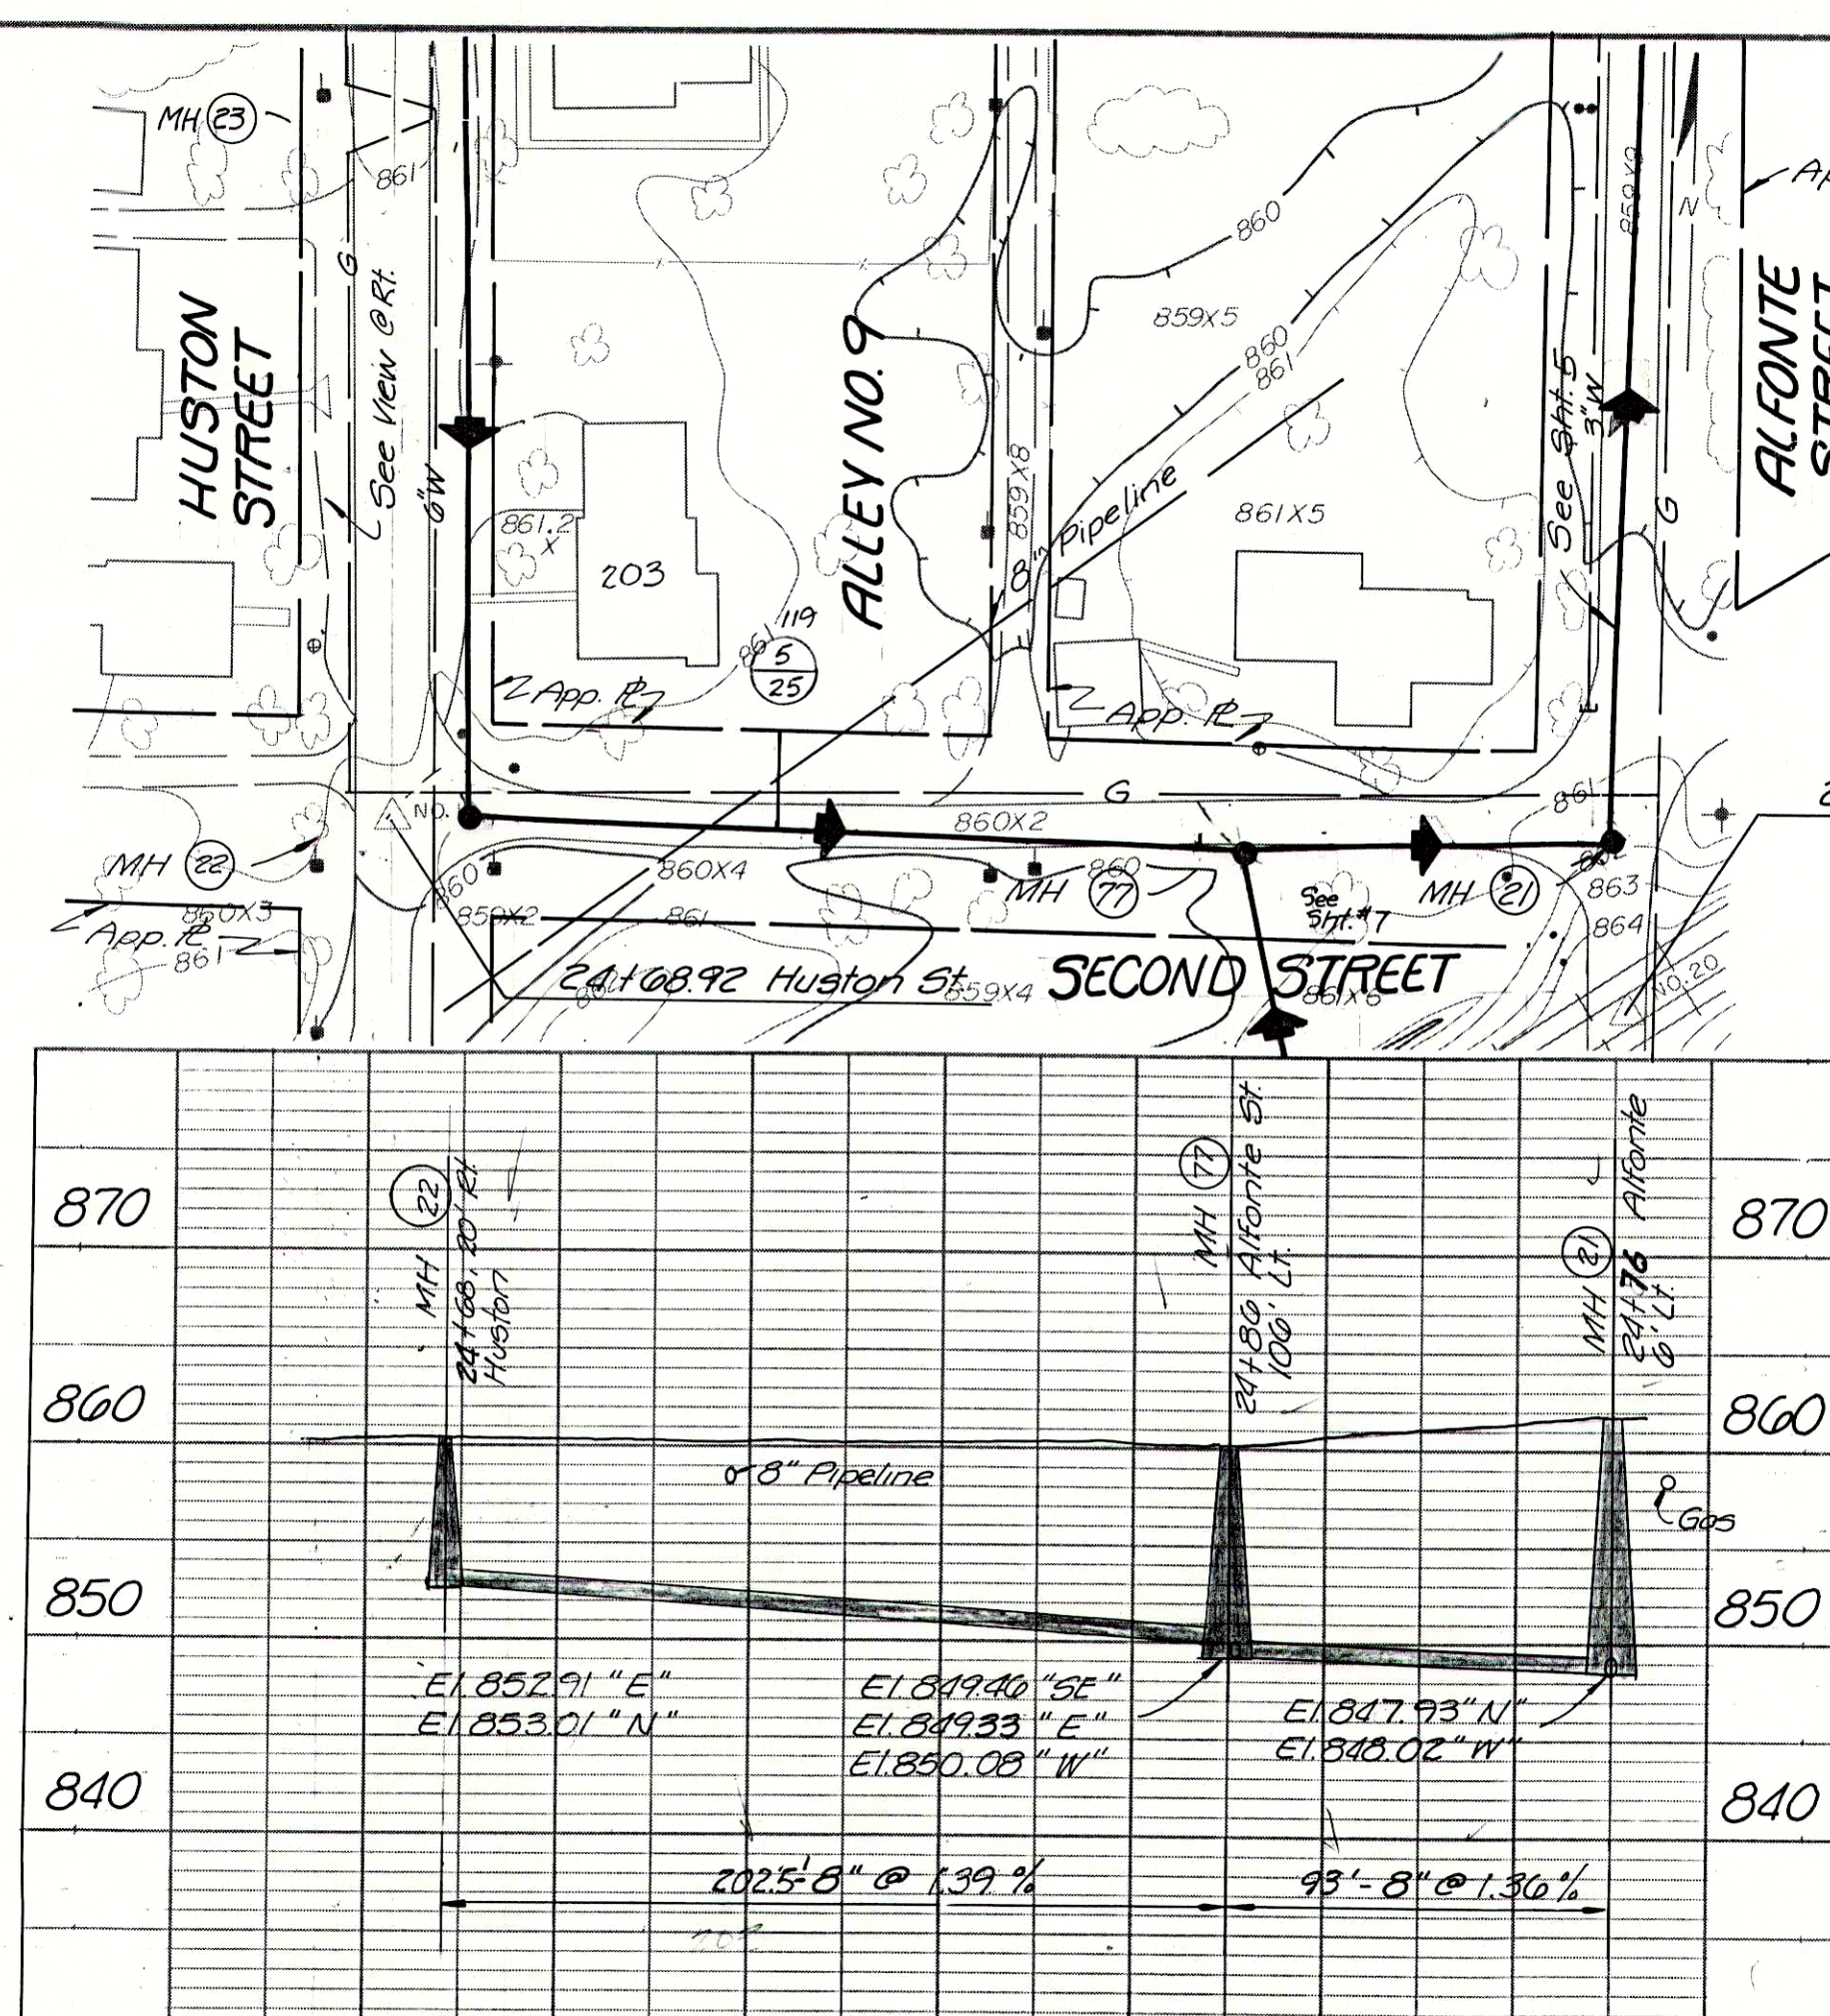

RECORD DRAWING

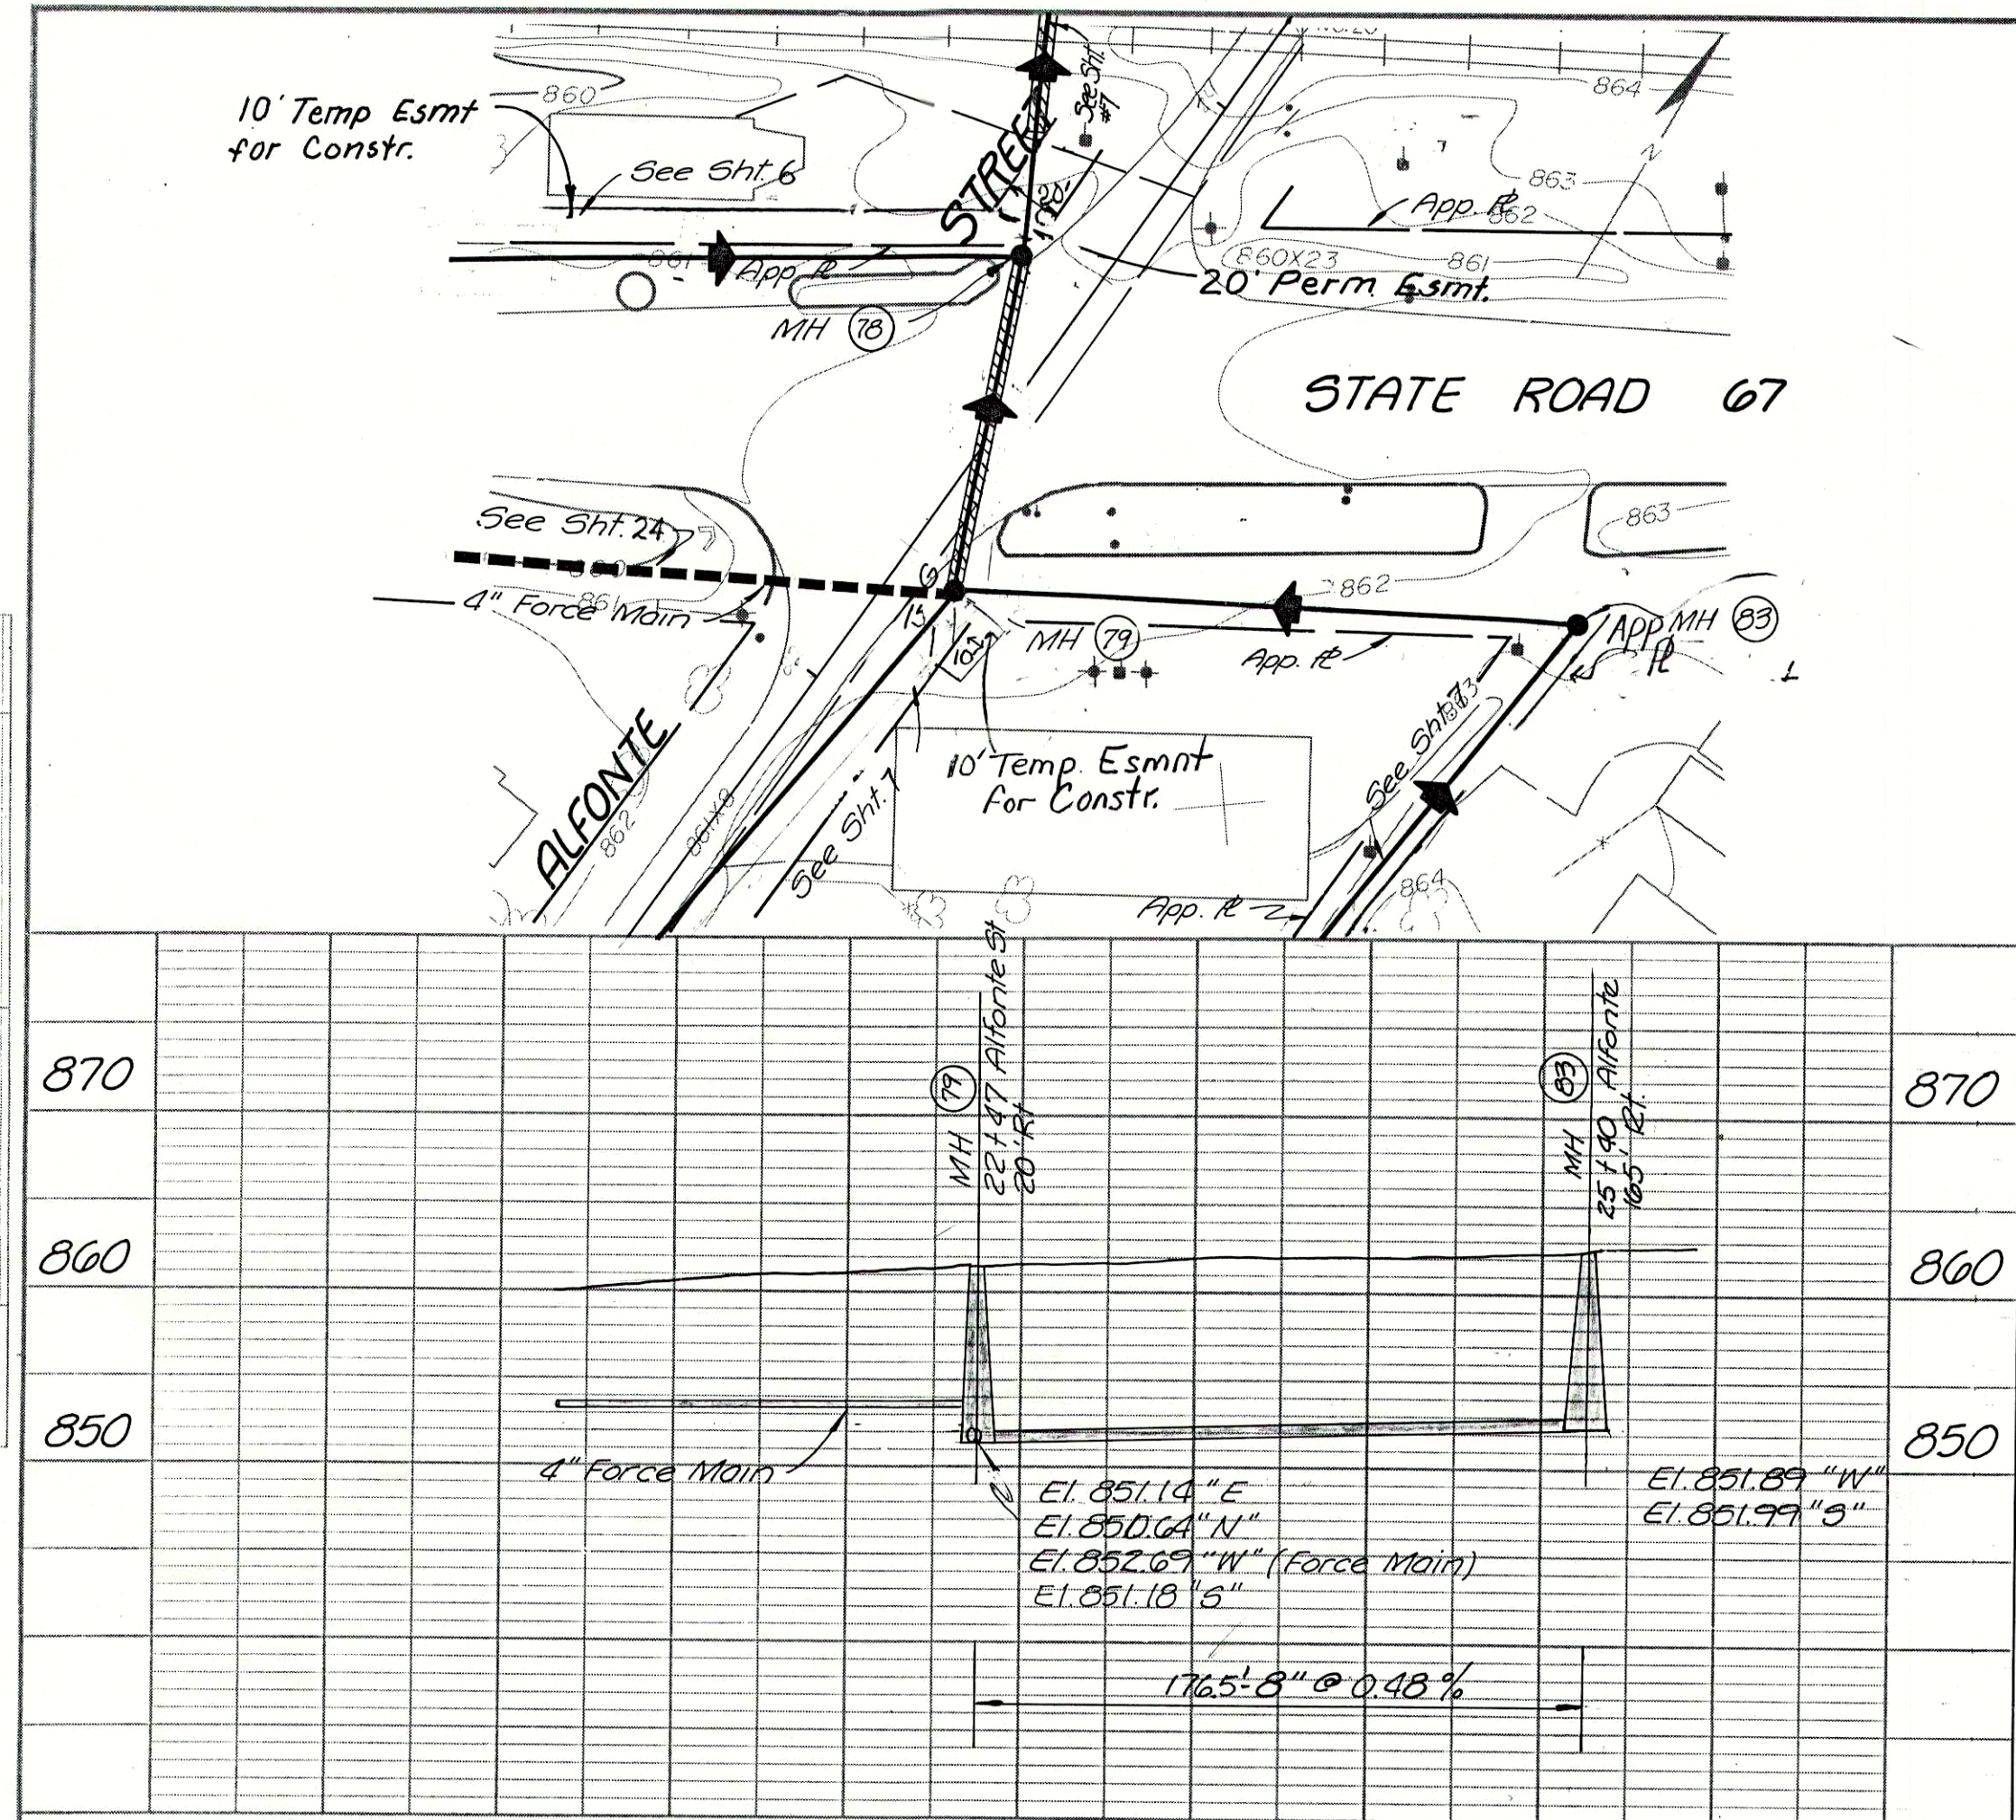

(Note) 1/4"

ALLEYS #7, #9, HUSTON ST.
FIRST ST., SECOND ST., S.R. 67
FALL CREEK R.W.D. PLAN & PROFILE SHEET

HORIZ. 1"=50'
VERT. 1"=10'

BEAM, LONGEST & NEFF, INC.
CONSULTING ENGINEERS
INDIANAPOLIS, INDIANA

8