


PLAN
SURVEYED
NOTED
NO.

PROFILE
SURVEYED
NOTED
NO.



RECORD DRAWING

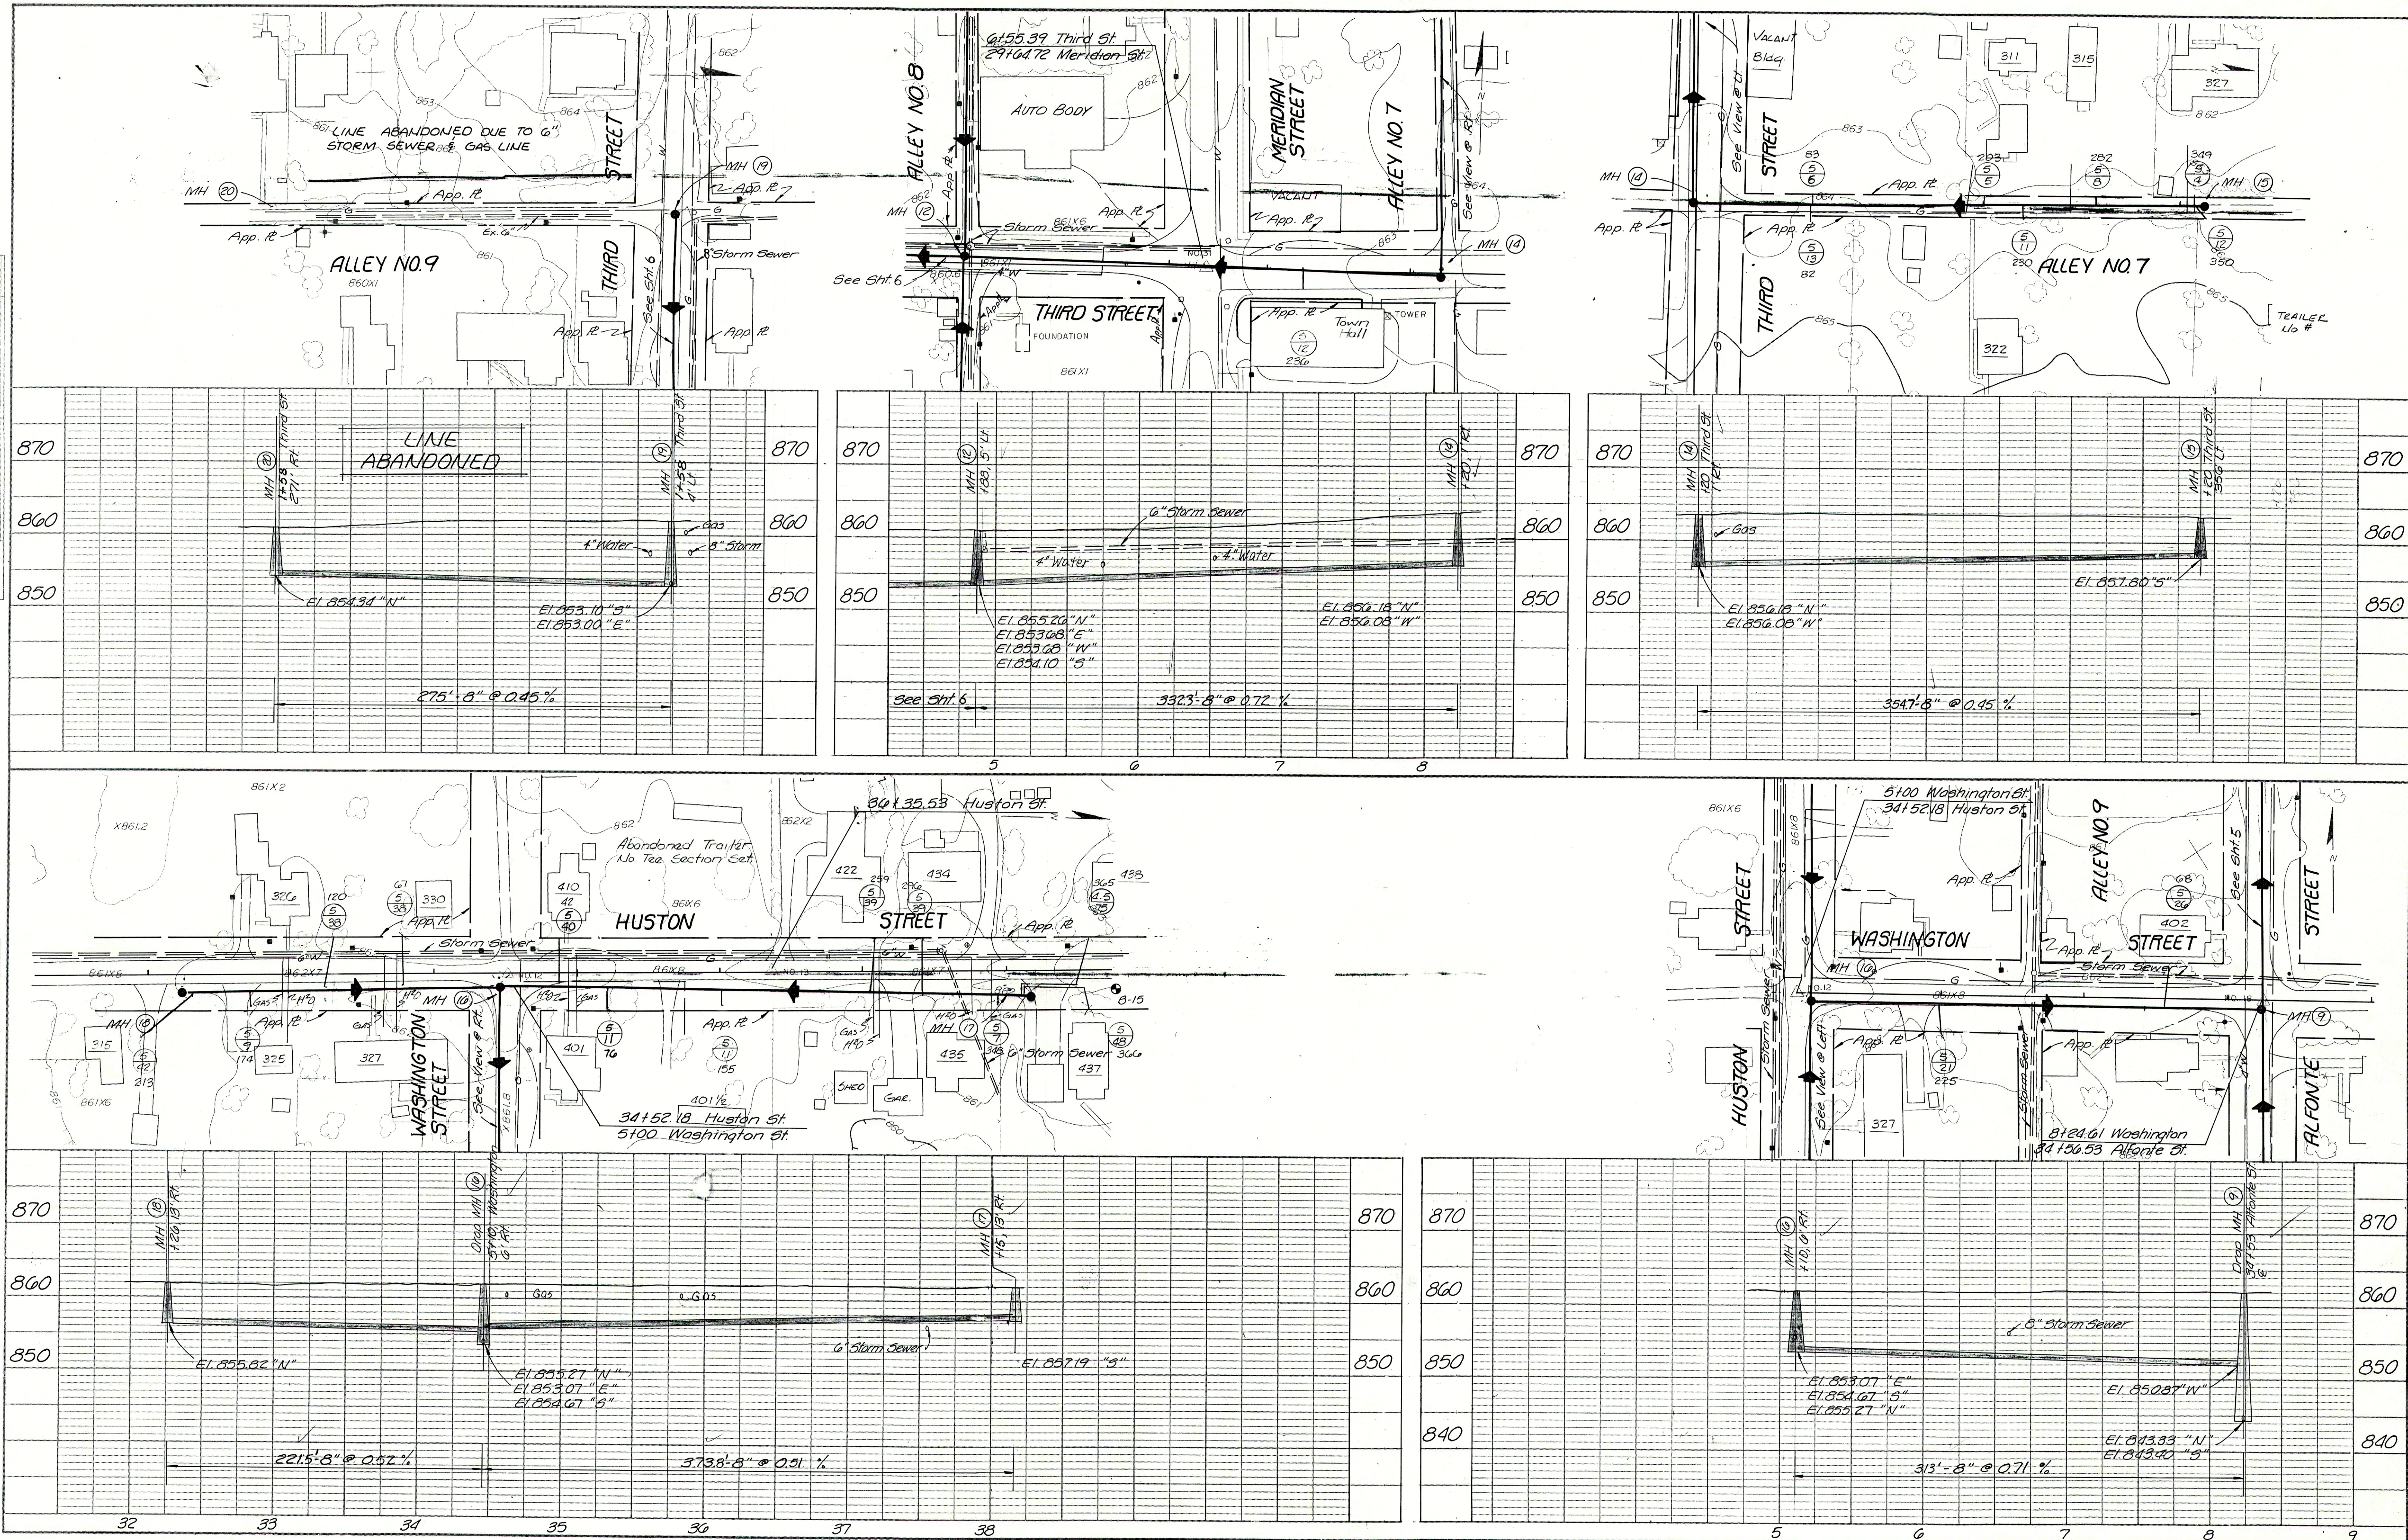

ALLEYS #7 & #9 WASHINGTON ST.
HUSTON ST. THIRD ST.
FALL CREEK R.W.D. PLAN & PROFILE SHEET
HORIZ. 1"=50'
VERT. 1"=10'
BEAM, LONGEST & NEFF, INC.
CONSULTING ENGINEERS
INDIANAPOLIS, INDIANA
9