



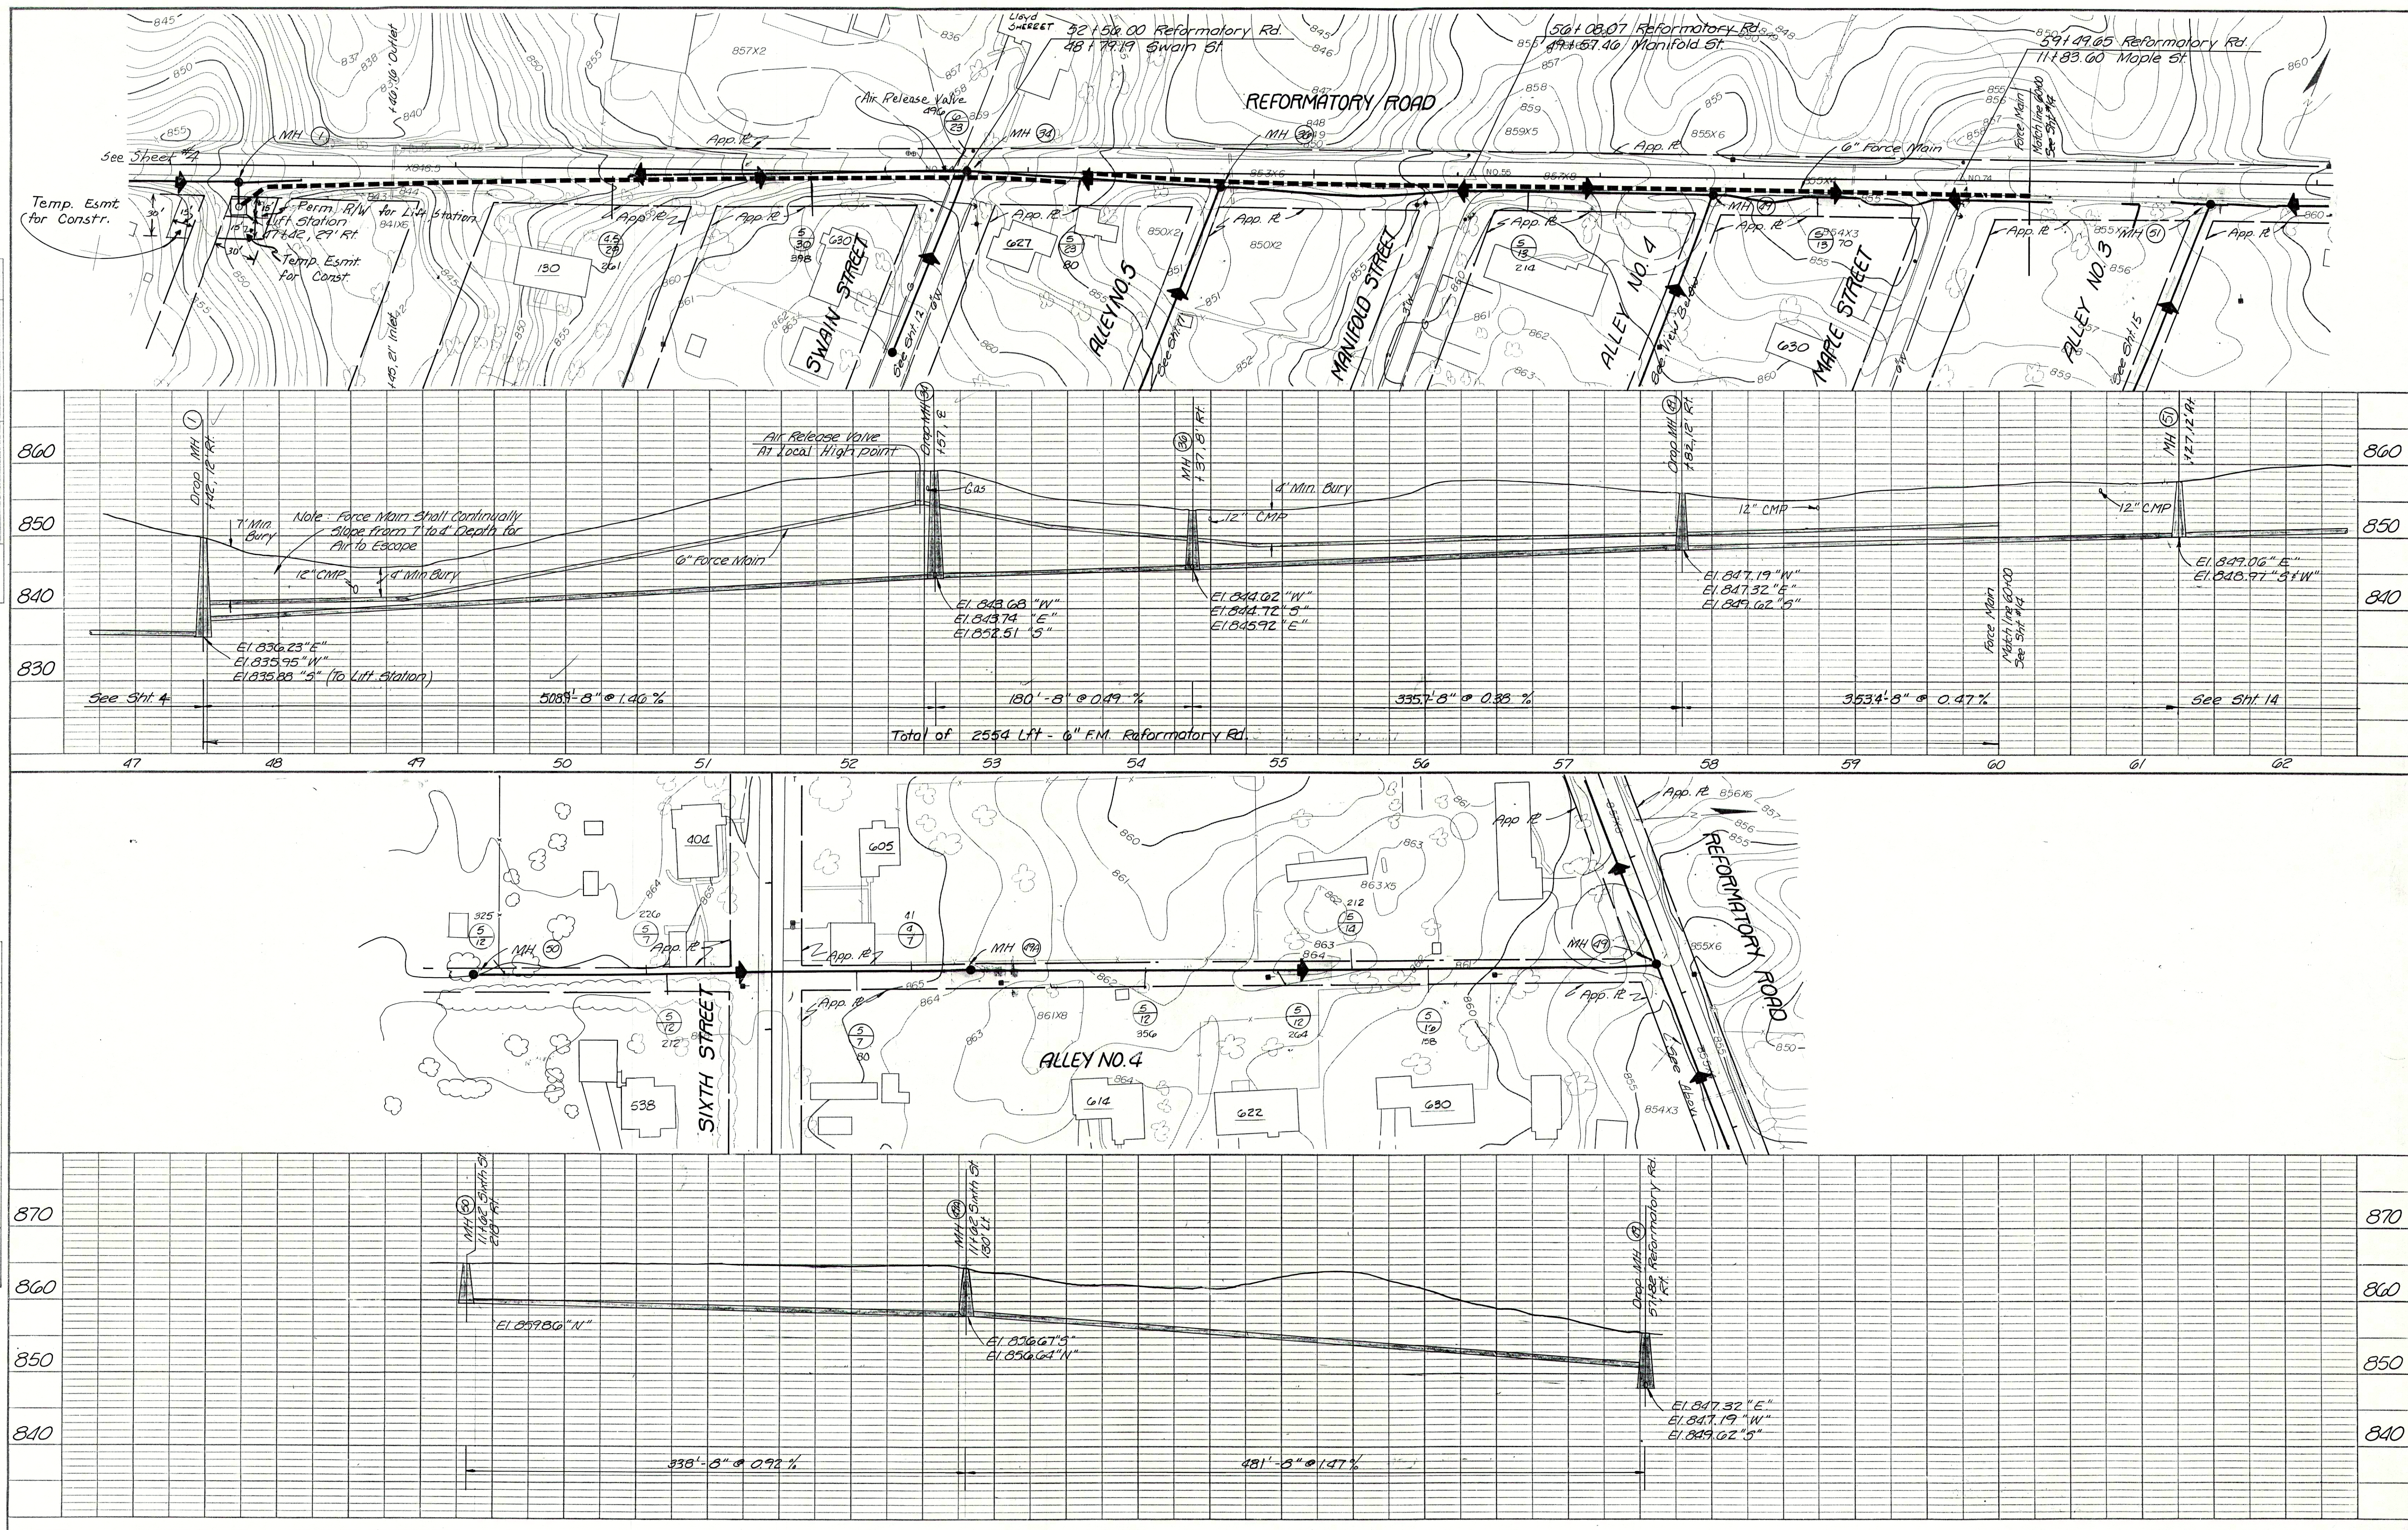

RECORD DRAWING

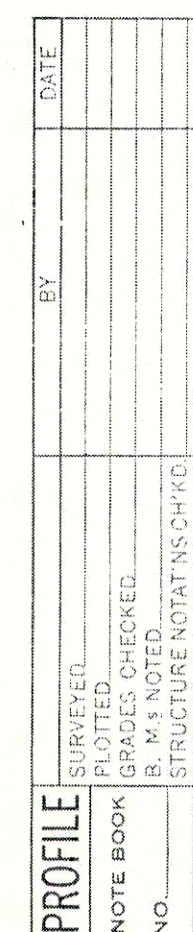

REFORMATORY RD. ALLEY #4		SHEET 10
FALL CREEK R.W.D. PLAN & PROFILE		
HORIZ. 1"=50'	BEAM, LONGEST & NEFF, INC.	
VERT. 1"=10'	CONSULTING ENGINEERS INDIANAPOLIS, INDIANA	