
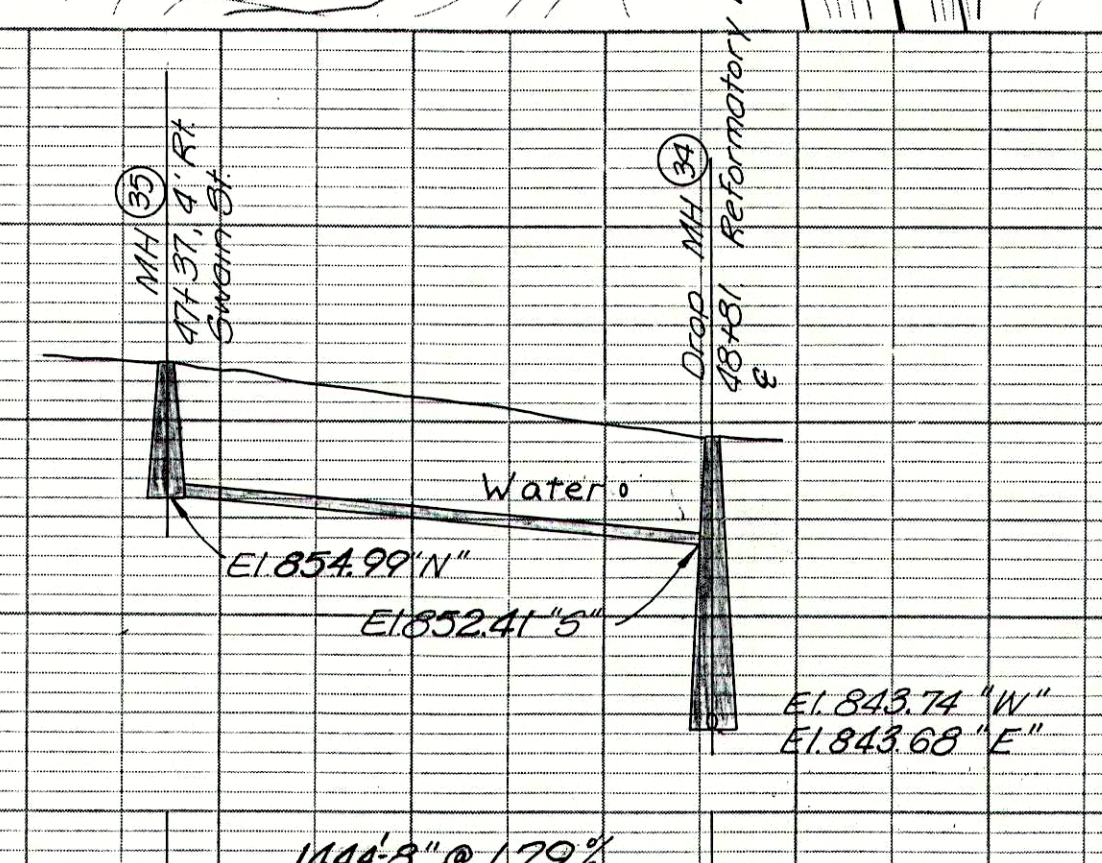
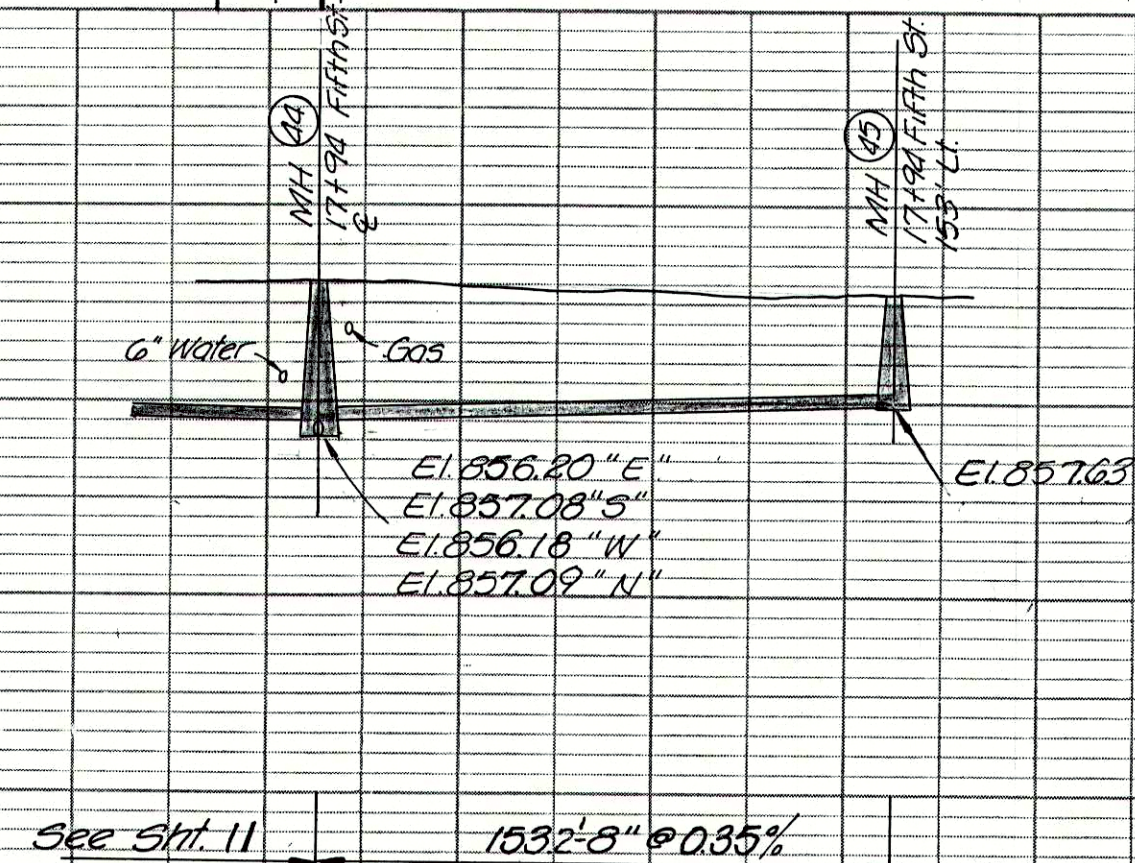
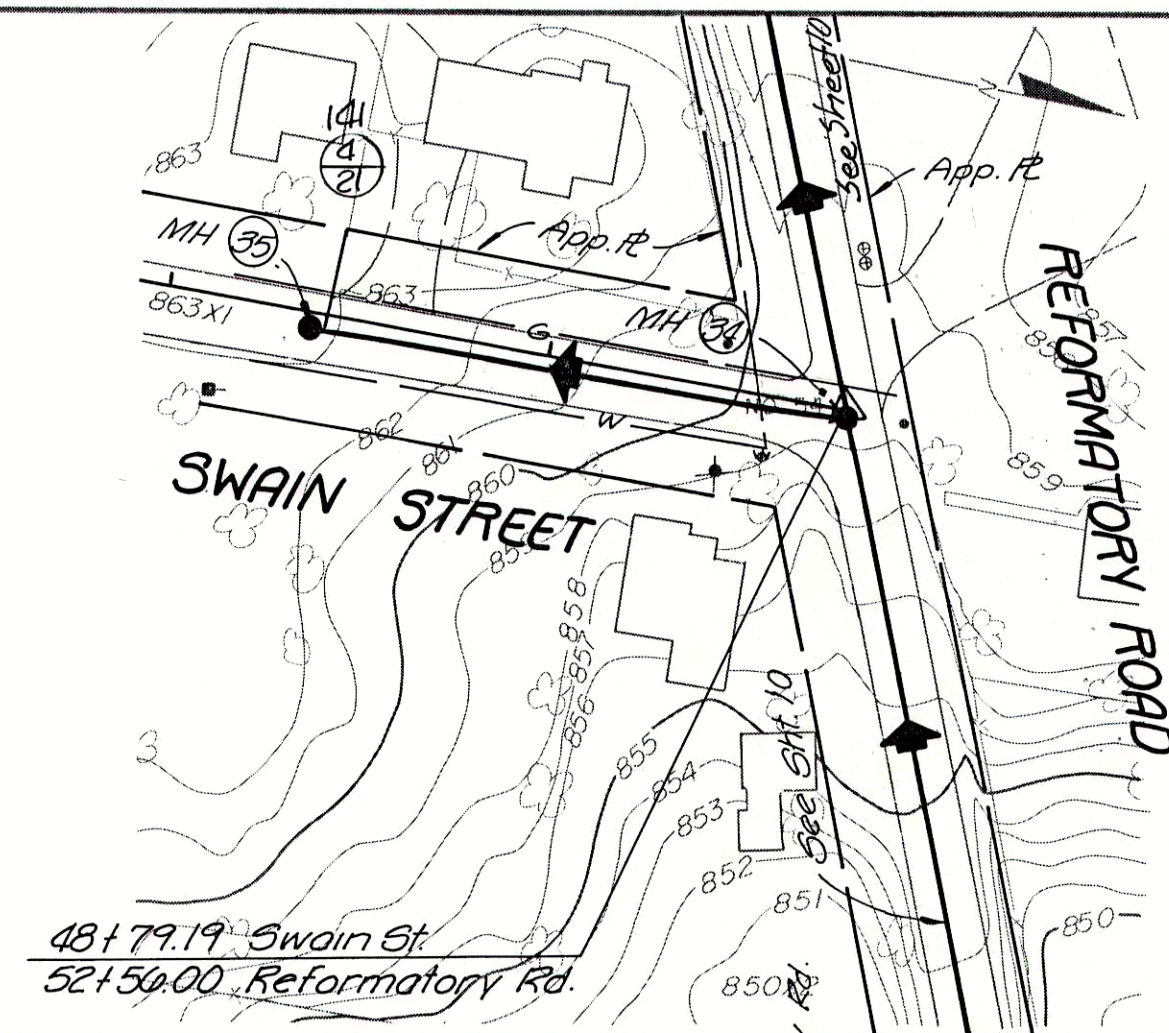
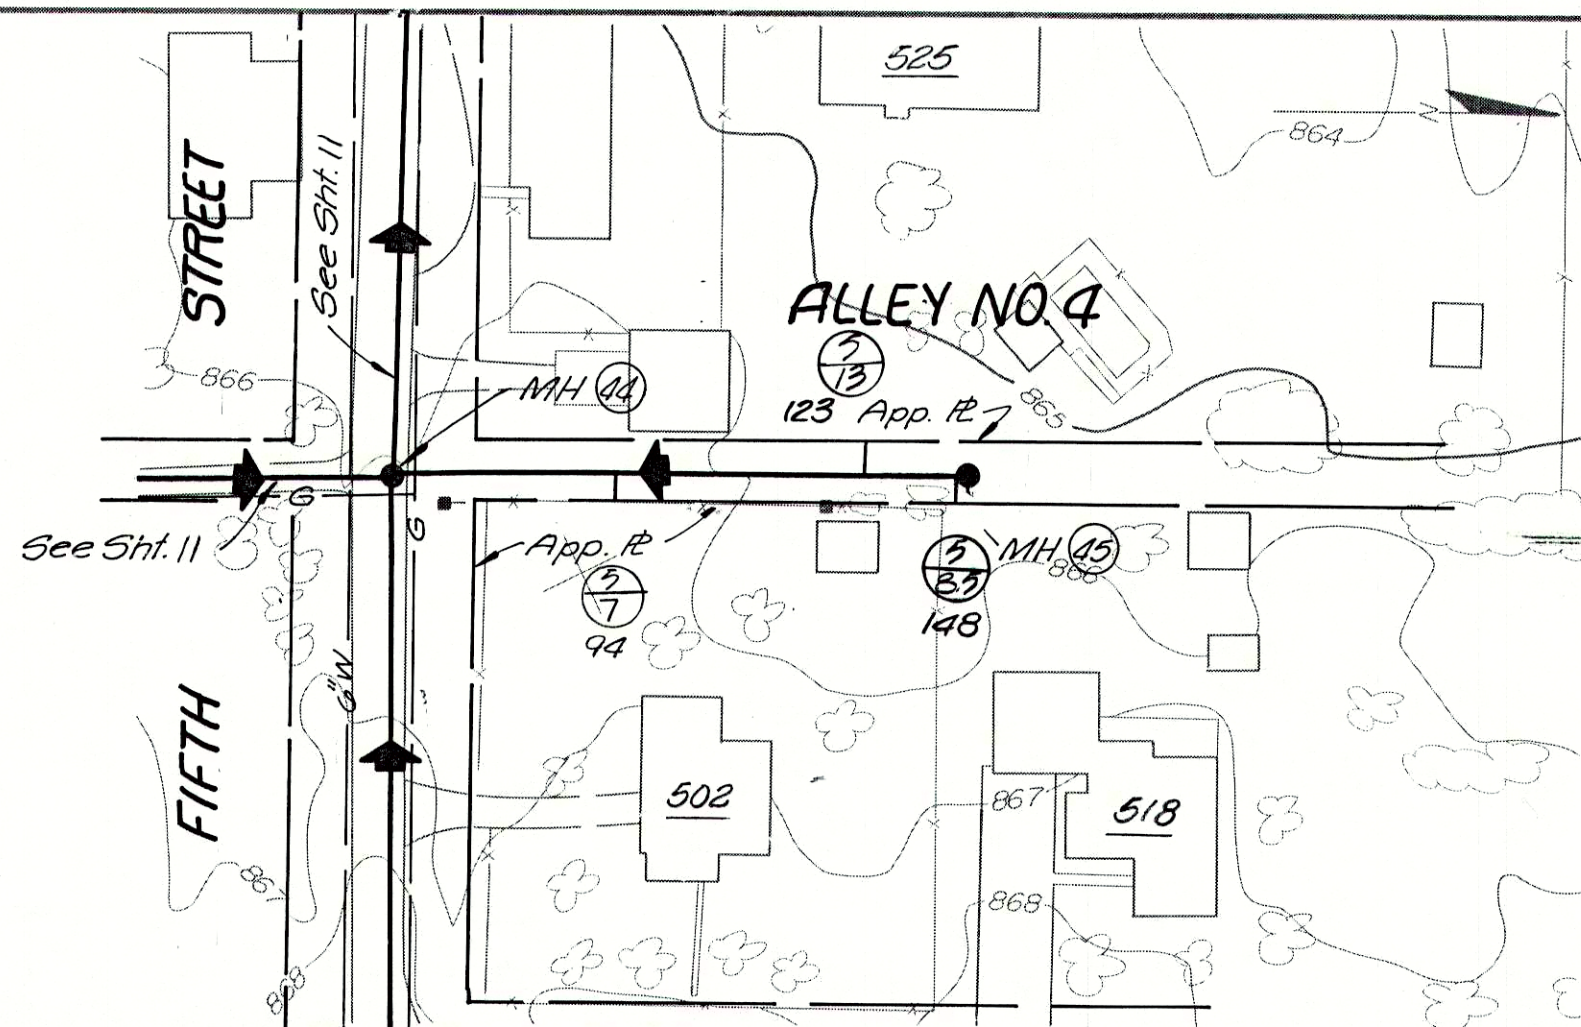


PLAN
SURVEYED
NOTE BOOK
NO. _____
ALIGNMENT CHECKED
RT. OF WAY CHECKED

PROFILE
SURVEYED
NOTE BOOK
NO. _____
GRADES CHECKED
STRUCTURE NOTATIONS

DATE
BY

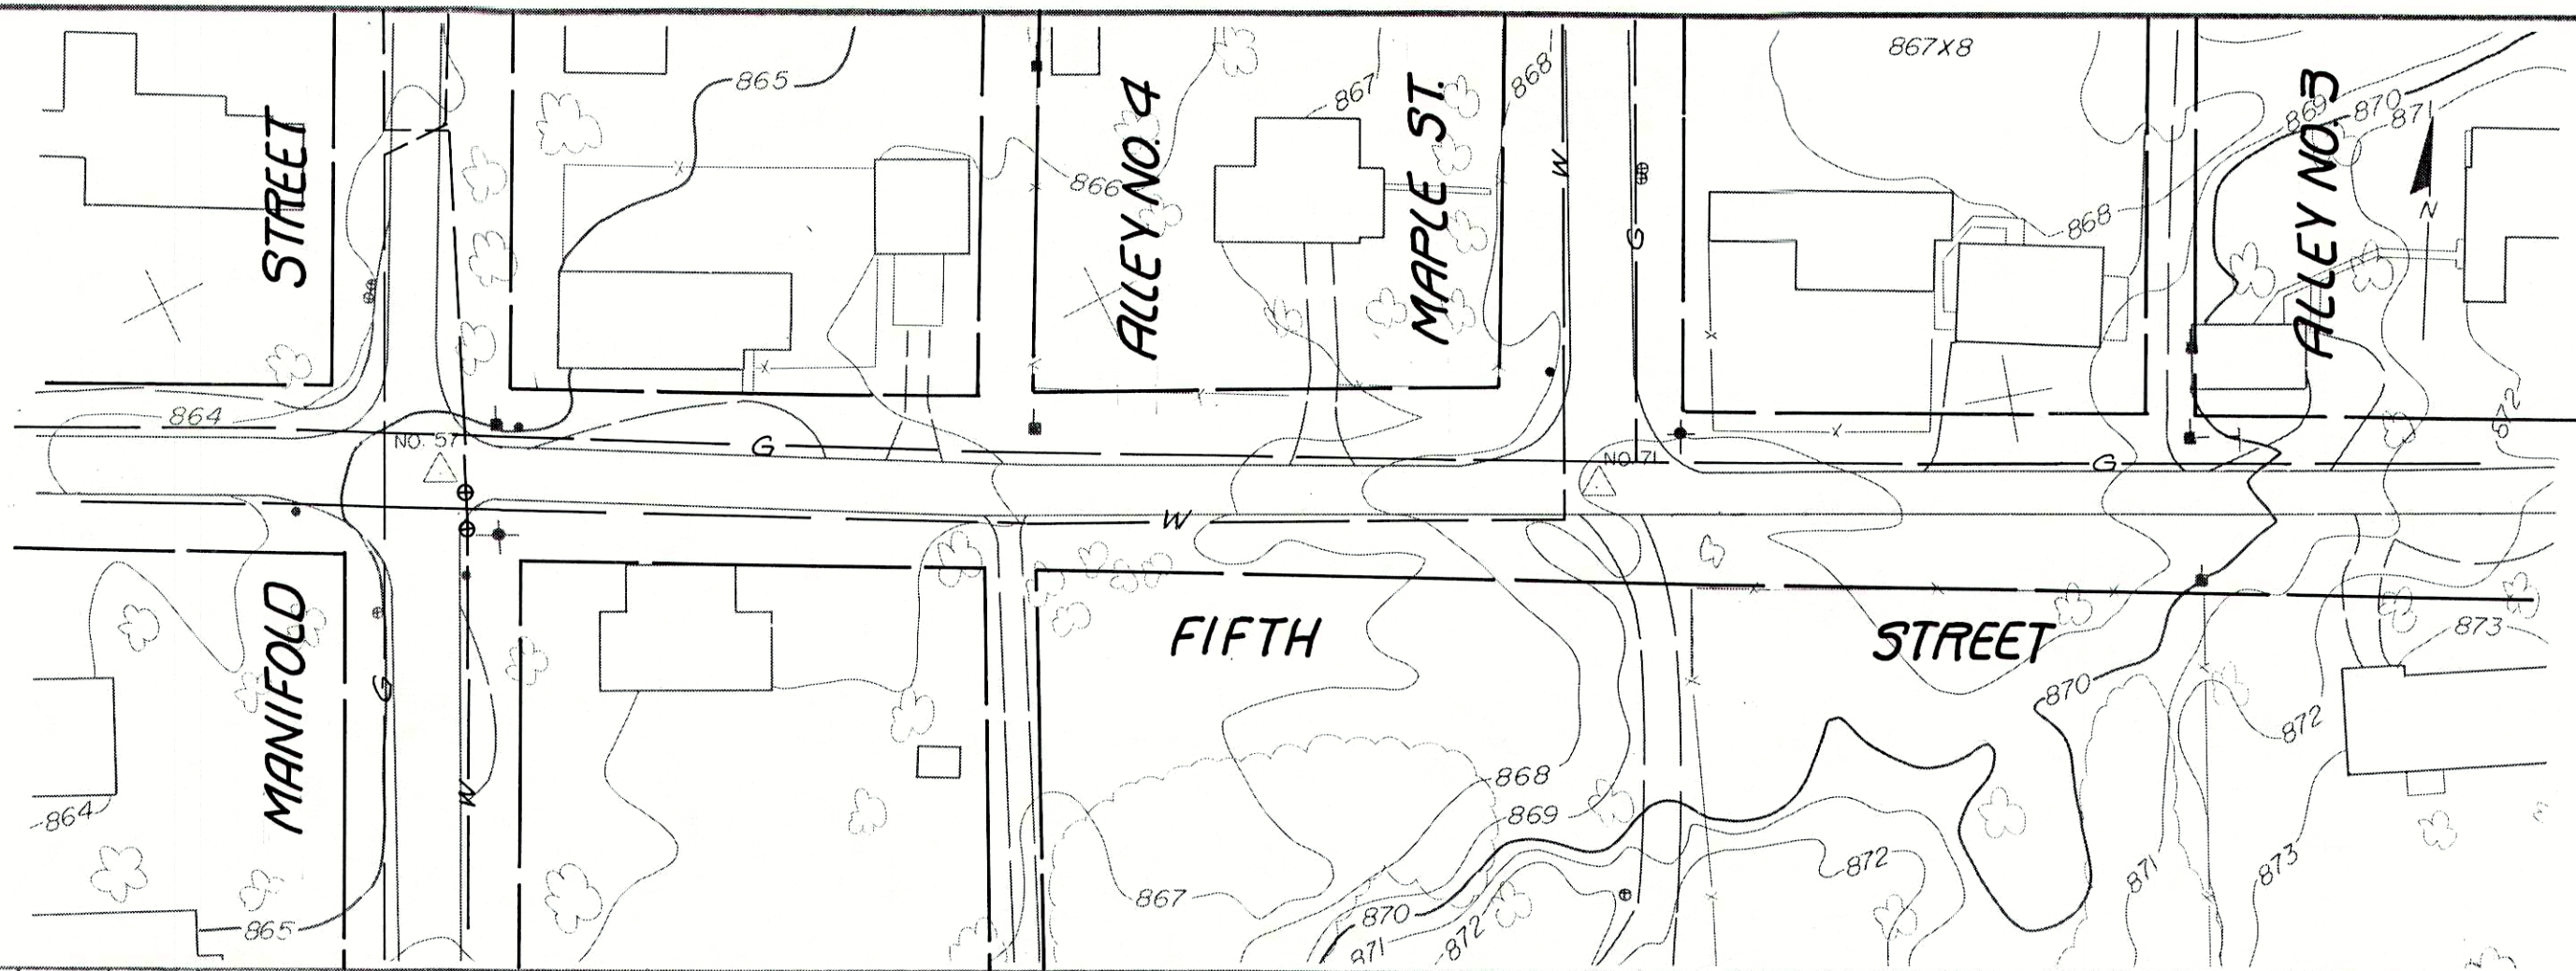

RECORD DRAWING



FIFTH ST. ALLEY #4 SWAIN ST.
FALL CREEK R.W.D. PLAN & PROFILE SHEET
HORIZ. 1"=50'
VERT. 1"=10'
BEAM, LONGEST & NEFF, INC.
CONSULTING ENGINEERS
INDIANAPOLIS, INDIANA

12