

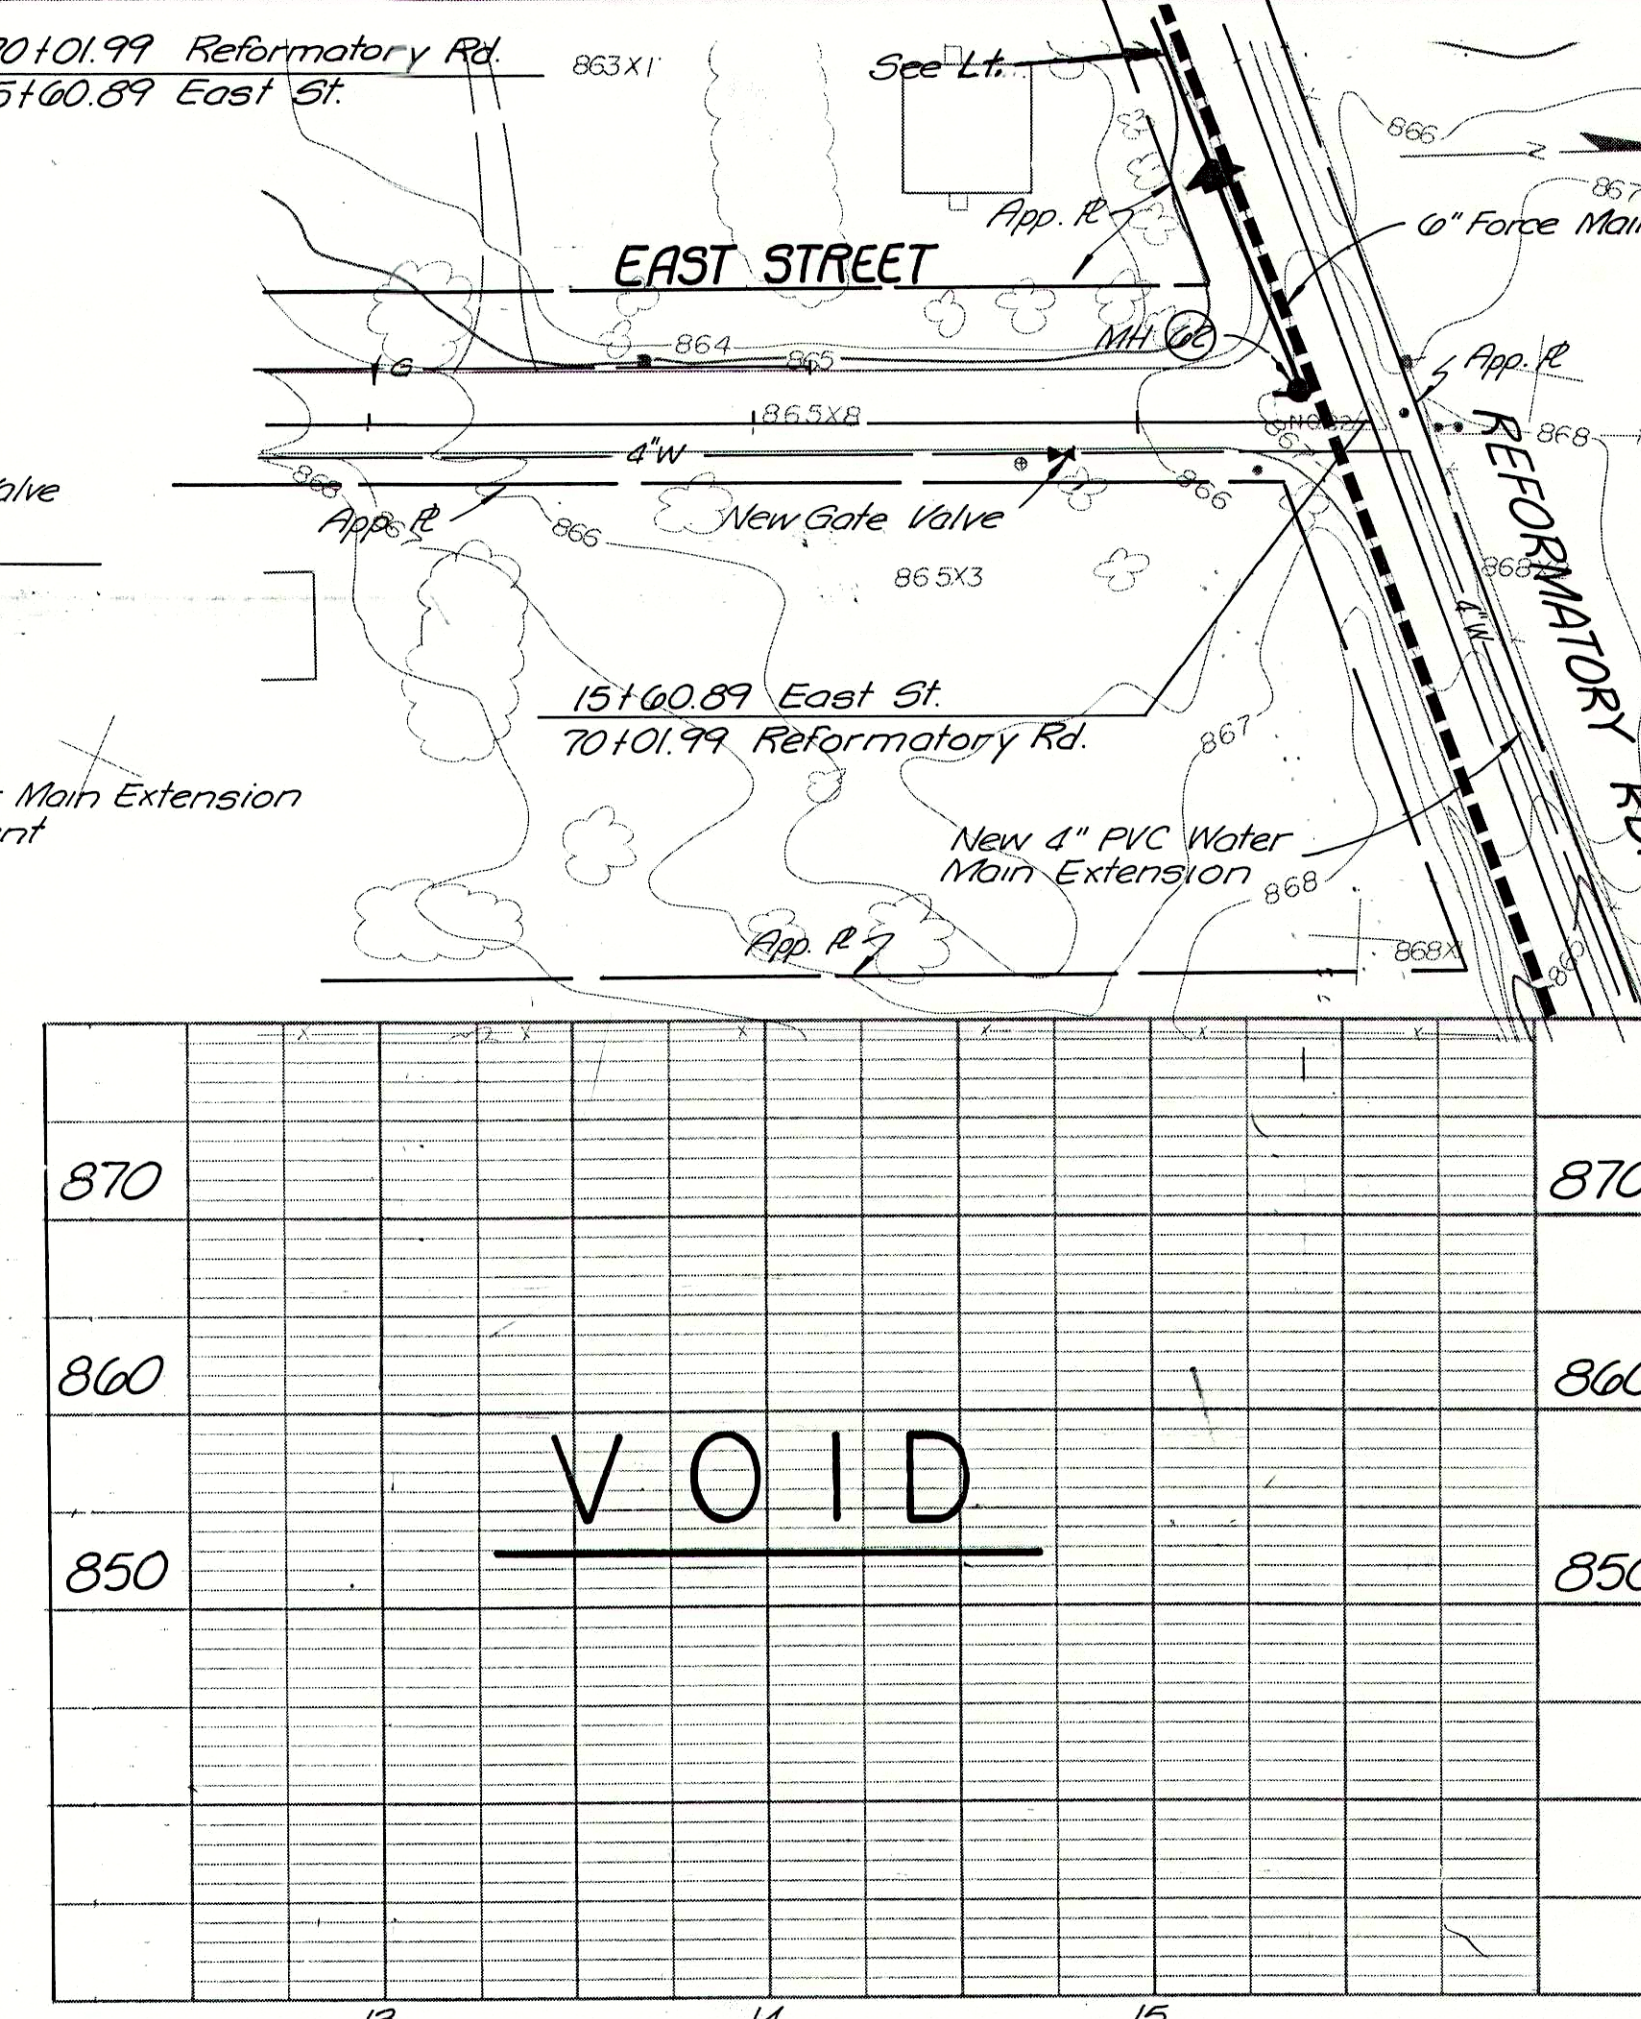
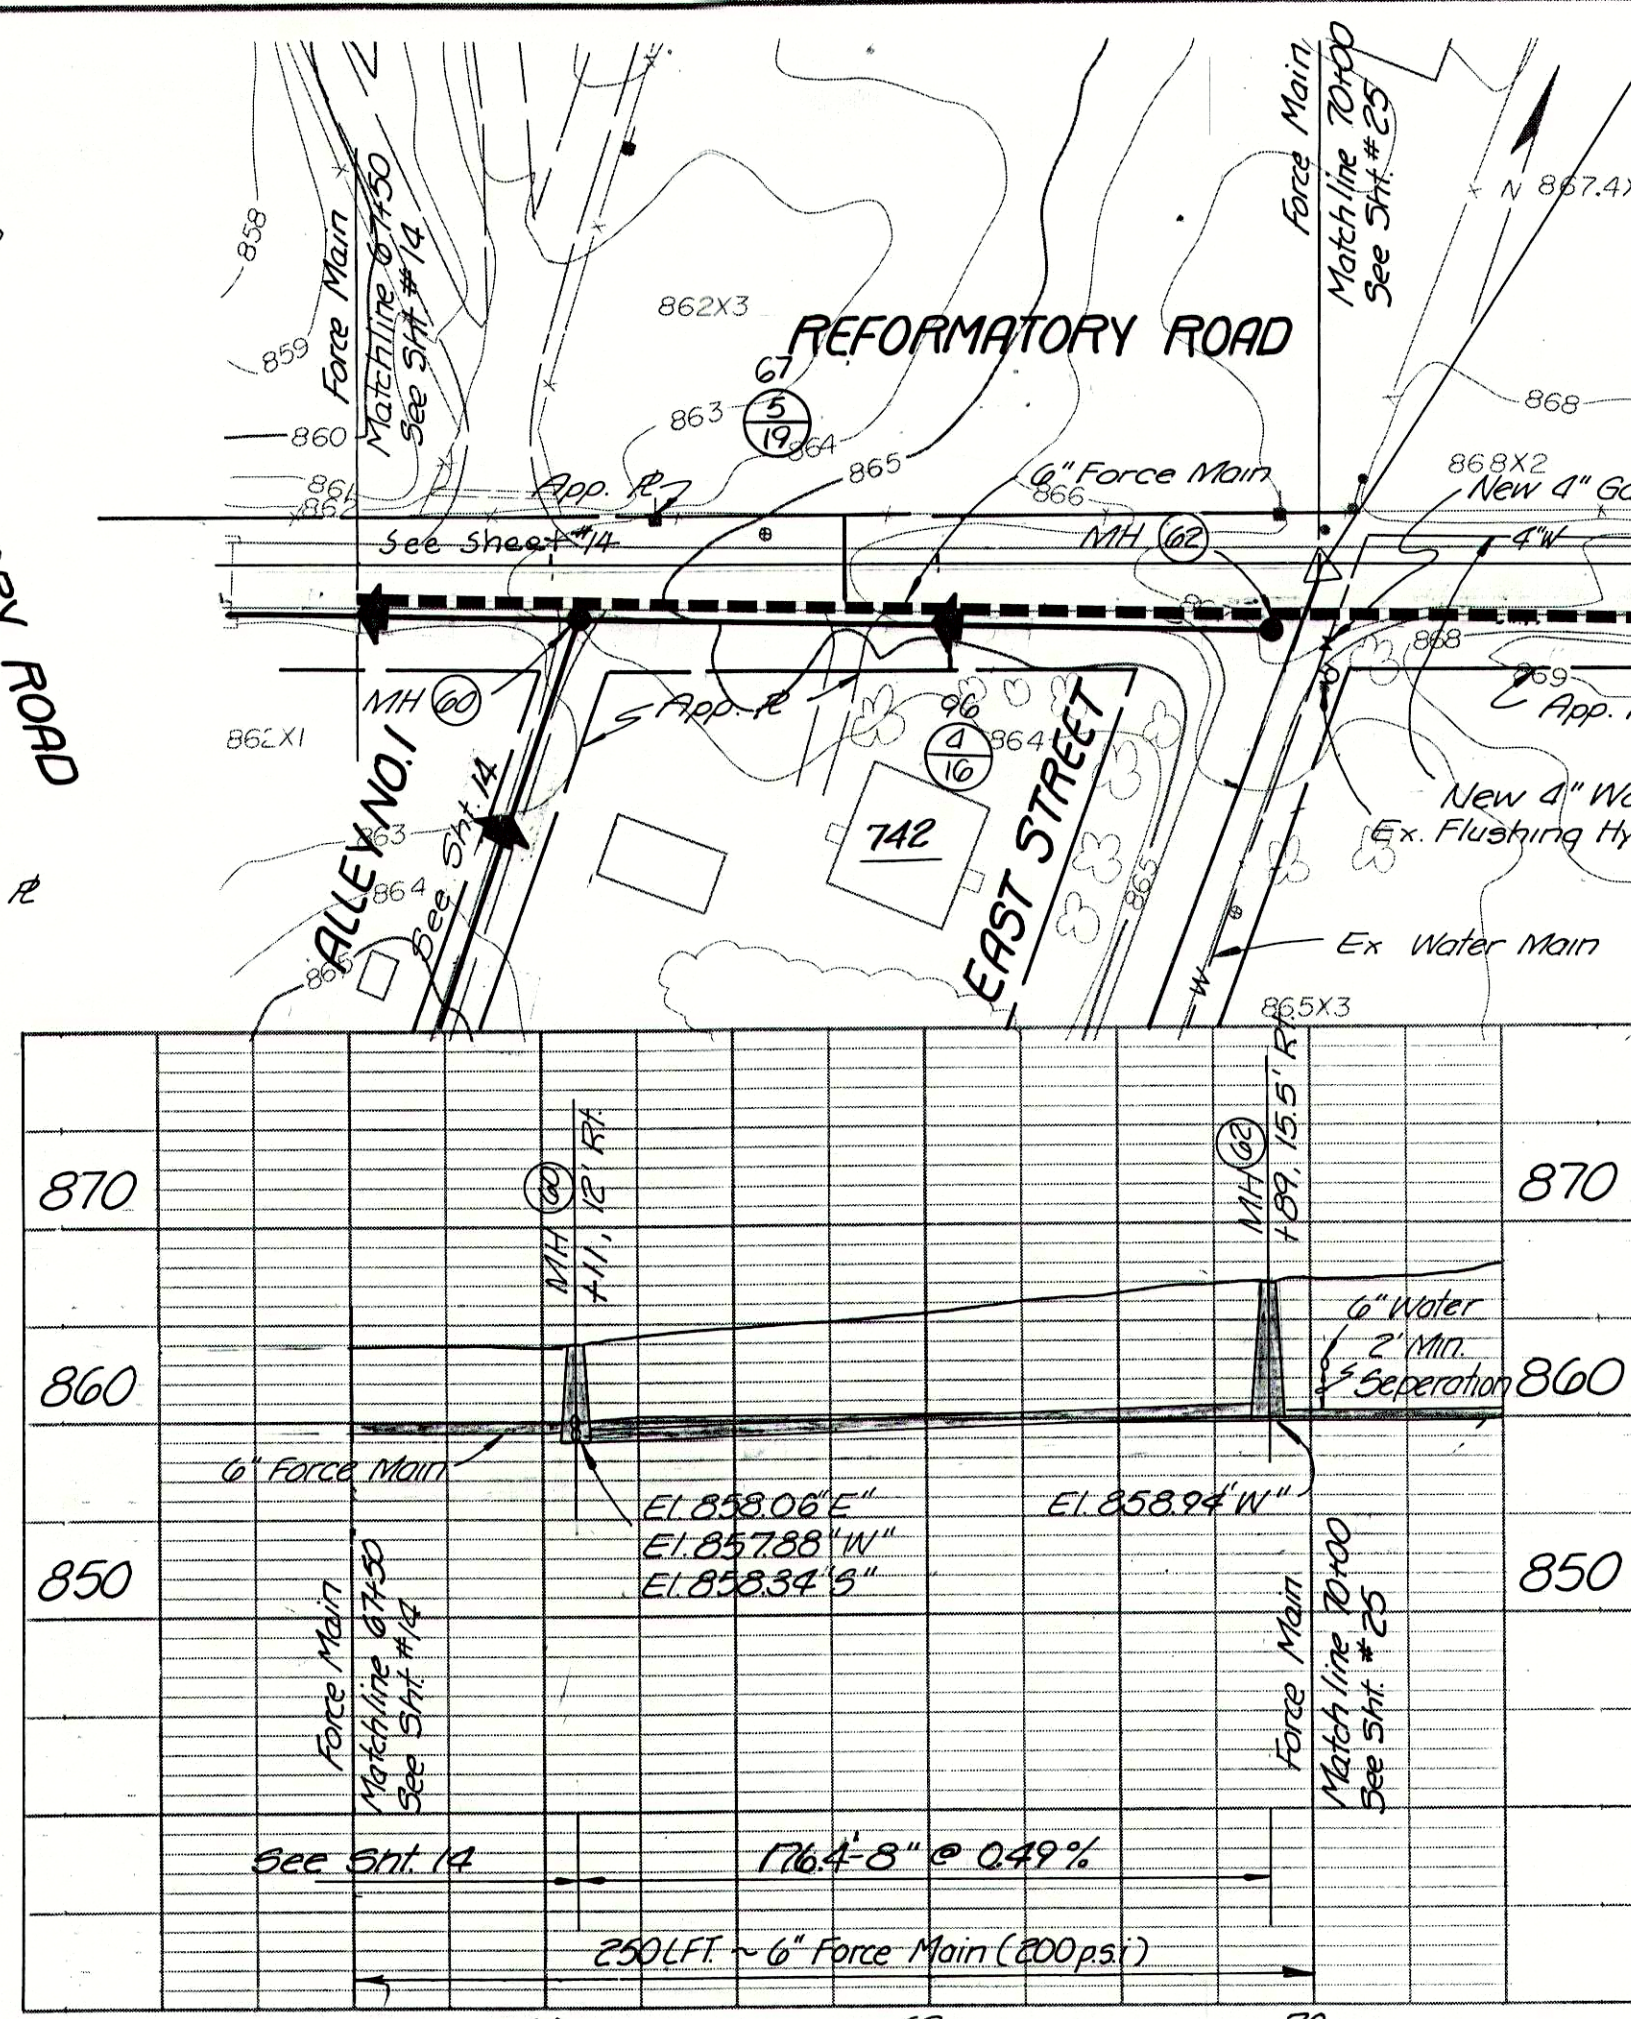
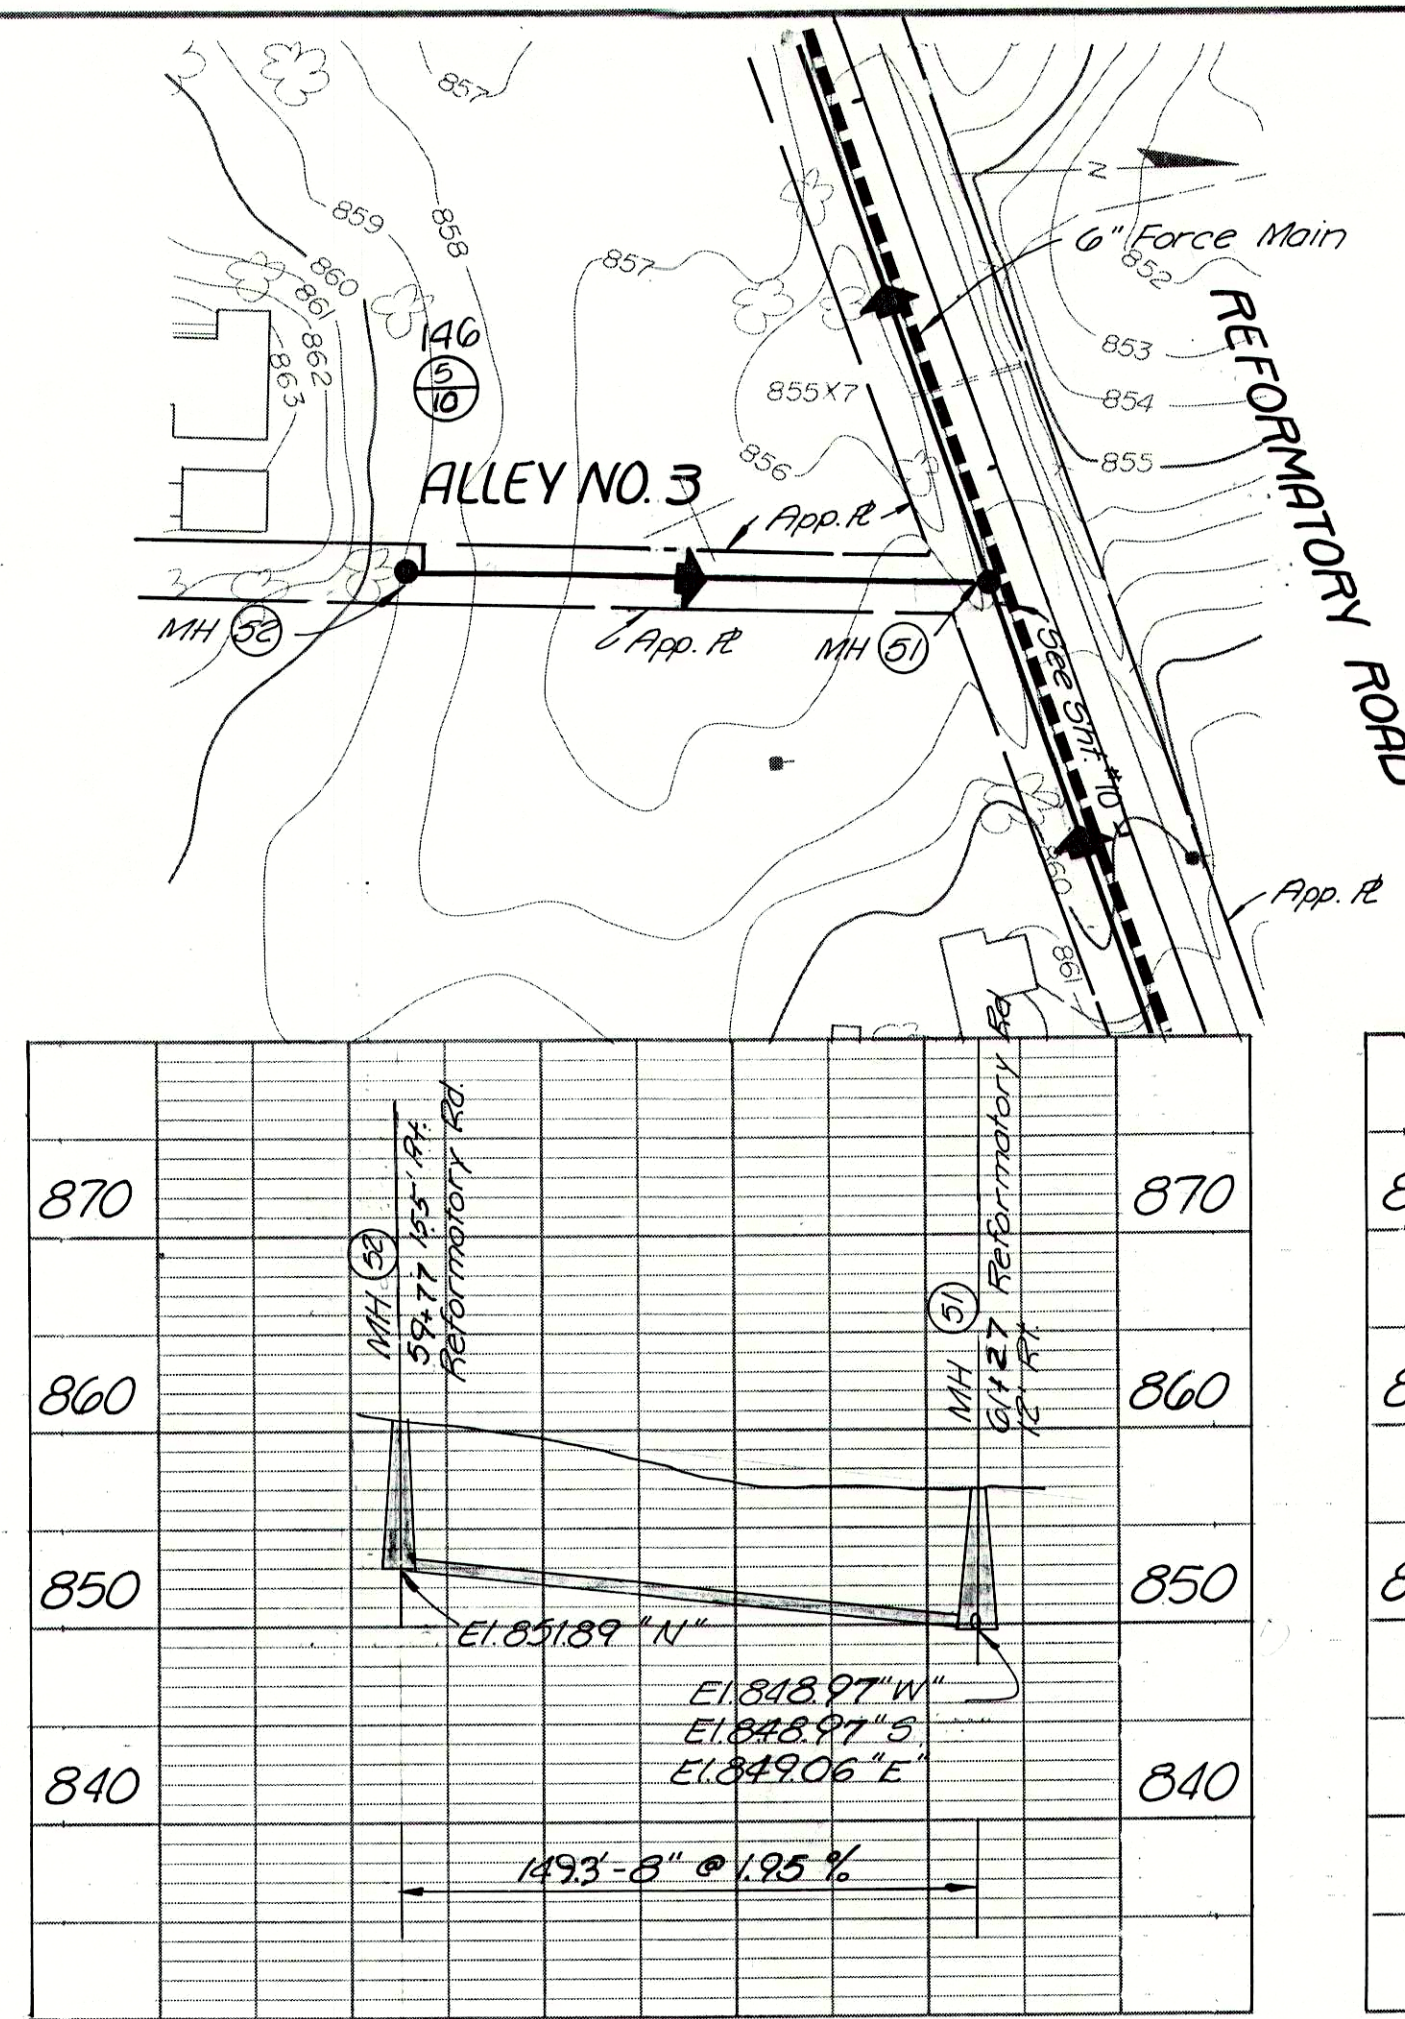



PLAN	DATE	BY
	SURVEYED	
	NOTE BOOK	
	NO.	

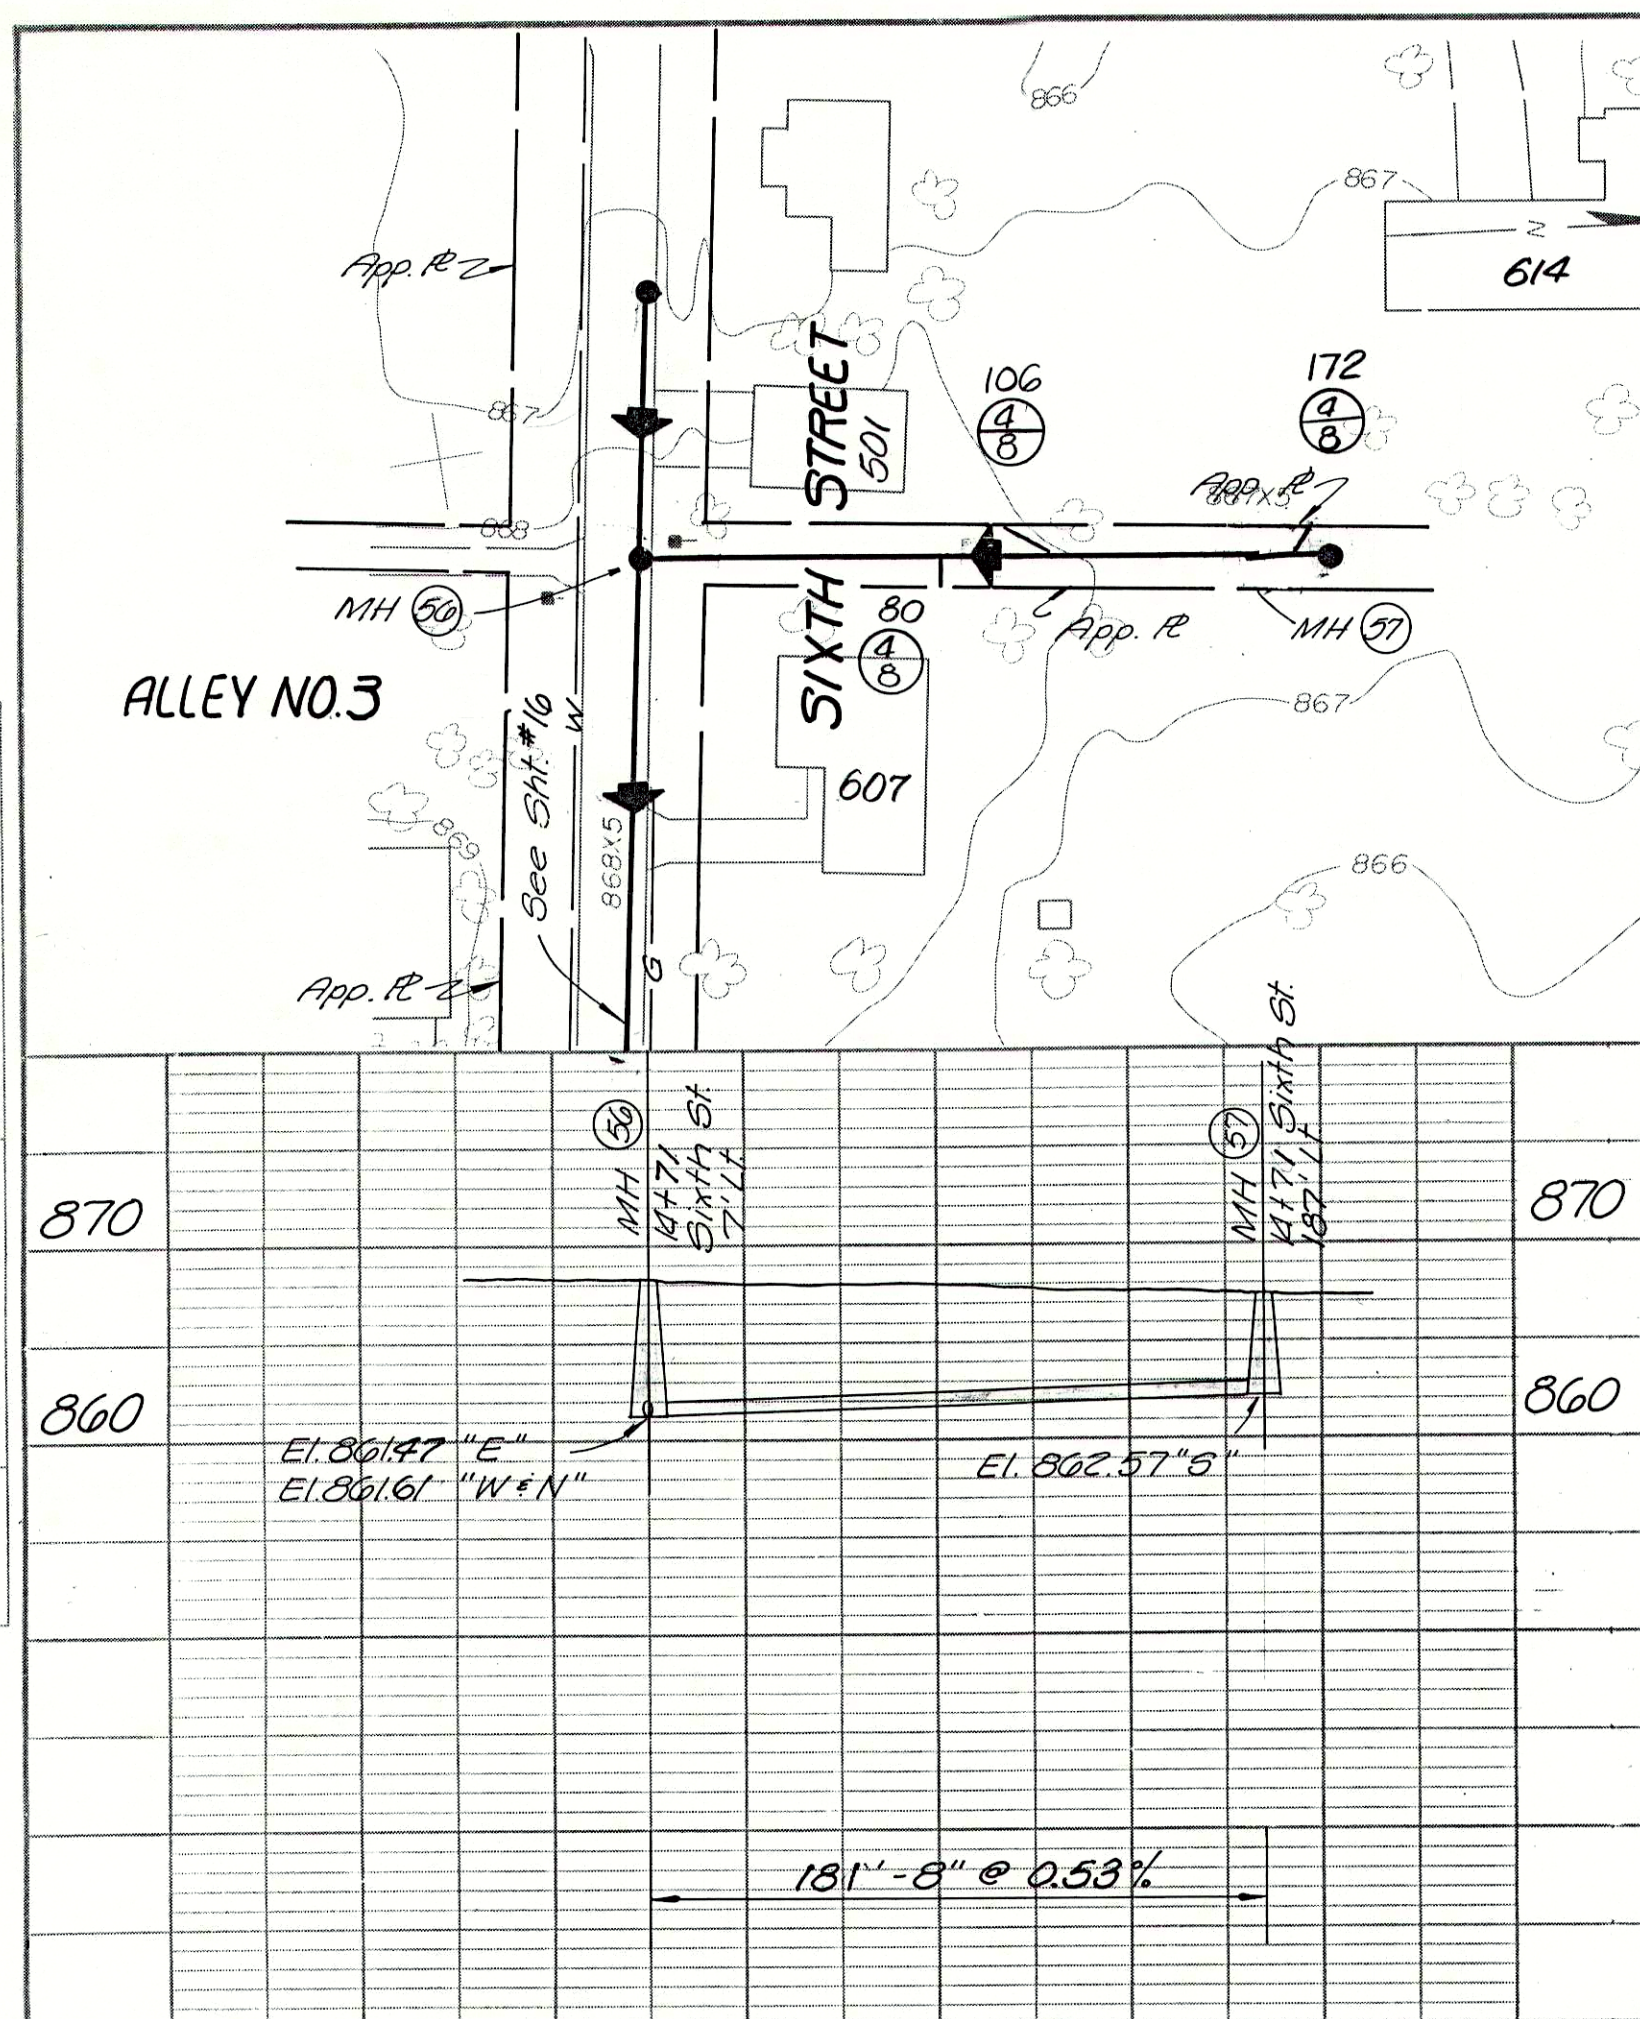

PROFILE	DATE	BY
	SURVEYED	
	NOTE BOOK	
	NO.	

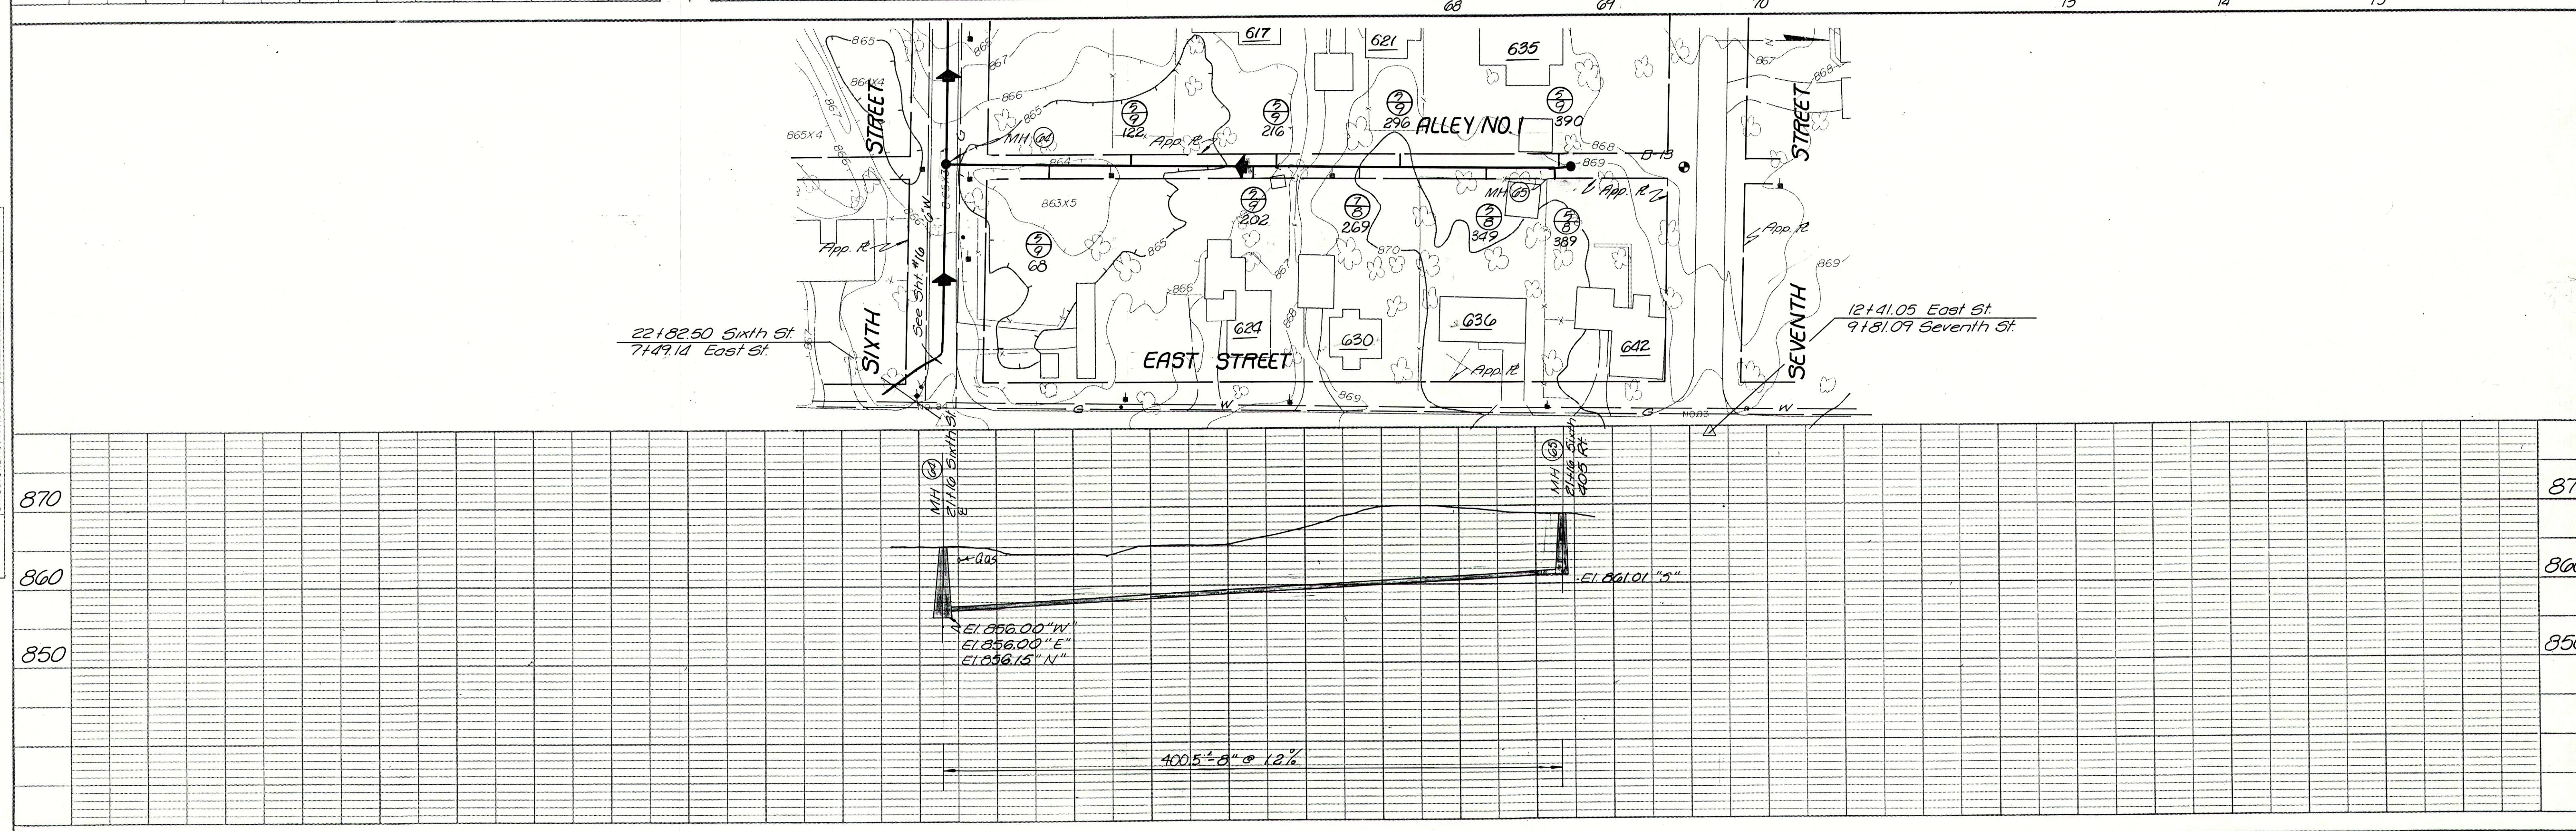

RECORD DRAWING

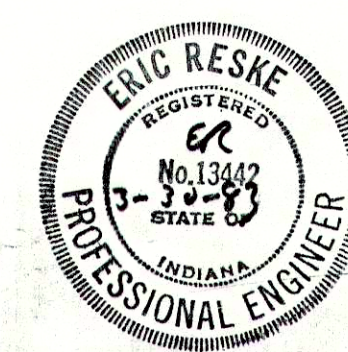

ALLEY #3 REFORMATORY RD.
EAST ST. ALLEY #1
FALL CREEK R.W.D. PLAN & PROFILE SHEET
HORIZ. 1"=50'
VERT. 1"=10'
BEAM, LONGEST & NEFF, INC.
CONSULTING ENGINEERS
INDIANAPOLIS, INDIANA
15