


PLAN	SURVEYED	DATE
	NOTE BOOK	BY
	ALIGNED	
	RT. OF WAY CHECKED	

PROFILE	SURVEYED	DATE
	NOTE BOOK	BY
	GRADES CHECKED	
	STRUCTURE NOTATIONS	

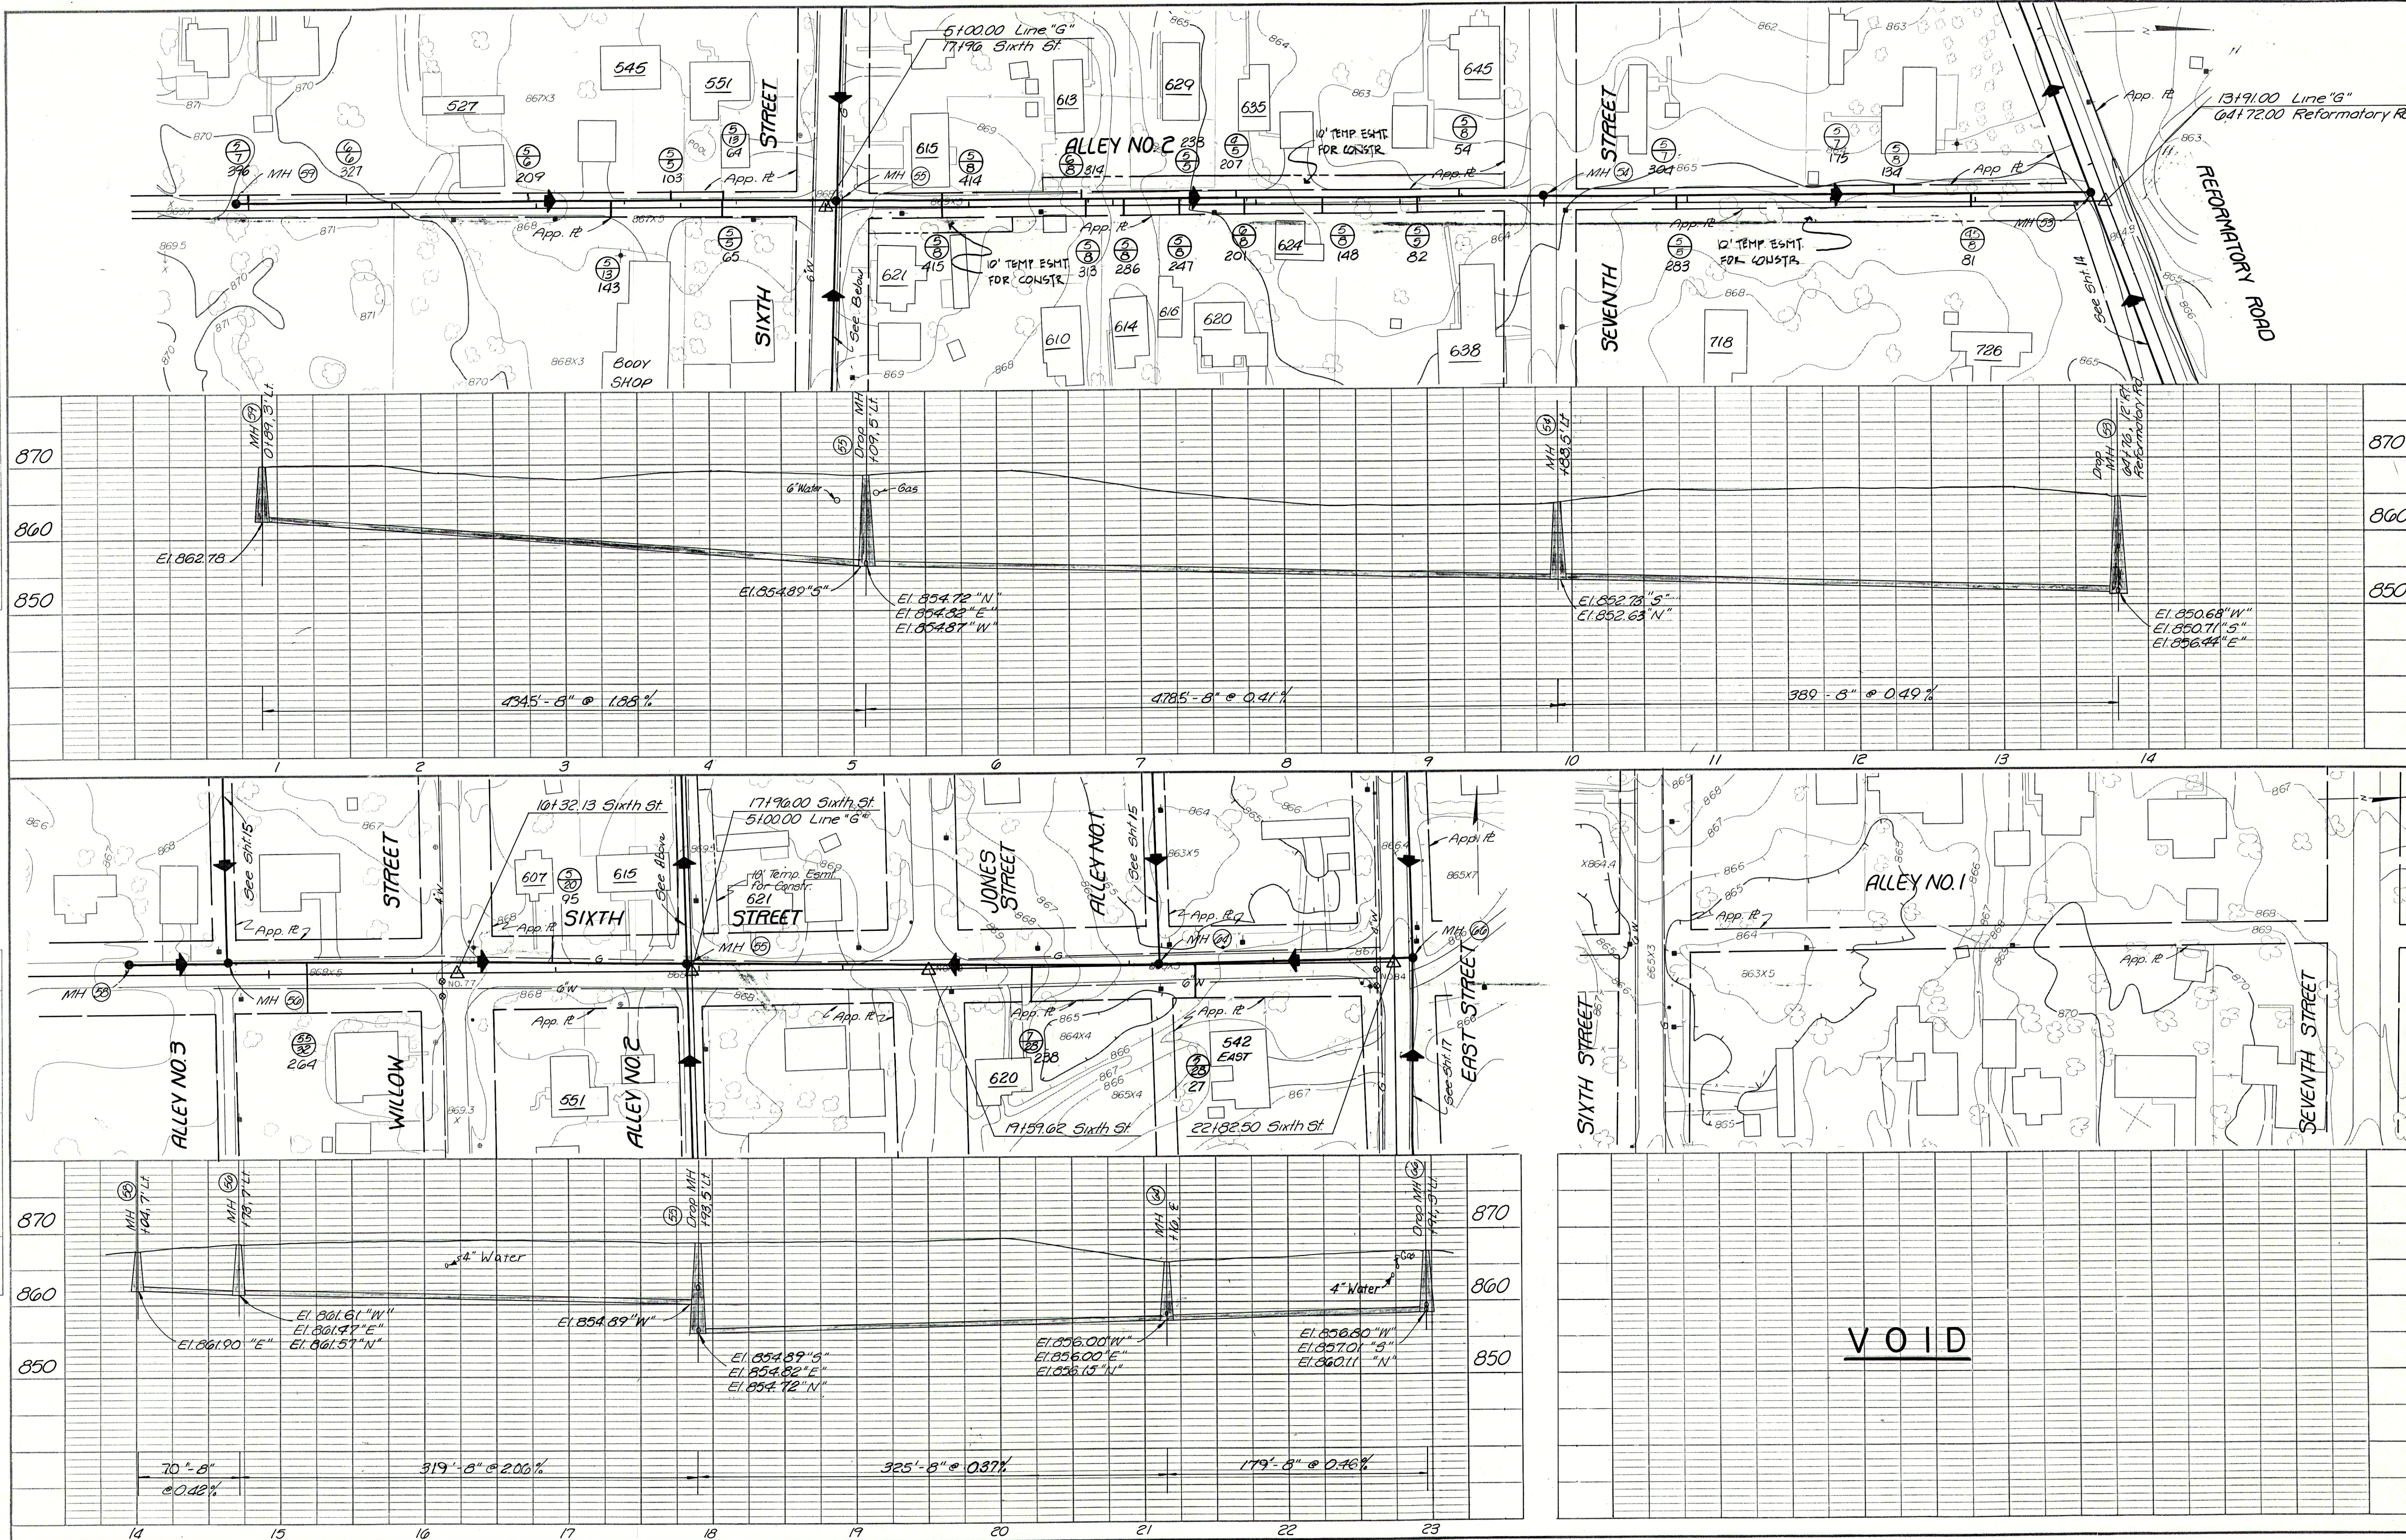

REVISED 3-19-84
CHANGED APP.

RECORD DRAWING

ERIC RESAE
REGISTERED
3-14-83
STATE OF INDIANA
PROFESSIONAL ENGINEER

ALLEYS #2 SIXTH ST.

FALL CREEK R.W.D. PLAN & PROFILE SHEET

HORIZ. 1"=50'

VERT. 1"=10'

BEAM, LONGEST & NEFF, INC.
CONSULTING ENGINEERS
INDIANAPOLIS, INDIANA

16