

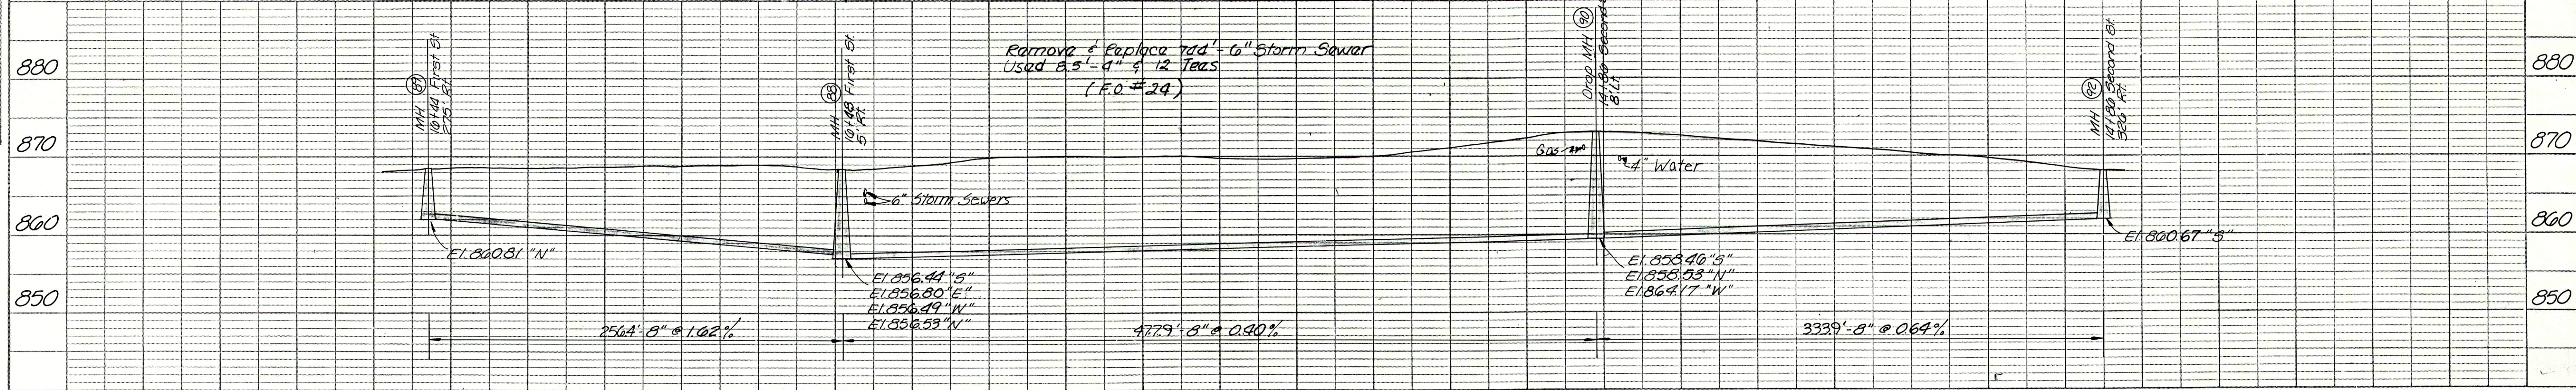
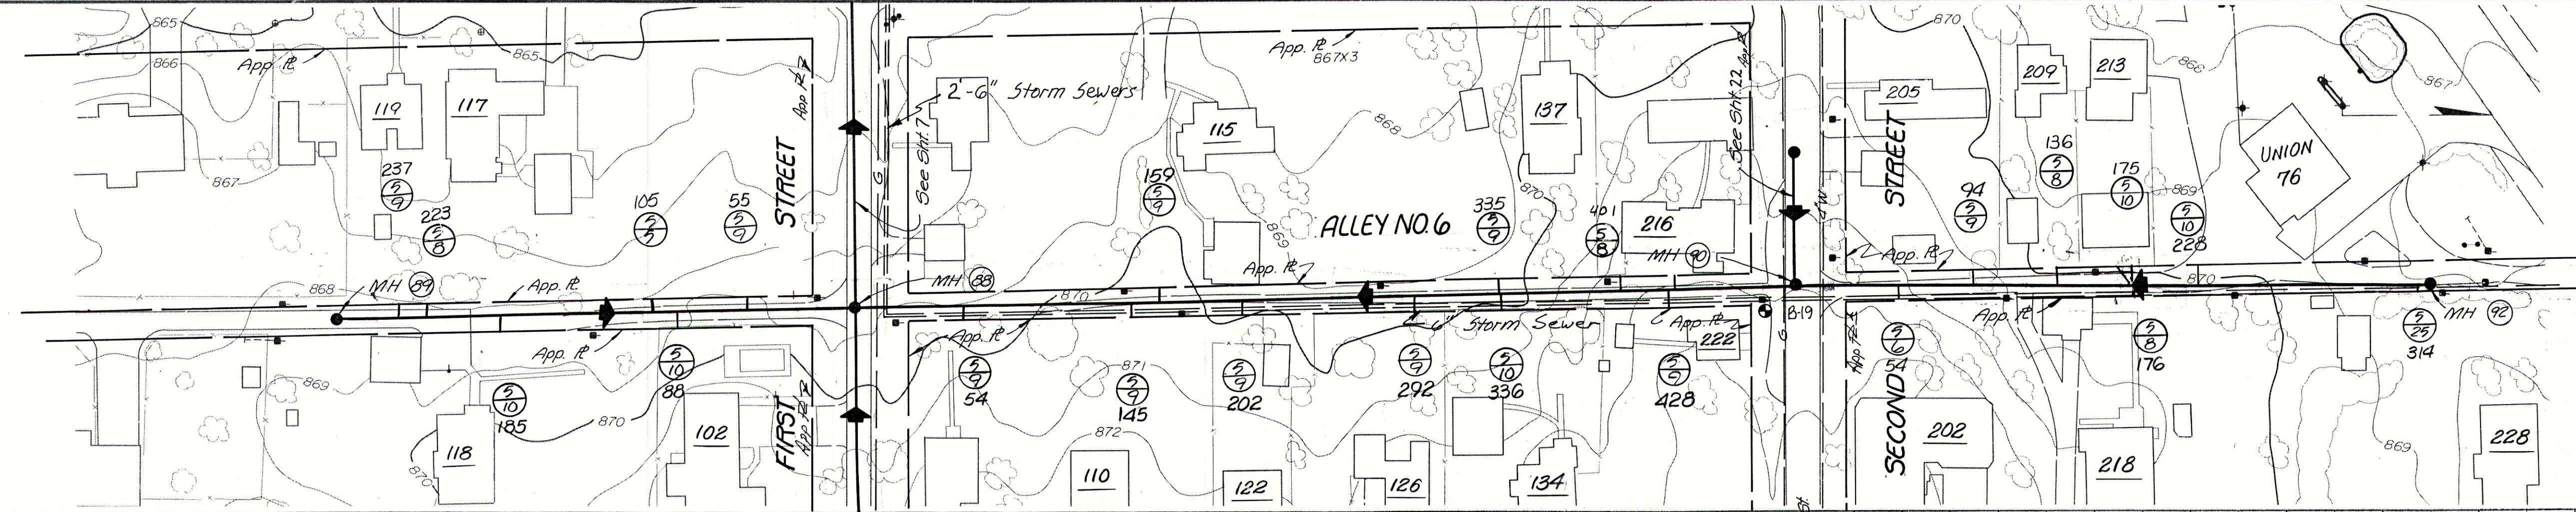
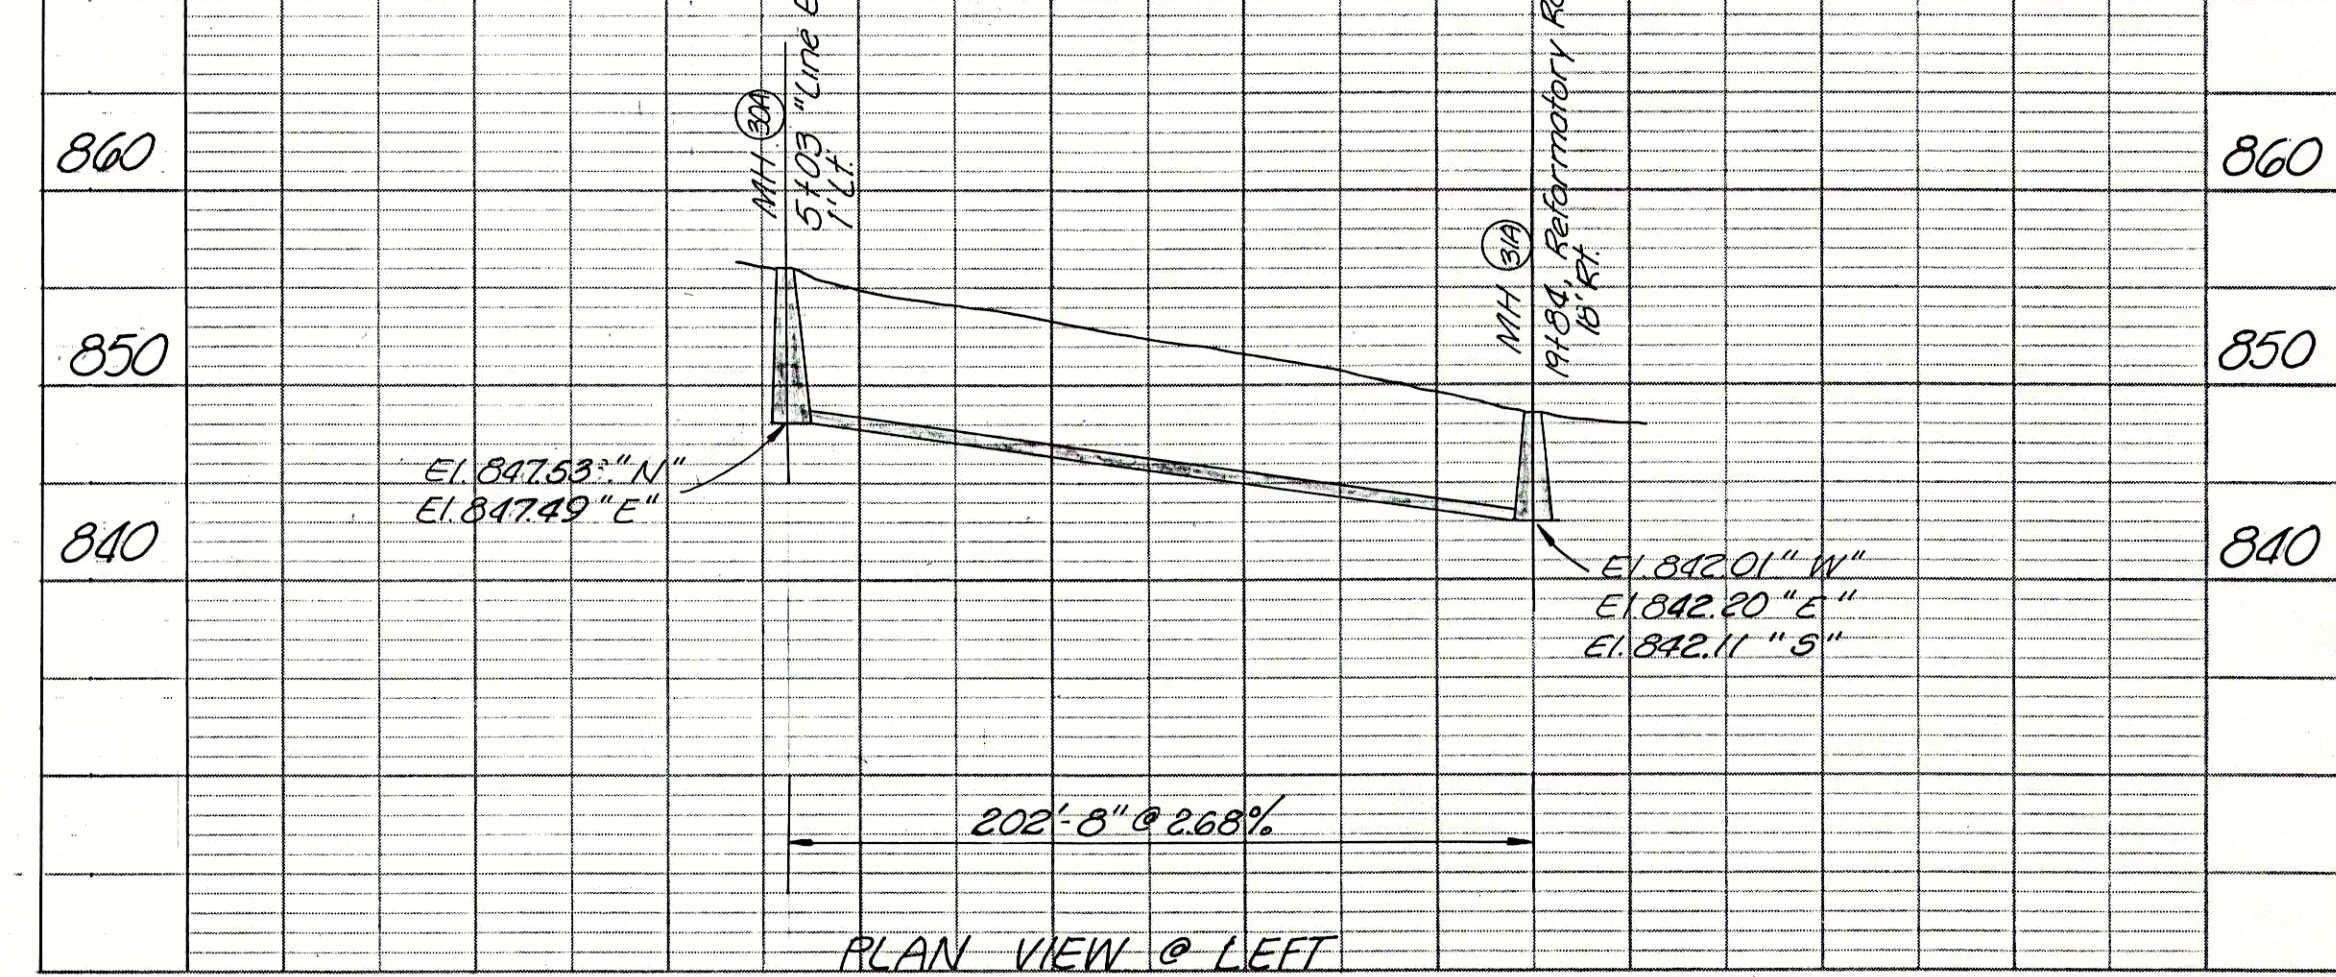
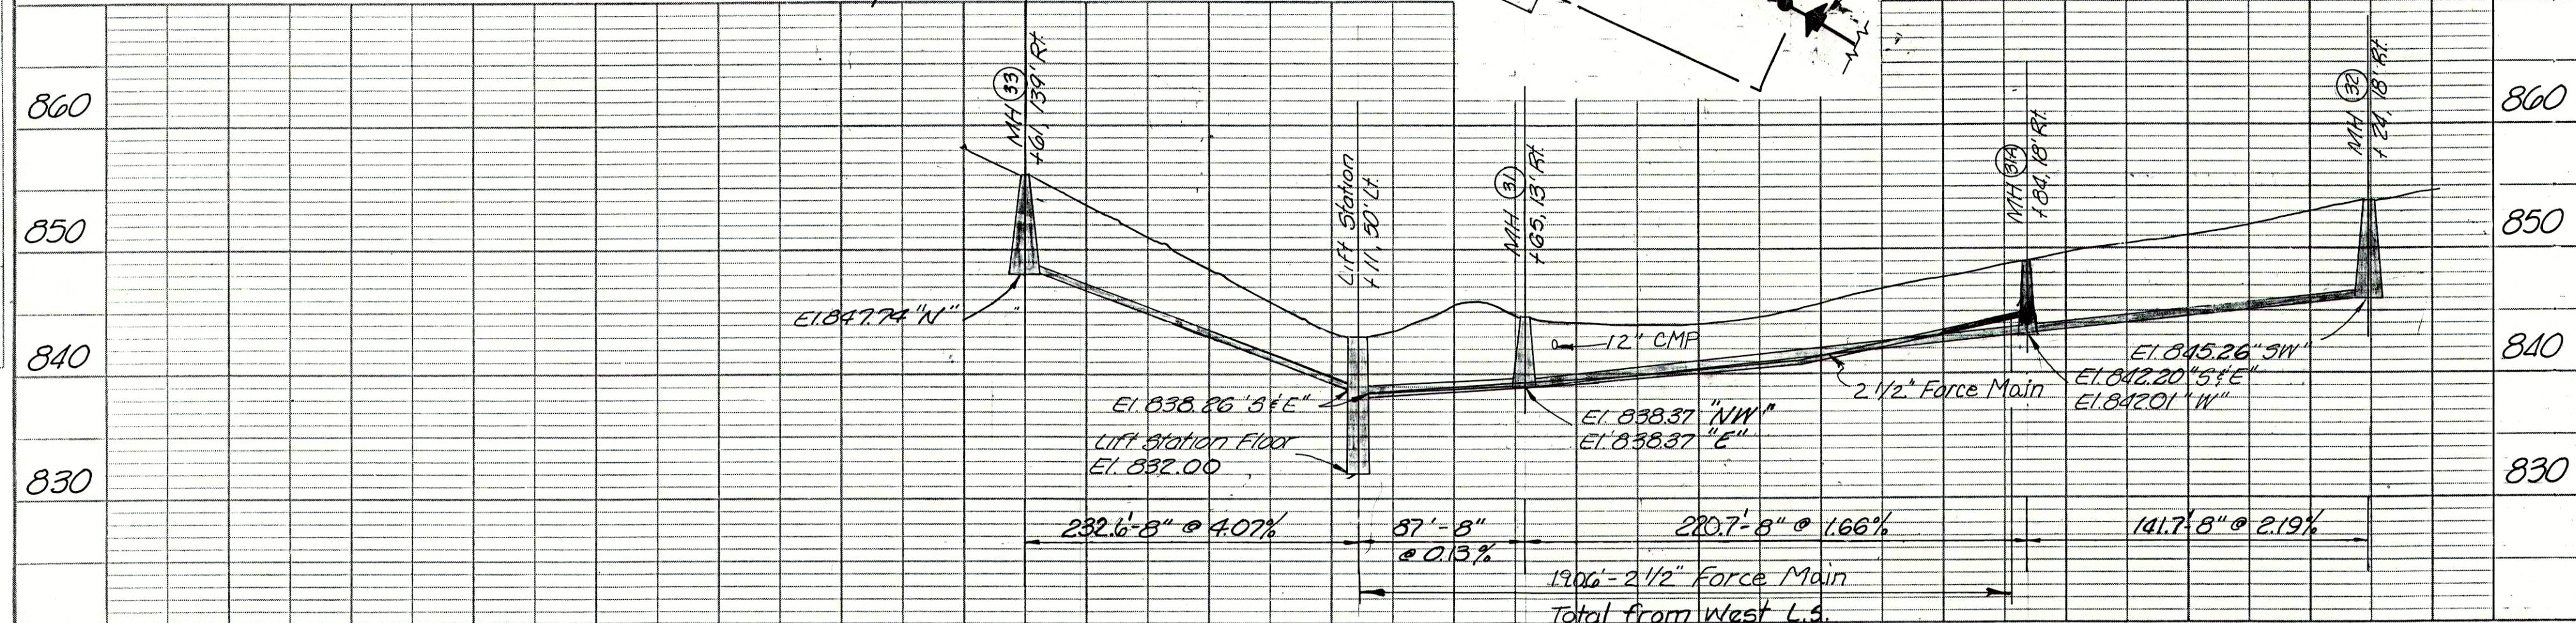


PLAN	SURVEYED	DATE
	NOTED	BY
	ALIGNED	CHECKED
	RT. OF WAY	CHECKED
NO.		

PROFILE	SURVEYED	DATE
	NOTED	BY
	GRADES	CHECKED
	STRUCTURE	NOTATIONS
NO.		

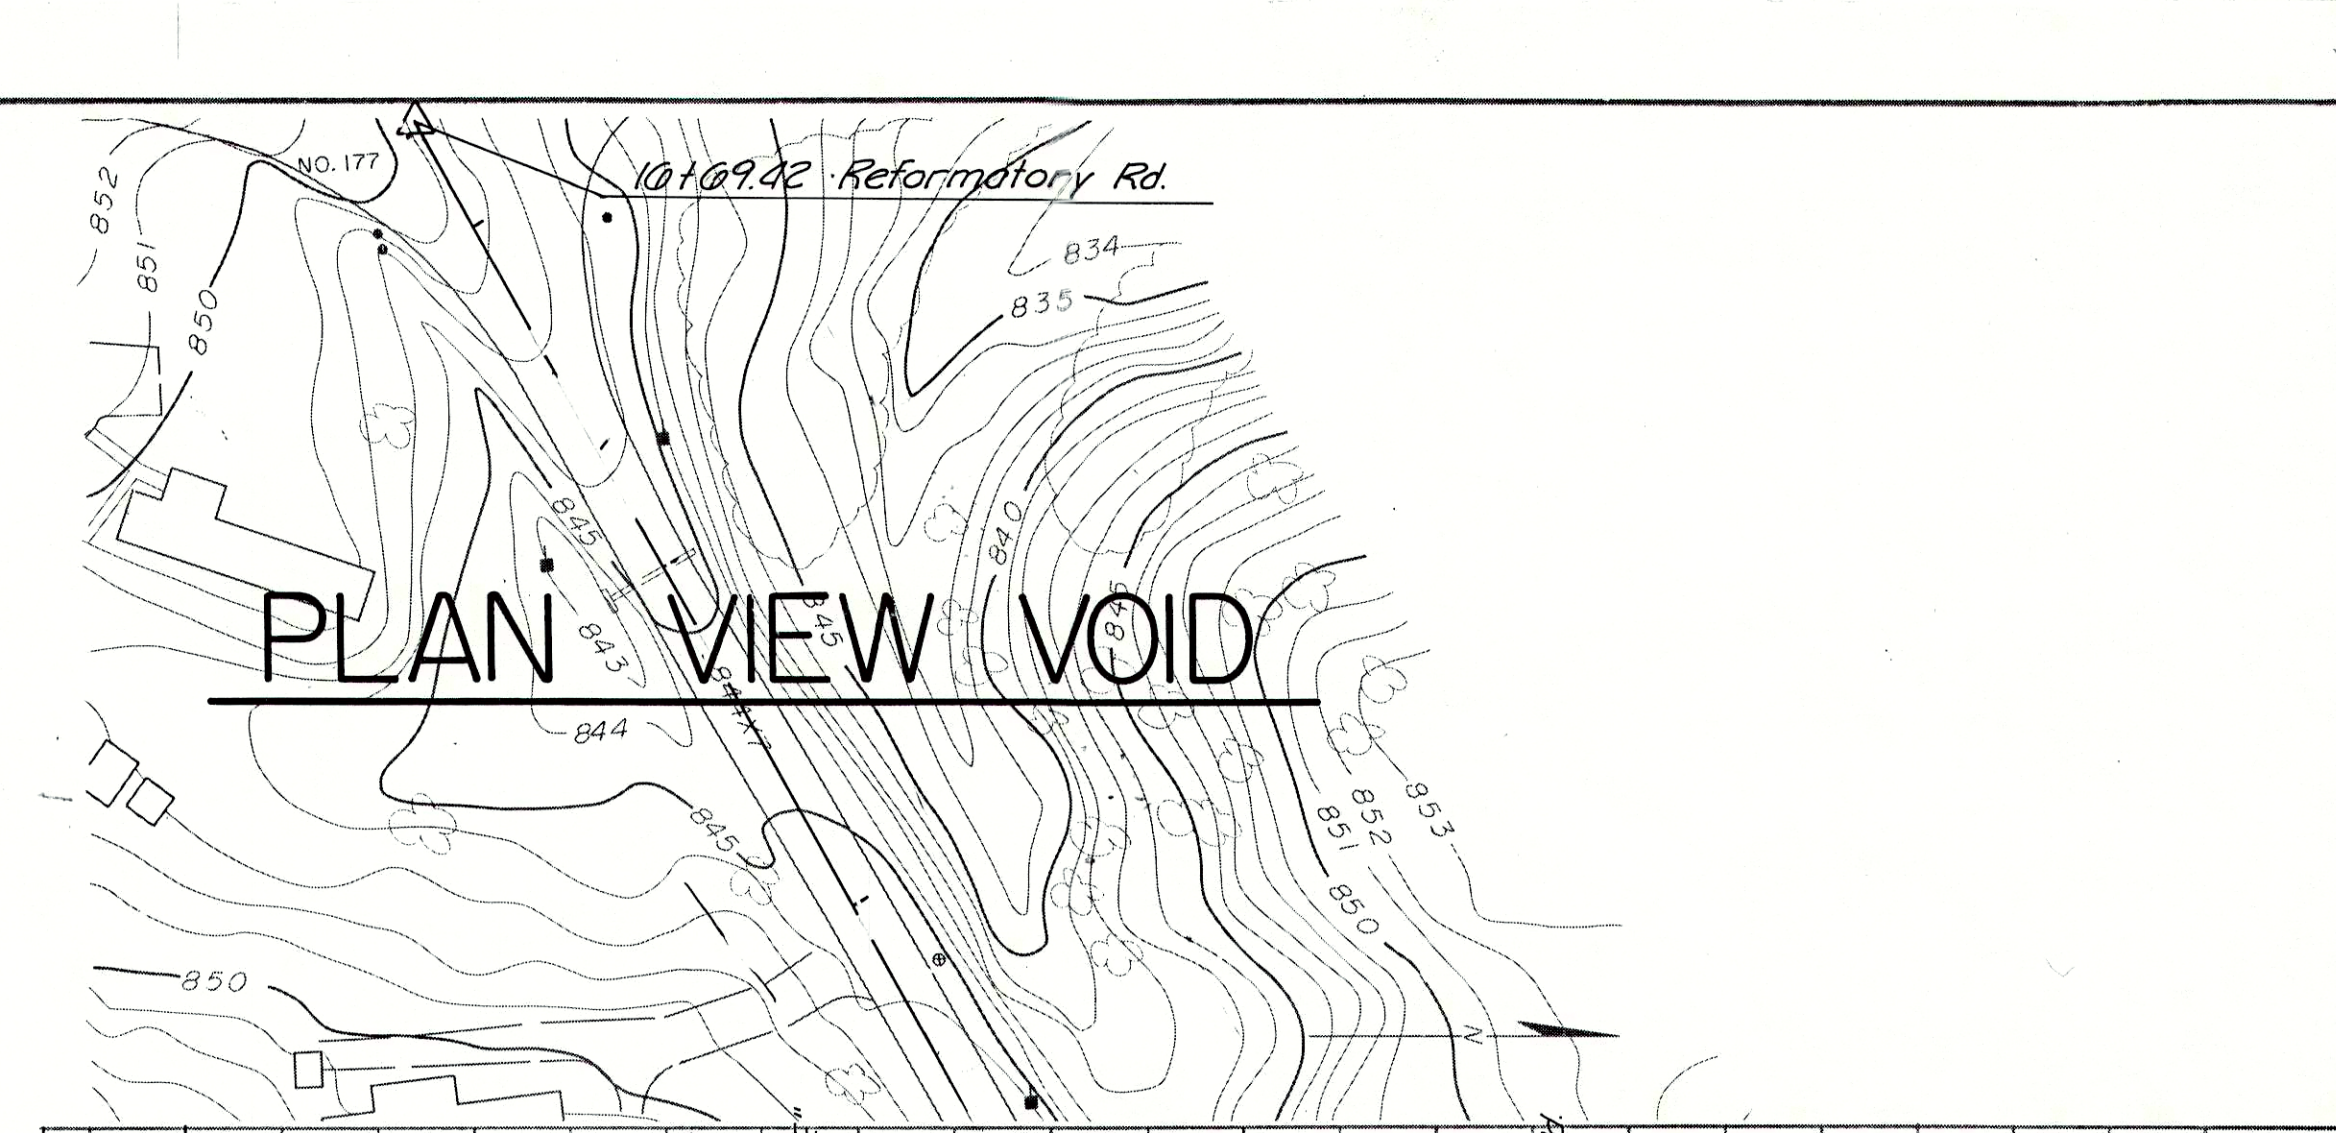

RECORD DRAWING

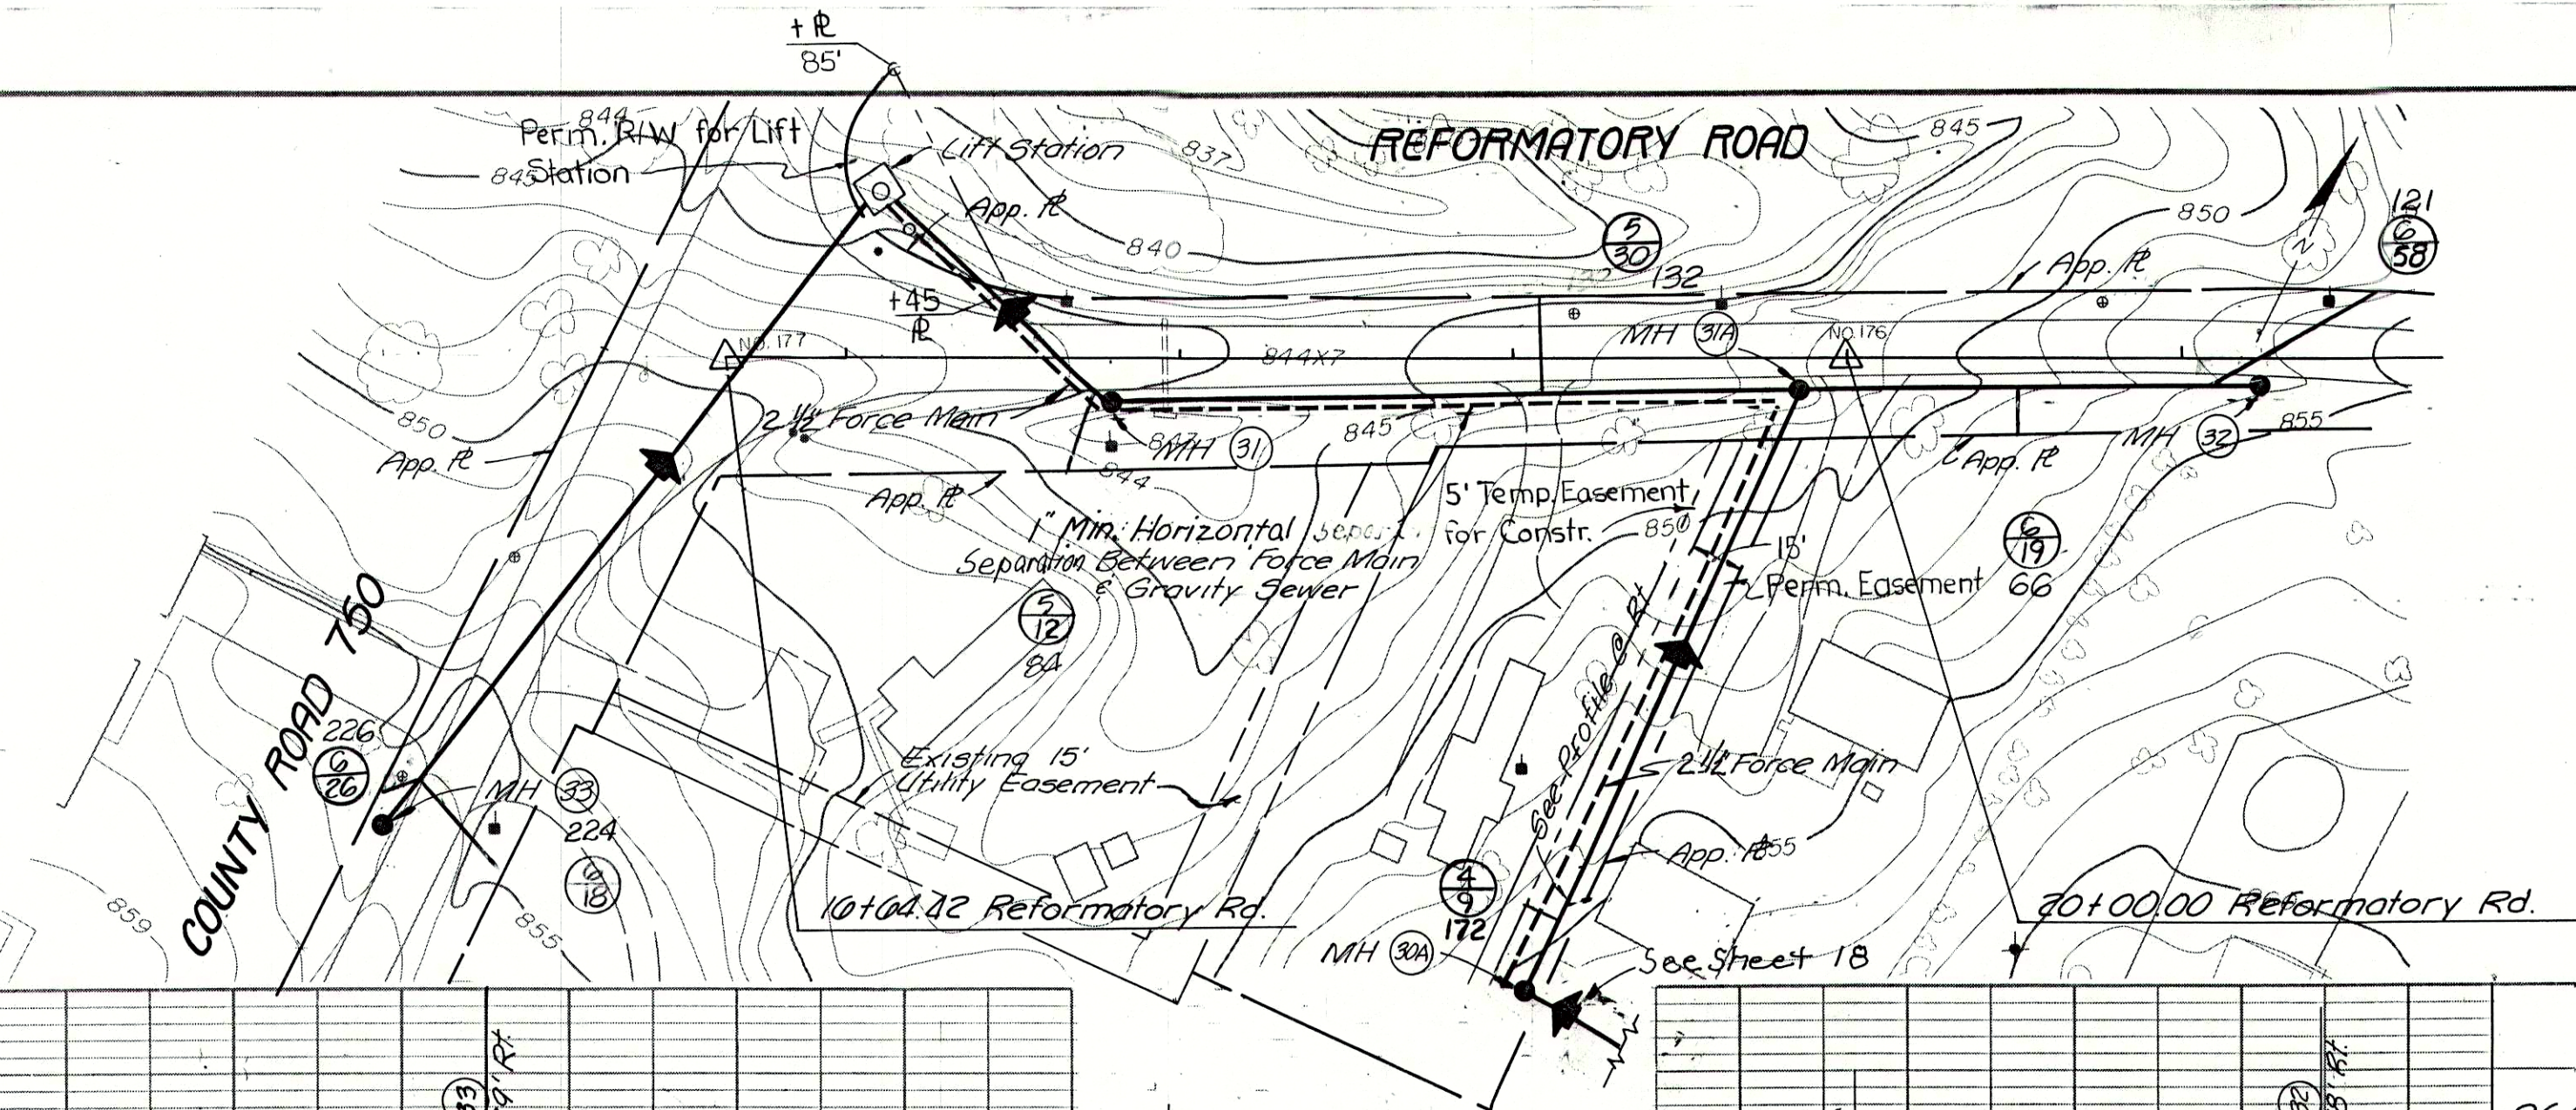

REFORMATORY RD. ALLEY #6
FALL CREEK R.W.D. PLAN & PROFILE SHEET
HORIZ. 1"=50'
VERT. 1"=10'
BEAM, LONGEST & NEFF, INC.
CONSULTING ENGINEERS
INDIANAPOLIS, INDIANA
19