

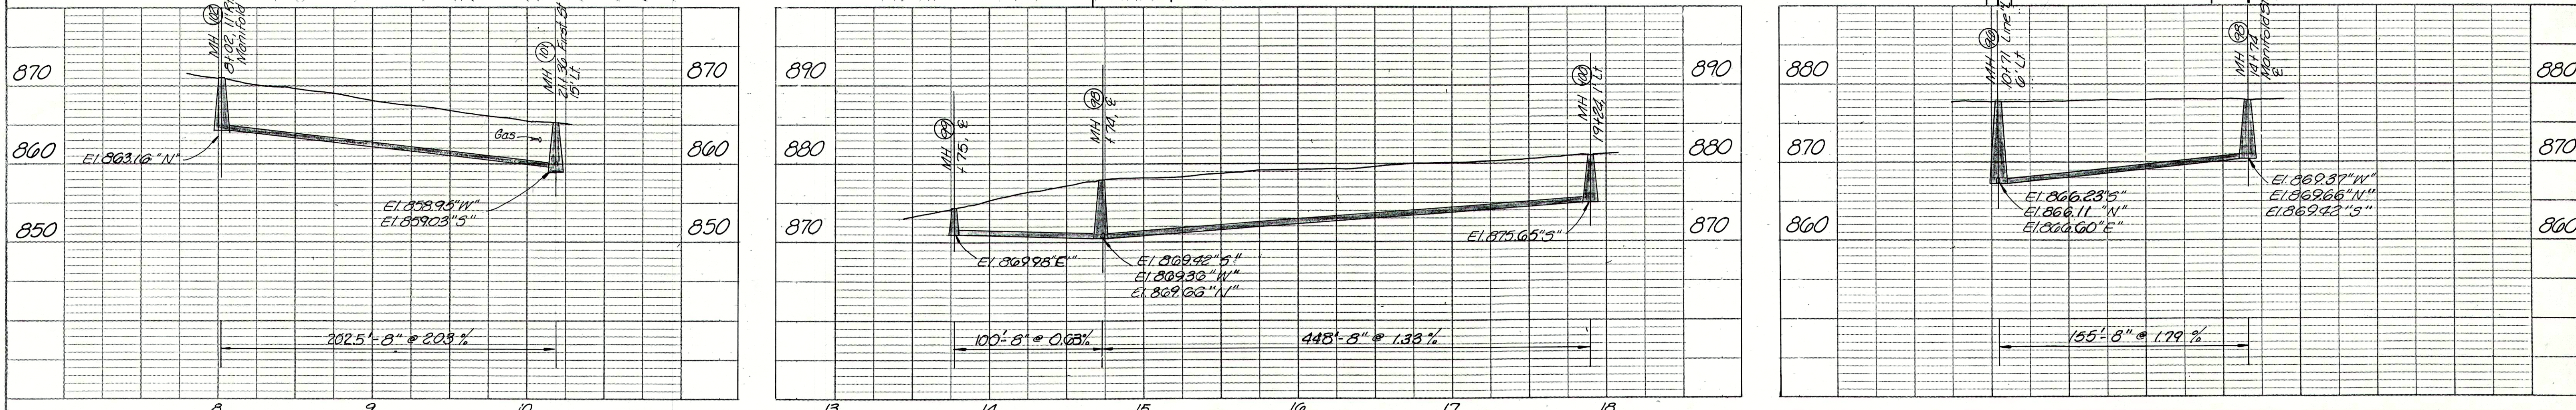
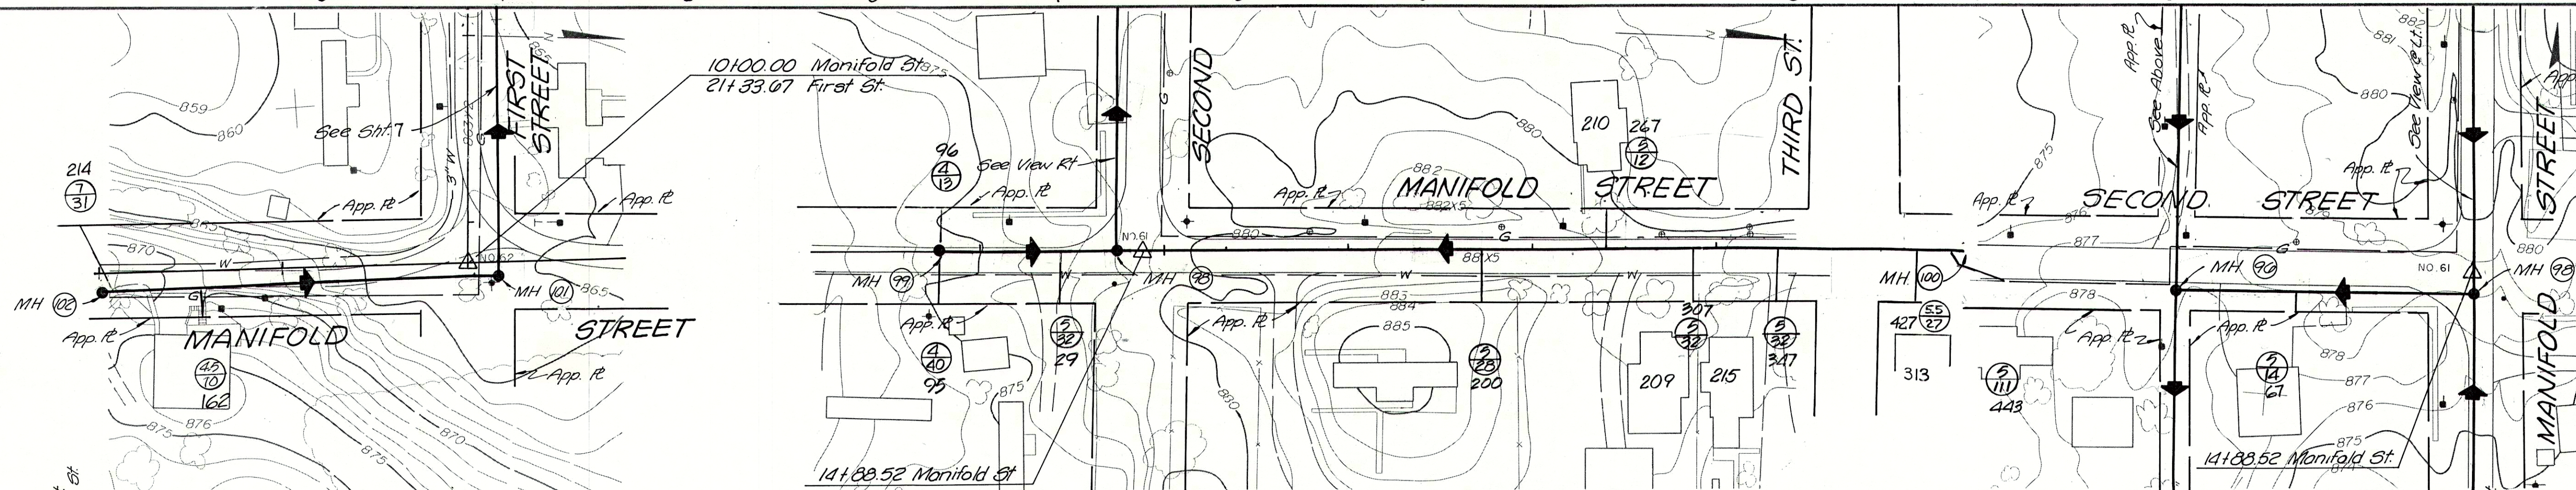


PLAN	SUBMITTED	DATE
	PLOTTED	BY
	NOTE BOOK	ALIGNMENT CHECKED
	NO.	FT. OF WAY CHECKED

PROFILE	SUBMITTED	DATE
	PLOTTED	BY
	NOTE BOOK	GRADES CHECKED
	NO.	STRUCTURE NOTATIONS CHKD

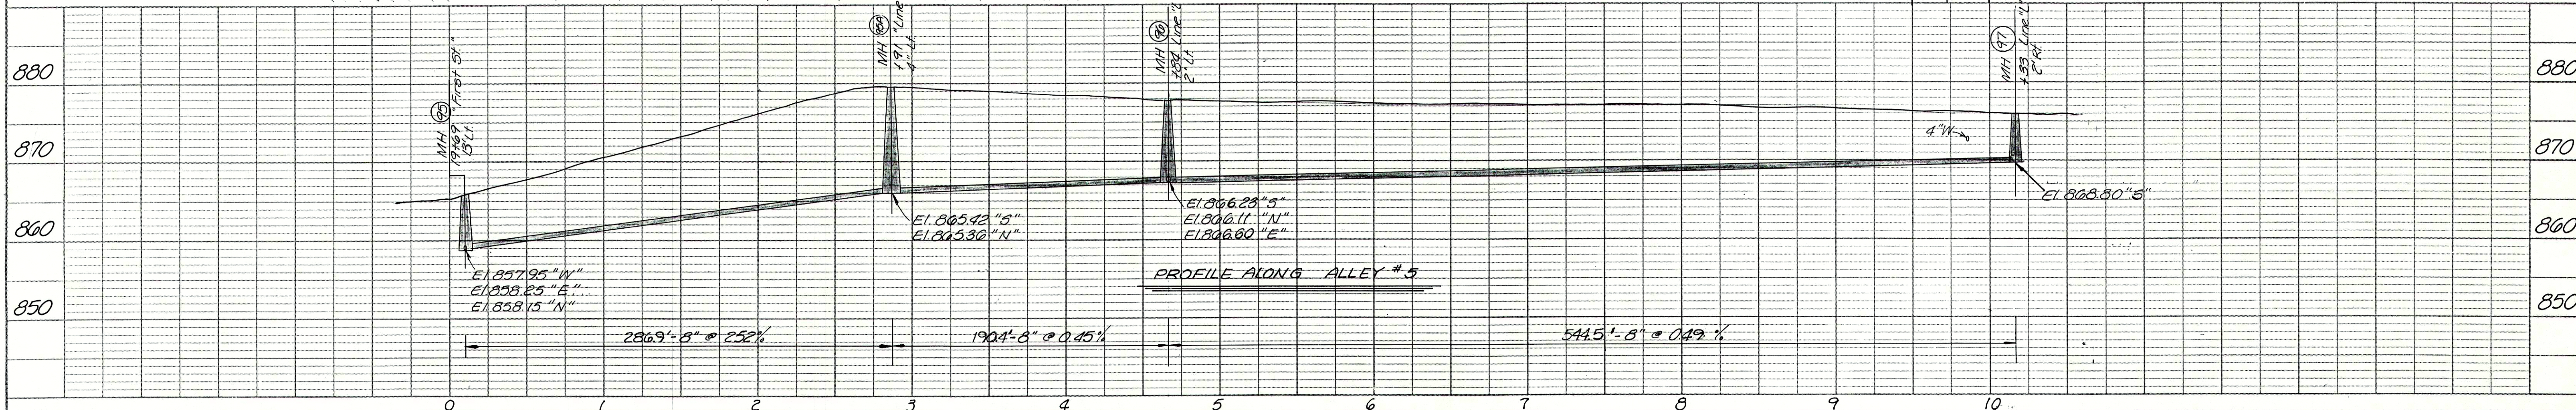

RECORD DRAWING

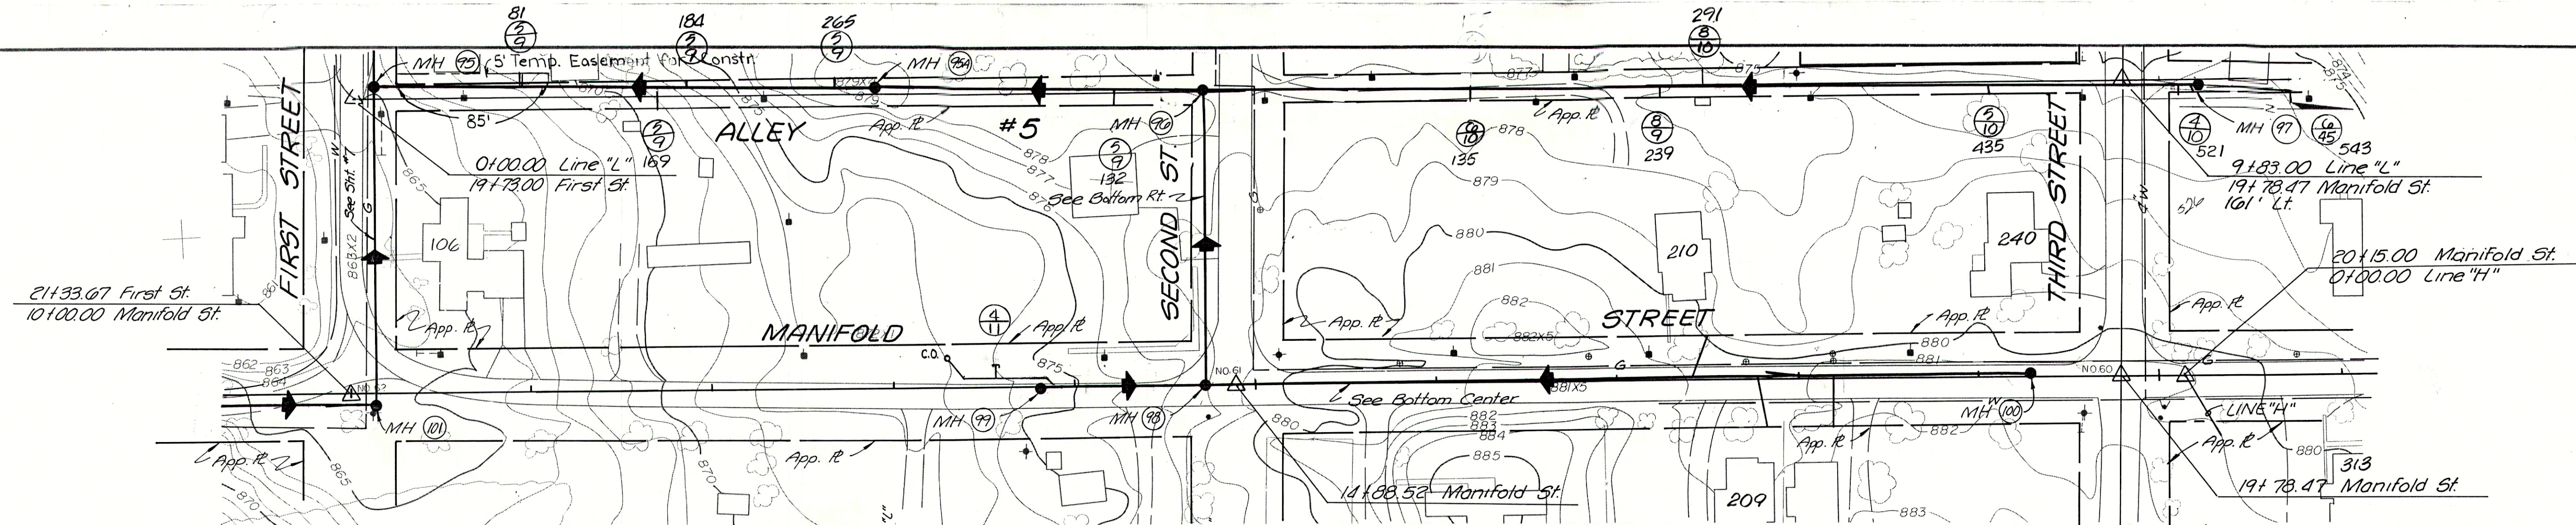

MANIFOLD ST. SECOND ST.
 FALL CREEK R.W.D. PLAN & PROFILE SHEET
 HORIZ. 1"=50'
 VERT. 1"=10'
 BEAM, LONGEST & NEFF, INC.
 CONSULTING ENGINEERS
 INDIANAPOLIS, INDIANA
 20