

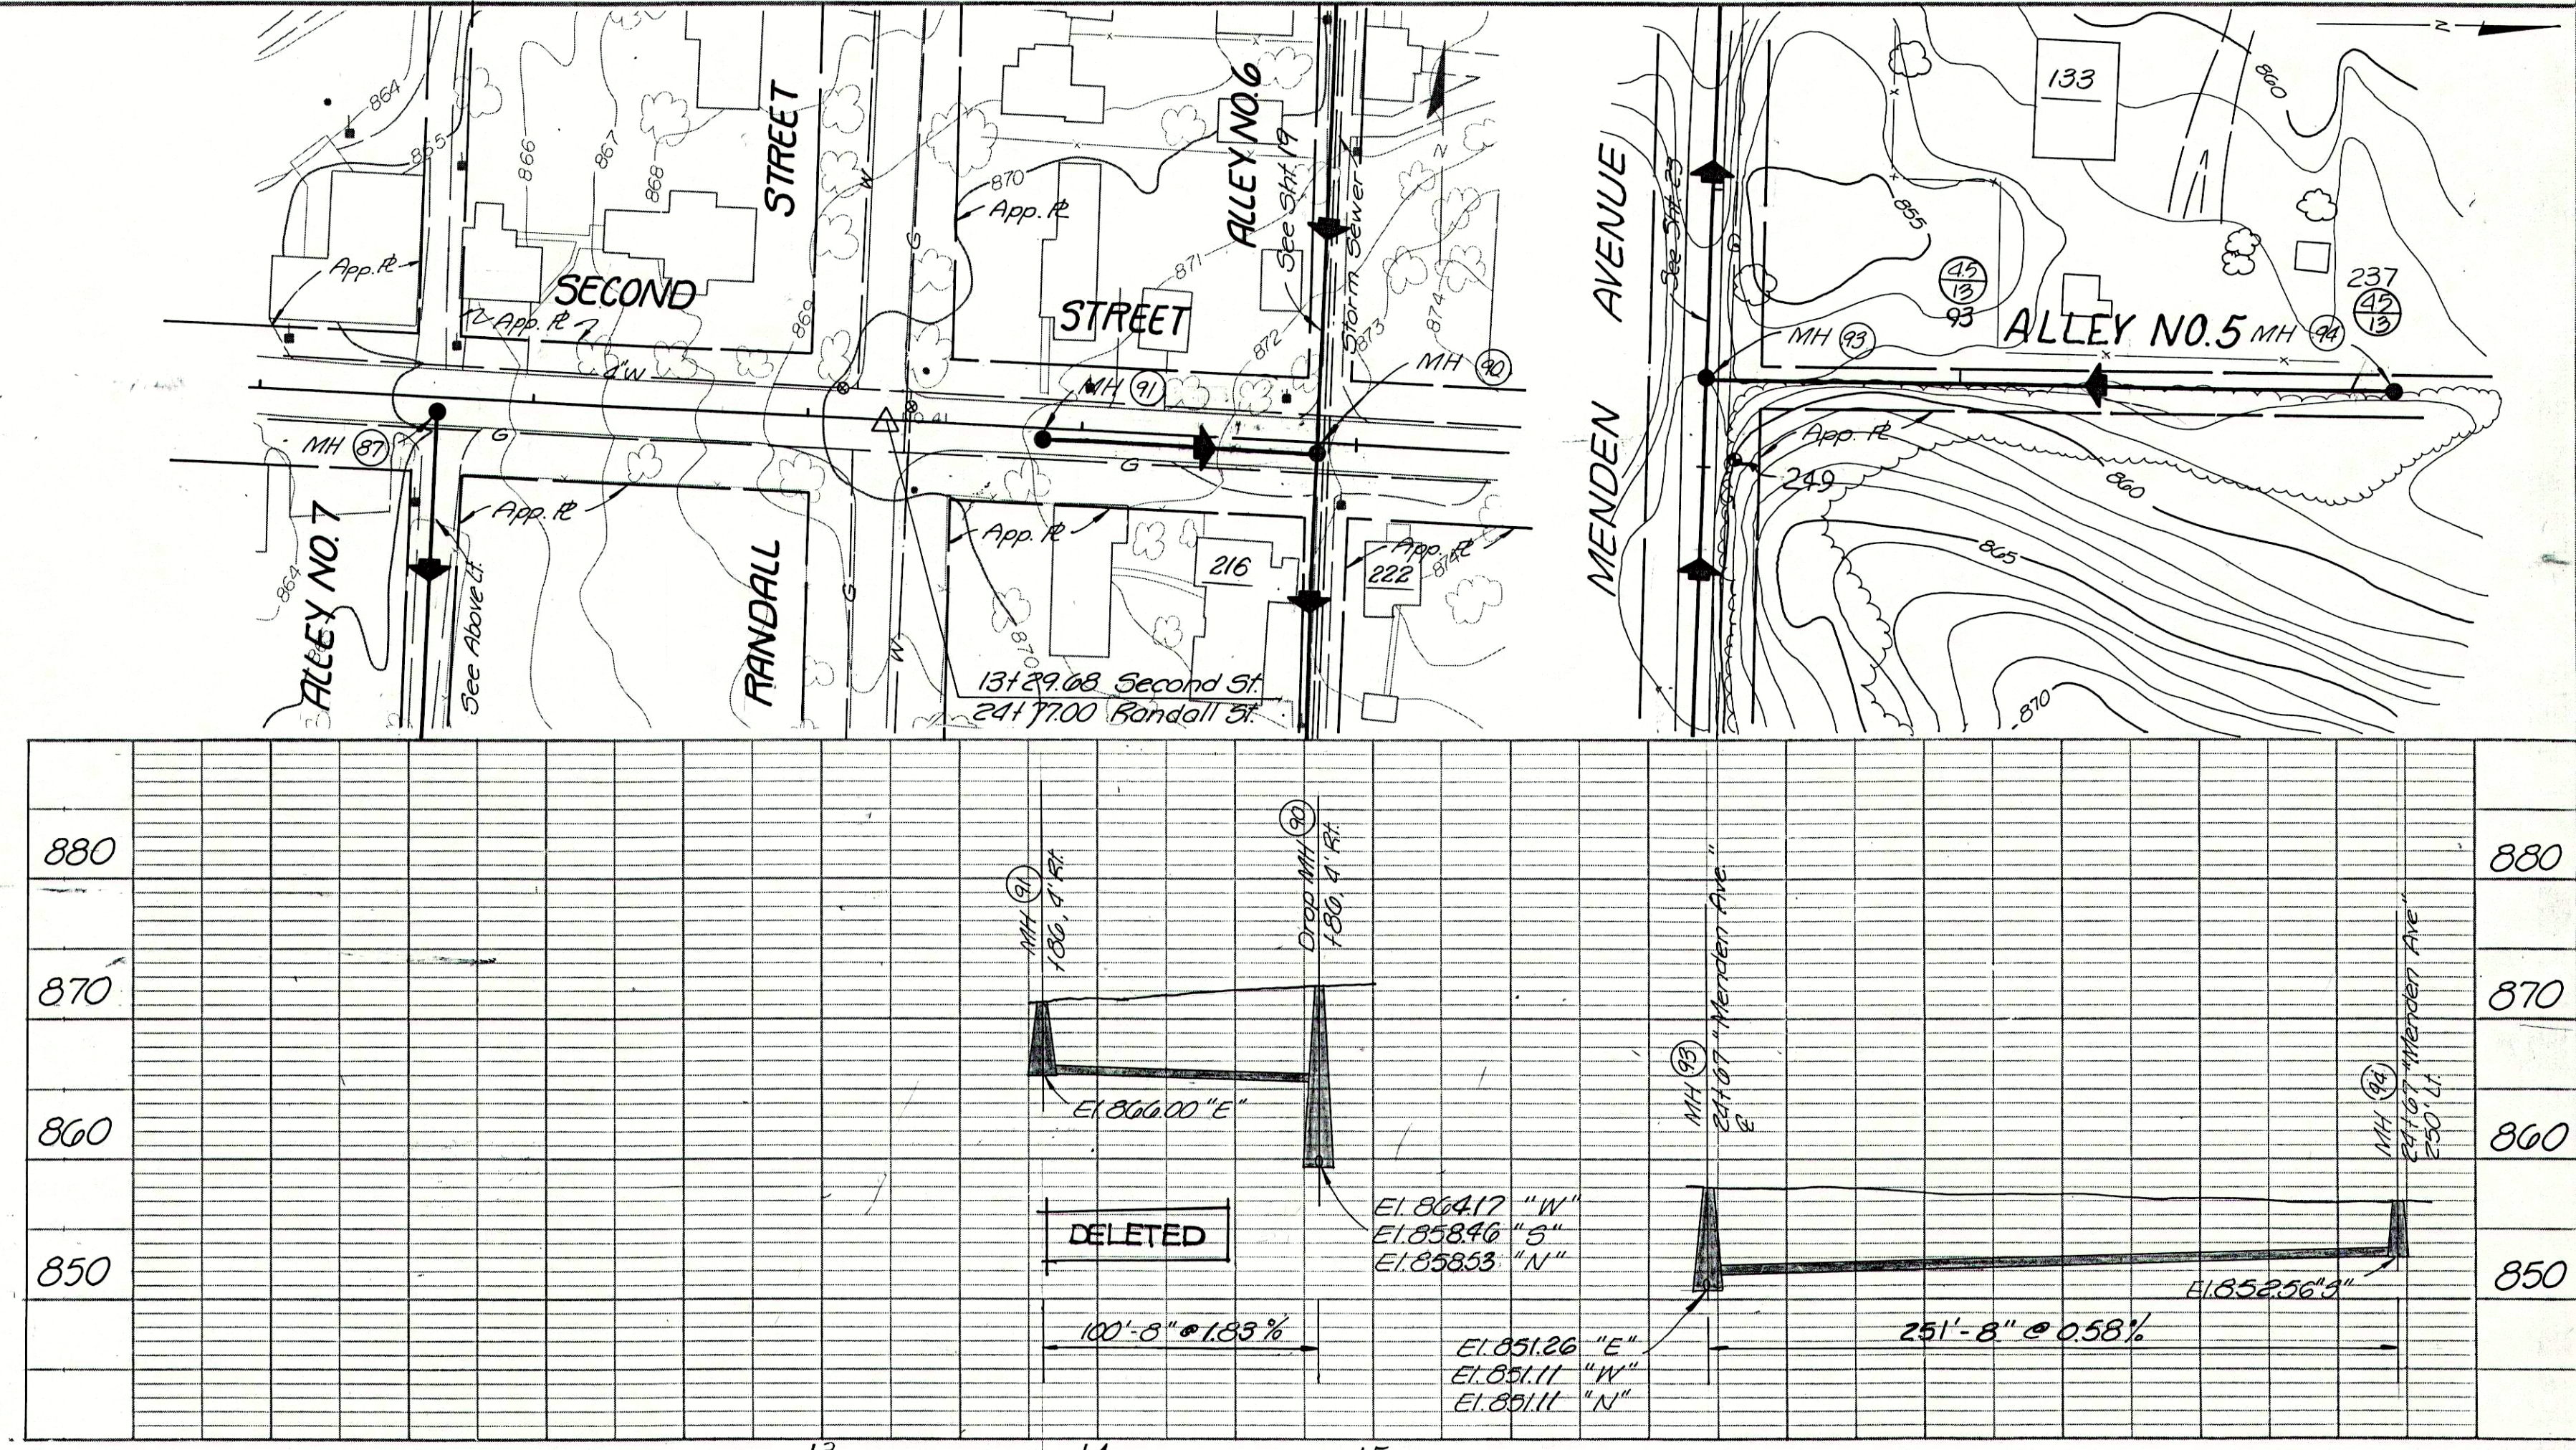
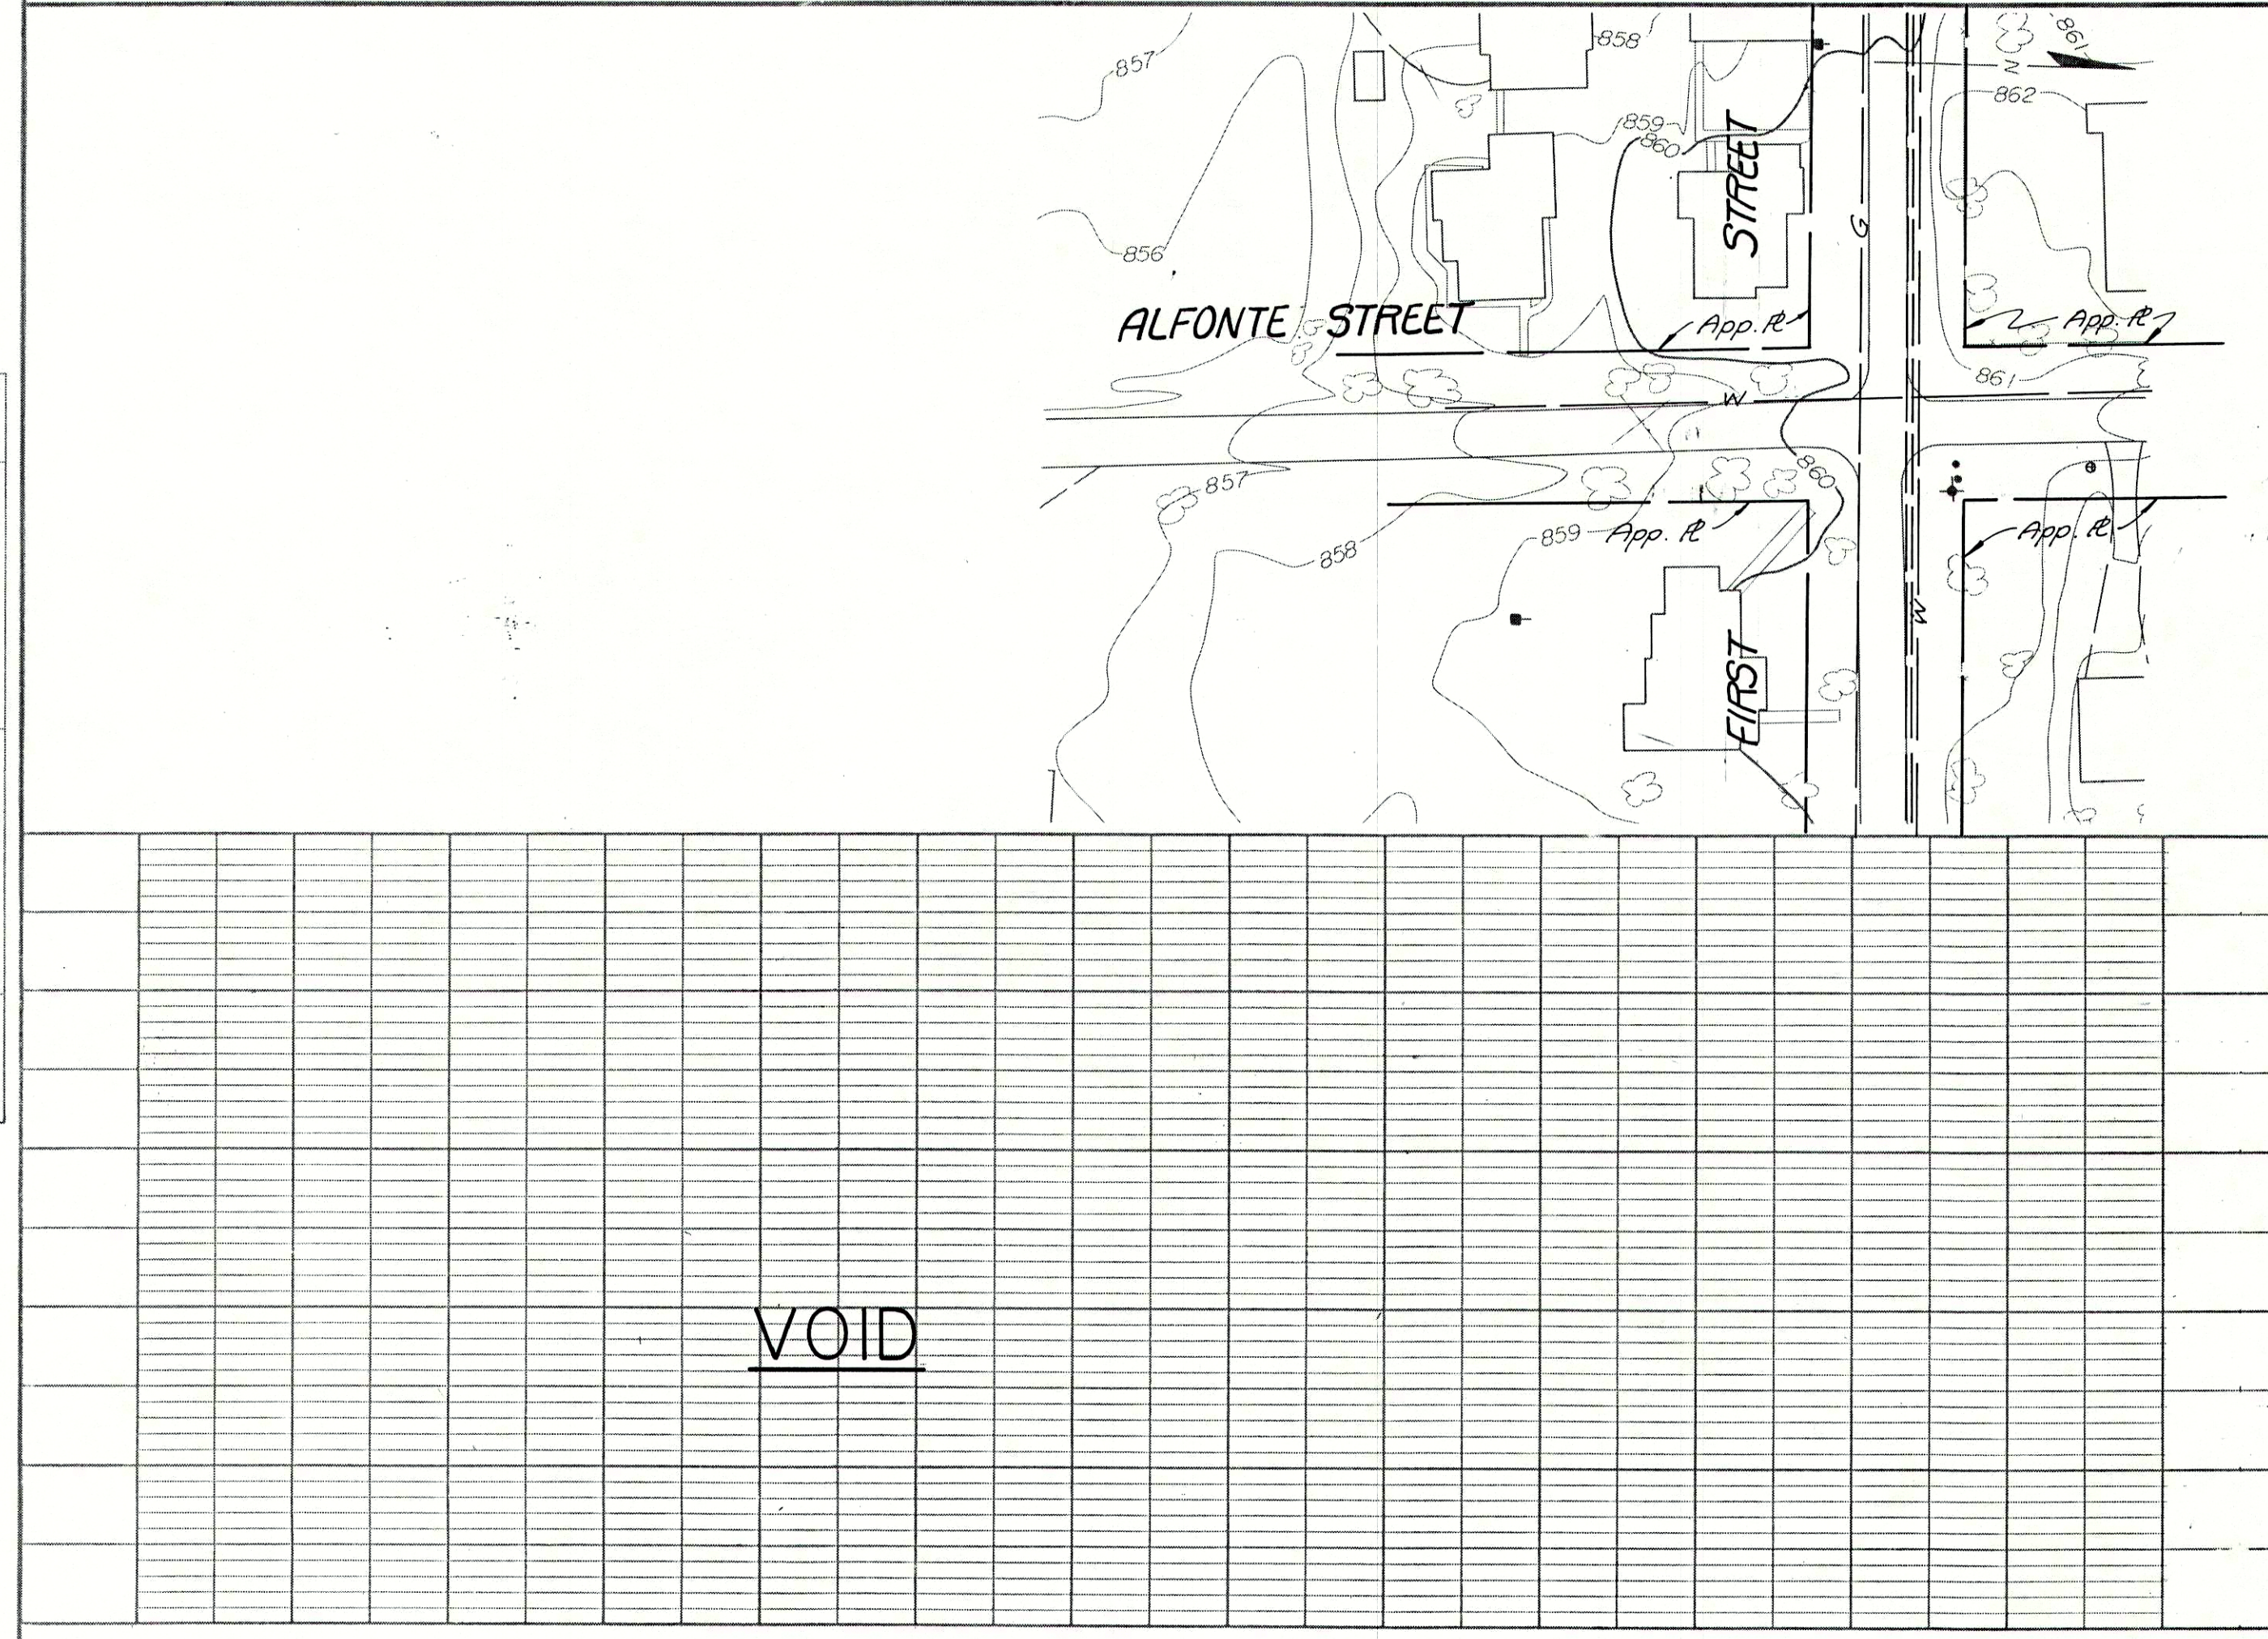
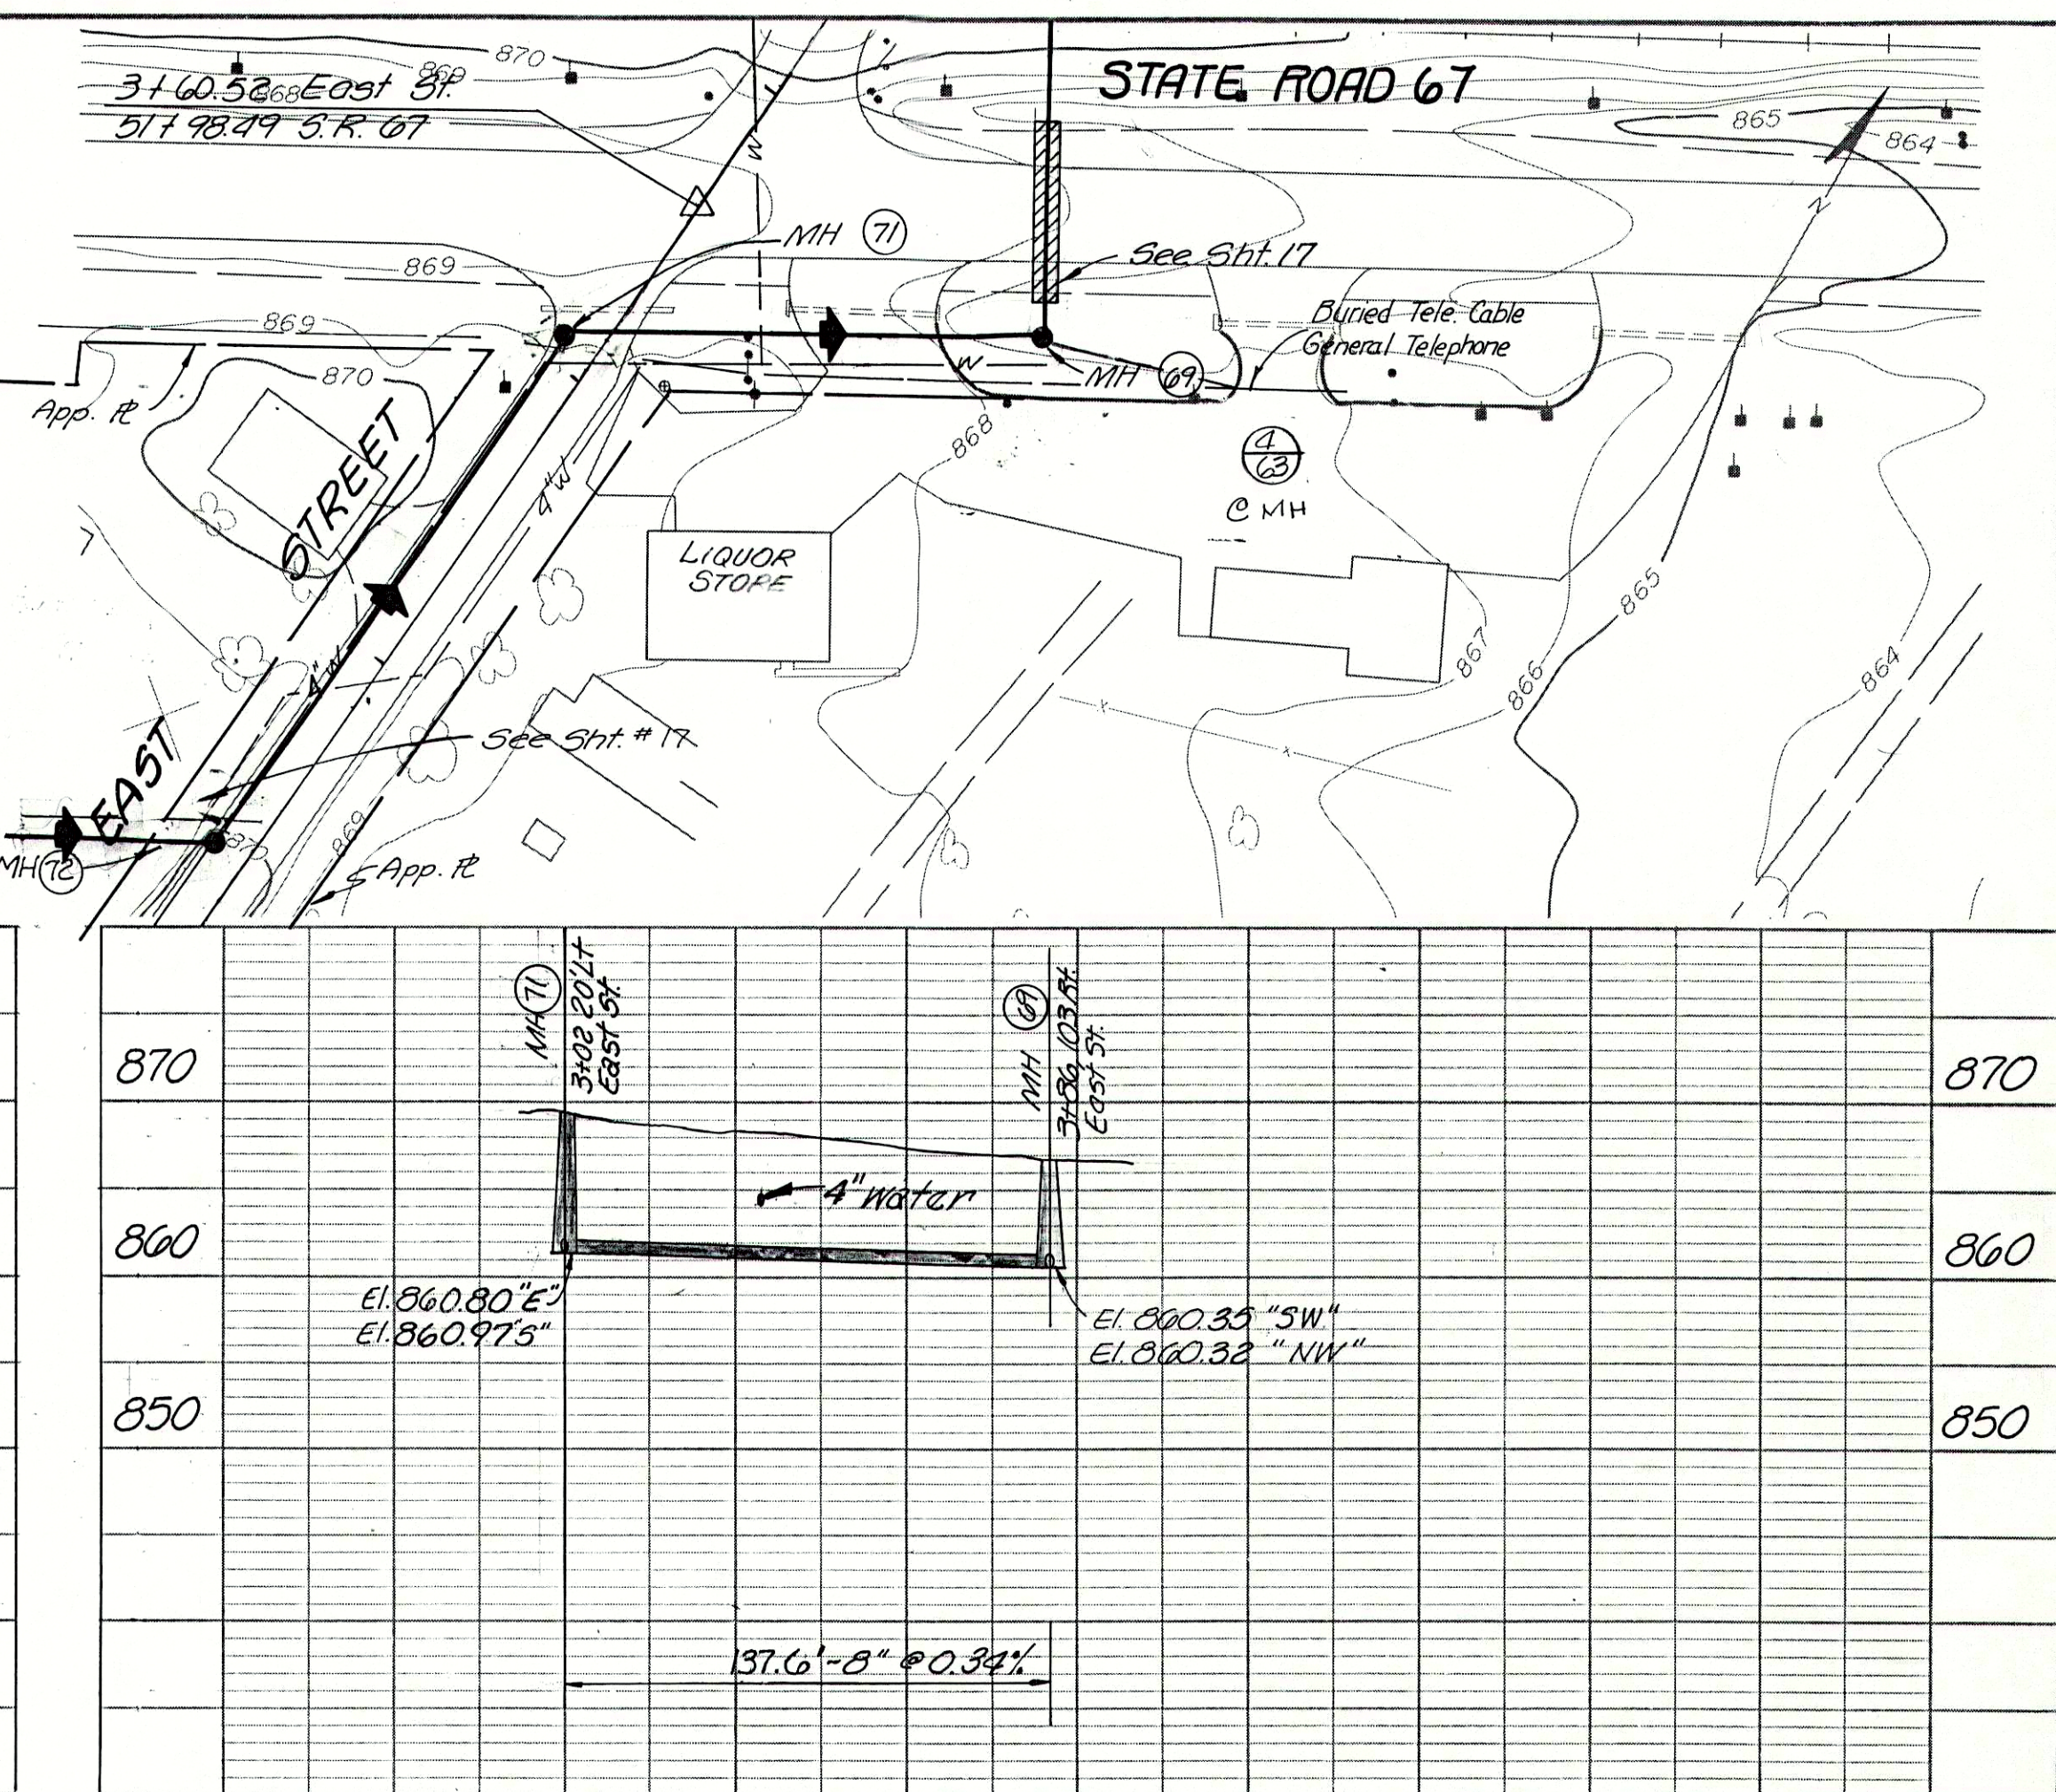
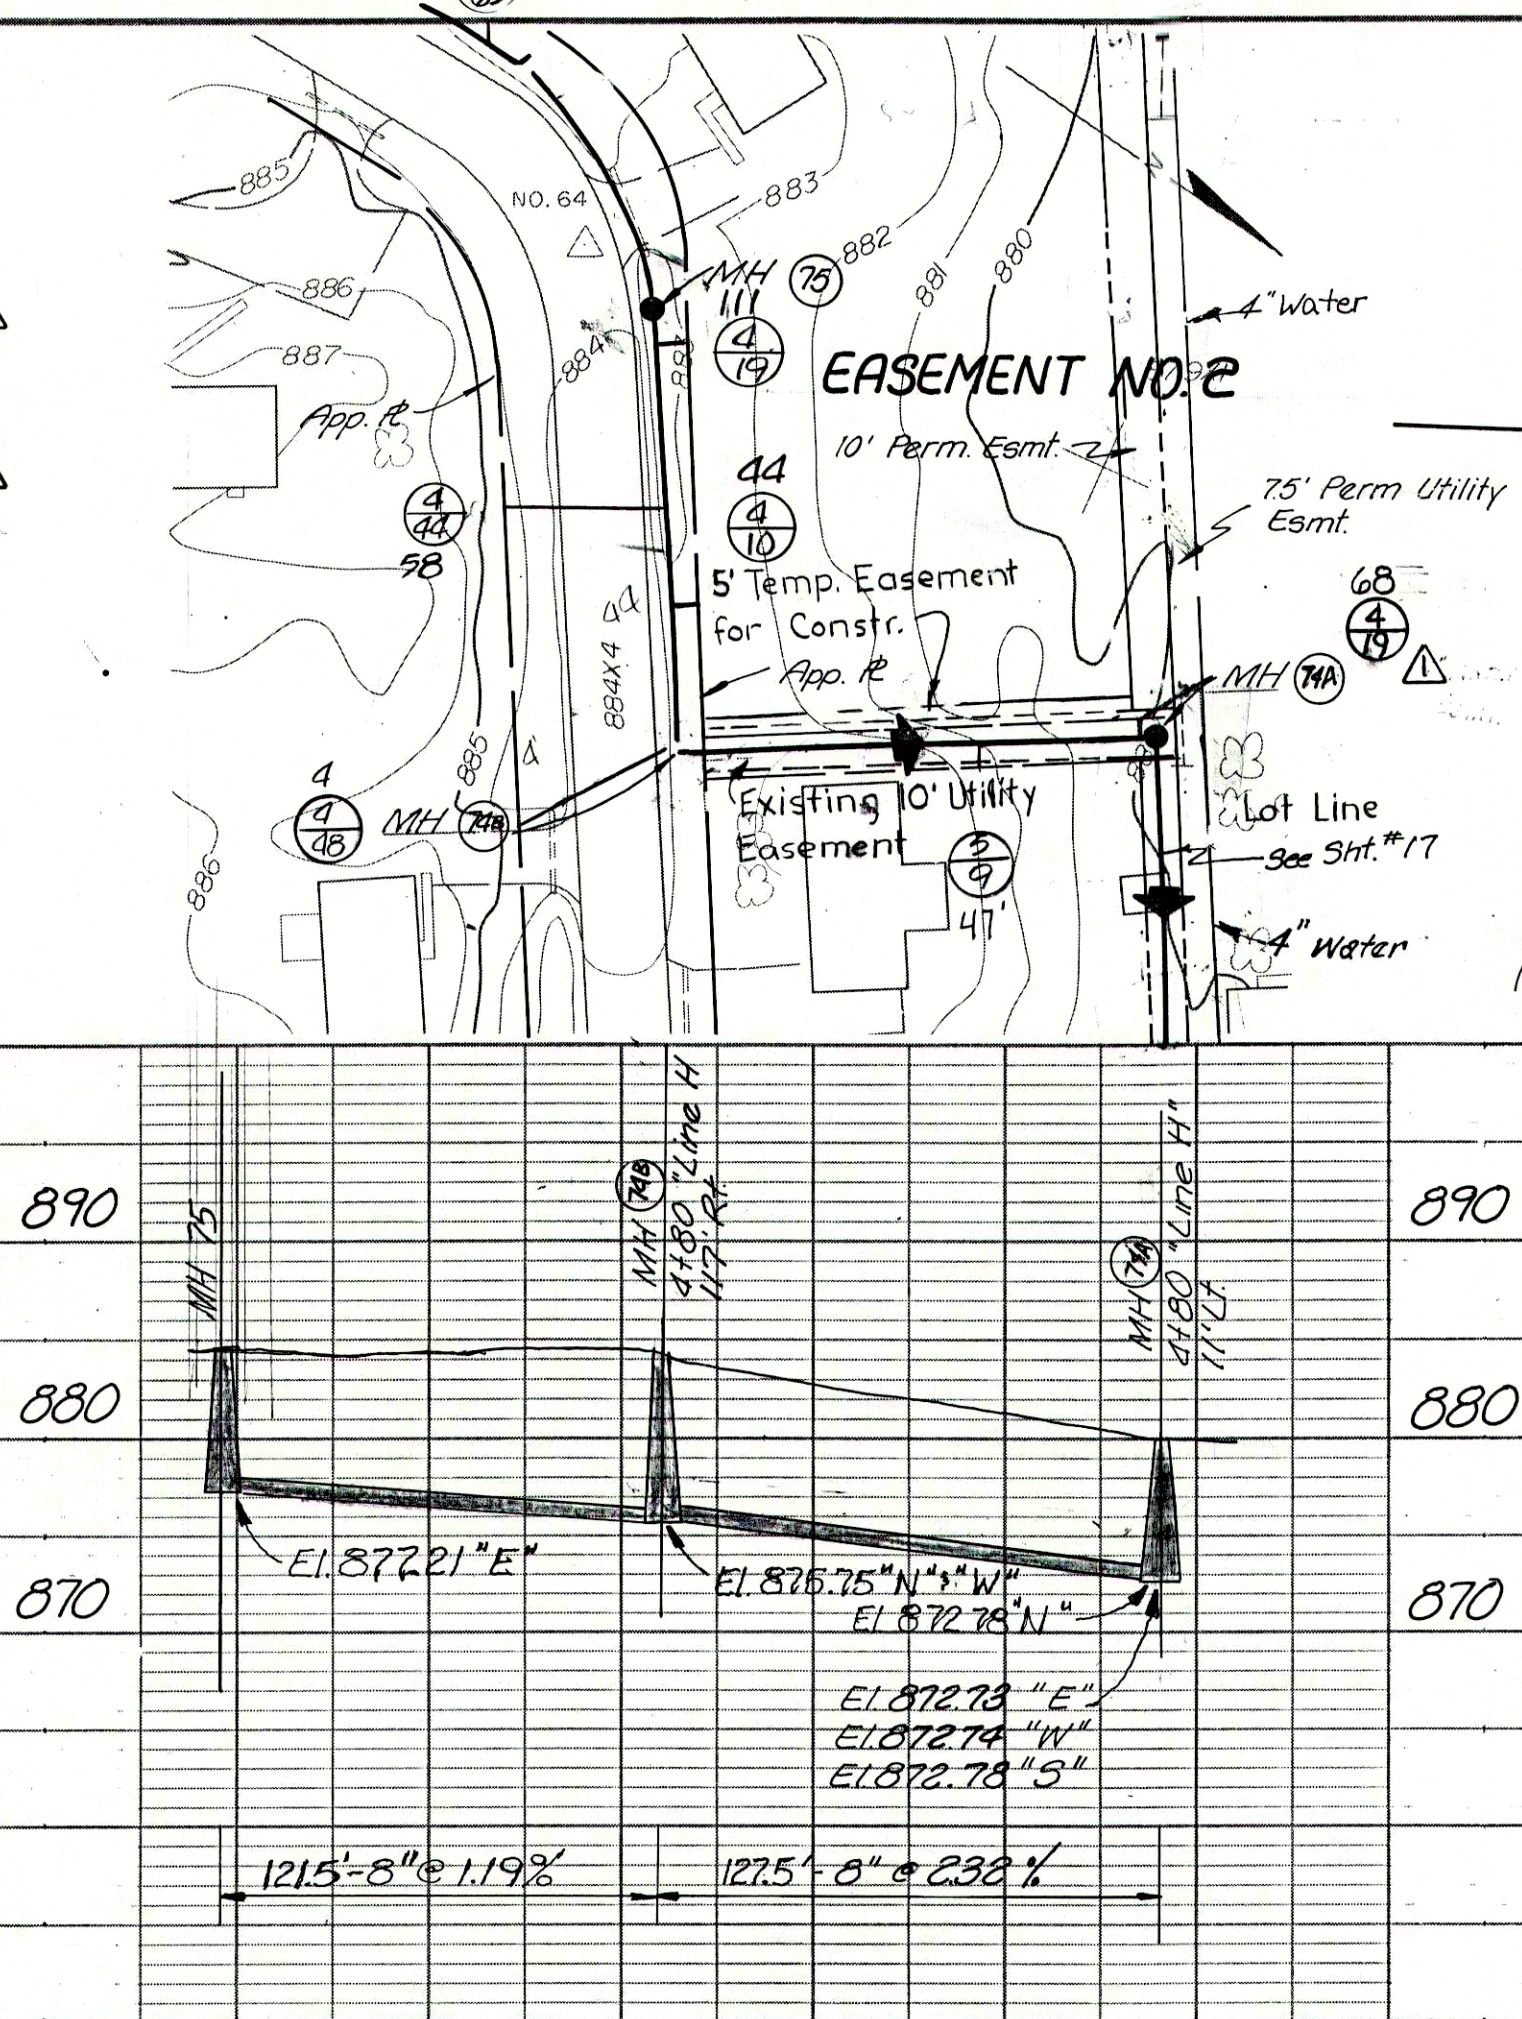


PROFILE	SURVEYED	BY	DATE
NOTE BOOK	PLOTTED		
	GRADES CHECKED		
	B. M.'S NOTED		
NO	STRUCTURE NOTED		

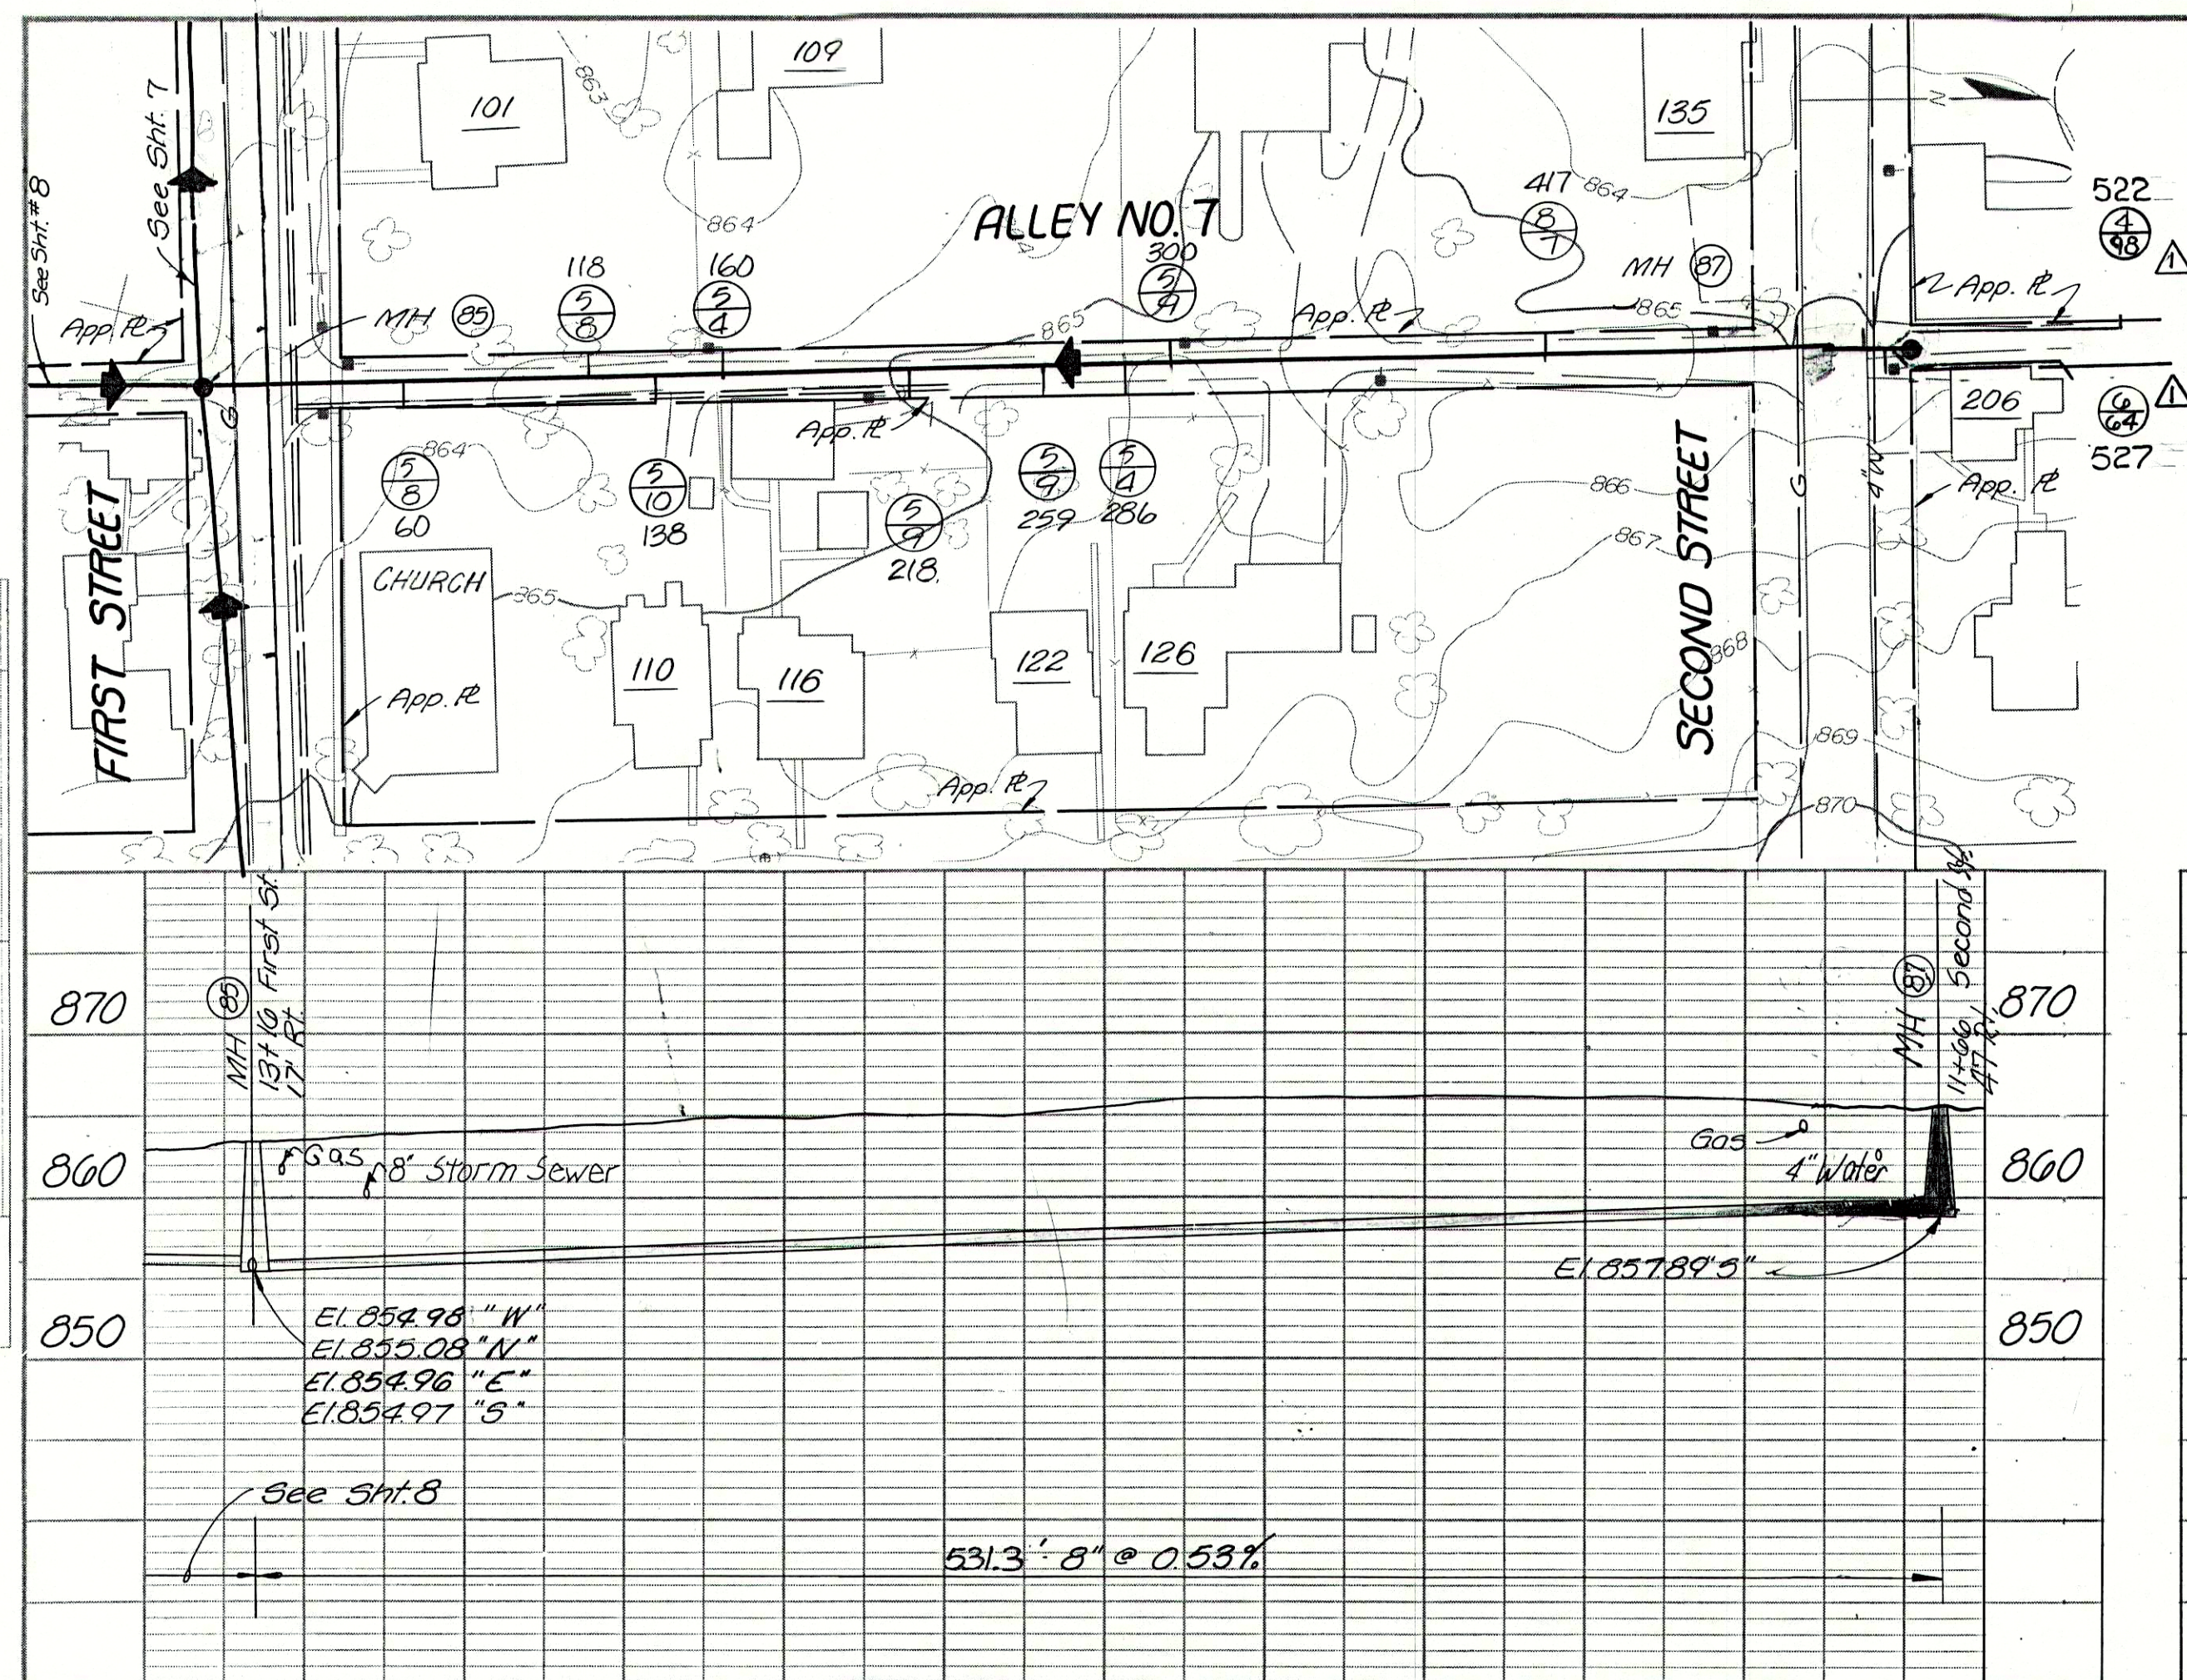

RECORD DRAWING

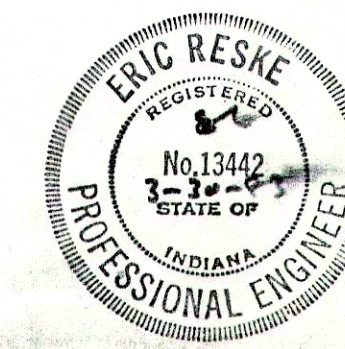

ALLEY #7, EAST ST. & S.R. 67 ALFONTE ST. SECOND ST.		SHEET 22
FALL CREEK R.W.D. PLAN & PROFILE		
HORIZ. 1"=50'	BEAM, LONGEST & NEFF, INC. CONSULTING ENGINEERS INDIANAPOLIS, INDIANA	
VERT. 1"=10'		